


O.D.O.T. DISTRICT 2 SURVEY OFFICE (USE ONLY)


PERSONNEL _____ REFERENCE NO. 43 SHEET 8 OF 25
 NOTES HOMAN DATE 07/07/14 ROUTE SR 424
 H.C. LEU WEATHER CLOUDY COUNTY HENRY
 R.C. THOMAS TEMP. 75° TOWNSHIP NAPOLEAN
 _____ SECTION 23
 _____ T 5 N R 6 E

TYPE MONUMENT _____ MAG/WASHER _____
 ON SURFACE - ~~BELOW~~ _____ ON _____
~~LEFT - C PAV'T~~ - RIGHT 1.7'
10.2' TO RT EDGE PAVEMENT
 S.L.M. 439+92

Grid: Northing: 628091.467 Easting: 1516650.718

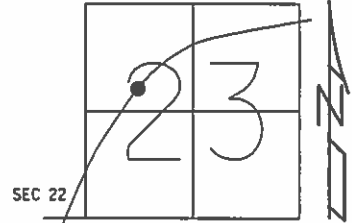

RECORD:
 ORIGIN UNKNOWN
 SET MAG/WASHER
 11/01/04
 DCH
 SET MAG/WASHER
 07/29/15
 DCH, JLL
 REF 43

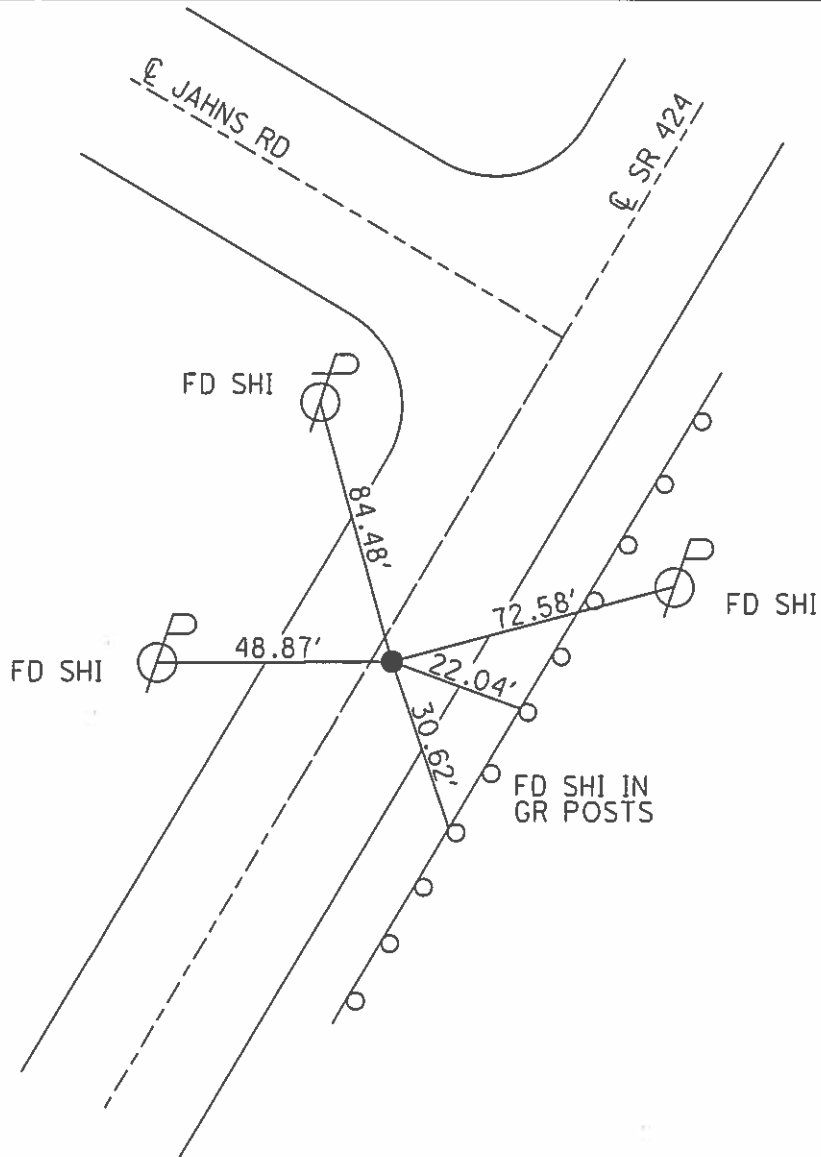

O.D.O.T. DISTRICT 2 SURVEY OFFICE

PERSONNEL

REFERENCE NO. 43

SHEET 5 OF 29

NOTES HOMAN

H.C. BARNHISEL

R.C. HOOVER

MC-DRAWING

DATE 9-01-04

WEATHER SUN

TEMP. + 74°

ROUTE S.R. 424

COUNTY HENRY

TOWNSHIP NAPOLEON

SECTION 23

T 5 N R 6 E


TYPE MONUMENT P.K. NAIL

ON SURFACE - BELOW SURFACE

LEFT - 0 PAV'T. - RIGHT 1.7 RT 0


10.2 TO RT. EDGE PAVEMENT

S.L.M. 439 + 92

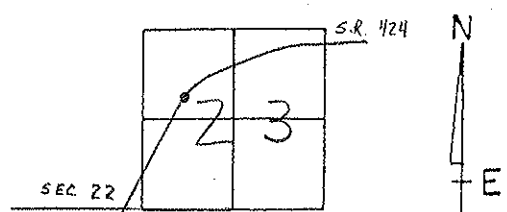

ORIGIN UNKNOWN

RESET MAG/WASHER
11-1-04
D.C.H.

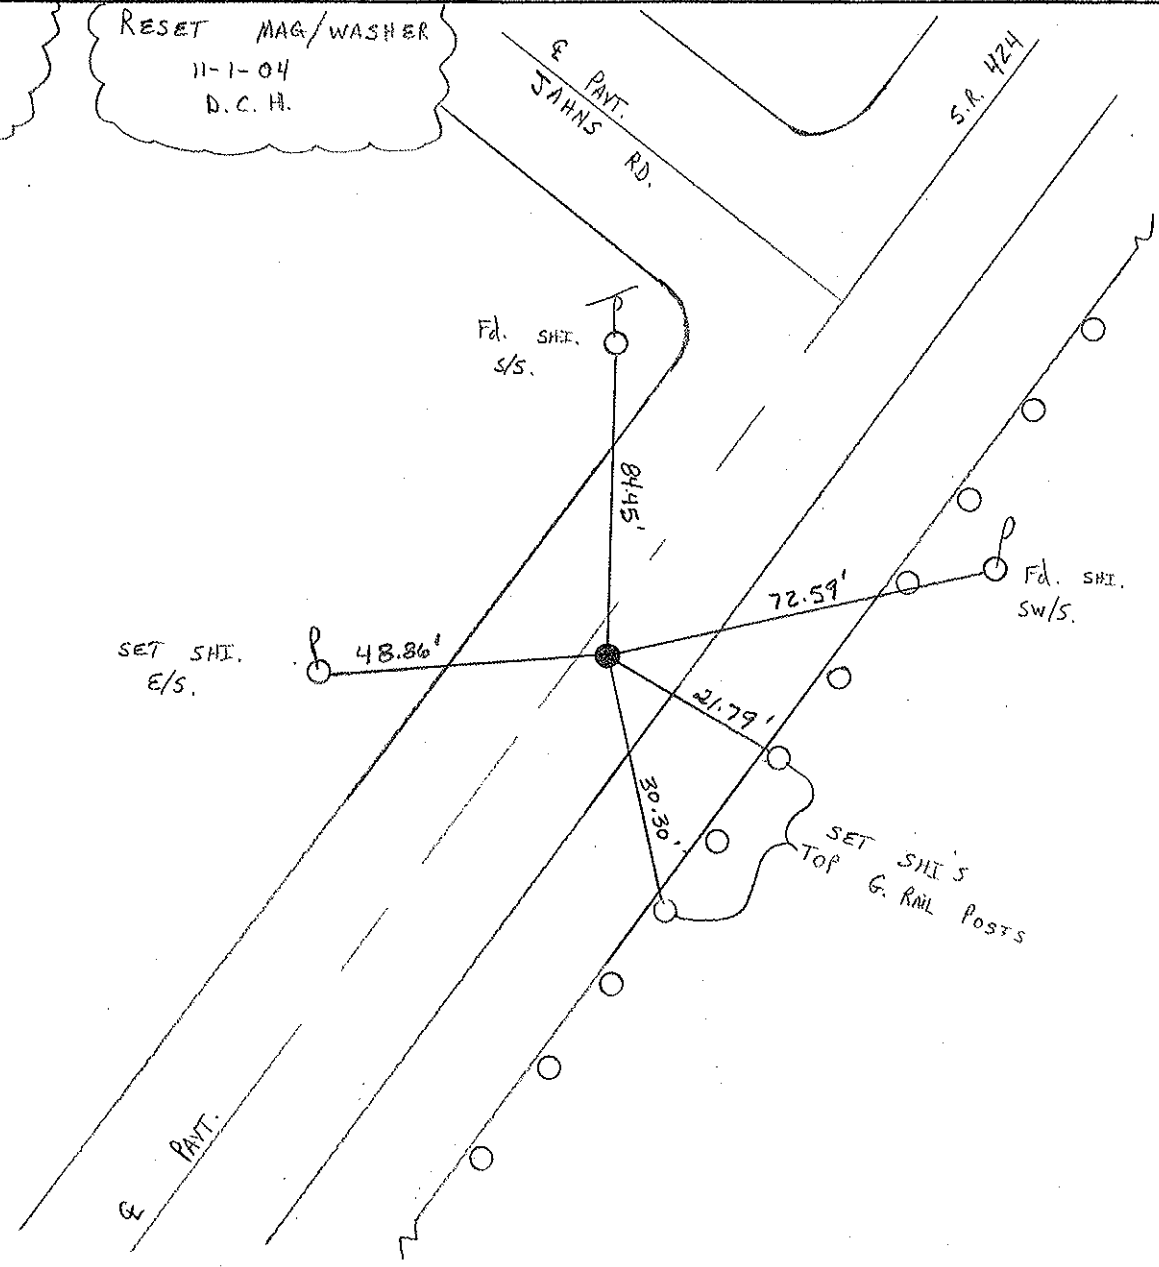

O.D.O.T. DISTRICT 2 SURVEY OFFICE

PERSONNEL _____

REFERENCE NO. _____

SHEET _____ OF _____

NOTES BARNHISEL

H.C. " "

DATE 9-21-90

ROUTE 424

R.C. HOFFMAN

WEATHER CLEAR

COUNTY HENRY

TEMP. +65°

TOWNSHIP Napoleon

SECTION 23

T 5 N R 6 E

TYPE MONUMENT Sm RR Spk



43

ON SURFACE - BELOW yes

LEFT - E PAV'T. - RIGHT 2.0

9.9 TO RT EDGE PAVEMENT

S.L.M. 439+92

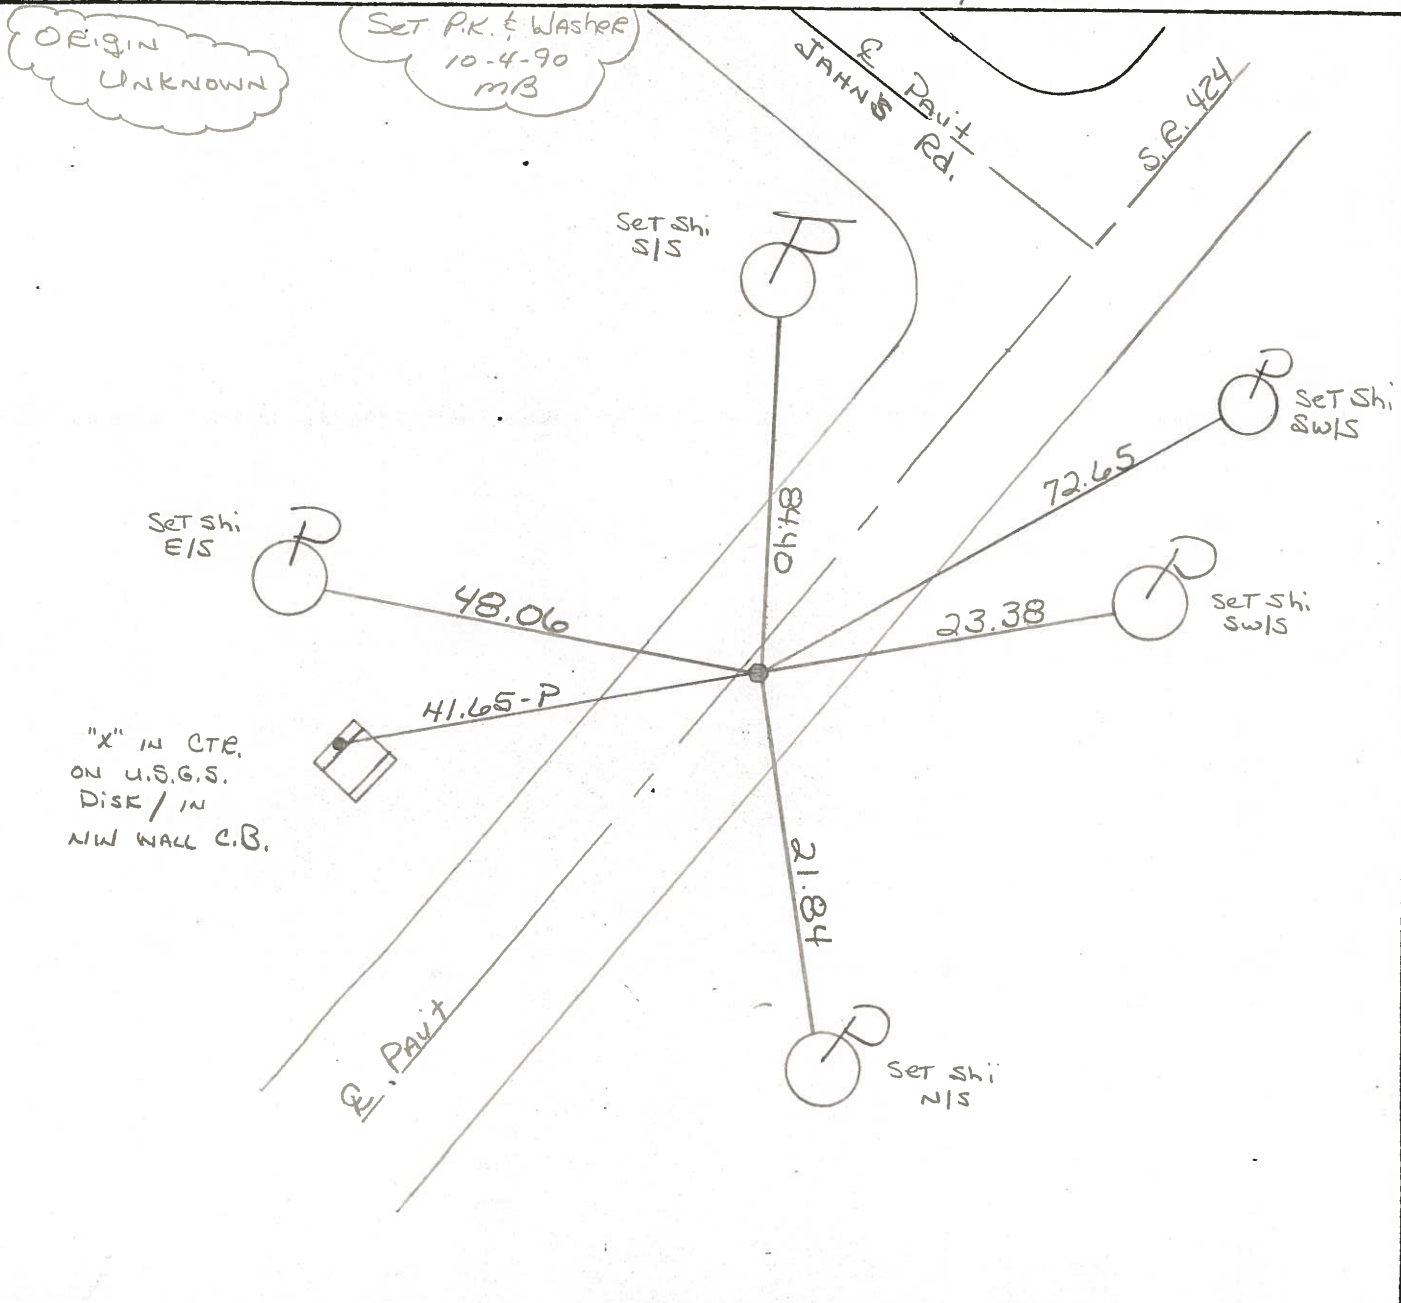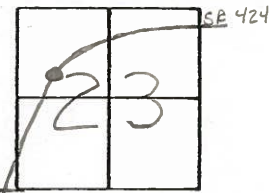

Q.D.O.T. DISTRICT 2 SURVEY OFFICE

Sht. 4 of 6

County HENRY S.R. 424

Date 7-26-79

Township NAPOLEON

Weather CLEAR

Section 23

Temp. +76°

T5N, R6E


Personnel BURNSIDE

BOWERS

KWAPE

MEAD

43

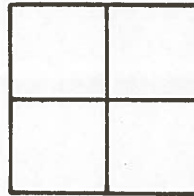

JAHNS ROAD

S.L.M. STA. 439+17
FD. 3/4" I. BOLT
1/2" DEEP & 2"
RT. OF CTR. PAVE.
(ORIGIN & EXACT
USE UNKNOWN)

"+" IN CTR.
U.S. ARMY CORPS
OF ENGINEERS
STA. DESIGNATION
"SURVEY MARK"
SET IN N. WALL
OF C.B.

S.R.

