



O.D.O.T. DISTRICT 2 SURVEY OFFICE (USE ONLY)

PERSONNEL \_\_\_\_\_ REFERENCE NO. 52 B SHEET 20 OF 25  
 NOTES HOMAN DATE 07/10/14 ROUTE SR 424  
 H.C. LEU WEATHER CLEAR COUNTY HENRY  
 R.C. HOMAN TEMP. +80° TOWNSHIP LIBERTY  
 \_\_\_\_\_ SECTION 7  
 \_\_\_\_\_ T 5 N R 7 E

TYPE MONUMENT \_\_\_\_\_ MAG \_\_\_\_\_  
 ON SURFACE - ~~BELOW~~ \_\_\_\_\_ ON \_\_\_\_\_  
 LEFT - ~~C PAV'T~~ - RIGHT \_\_\_\_\_ 0.8' \_\_\_\_\_  
11.3' TO LT EDGE PAVEMENT  
 S.L.M. \_\_\_\_\_ 589+61 \_\_\_\_\_  
 Grid: Northing: 637400.809 Easting: 1527820.249

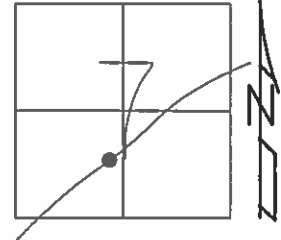

RECORD:  
 SET MAG/WASHER  
 11/03/04  
 MB  
 REFB52  
 SET PK/WASHER  
 10/27/15  
 DCH, JLL

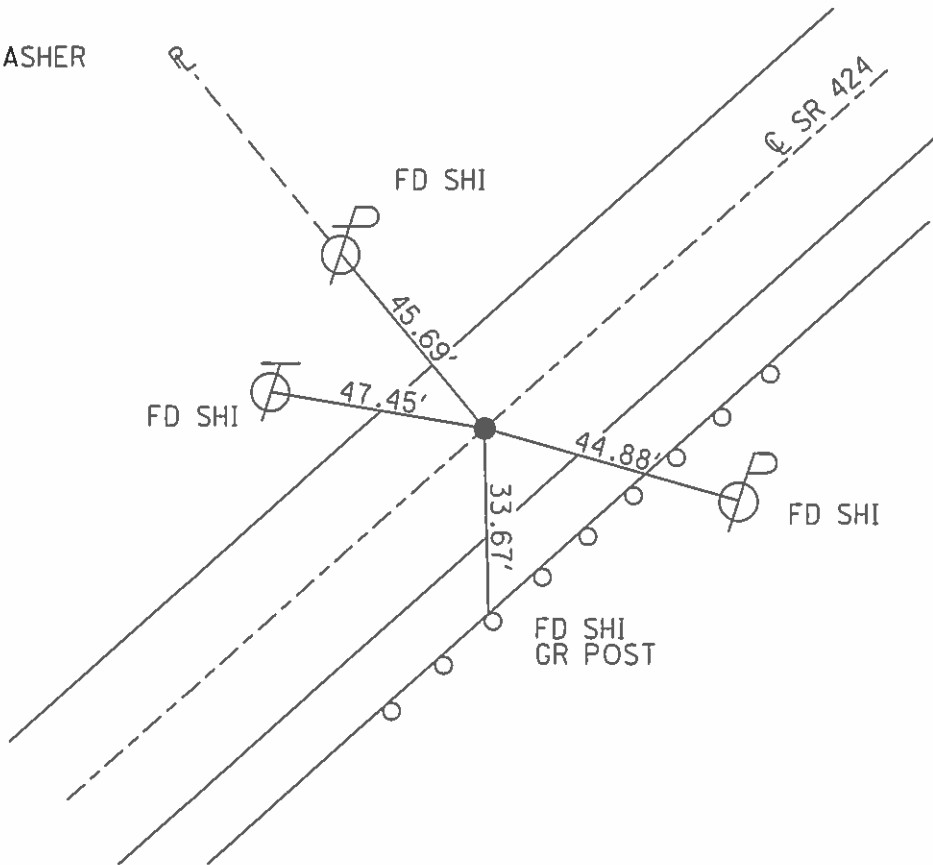

# O.D.O.T. DISTRICT 2 SURVEY OFFICE

PERSONNEL

REFERENCE NO. 52-B

SHEET 16 OF 29

NOTES BARNHISEL

H.C. CANTERBURY

R.C. HOOVER

MC - DRAWING

DATE 9/03/04

WEATHER CLOUDY

TEMP. +80°

ROUTE S.R. 424

COUNTY HENRY

TOWNSHIP LIBERTY

SECTION 7

T 5 N R 7 E


TYPE MONUMENT P.K. / WASHER

ON SURFACE - BELOW SURFACE


LEFT - PAV'T. - RIGHT 0.8' LT ♀

11.3' TO LT EDGE PAVEMENT

S.L.M. 589 + 61

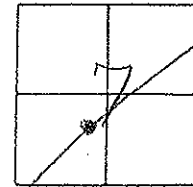

RESET MAG/WASHER  
 11/03/04  
 M.B.

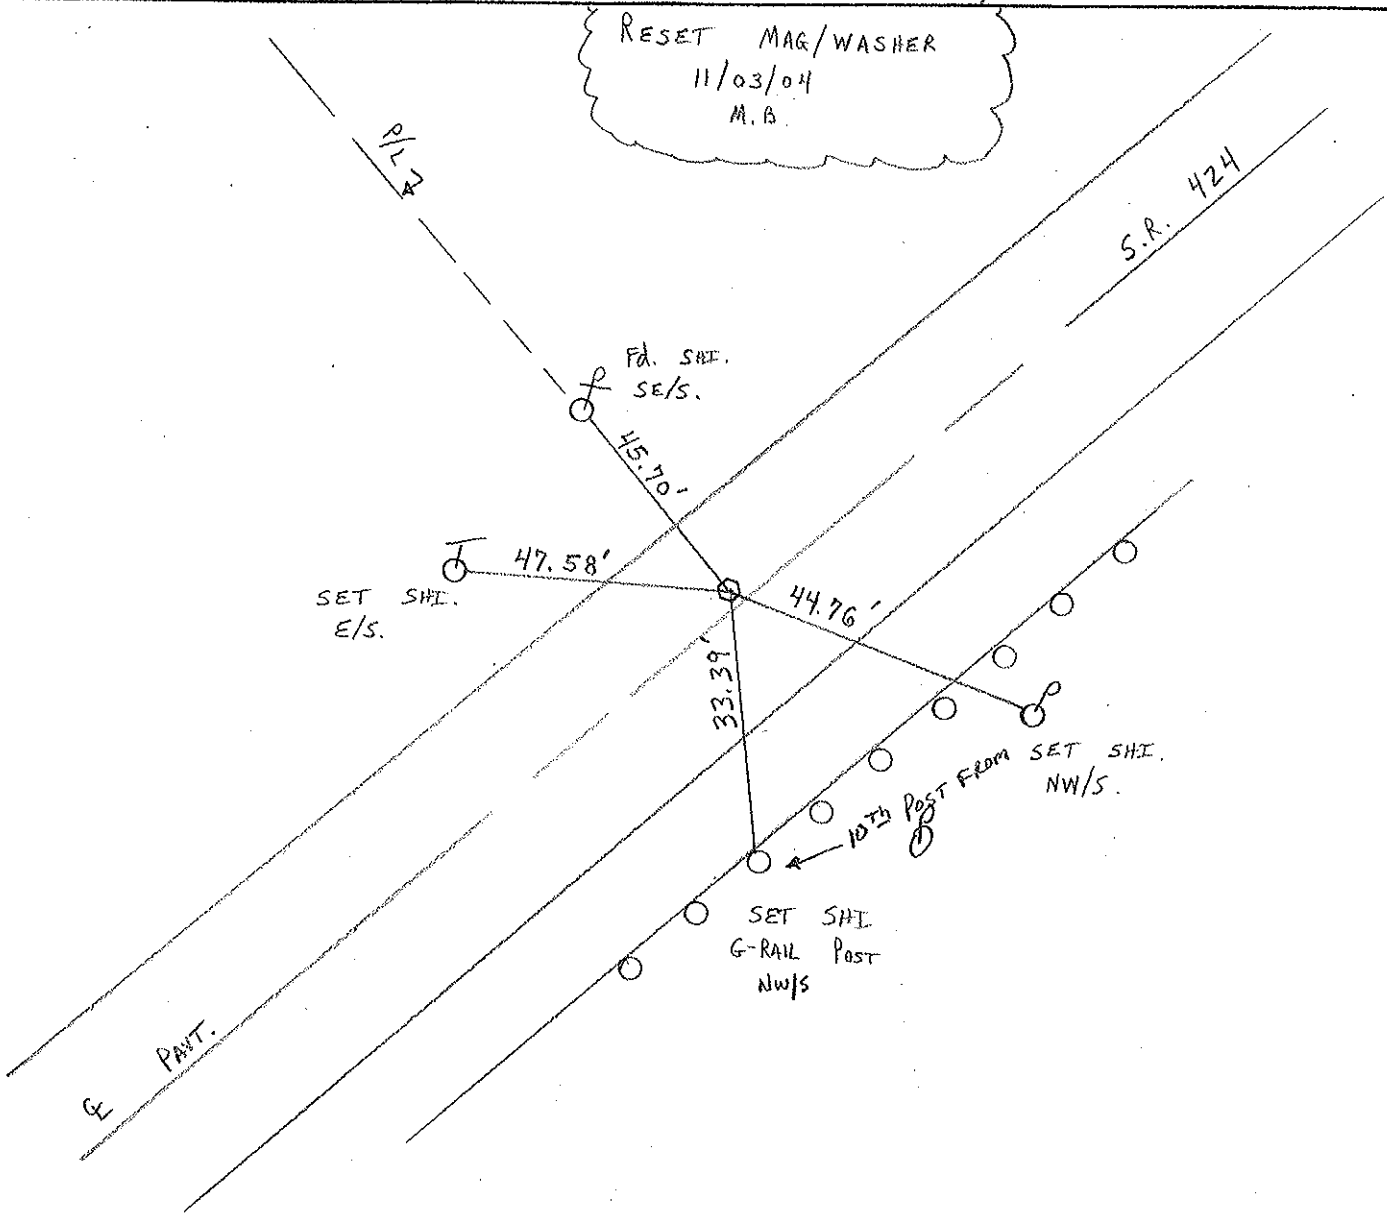

O.D.O.T. DISTRICT 2 SURVEY OFFICE

PERSONNEL

REFERENCE NO. 52-B SHEET B OF 26

NOTES D. CURTIS

H.C. CANTERBURY

R.C. HEMILLER

CORDES

VOGEL

DATE 4-18-94

WEATHER RAIN

TEMP. +65

ROUTE S.R. 424

COUNTY HENRY

TOWNSHIP LIBERTY

SECTION 7

T 5 N R 7 E

set P.K. / WASHER  
8-294  
C.L.



TYPE MONUMENT P.K. NAIL

ON SURFACE - BELOW ON SURFACE

LEFT - ~~C~~ PAV'T. - RIGHT 0.8' LT. ~~E~~

11.3 TO LT. EDGE PAVEMENT

S.L.M. 595 + 85

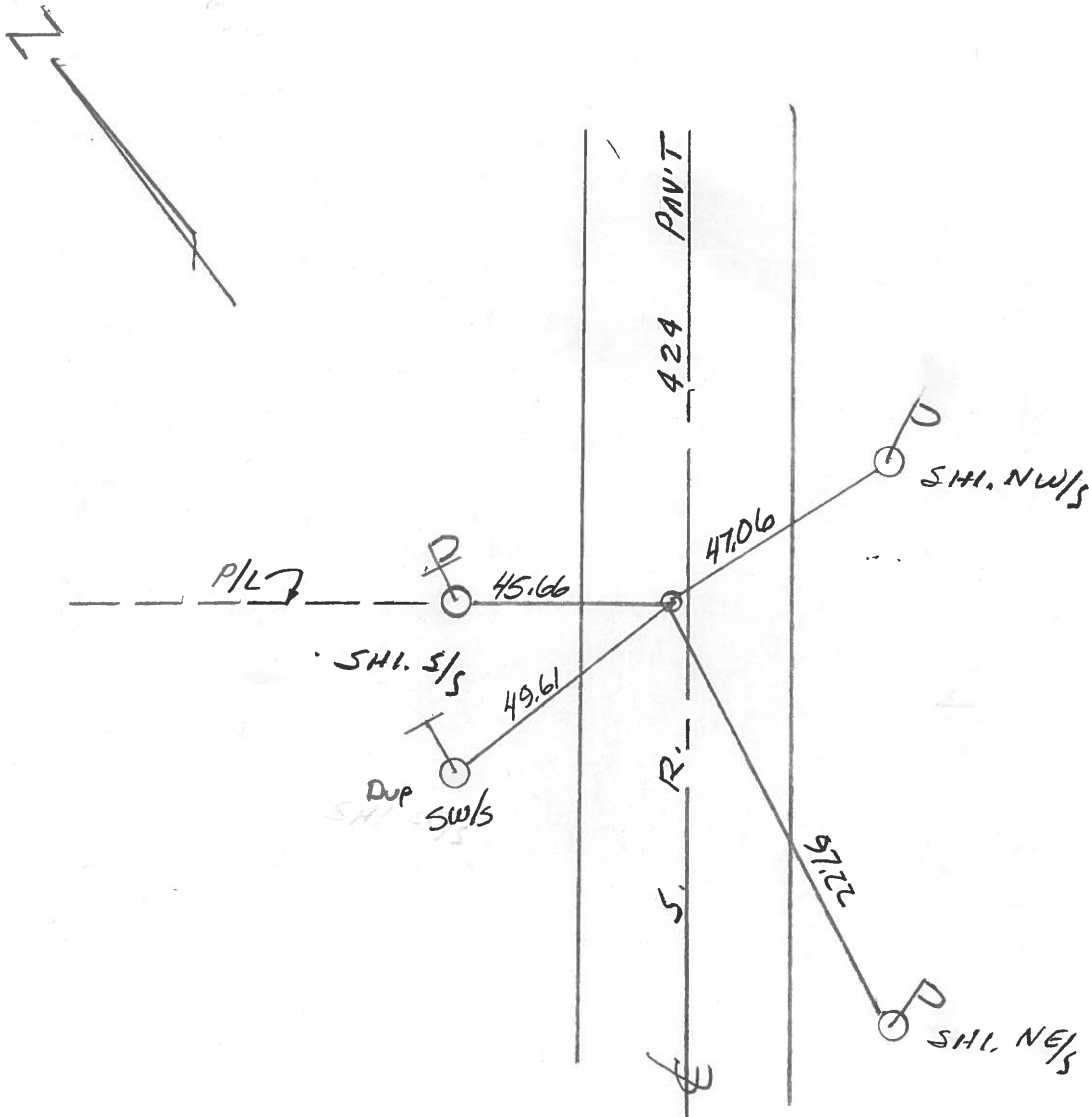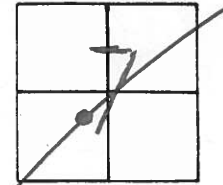

O.D.O.T. DISTRICT 2 SURVEY OFFICE

SHEET 8 OF

County Henry S.R. 424

Date 7 July 82

Township Harrison LIBERTY

Weather Warm

Section 7

Temp. 83°


T N, R E

Personnel I. Stone


P. Neuse

R. Michalak

D. Curtis

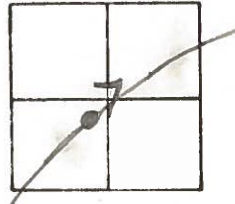

REF. NO. 52-B

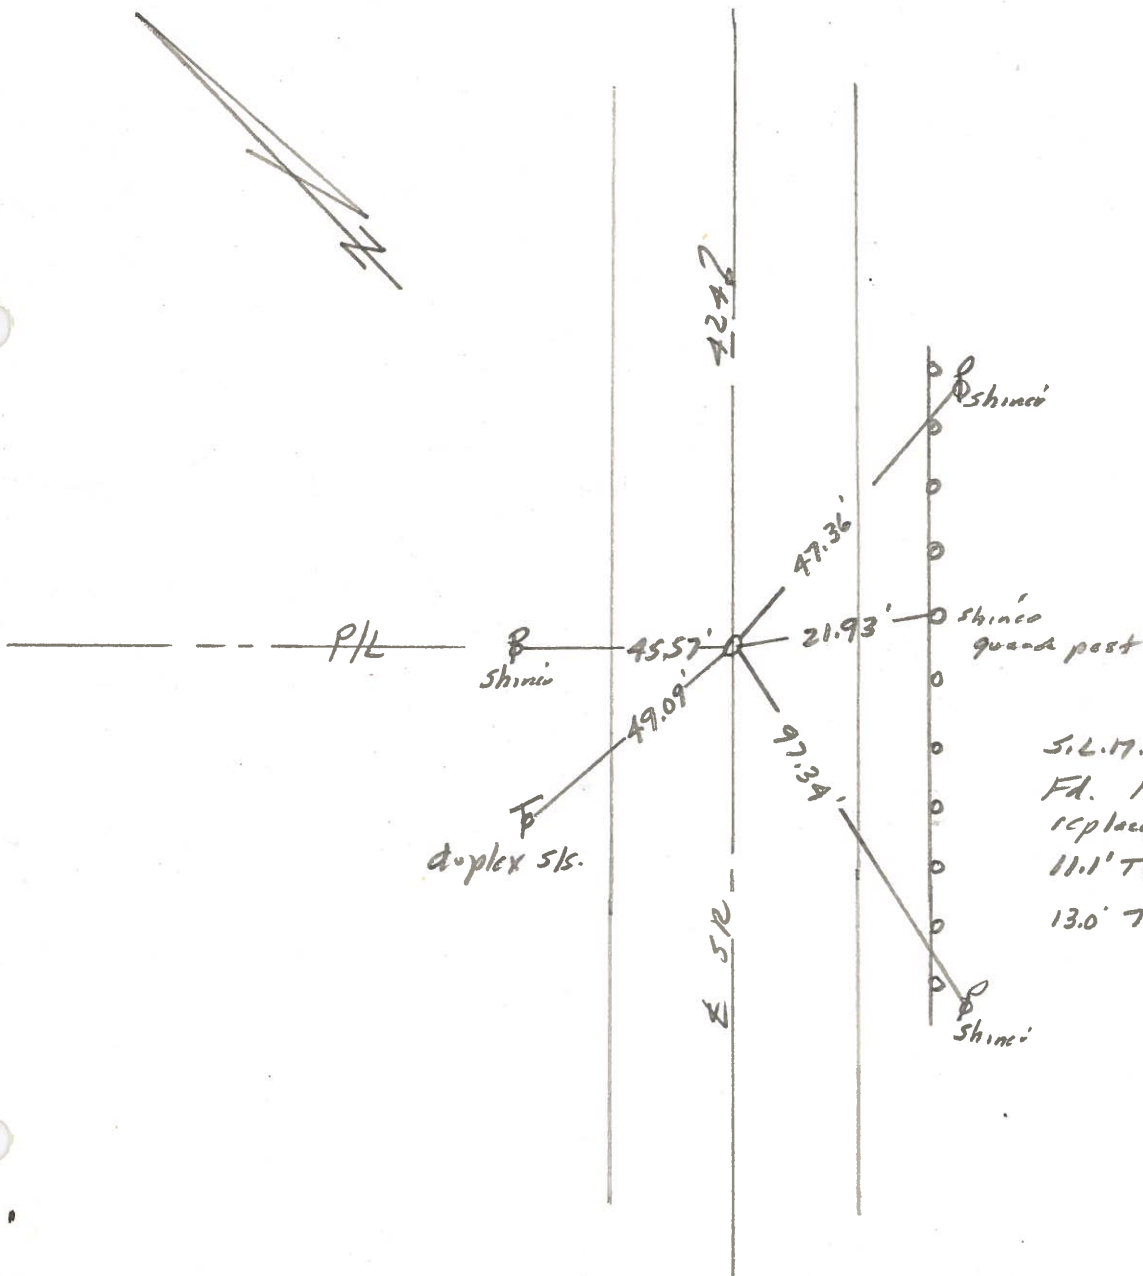

S.L. 17. Sta. 587+78±  
 Fd. Nail in lead pipe  
 replaced with PK Nail  
 11.1' To N. edge put.  
 13.0' To S. edge put.

PERSONNEL	TITLE	PERSONNEL	TITLE
Tomsic			
Neuser			
Granata			
Vandy			

COUNTY Henry DATE Sept. 4, 1973  
 S. R. 424 WEATHER \_\_\_\_\_  
 SEC. \_\_\_\_\_ TEMP. \_\_\_\_\_

