


O.D.O.T. DISTRICT 2 SURVEY OFFICE (USE ONLY)


PERSONNEL \_\_\_\_\_ REFERENCE NO. 54 SHEET 23 OF 25  
 NOTES HOMAN DATE 07/10/14 ROUTE SR 424  
 H.C. LEU WEATHER CLEAR COUNTY HENRY  
 R.C. MEYER TEMP. 80° TOWNSHIP LIBERTY  
 \_\_\_\_\_ SECTION 7  
 \_\_\_\_\_ T 5 N R 7 E

TYPE MONUMENT \_\_\_\_\_ MAG \_\_\_\_\_  
 ON SURFACE - ~~BELOW~~ \_\_\_\_\_ ON \_\_\_\_\_  
 LEFT - ~~C PAV'T~~ - ~~RIGHT~~ \_\_\_\_\_ 3.3' \_\_\_\_\_  
15.0' TO RT EDGE PAVEMENT  
 S.L.M. \_\_\_\_\_ 623+79

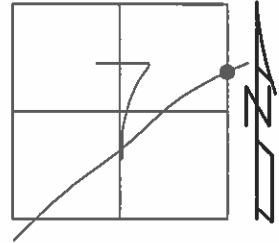

Grid: Northing: 639107.874 Easting: 1530766.429

RECORD:  
 SET MAG/WASHER  
 11/04/04  
 MB  
 REF55  
 SET PK/WASHER  
 10/27/15  
 DCH, JLL

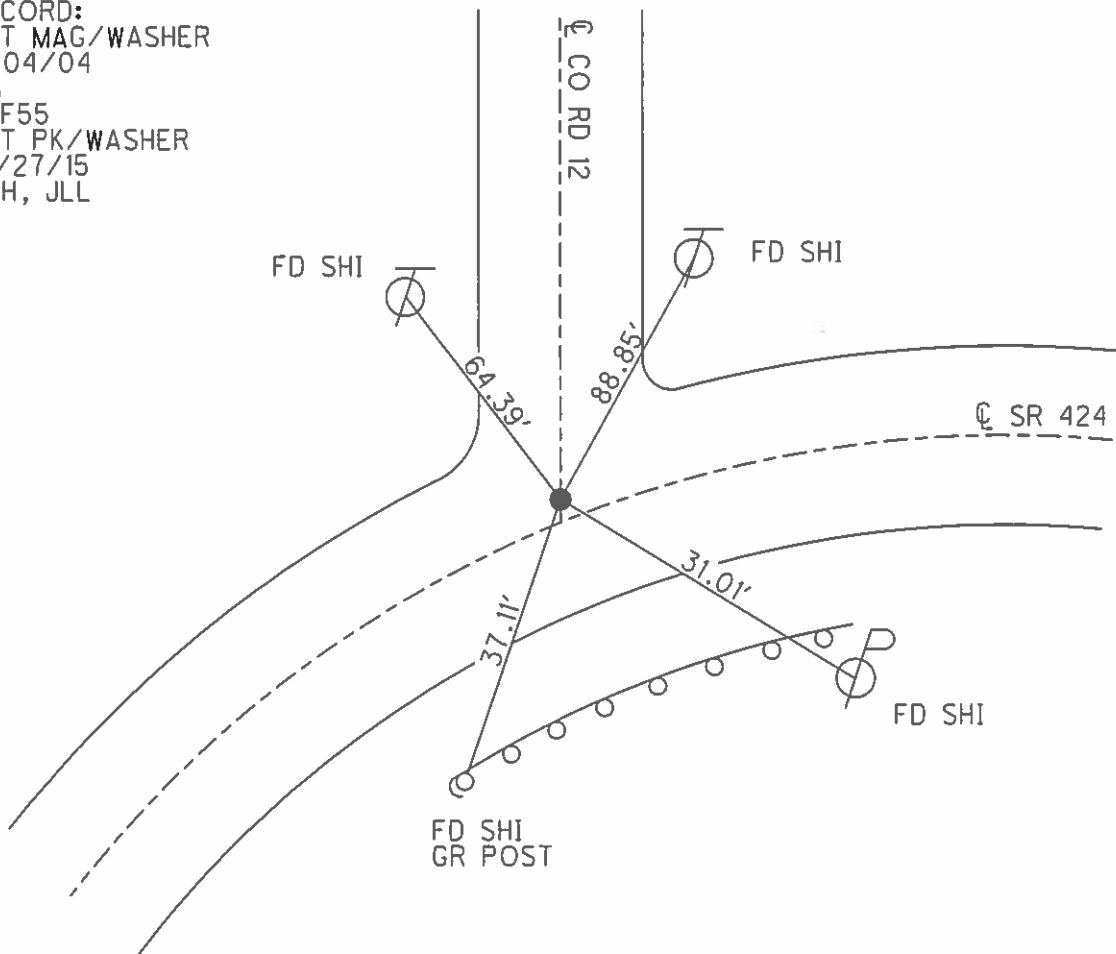

# O.D.O.T. DISTRICT 2 SURVEY OFFICE

PERSONNEL

REFERENCE NO. 54

SHEET 19 OF 29

NOTES BARNHISEL

H.C. CANTERBURY

R.C. HOOVER

MC-DRAWING

DATE 9/08/04

WEATHER CLOUDY

TEMP. +65°

ROUTE S.R. 424

COUNTY HENRY

TOWNSHIP LIBERTY

SECTION 7

T 5 N R 7 E


TYPE MONUMENT P.K. / WASHER

ON SURFACE - ~~BELOW~~ SURFACE


LEFT - ~~Q~~ PAV'T. - RIGHT 3.3' LT Q

15.0' TO RT EDGE PAVEMENT 4' WEST OF Q NORTH

S.L.M. 623 + 79

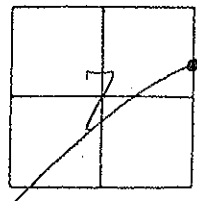

RESET MAG/WASHER  
 11/04/04  
 M.B.

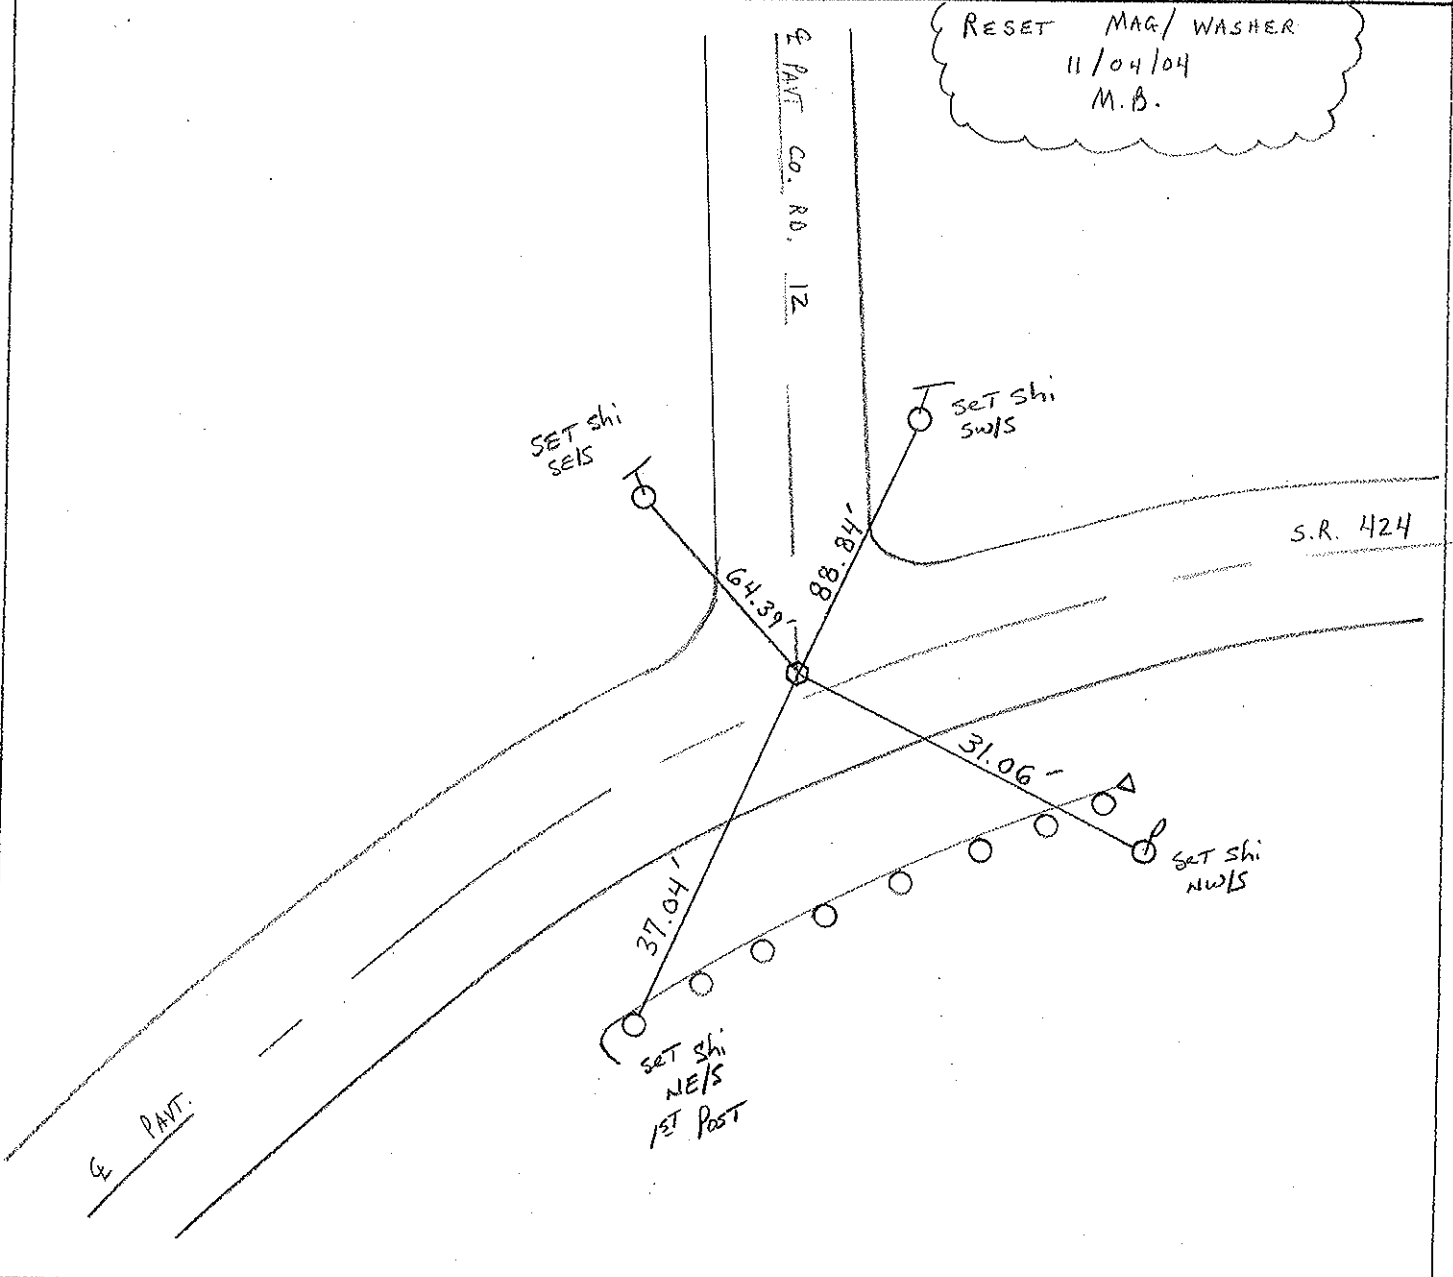

# O.D.O.T. DISTRICT 2 SURVEY OFFICE

PERSONNEL

REFERENCE NO. 54

SHEET 11 OF 26

NOTES D. CURTIS

H.C. CANTERBURY

DATE 4-18-94

ROUTE S.R. 424

R.C. HERMILLER

WEATHER CLOUDY

COUNTY HENRY

CORDS

TEMP. +65

TOWNSHIP LIBERTY

VOGEL

SECTION 7

T 5 N R 7 E



TYPE MONUMENT RESET P.K./WASHER 8-2-94 CAL

ON SURFACE - BELOW Yes

LEFT - PAV'T. - RIGHT 35'

15.8 TO RT EDGE PAVEMENT

S.L.M. 630701

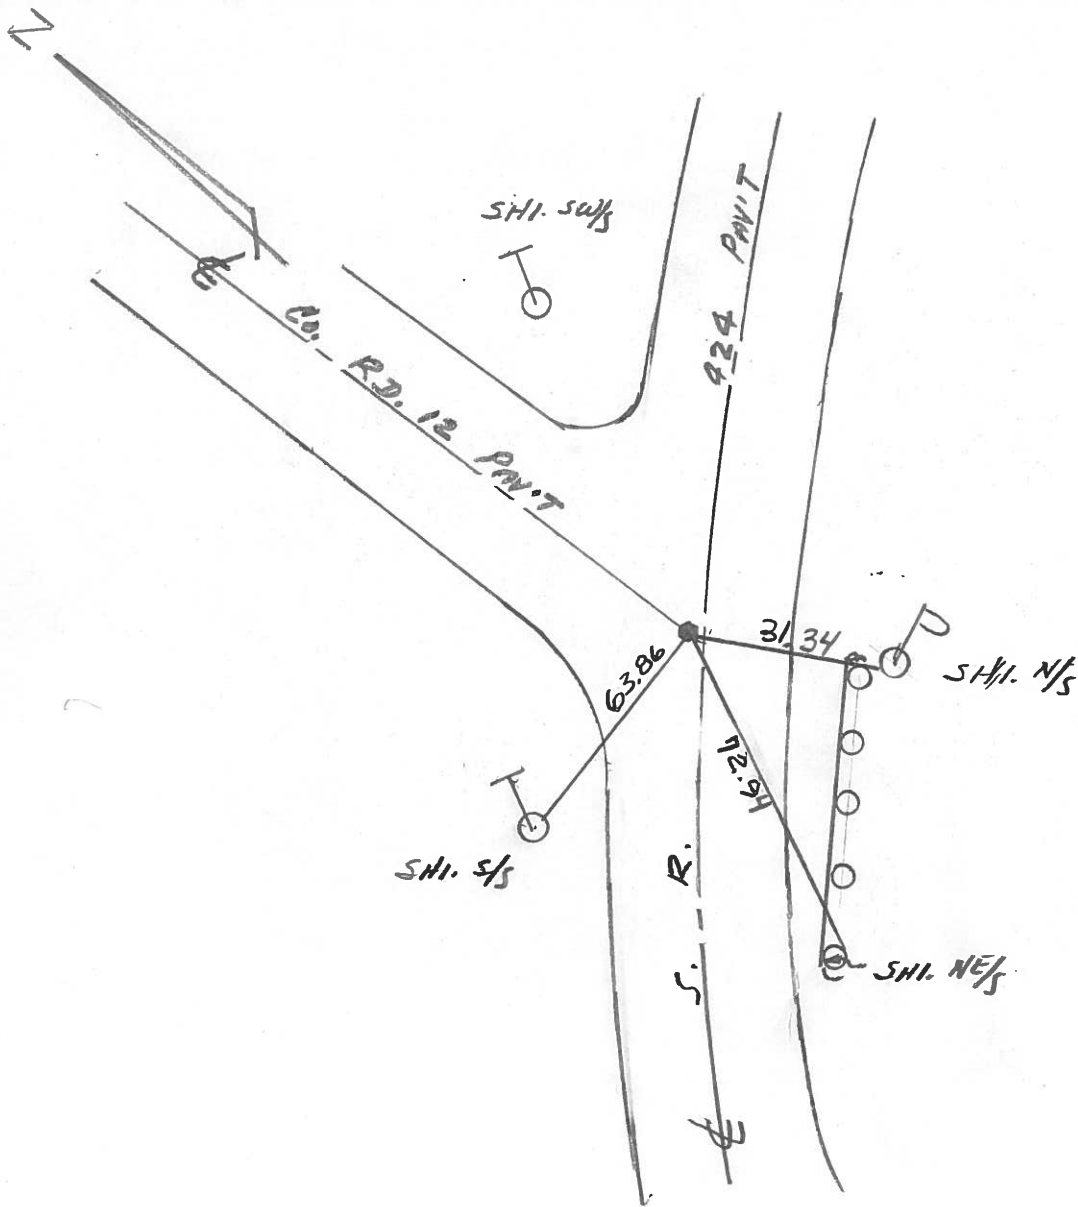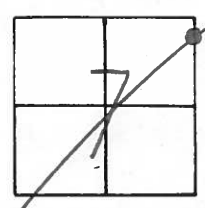

County Henry S.R. 424

Date 9 July 82

Township Harrison Liberty

Weather Fair

Section 7

Temp. 76°


T N, R E

Personnel J. Stone


P. Neuse

R. Michalak

D. Curtis

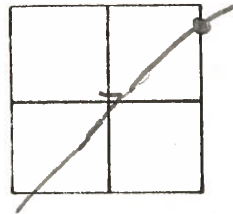

REF. No. 54

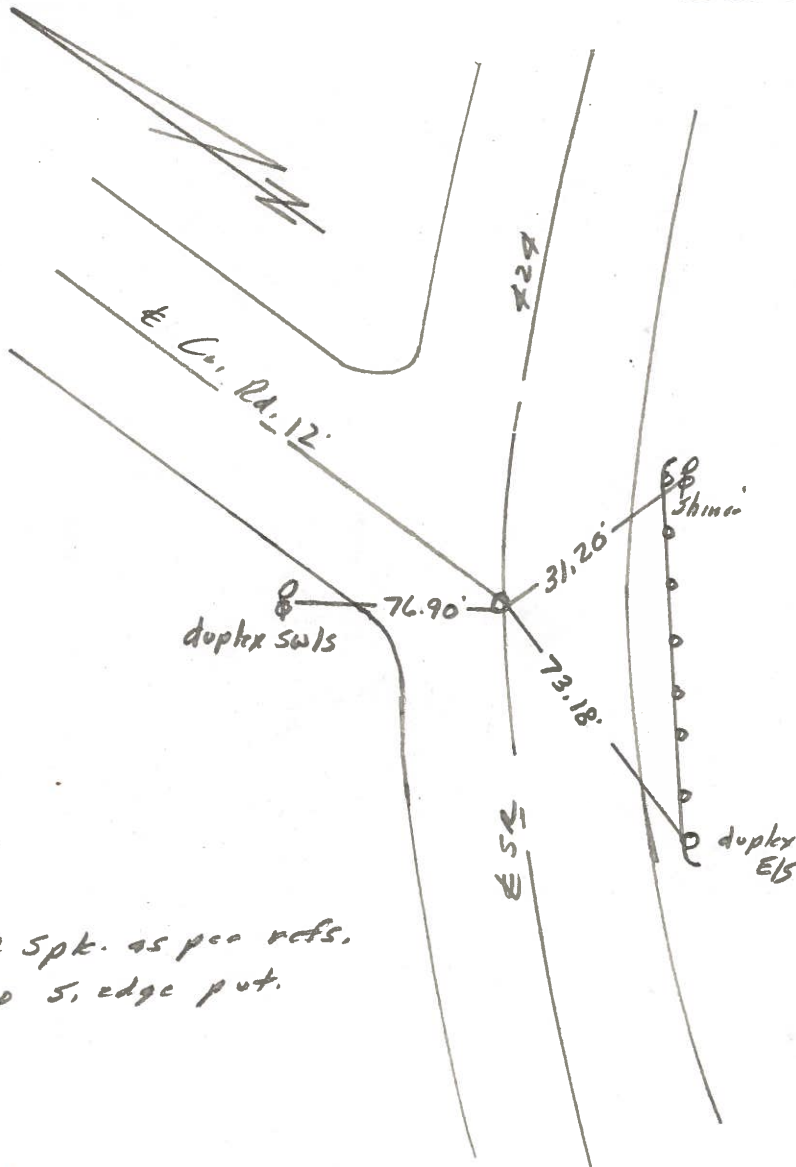

Set RR Spt. as per refs.  
14.6' to S. edge put.



PERSONNEL	TITLE	PERSONNEL	TITLE
Tomsic			
Neuser			
Granata			
Vanyo			

COUNTY HENRY DATE Sept. 4, 1973

S. R. 424 WEATHER \_\_\_\_\_

SEC. \_\_\_\_\_ TEMP. \_\_\_\_\_

DESCRIPTION \_\_\_\_\_ LEFT \_\_\_\_\_ CENTER LINE \_\_\_\_\_ RIGHT \_\_\_\_\_ JOB NO. \_\_\_\_\_

