



O.D.O.T. DISTRICT 2 SURVEY OFFICE (USE ONLY)

PERSONNEL _____ REFERENCE NO. 55 SHEET 25 OF 25
 NOTES HOMAN DATE 09/08/04 ROUTE SR 424
 H.C. LEU WEATHER WINDY COUNTY HENRY
 R.C. MEYER TEMP. +65° TOWNSHIP LIBERTY
 _____ SECTION 8
 _____ T 5 N R 7 E

TYPE MONUMENT _____ MAG SPIKE _____
 ON SURFACE - ~~BELOW~~ _____ ON _____
 LEFT - ~~C PAV'T~~ - RIGHT _____ 1.0'
10.7' TO LT EDGE PAVEMENT
 S.L.M. _____ 649+87
 Grid: Northing: 639018.547 Easting: 1533327.923

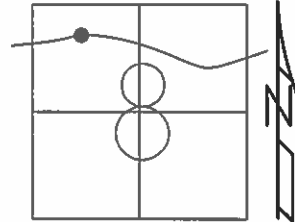

RECORD:
 SET MAG/WASHER
 11/04/04
 MB
 GPS, REF57

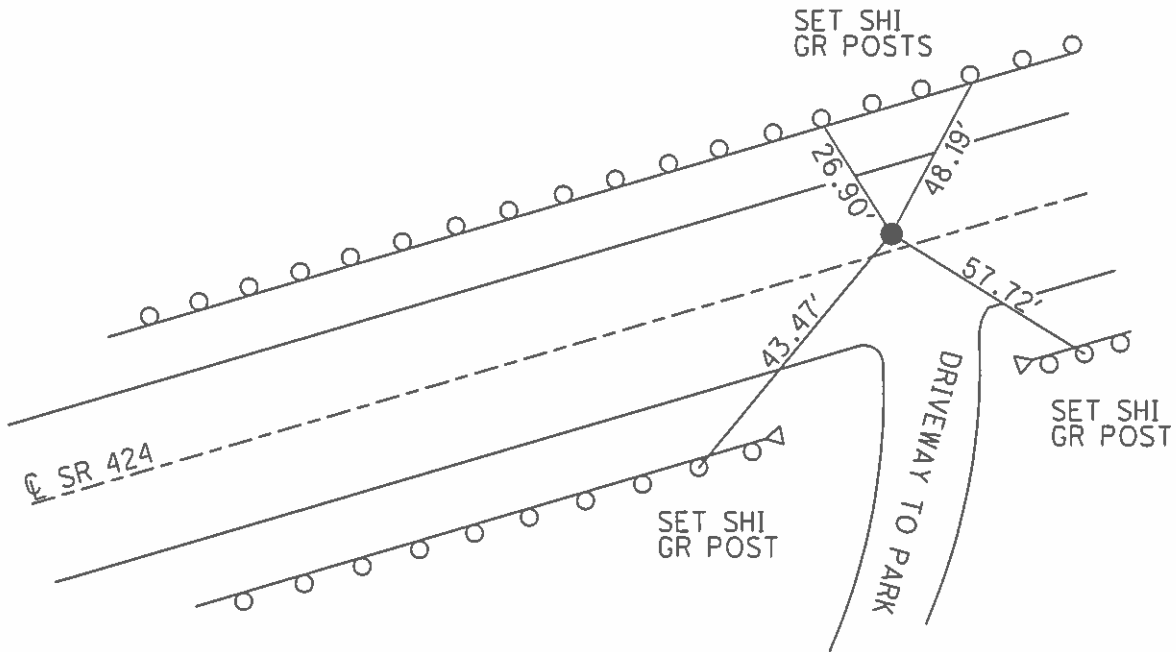

O.D.O.T. DISTRICT 2 SURVEY OFFICE

PERSONNEL

REFERENCE NO. 55

SHEET 21 OF 29

NOTES BARNHISEL

H.C. CANTERBURY

R.C. HOOVER

MC-DRAWING

DATE 9/08/04

WEATHER WINDY

TEMP. +65°

ROUTE S.R. 424

COUNTY HENRY

TOWNSHIP LIBERTY

SECTION 8

T 5 N R 7 E


TYPE MONUMENT P.K. NAIL

ON SURFACE - ~~BELOW~~ SURFACE


LEFT-☉ PAV'T. - RIGHT 1.0' LT ☉

10.7' TO LT EDGE PAVEMENT

S.L.M. 649+87

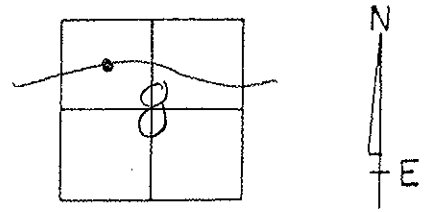

RESET MAG/WASHER
 11/04/04
 M.B.

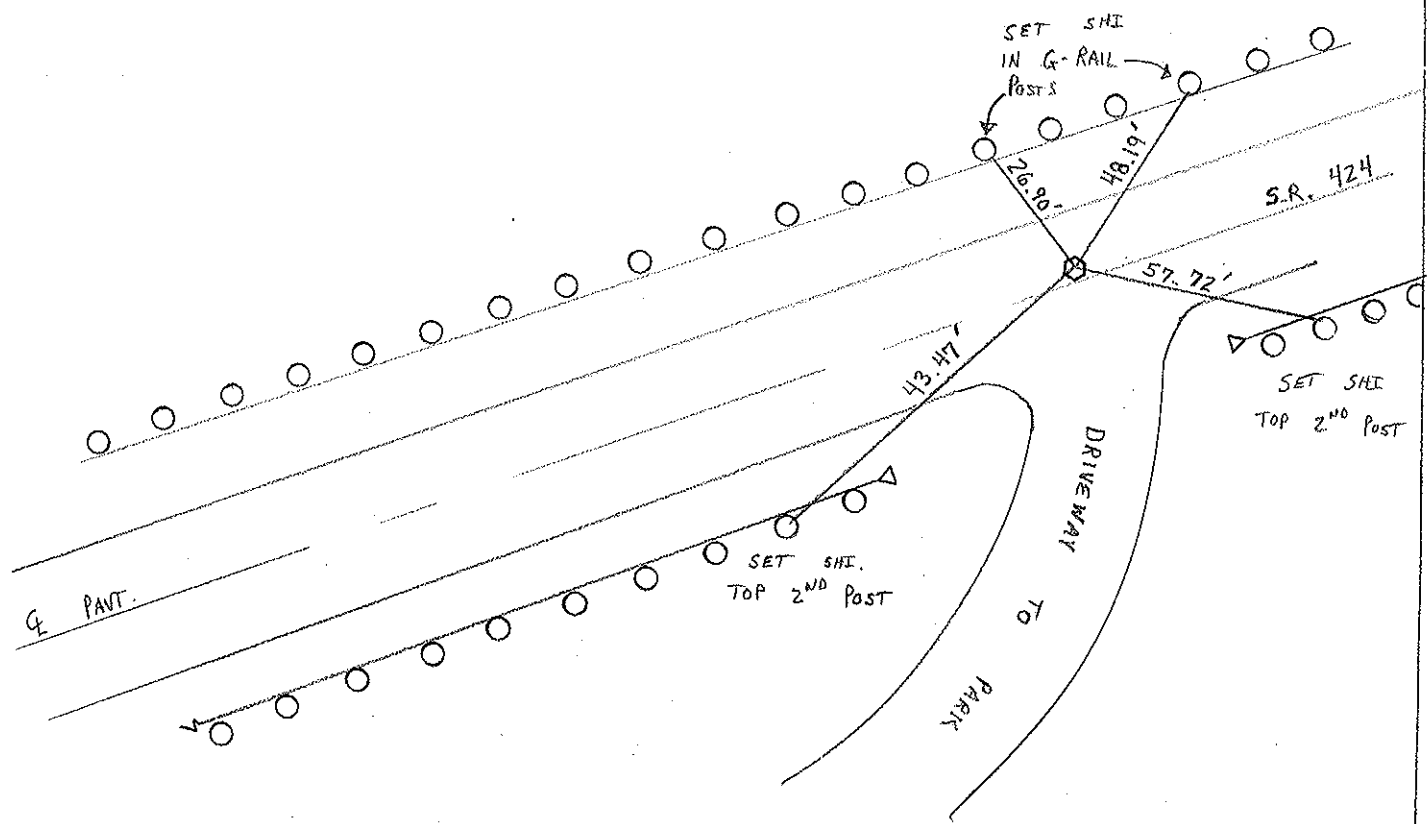

O.D.O.T. DISTRICT 2 SURVEY OFFICE

PERSONNEL

REFERENCE NO. 55

SHEET 13 OF 26

NOTES J. CURTIS

H.C. CANTERBURY

DATE 4-18-94

ROUTE S.R. 424

R.C. HERMILLER

WEATHER WINDY

COUNTY HENRY

CORDES

TEMP. +65

TOWNSHIP LIBERTY

VOGEL

SECTION B

Set P.K. / WASHER
8-2-94
C.L.

T. 5 N. R. 7 E



TYPE MONUMENT S.M. R.R. SPK.

ON SURFACE - BELOW 2" BELOW

LEFT - ~~C~~ PAV'T. - RIGHT 2.0' Lt. E PAV'T

10.9 TO LT. EDGE PAVEMENT

S.L.M. 656 + 09

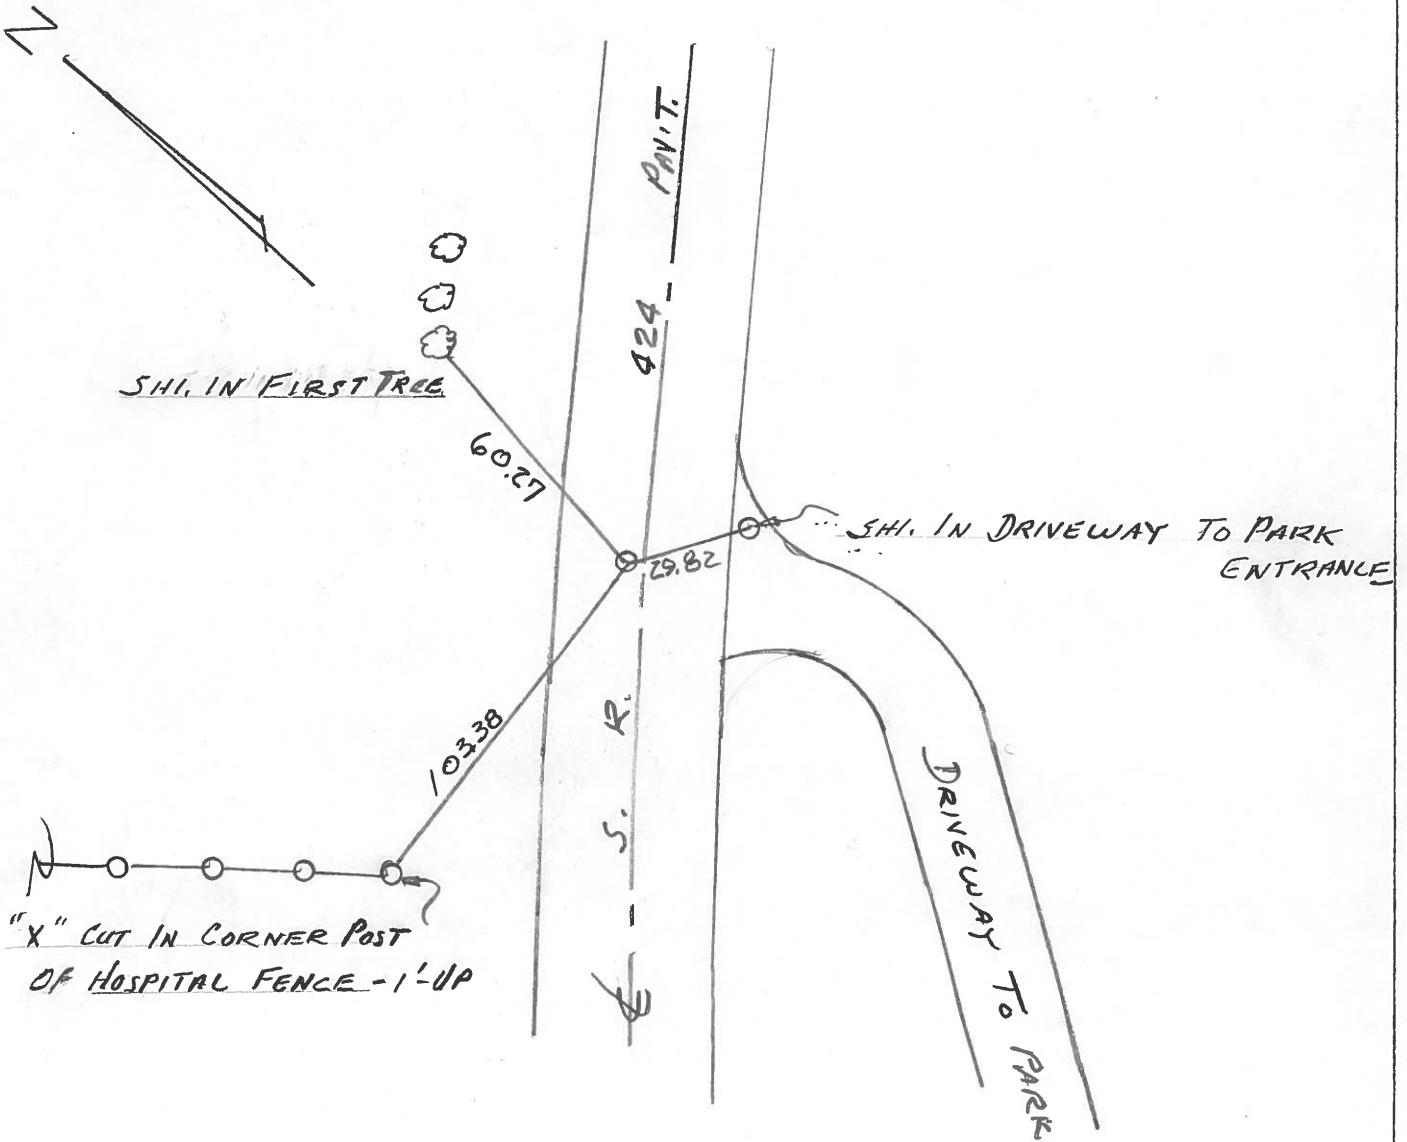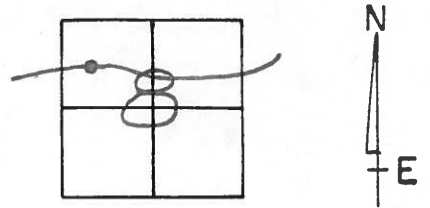

O.D.O.T. DISTRICT 2 SURVEY OFFICE

SHEET 13 OF

County Henry S.R. 424

Date 9 July 82

Township Harrison LIBERTY

Weather Fair

Section 8

Temp. 79°


T N, R E

Personnel I. Stone


P. Heuser

R. Michalek

D. Curtis

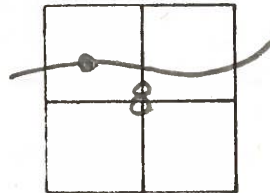

REF. NO. 55

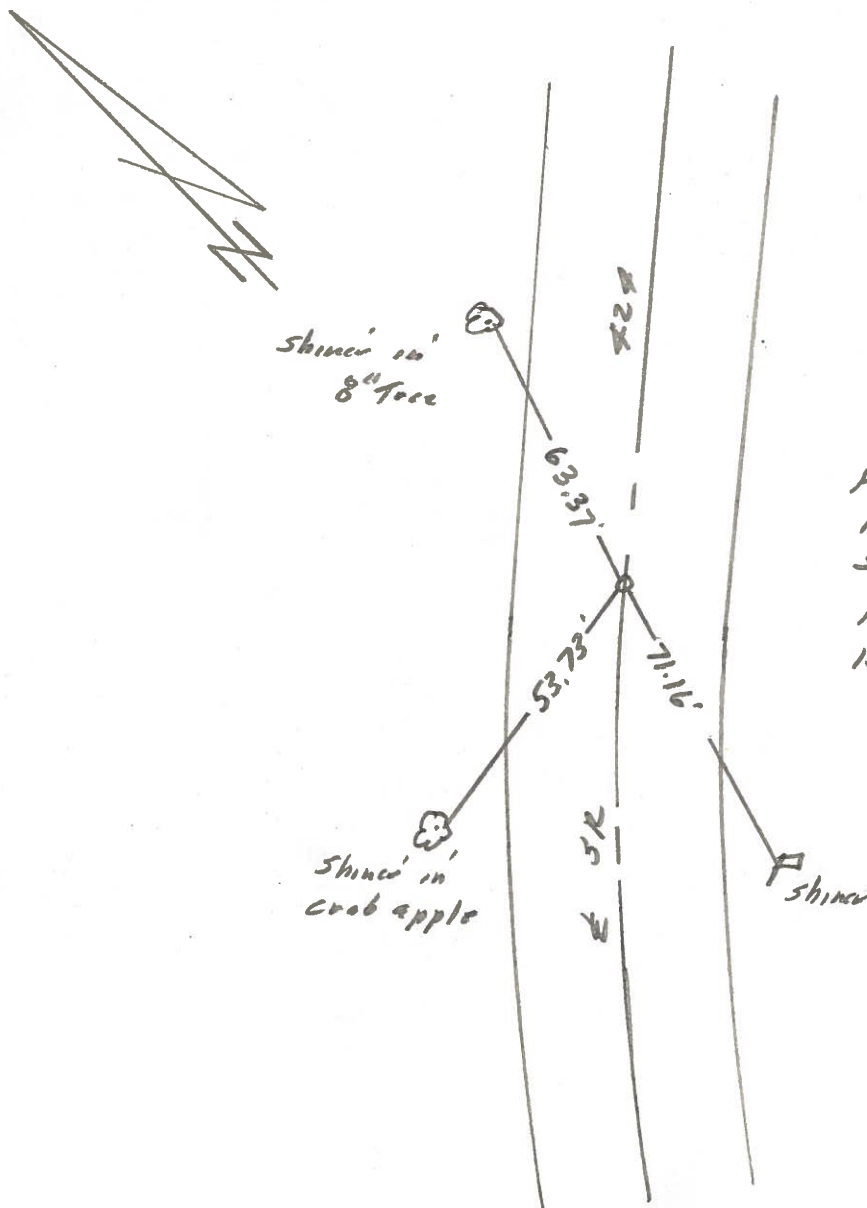

Fd. Small RR Spk.
P.T. curve.
S.L.M. Sta. 648+12
11.1' To N. edge put.
13.0' To S. edge put.