

O.D.O.T. DISTRICT 2 SURVEY OFFICE (USE ONLY)

PERSONNEL _____

REFERENCE NO. 56

SHEET 1 OF 15

NOTES BARNHEISEL DATE 9/8/04

ROUTE SR 424

H.C. CANTERBURY WEATHER WINDY

COUNTY HENRY

R.C. HOOVER TEMP. 65°

TOWNSHIP LIBERTY

SECTION 8

DWG BY NIESE PID _____

T 5 N R 7 E

TYPE MONUMENT P.K./WASHER

ON SURFACE - ~~BELOW~~ ON


OFFSET Q PAVEMENT ON LT : RT

11.6' TO RT EDGE PAVEMENT


STATION: 677+80

HORIZ.DATUM: _____ GEOID: _____

GRID: NORTHING: _____ EASTING: _____

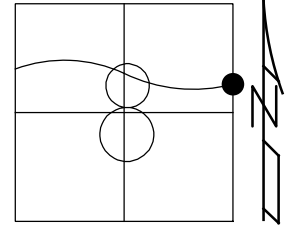

RECORD:
FD P.K./WASHER
9/8/04, MB
SET MAG/WASHER
11/04/04, MB

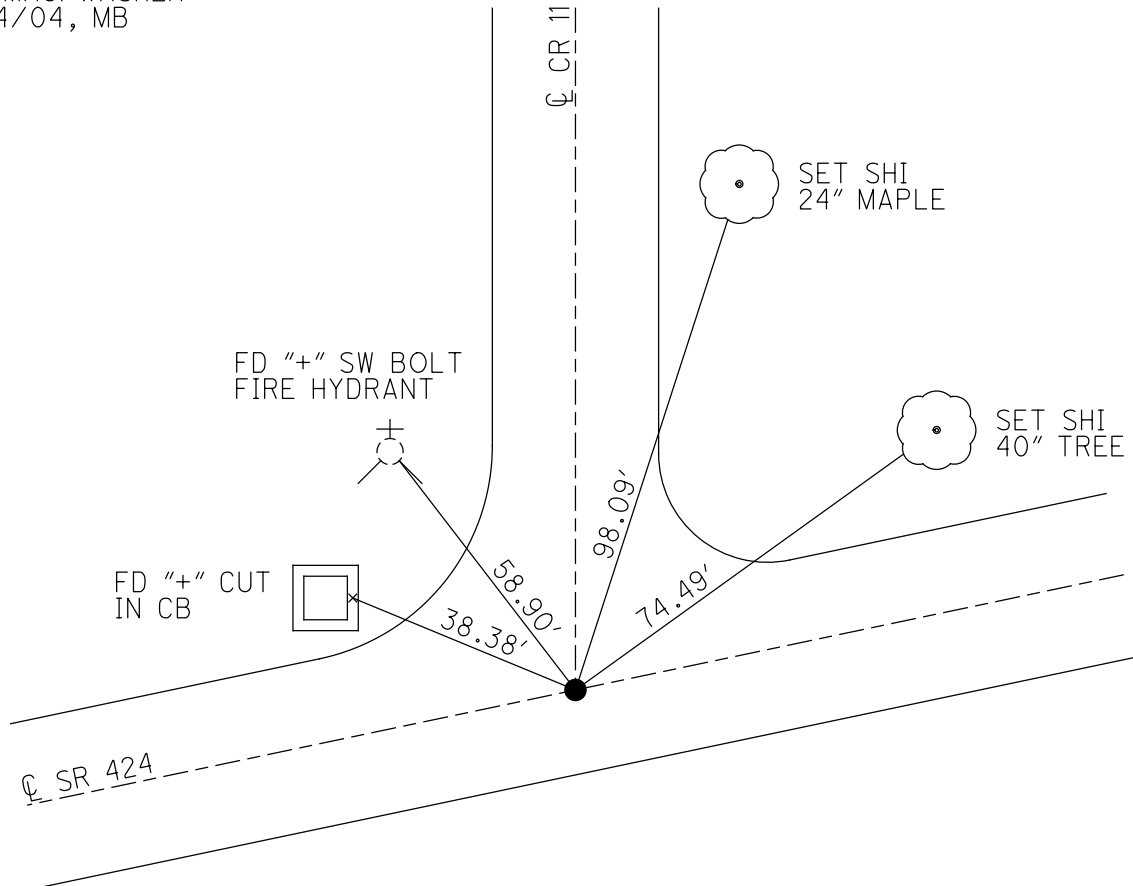

O.D.O.T. DISTRICT 2 SURVEY OFFICE

PERSONNEL

REFERENCE NO. 56

SHEET 22 OF 29

NOTES BARNHISEL

H.C. CANTERBURY

R.C. HOOVER

MC-DRAWING

DATE 9/08/04

WEATHER WINDY

TEMP. +65°

ROUTE S.R. 424

COUNTY HENRY

TOWNSHIP LIBERTY

SECTION 8

T 5 N R 7 E


TYPE MONUMENT P.K. / WASHER

ON SURFACE - BELOW SURFACE


LEFT - & PAV'T. - RIGHT & BOTH

11.6' TO RT. EDGE PAVEMENT

S.L.M. 677 + 80

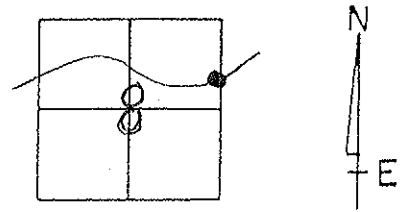

RESET MAG/WASHER
 11/04/04
 M.B.

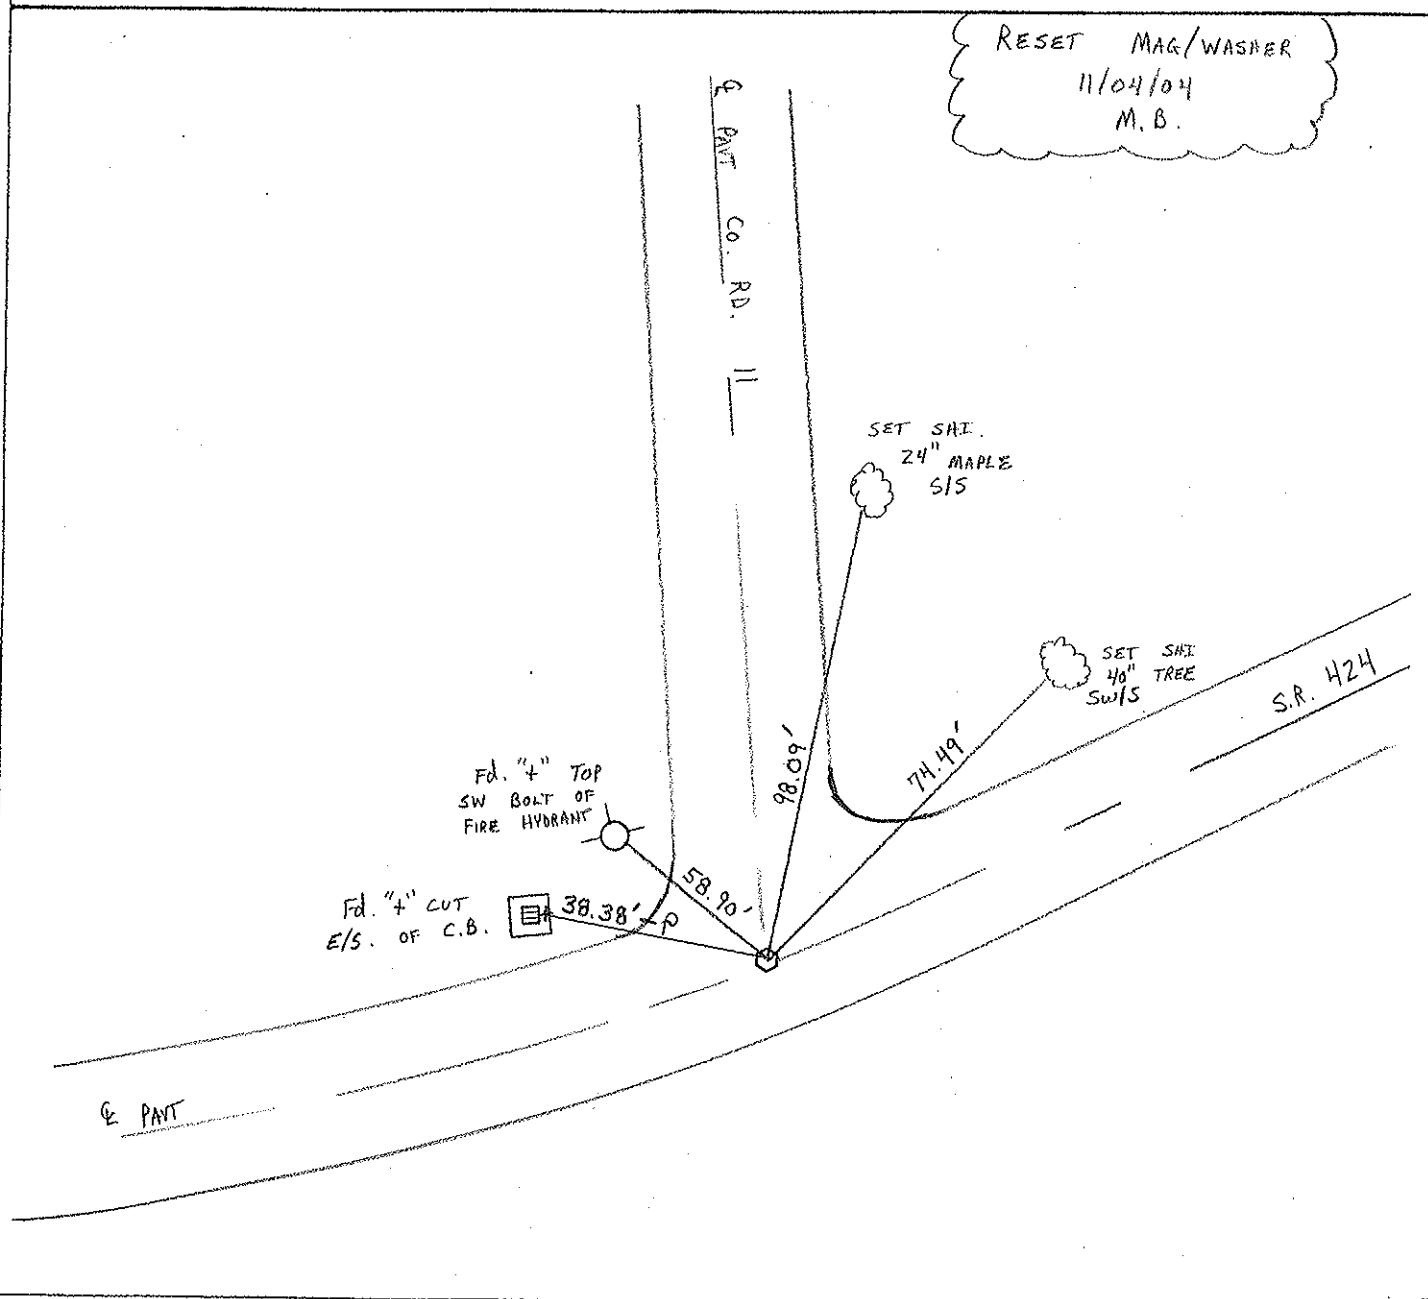

O.D.O.T. DISTRICT 2 SURVEY OFFICE

SHEET 14 OF

County Henry S.R. 424

Date 9 July 82

Township Harrison LIBERTY

Weather Fair

Section 8

Temp. 80°


T N, R E

Personnel I. Stone


P. Newson

R. Michaelok

D. Curtis

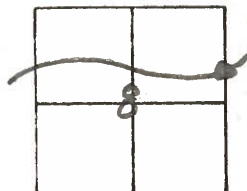

REF. No. 56

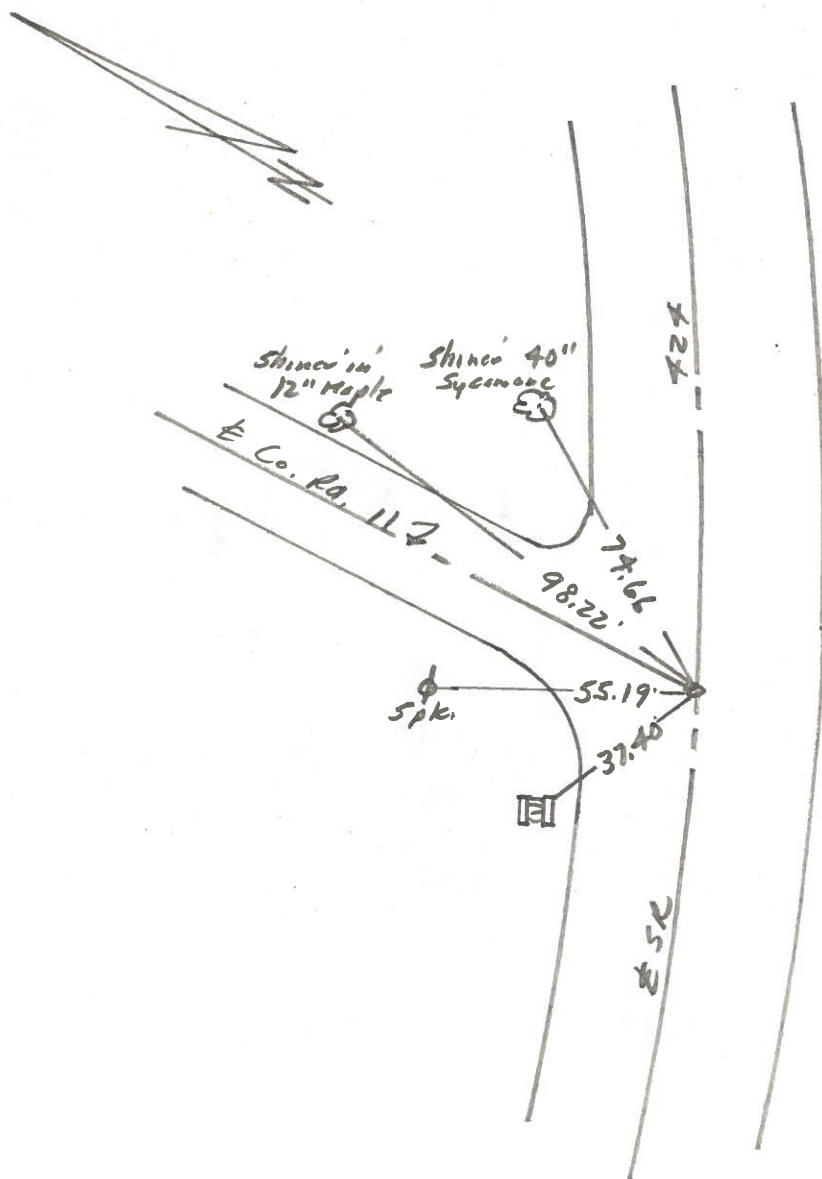

Fd. Roofing nail
52M sta. 675+99
11.5' to s. edge put

P.K. Nail

PERSONNEL TITLE PERSONNEL TITLE

Beach
Ruffer
Knappe
Delventhal

COUNTY Henry DATE Apr 59

S. R. US-24 WEATHER

SEC. 11.22 TEMP.

DESCRIPTION ~~E~~ Constr. JOB NO.

~~E~~ Constr.

CURVE # 3

P.I. Sta. 674+86.13

$\Delta - 38^{\circ} 04\frac{1}{2}'$ Lt.

D - $1^{\circ} 30'$

T - 1318.06'


L - 2538.33'

E - 221'

R - 3819.72'

P.C. Sta. 661+68.07

P.T. Sta. 687+06.40

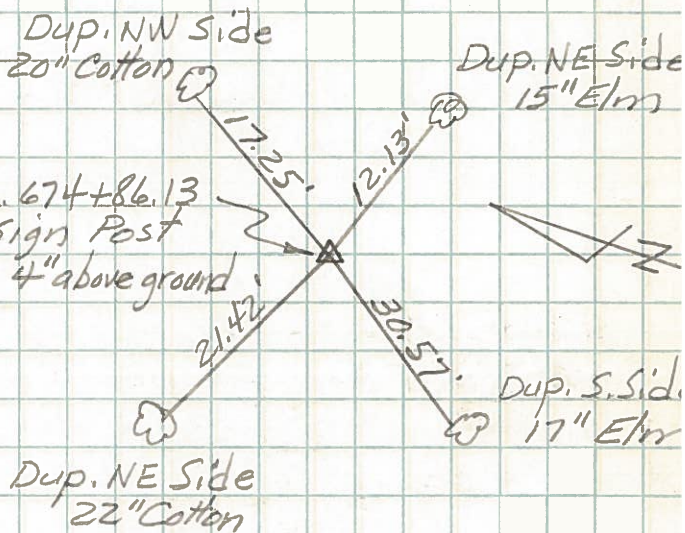

Near Sides of Steel Sign Posts on Top of Backslope

