

O.D.O.T. DISTRICT 2 SURVEY OFFICE (USE ONLY)

PERSONNEL

REFERENCE NO. 60

SHEET 7 OF 15

NOTES BARNHISEL

DATE 9/14/04

ROUTE SR 424

H.C. CANTERBURY

WEATHER CLEAR

COUNTY HENRY

R.C. HOOKER

TEMP. 65°

TOWNSHIP LIBERTY

DWG BY NIESE PID _____

SECTION 9

T 5 N R 7 E

TYPE MONUMENT MONBOX W/ IPIN

ON SURFACE - ~~BELOW~~ ON


OFFSET ☉ PAVEMENT ON LT : RT

14.5' TO RT EDGE PAVEMENT


STATION: 733+06

HORIZ.DATUM: _____ GEOID: _____

GRID: NORTHING: _____ EASTING: _____

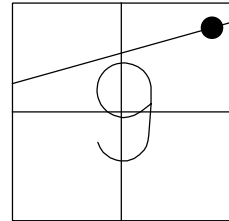

RECORD:
FD MONBOX
W/ IPIN
9/14/04, MC
11/04/04, MC

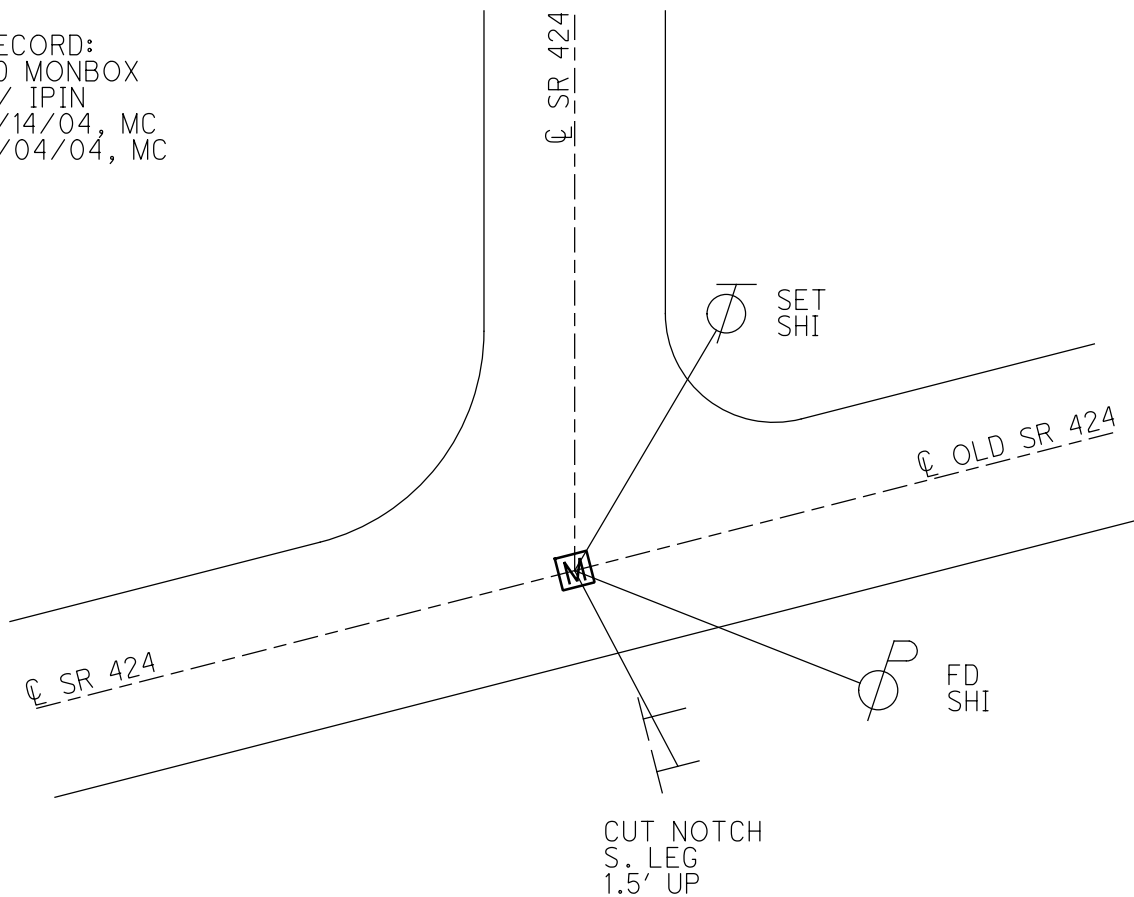

O.D.O.T. DISTRICT 2 SURVEY OFFICE

PERSONNEL

REFERENCE NO. 60

SHEET 28 OF 29

NOTES BARNHSEL

H.C. CANTERBURY

R.C. HOOKER

MC-DRAWING

DATE 9/14/04

WEATHER CLEAR

TEMP. +65

ROUTE S.R. 424

COUNTY HENRY

TOWNSHIP LIBERTY

SECTION 9

T 5 N R 7 E


TYPE MONUMENT MON BOX w/ I-PIN

ON SURFACE - ~~BELOW~~ SURFACE

~~LEFT - C PAV'T. - RIGHT~~ & BOTH PAVTS


14.5' TO RT. EDGE PAVEMENT

S.L.M. 733 + 06

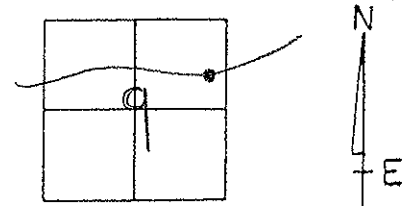

MEASUREMENTS TO I-PIN IN BOX

CHECKED 11/04/04
M.C.

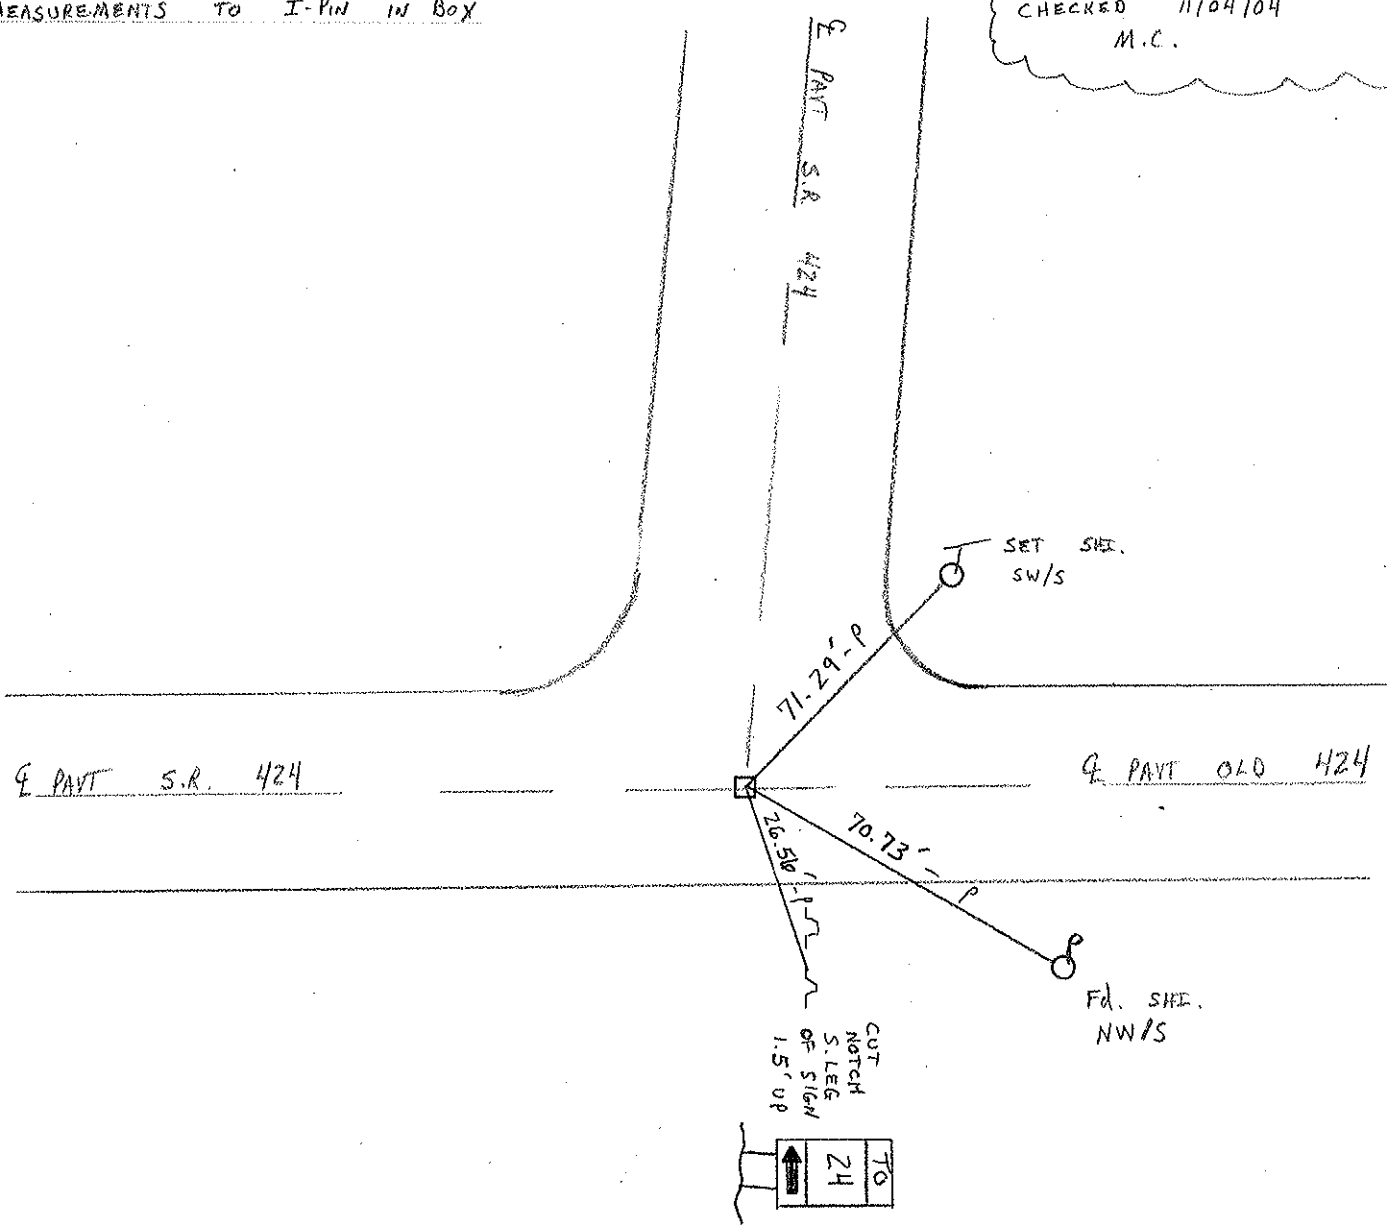

O.D.O.T. DISTRICT 2 SURVEY OFFICE

PERSONNEL

REFERENCE NO. 60

SHEET 20 OF 26

NOTES J. CURTIS

H.C. CANTERBURY

R.C. VOGEL

LOEHRKE

DATE 4-19-94

WEATHER Pt Cloudy

TEMP. +60

ROUTE S. R. 424

COUNTY HENRY

TOWNSHIP LIBERTY

SECTION 9

T 5 N R 7 E



TYPE MONUMENT MON. BOX

ON SURFACE - BELOW ON SURFACE

LEFT- & PAV'T. - RIGHT & BOTH PAV'T'S

14.5 TO RT EDGE PAVEMENT

S.L.M. 739+18

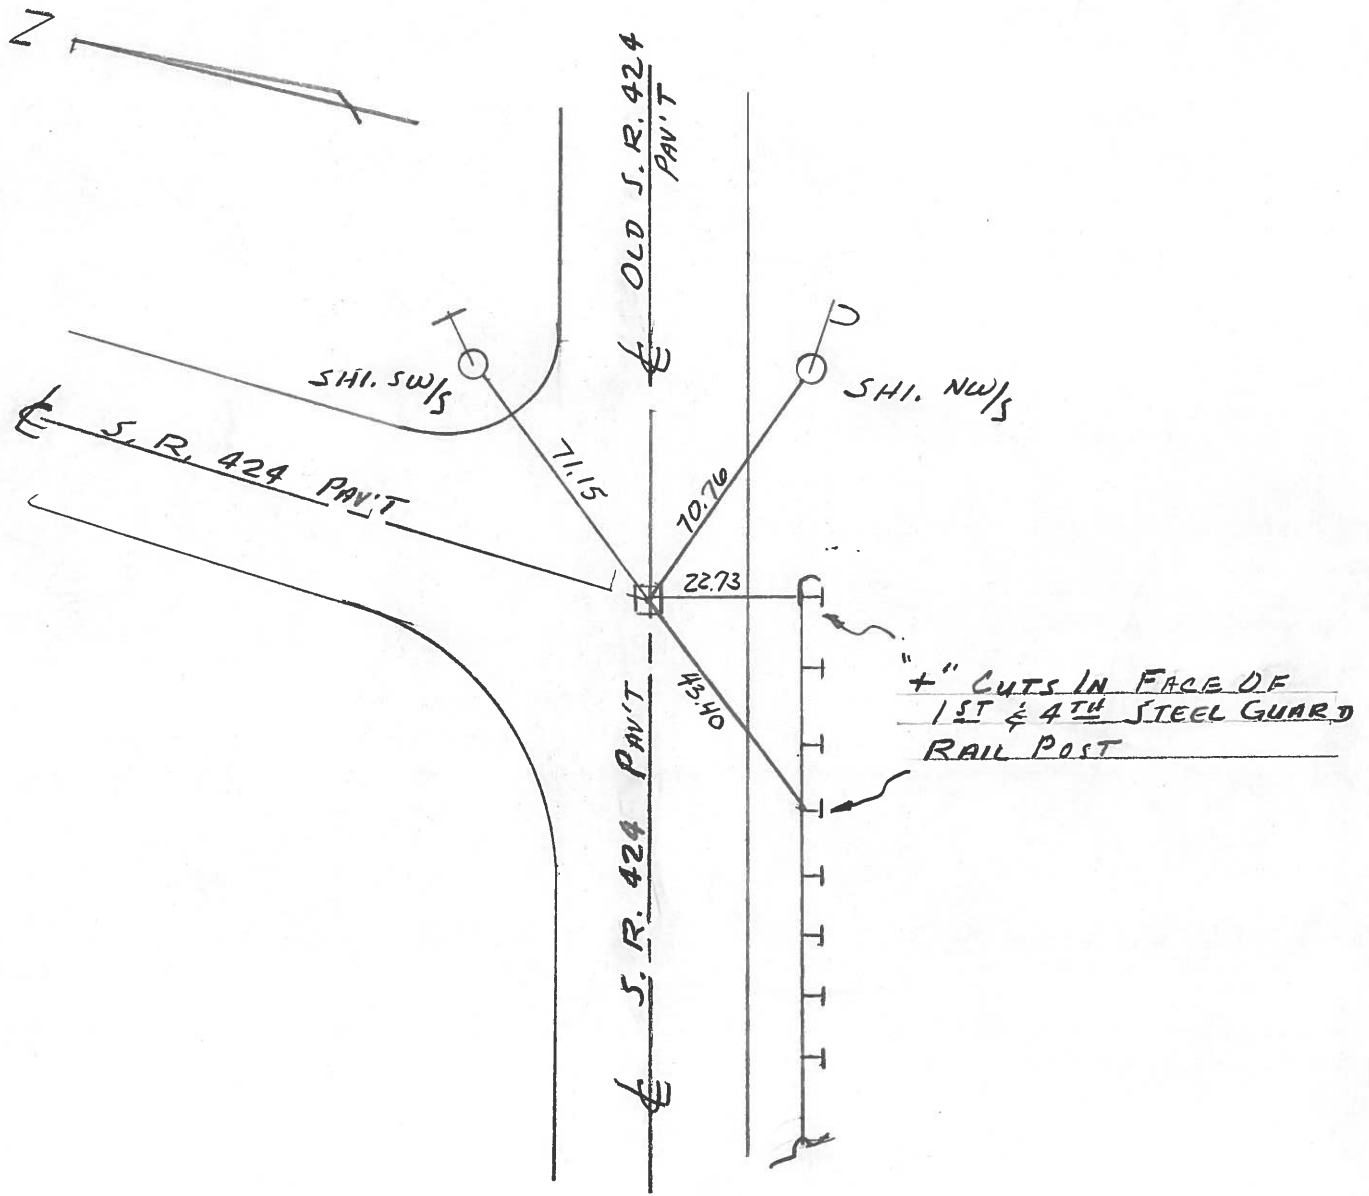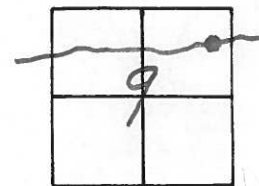

County Henry S.R. 424

Date 9 July 82

Township Harrison LIBERTY


Weather Warm

Section 9

Temp. 89°

T N, R E

Personnel L. Stone

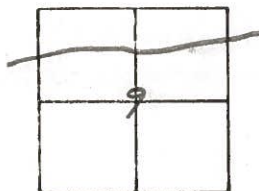


P. Neuser

R. Michalok

D. Curtis

REF. No. 60

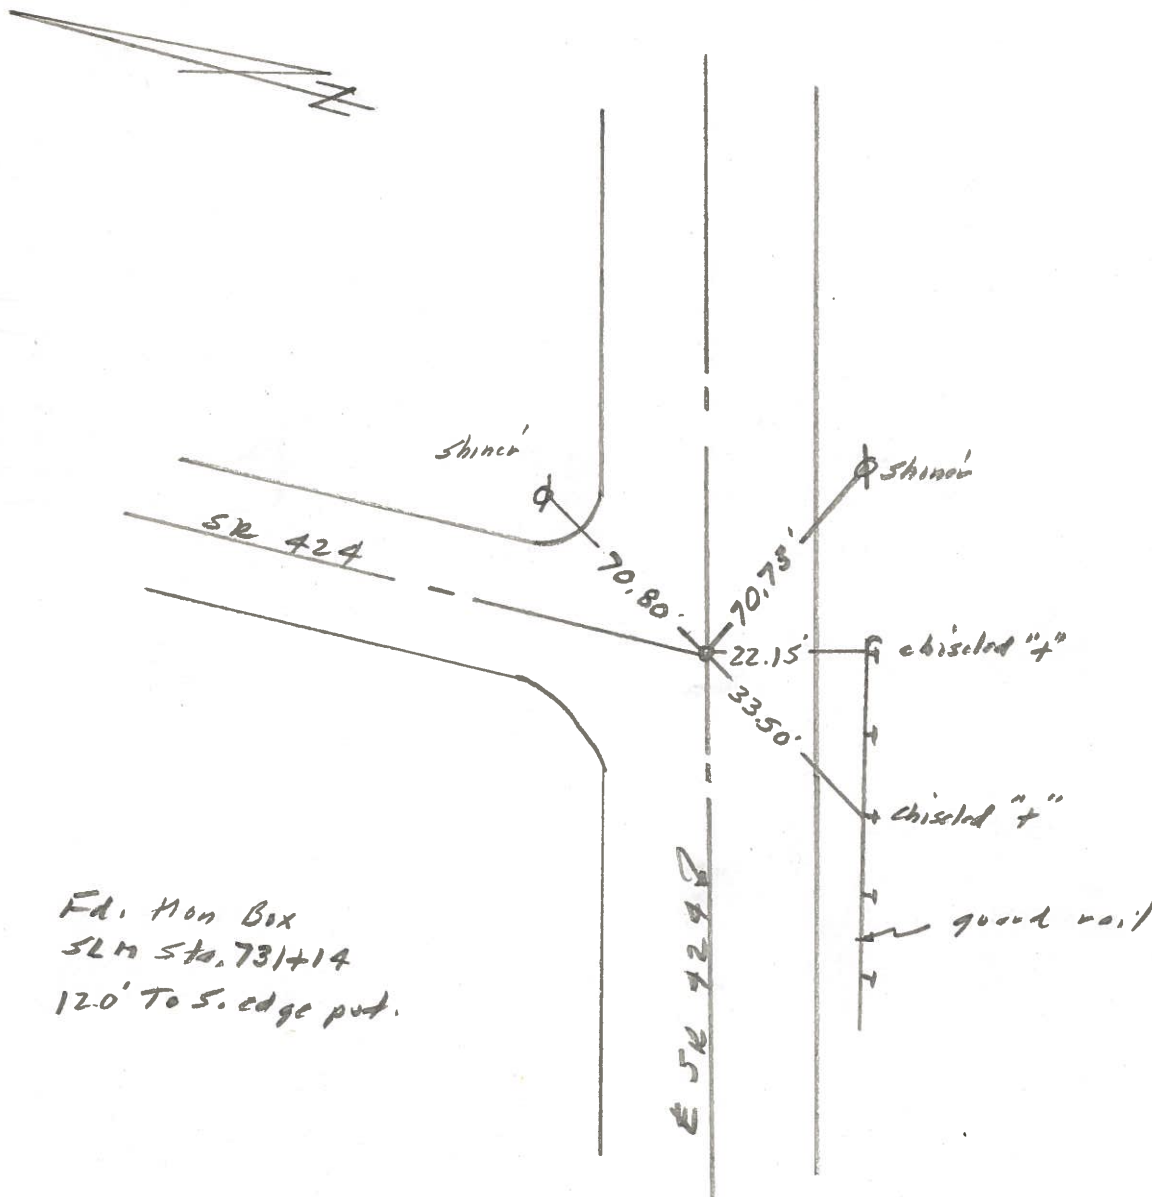

Ed. Mon Box
52m Sta. 731+14
12.0' To S. edge put.

PERSONNEL	TITLE	PERSONNEL	TITLE
Tomsic			
Neuser			
Granata			

COUNTY HEN. DATE JUNE 17, 1971

S. R. 424 WEATHER _____

SEC. E. of Napoleon TEMP. _____

DESCRIPTION _____ LEFT _____ CENTER LINE _____ RIGHT _____ JOB NO. _____

