

O.D.O.T. DISTRICT 2 SURVEY OFFICE (USE ONLY)

PERSONNEL

REFERENCE NO. 62

SHEET 10 OF 15

NOTES CURTIS

DATE 4/19/94

ROUTE (OLD) SR 424

H.C. CANTERBURY

WEATHER PARTLY CLOUDY

COUNTY HENRY

R.C. VOGEL

TEMP. 60°

TOWNSHIP LIBERTY

LOEHRKE

SECTION 9

DWG BY NIESE PID _____

T 5 N R 7 E

TYPE MONUMENT P.K. NAIL

ON SURFACE - ~~BELOW~~ ON _____


OFFSET ☉ PAVEMENT 1.3' LT : ~~RT~~

11.4' TO LT EDGE PAVEMENT


STATION: 762+26

HORZ.DATUM: _____ GEOID: _____

GRID: NORTHING: _____ EASTING: _____

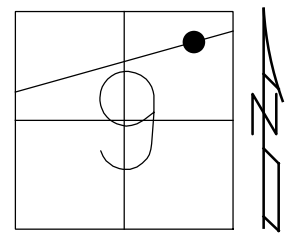

RECORD:
FD P.K. NAIL
4/19/94, MC

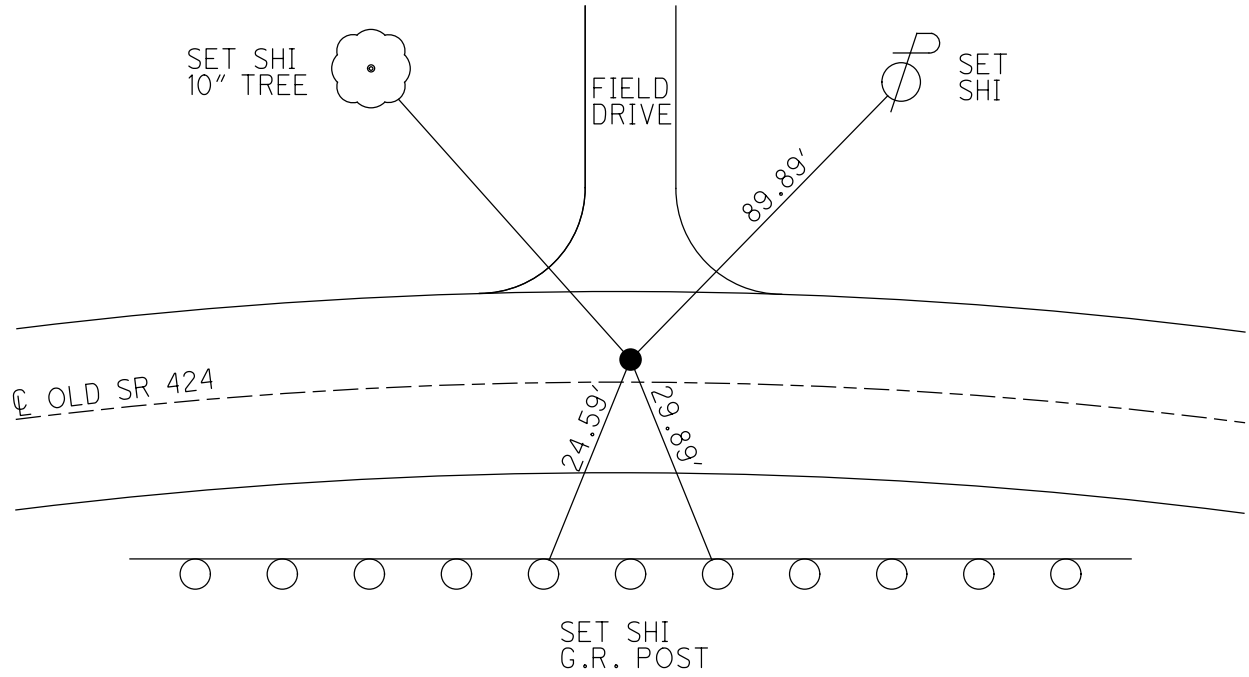

O.D.O.T. DISTRICT 2 SURVEY OFFICE

PERSONNEL

REFERENCE NO. 62

SHEET 22 OF 26

NOTES D. CURTIS

H.C. CANTERBURY

R.C. VOGEL

LOEHRKE

DATE 4-19-94

WEATHER PT CLOUDY

TEMP. 46.0

ROUTE OLD S. R. 424

COUNTY HENRY

TOWNSHIP LIBERTY

SECTION 9

T 5 N R 7 E

TYPE MONUMENT P.K. NAIL

ON SURFACE - BELOW ON SURFACE

LEFT - PAV'T. - RIGHT 1.3' LT. OF PAV'T

11.4' TO LT. EDGE PAVEMENT

S.L.M. 762 + 26

