

O.D.O.T. DISTRICT 2 SURVEY OFFICE (USE ONLY)

PERSONNEL

REFERENCE NO. 63

SHEET 11 OF 15

NOTES CURTIS DATE 4/19/94

ROUTE (OLD) SR 424

H.C. CANTERBURY WEATHER SUNNY

COUNTY HENRY

R.C. VOGEL TEMP. 64°

TOWNSHIP LIBERTY

LOEHRKE

SECTION 9

DWG BY NIESE PID \_\_\_\_\_

T 5 N R 7 E

TYPE MONUMENT SURVEYOR'S CAP

ON SURFACE - ~~BELOW~~ ON


OFFSET Q PAVEMENT ON LT : RT

- TO - EDGE PAVEMENT

STATION: 763+09


HORZ. DATUM: \_\_\_\_\_ GEOID: \_\_\_\_\_

GRID: NORTHING: \_\_\_\_\_ EASTING: \_\_\_\_\_

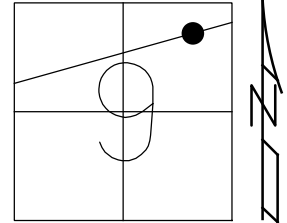

RECORD:  
COULD BE P.T.  
FD SURVEYOR'S CAP  
4/19/94, MC

DIST. 63-63A = 26.38'

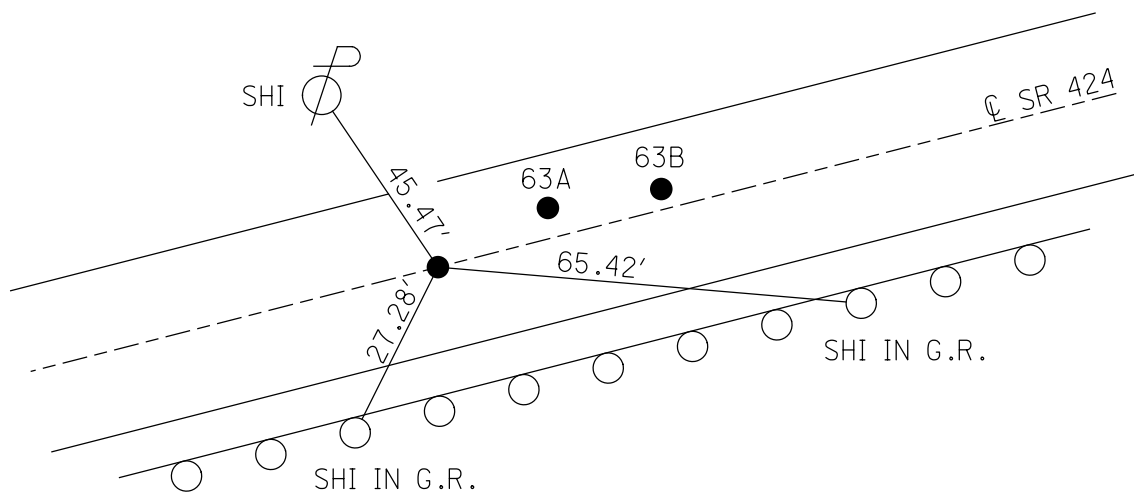

# O.D.O.T. DISTRICT 2 SURVEY OFFICE

PERSONNEL

REFERENCE NO. 63-63A  
63B

SHEET 23 OF 26

NOTES J. CURTIS

H.C. CANTERBURY

R.C. VOGEL

LOENKE

DATE 4-19-94

WEATHER M. Sunny

TEMP. 64

ROUTE OLD S. R. 424

COUNTY HENRY

TOWNSHIP LIBERTY

SECTION 9

T 5 N R 7 E

63 = SURVEYERS CAR  
63-A = P.K. NAIL  
63-B = P.K. NAIL

TYPE MONUMENT 63-A = P.K. NAIL



ON SURFACE - BELOW ALL PTS ON SURFACE

LEFT - 63 - ON E (63-A) 3' Lt. E (63-B) 2.2' Lt. E

11' to L. ED. 12.2' to L. ED.

TO EDGE PAVEMENT

S.L.M. (63) = 763+09 (63-A) = 763+35 (63-B) = 763+58

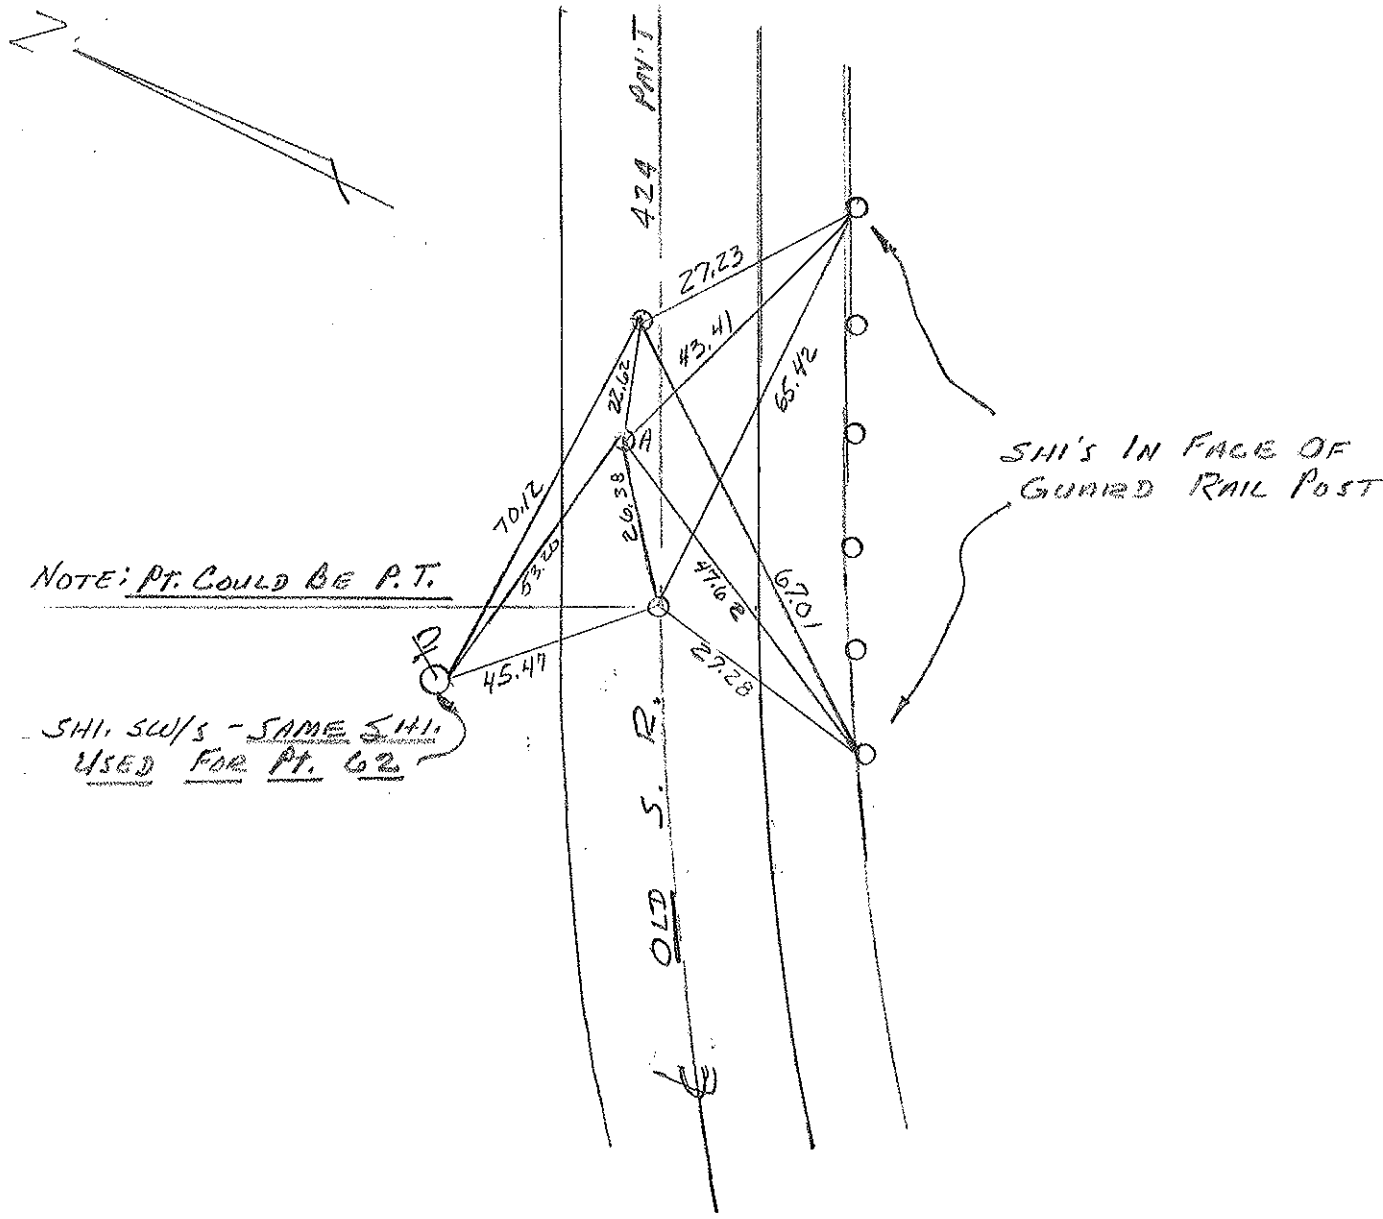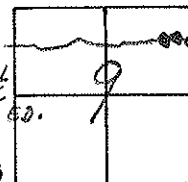

PERSONNEL	TITLE	PERSONNEL	TITLE	COUNTY	DATE
Beach				Henry	Apr 59
Ruffer				S. R. 115-24	WEATHER
Khipe				SEC. 11.22	TEMP.
Delventhal					

DESCRIPTION ± constr. JOB NO. \_\_\_\_\_

