

ODOT (D-2)


1994 TWO-LANE RESURFACING PROGRAM

DATE April 27 - 1992
 PERSONNEL Loehrkig
Simon
Moser

PRIORITY NO. _____ PART _____ OF _____ SHEET 1 OF 28
 COUNTY Lucas ROUTE S.R.2 SECTION 4.12
 BEGIN LOG (SLM) 4.12 TERMINII Const Joint 2217+95
 END LOG (SLM) _____ TERMINII ± 1000 East of Holland Rd 574+00
 TOTAL LENGTH _____ MILES
 MUNICIPALITY _____ BEGIN LOG (SLM) _____ END LOG (SLM) _____
 MUNICIPALITY _____ BEGIN LOG (SLM) _____ END LOG (SLM) _____

PROPOSED WORK: _____
 PAVEMENT _____ SHOULDER _____
 OTHER _____

STATION ESTABLISHED FROM:

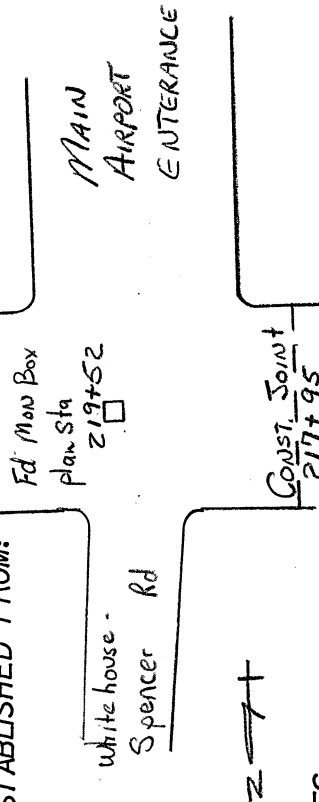

STRUCTURES:

NUMBER	STATION	WIDTH	LENGTH	PROPOSED WORK
	244+52 to 246+60	62'	208	No Work, From Approach to End of Approach From 243+91 to 247+18

RAILROAD CROSSING: None STATION _____ NO. TRACKS _____ LENGTH ALONG C L _____ FT
 NAME _____ (NO WORK)

1994 TWO-LANE RESURFACING PROGRAM
INTERSECTIONS

COUNTY LUCAS ROUTE S.R. 2 SECTION 4.12

L = PROP PAVT DEPTH (IN) X 10; W = WIDTH @ MOUTH; W-I = WIDTH @ THROAT

STATION	SIDE	NAME OR NO.	L	W	W-I	ASPH	CONC	REMARKS
219+18	L+	AIRPORT DRIVE	15'	145'	97'	X		AIRPORT MAIN ENVI.
219+79	R+	Whitehouse-Spencer	15'	147'	82'	X		
232+42	R+	E. Service Rd	15'	87'	40'	X		AIRPORT Service Drive
258+28	L+	GARDEN Rt	15'	108'	43'	X		
258+66	R+	GARDEN Rd	15'	115'	53'	X		
278+40	R+	EBER Rd (South)	15'	125'	70'	X		
284+20	L+	EBER Rd (North)	15'	160'	46'	X		
302+97	R+	MESCHER Rd	15'	80'	38'	X		
302+97	L+	MESCHER Rd	15'	82'	34'	X		
349+30	R+	CRISSEY Rd	15'	128'	70'	X		
349+50	L+	CRISSEY Rd	15'	127'	58'	X		
377+01	L+	OLD AIRPORT Hwy	15'	96'	43'	X		
417+01	R+	ALBON Rd	15'	136'	58'	X		
417+05	L+	ALBON Rd	15'	135'	58'	X		
440+50	R+	ROY ROFT	15'	116'	53'	X		
444+40	L+	TIMBER WOLF	15'	160'	78'	X		
446+25	R+	GUNN	15'	116'	49'	X		
456+15	R+	CONNECTICUT	15'	128'	60'	X		
459+00	L+	IFORD	15'	98'	35'	X		
460+98	R+	RHODE ISLAND	15'	110'	51'	X		

COUNTY LUCAS ROUTE S.R. 2 SECTION 4.21

L = PROP PART DEPTH (IN) X 10; W = WIDTH @ MOUTH; W-I = WIDTH @ THROAT

[illegible]

DATE 4-30-93

SHEET 4 OF 28

1994 TWO-LANE RESURFACING PROGRAM
PAVEMENT DATANOTE: LOCATE ALL
CHANGES IN PAVT WIDTH

COUNTY Lucas ROUTE SR 2 SECTION 4.12

MILE MARKER	STATION	LEFT BERM WIDTH (TYPE)	PAVEMENT WIDTH OUT/OUT WHITE LINES	RIGHT BERM WIDTH (TYPE)
	217+95	10' Asph	62'	11' Asph
	224+10	10' Asph	61'	11' Asph
	227+12	10' " BEGIN TAPER	50'	11' Asph
5	264+17	10' " END TAPER	50'	11' Asph
	272+77	7' " "	50'	8' "
	278+00	7' " "	64'	8' "
	282+00	9' " "	58'	9' "
	284+90	9' " "	55'	9' "
	288+00	8' " "	51'	9' "
	302+00	8' " "	52'	8' "
6	315+85	8' " "	52'	8' "
	341+00	8' " "	52'	8' "
	344+00	7' " "	60'	7' "
	348+00	7' " "	63'	8' "
	354+00	7' " "	62'	8' "
	358+79	8' " "	51'	8' "
7	369+00	8' "	51'	8' "
	377+65	2' CURB & GUTTER BEGIN STA 377+65	52'	2' CURB & GUTTER BEGIN STA 377+65
	410+20	2' GUTTER	52'	2' GUTTER
	412+65	2' GUTTER PAVED OVER	62'	2' GUTTER PAVED OVER
	421+40	" " "	62'	" " "
8	421+40	" " "	62'	" " "

PERSONNEL
LOEHLKE

TITLE

PERSONNEL

TITLE

COUNTY Lucas

DATE 4-29-93

Crew

S. R.

WEATHER Cloudy

SEC. 4.12

TEMP. 70

DESCRIPTION


PAVT

WIDTHS

LEFT

CENTER LINE

RIGHT

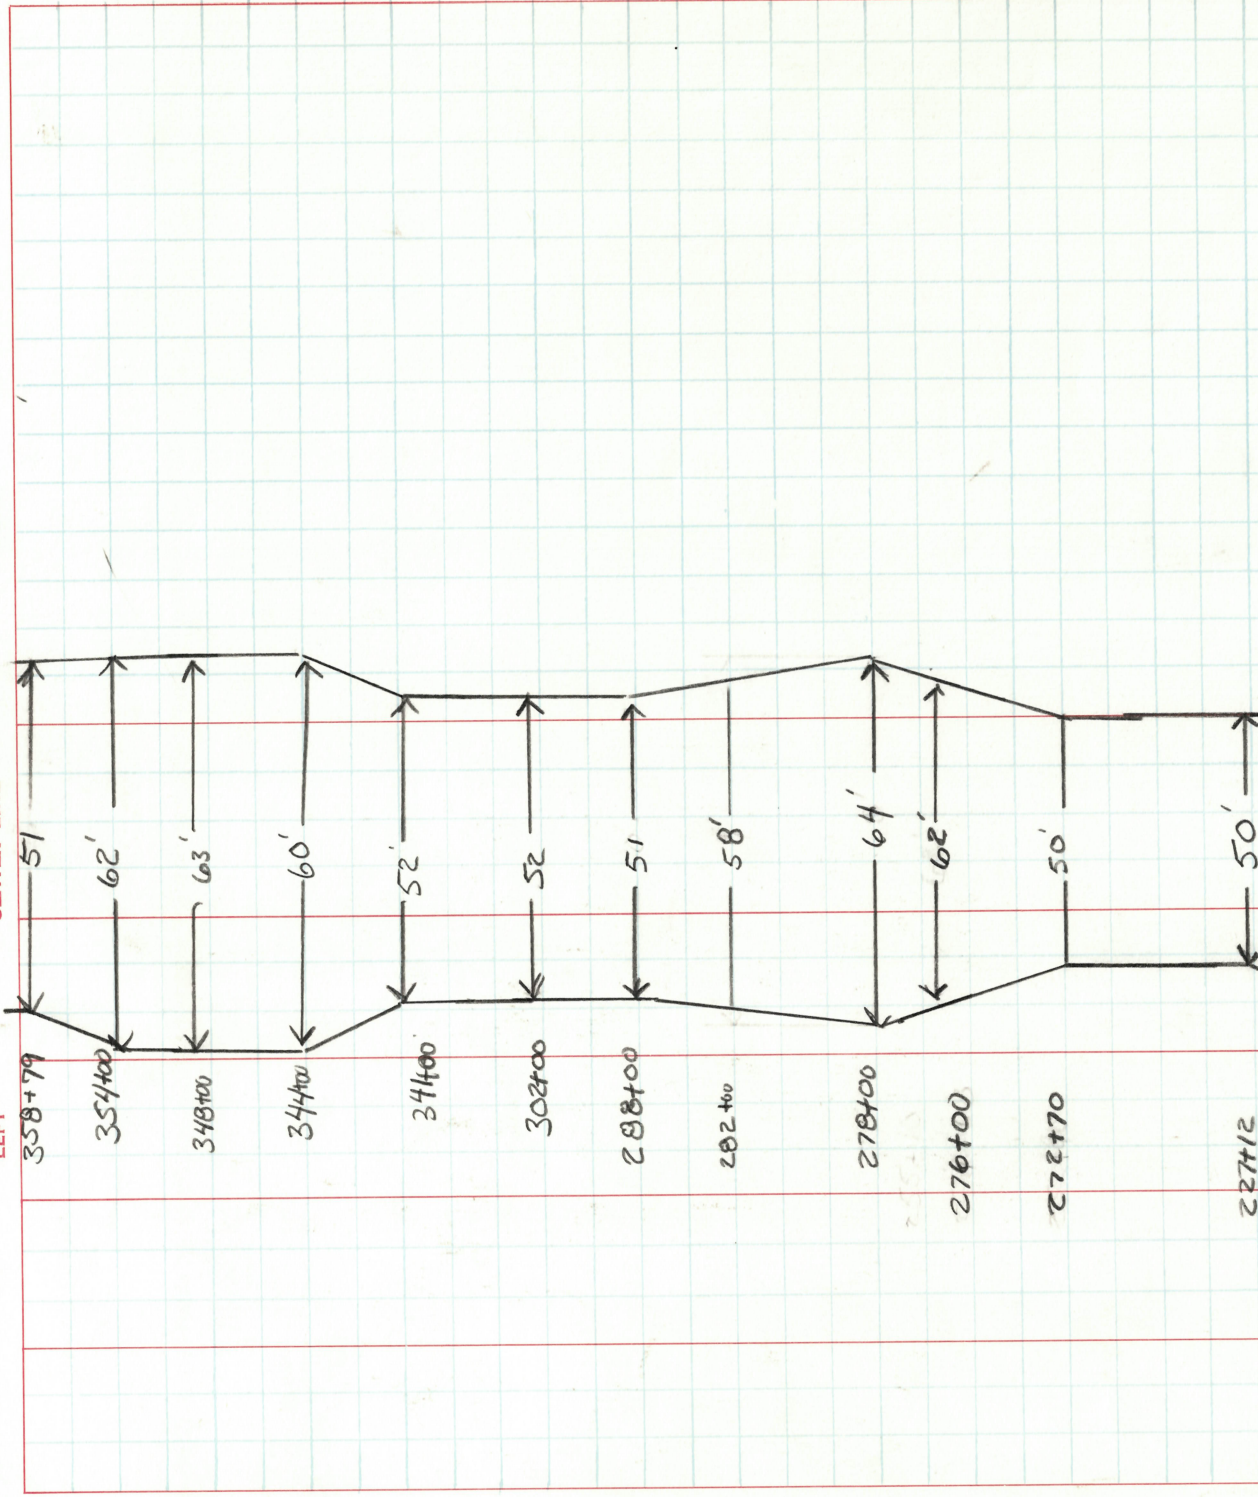


DATE 5-3-93

WEATHER Cloudy

WEATHER

TEMP. + 70

JOB NO. _____

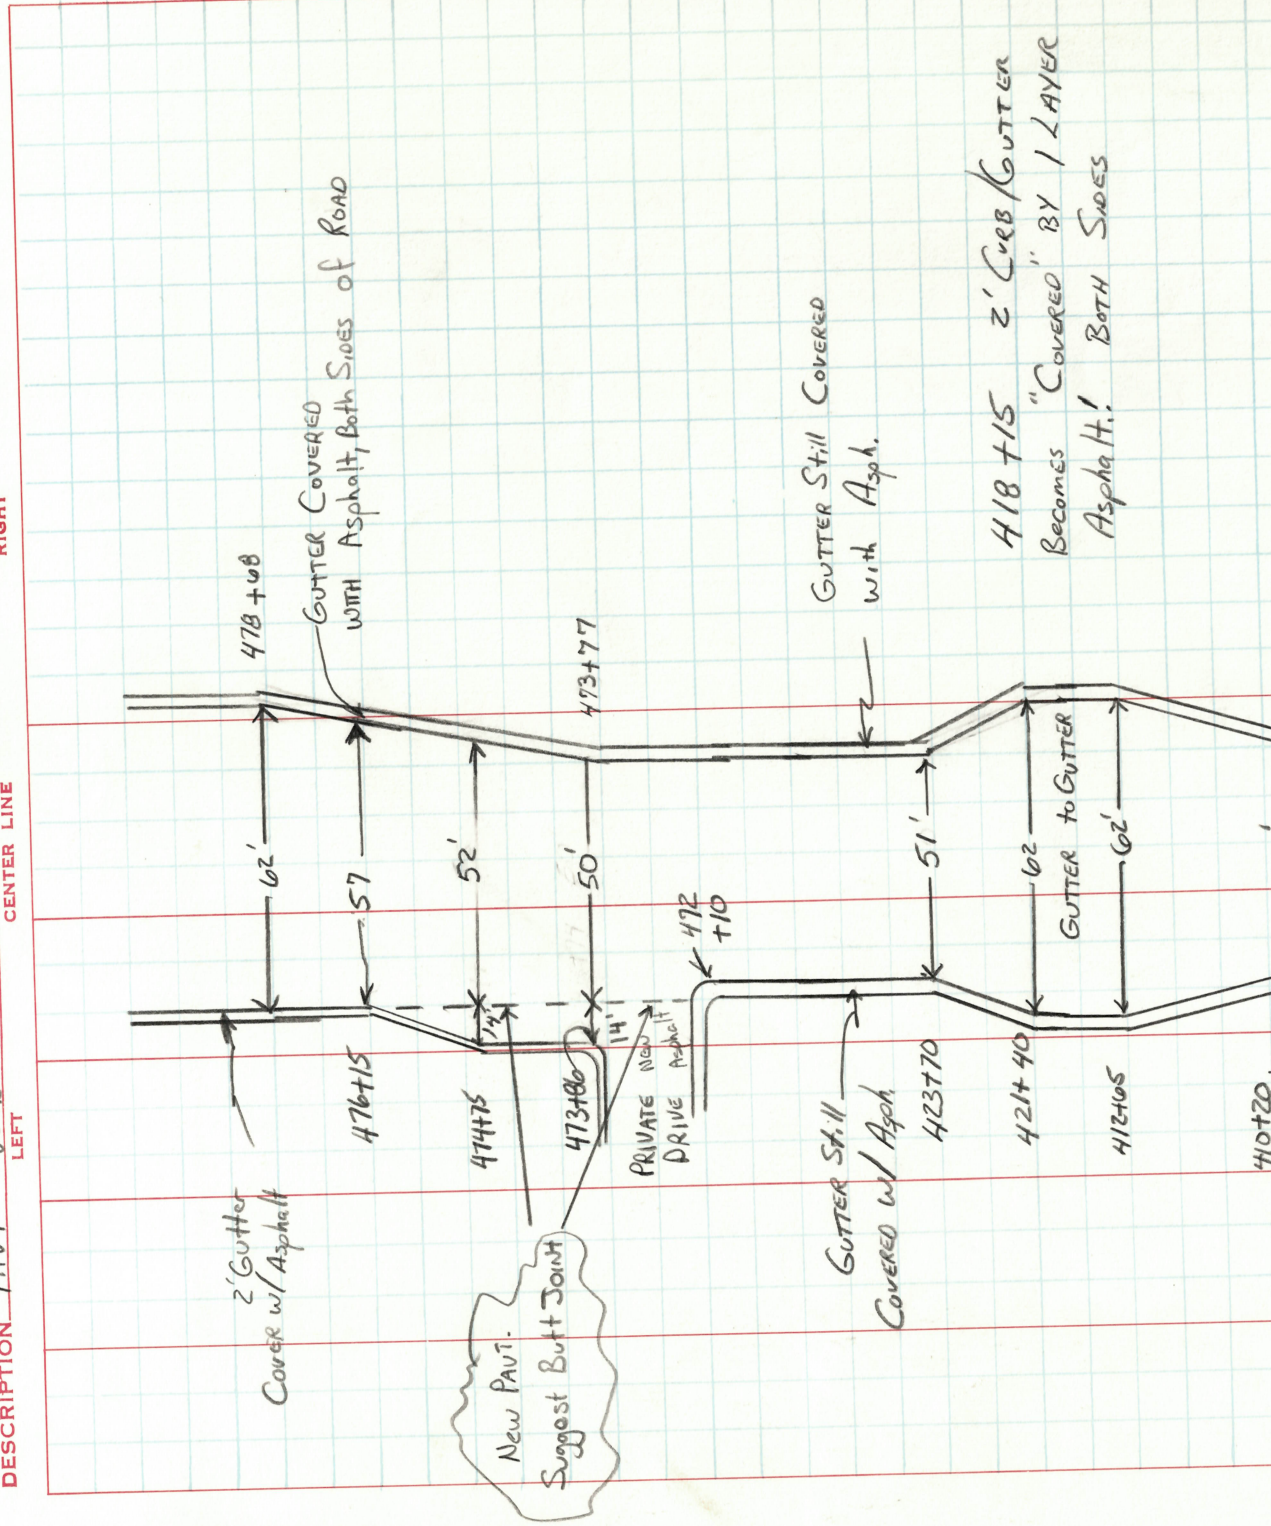

OHIO DEPARTMENT OF TRANSPORTATION

SHEET NO. 7/28

LD-5 Rev. 2-83


PERSONNEL	TITLE	PERSONNEL	TITLE	COUNTY	DATE
LOEHRKE		S. R.	S. R. 2	LUCAS	5-5-93
SINON					WEATHER <u>Cloudy</u>
MOSE					TEMP. <u>165</u>

JOB NO. _____

DESCRIPTION	WIDTHS		CENTER LINE	RIGHT
	PAVT	LEFT		

NOTE.

Luc 2-0944
Suggest GRINDING FOR
BUTT JOINT IN ALL AREAS
Where Conc And Asph. Meet!
Deck in Fair Shape

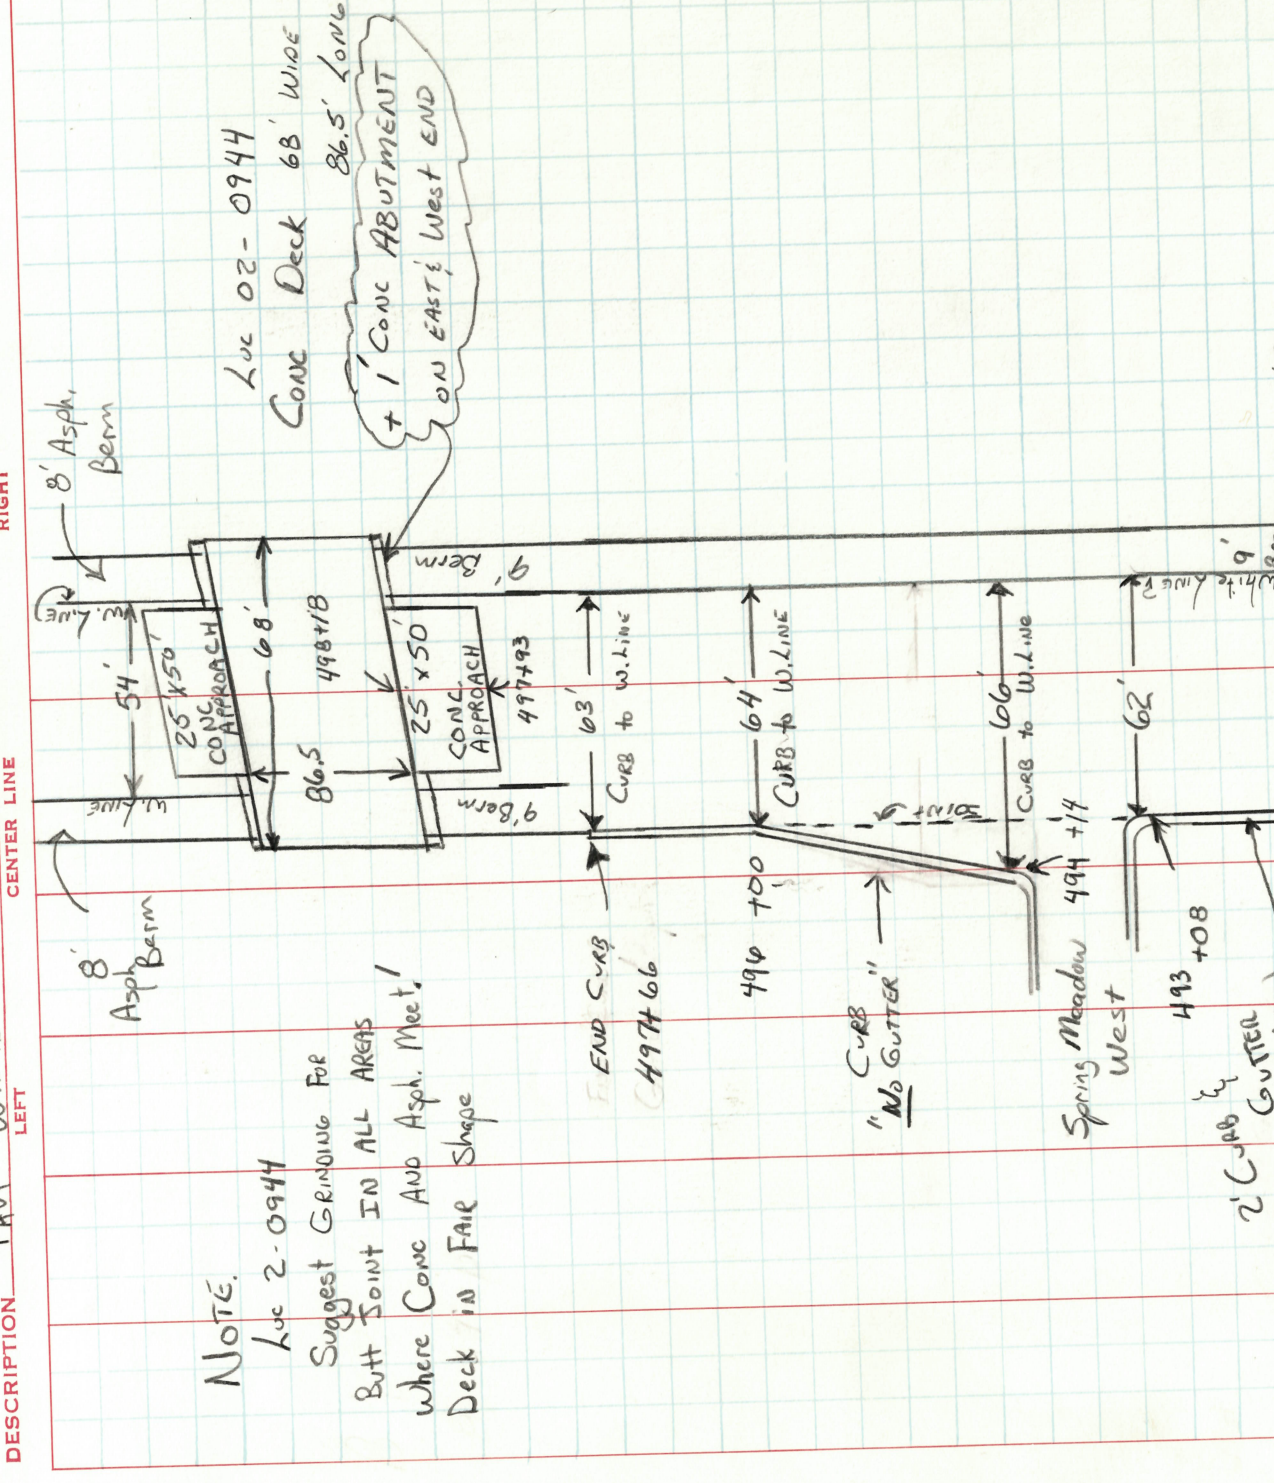

OHIO DEPARTMENT OF TRANSPORTATION


LD-5 Rev. 2-83

SHEET NO. 8/28

PERSONNEL LOEHKE TITLE _____ COUNTY LUCAS DATE 5-6-93
Moser S. R. S.R. 2 WEATHER Nice

SEC. 4/12 TEMP. +70

DESCRIPTION PAV WIDTHS CENTER LINE RIGHT JOB NO. _____

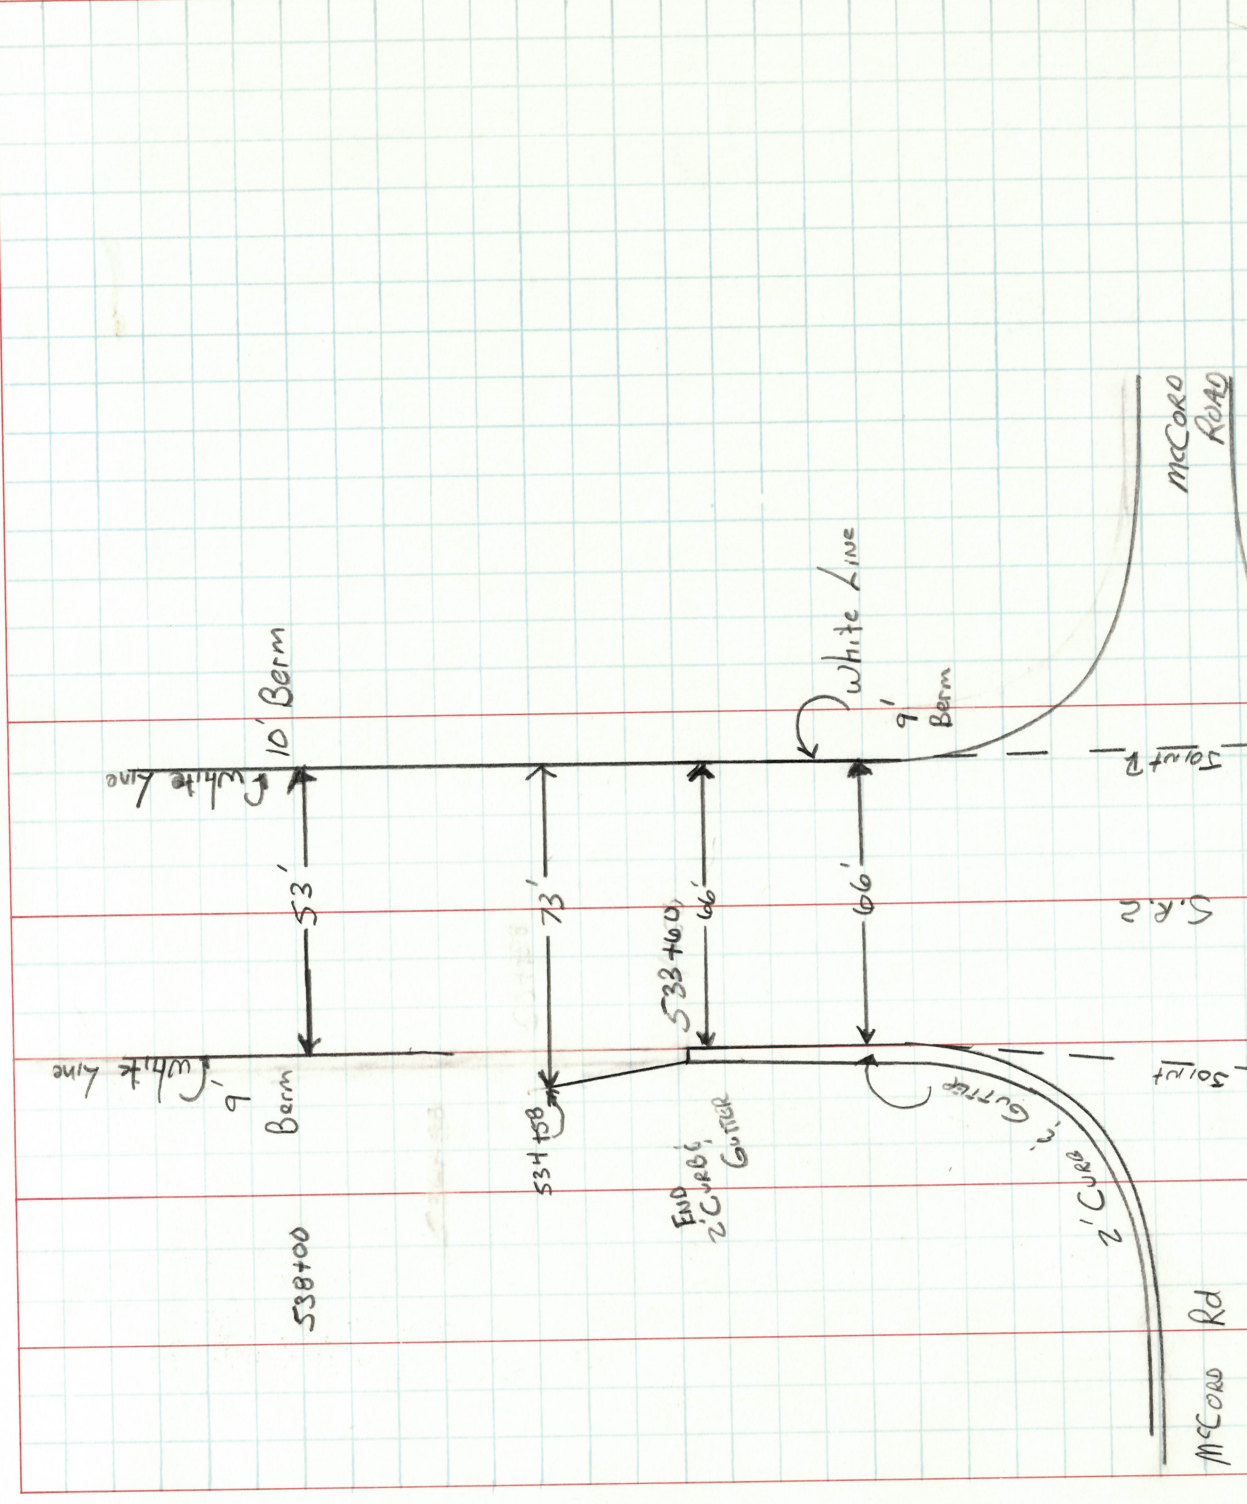

62/6

SHEET NO. 118


4-29-93

LOEHRKE

Simon

Moser

DESCRIPTION	PAVT	WIDTH	CENTER LINE	RIGHT	JOB NO.

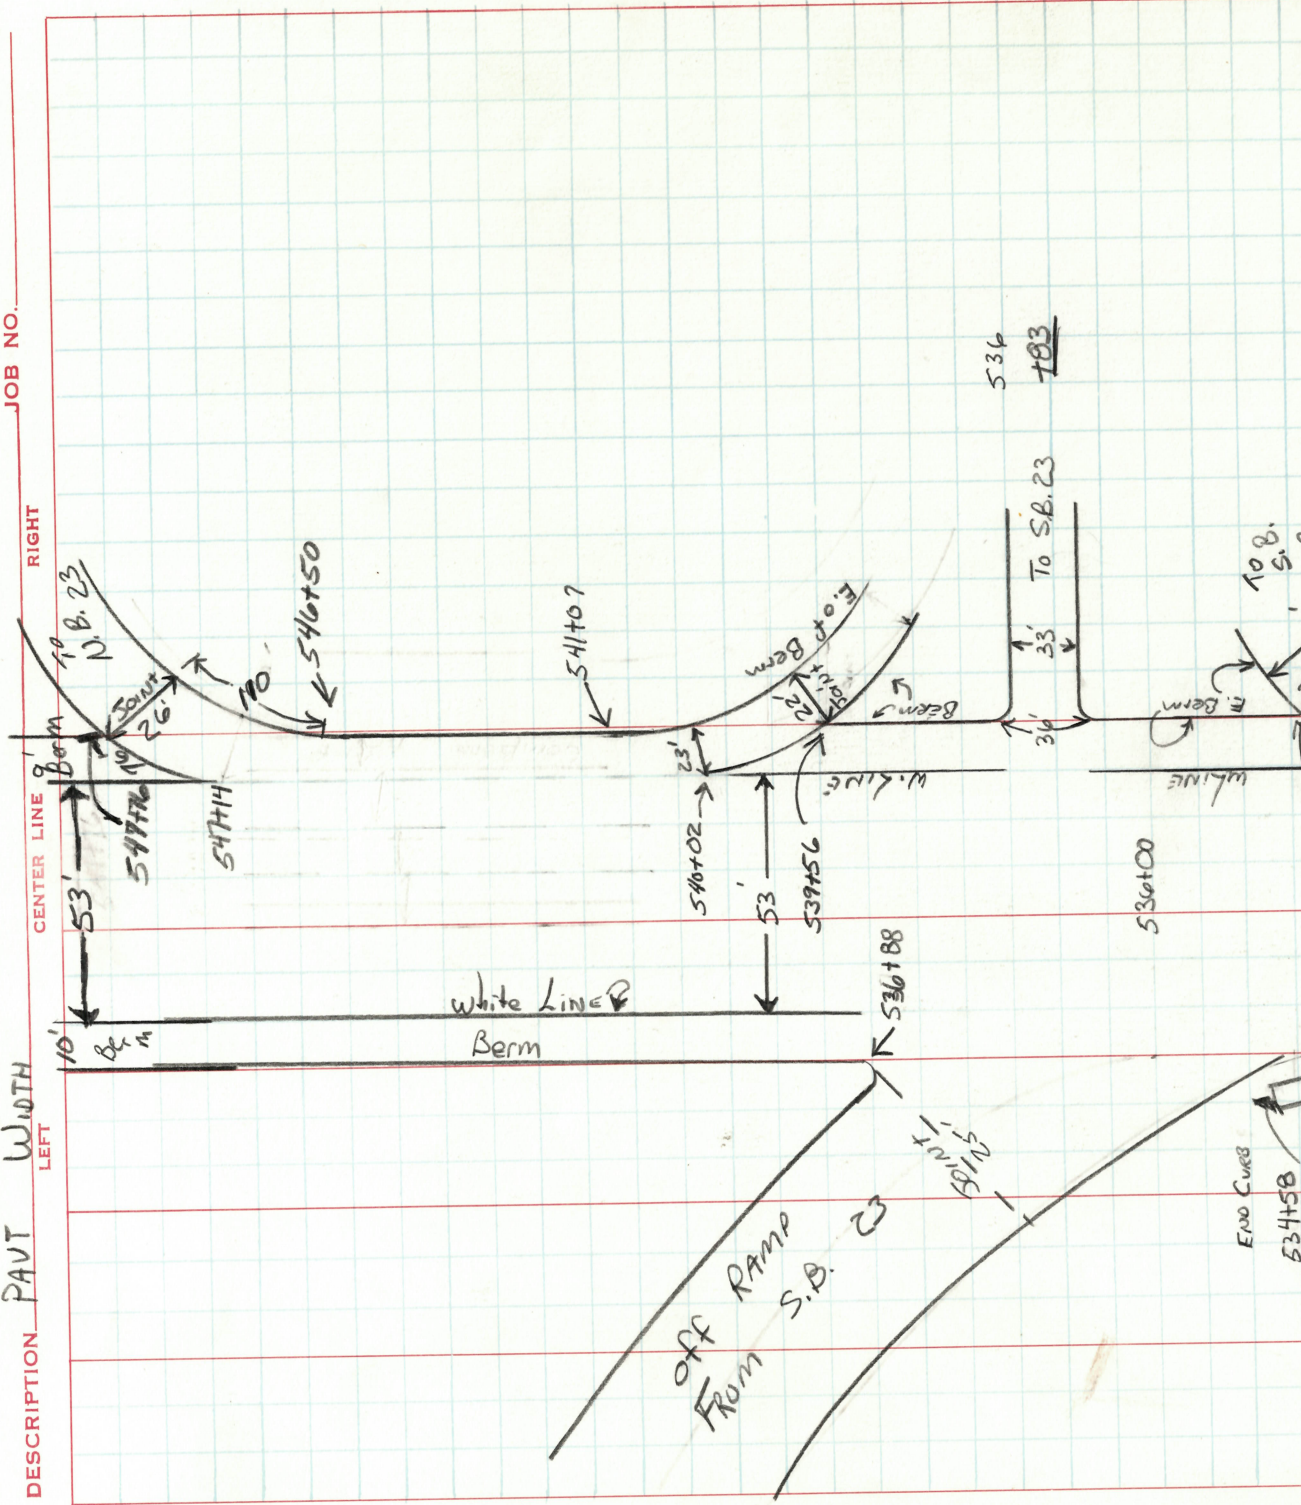

TITLE

PERSONNEL

TITL

COUNTY LUCAS

DATE _____

LOGS

COUNTY LUCAS

丁巳年

S. R. S.R.2

WEATHER Nice

Crew

SEC. 4.12

TEMP: +77

DESCRIPTION-


PAVT

PART WIDTHS

CENTER LINE

RIGHT

JOB NO.: _____

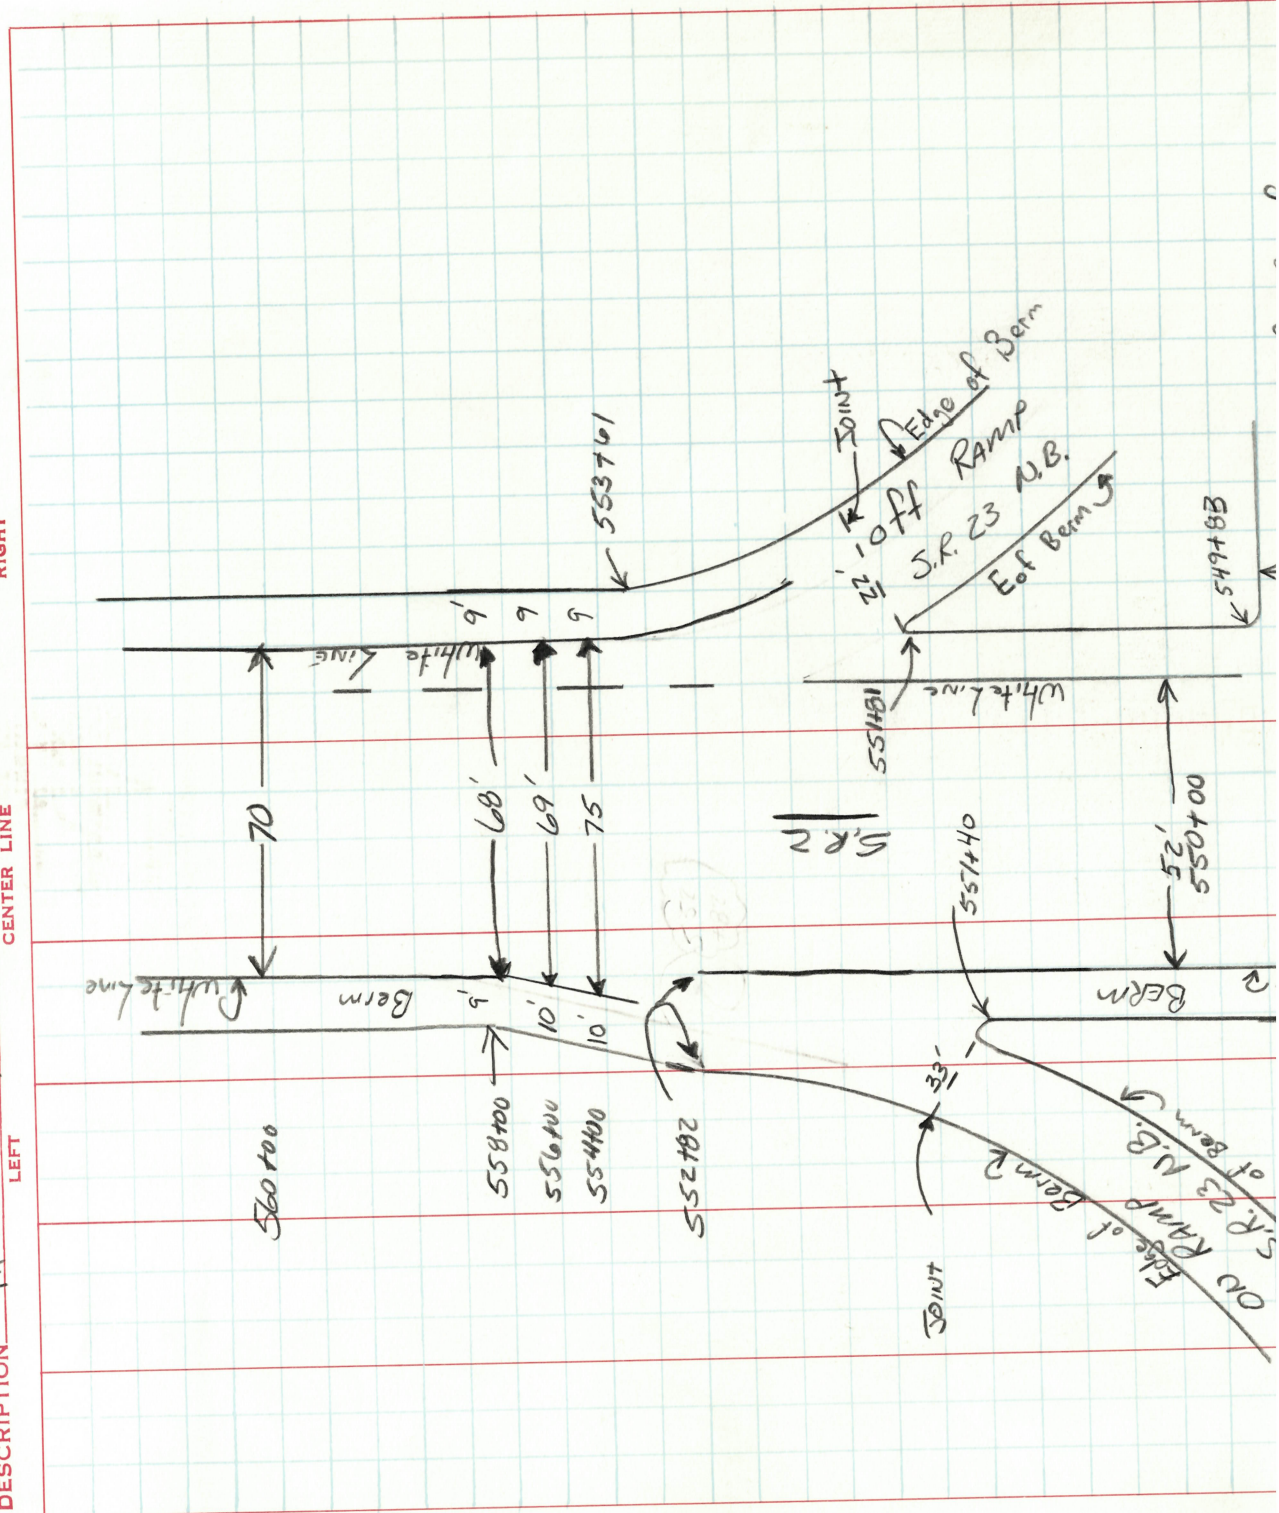

OHIO DEPARTMENT OF TRANSPORTATION

SHEET NO. 11/28
 DATE 5-6-93
 COUNTY LUCAS
 WEATHER NICE
 TEMP. 75°
 JOB NO. _____

LD-5 Rev. 2-83

PERSONNEL

TITLE

PERSONNEL

TITLE

COUNTY LUCAS

LOEHKE

Moser

S. R. S.R.2


SEC. 4.12

DESCRIPTION PAVT W.D.THS

CENTER LINE

END

LEFT

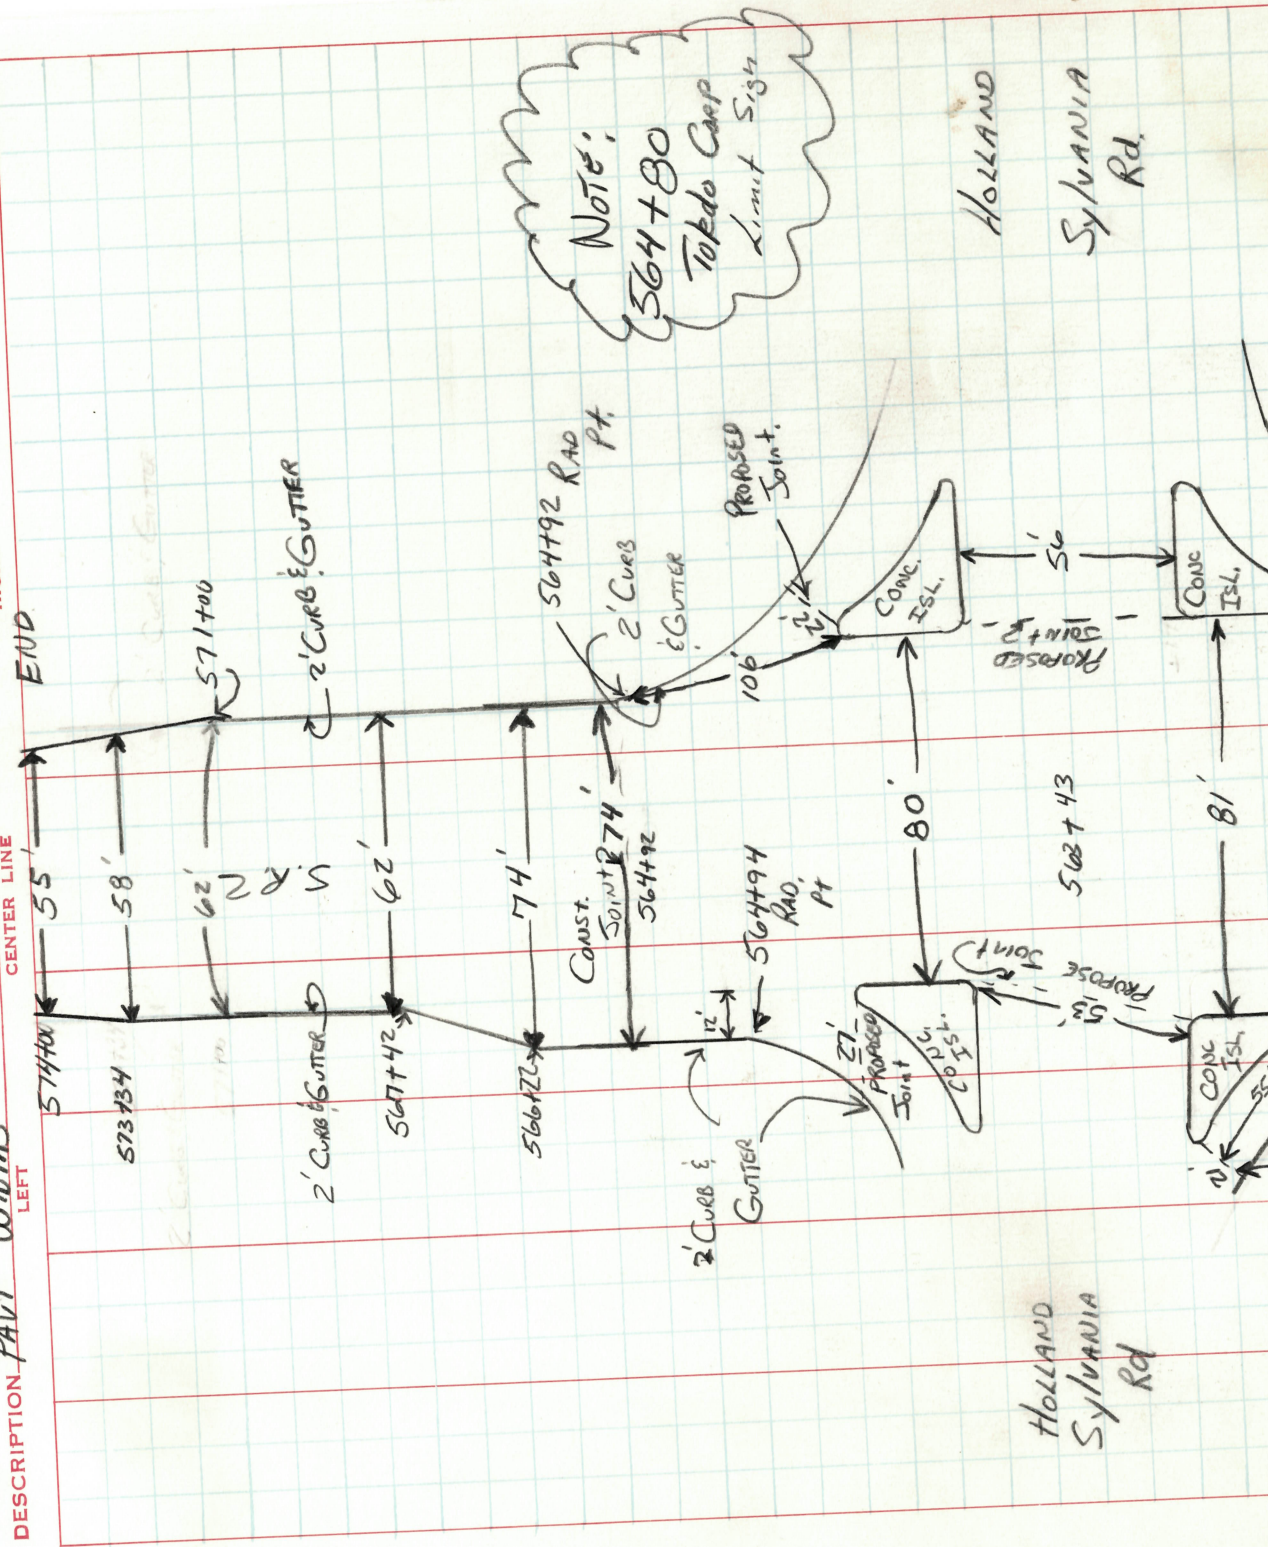

OHIO DEPARTMENT OF TRANSPORTATION



SHEET NO. 12 / 128

LD-5 Rev. 2-83

PERSONNEL Loehle TITLE _____ PERSONNEL Lucas TITLE _____
 PERSONNEL Moser TITLE _____ PERSONNEL _____ TITLE _____
 S. R. S.R.2 WEATHER _____
 SEC. 4.12 TEMP. _____
 JOB NO. _____

DESCRIPTION Bridge Info

CENTER LINE RIGHT

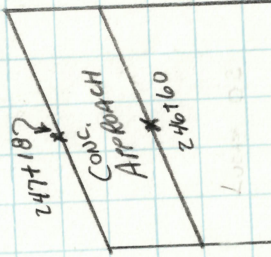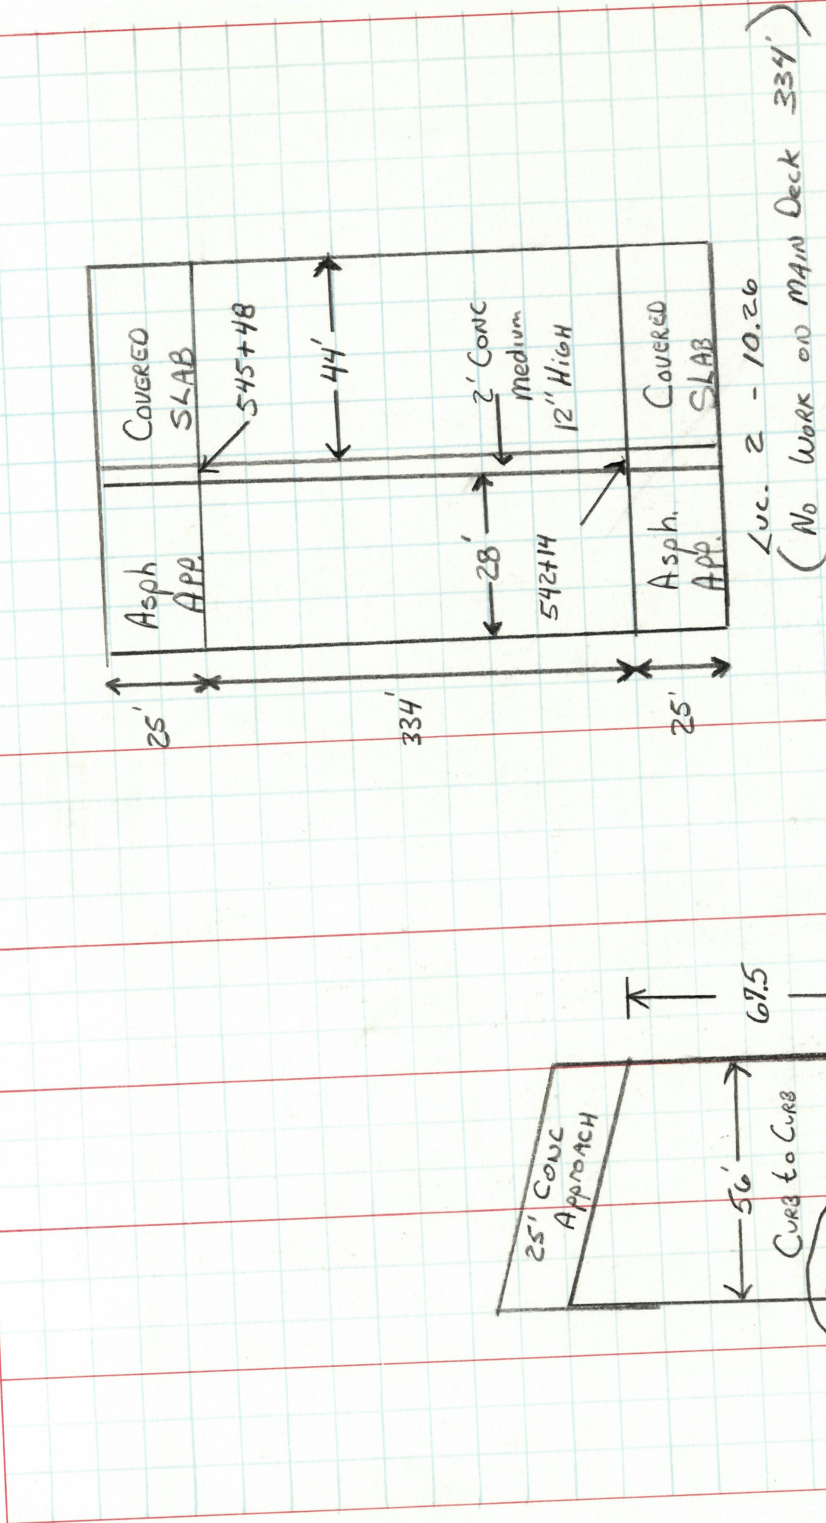

Loc-02-0843
 (117.5' No Work)

DATE 1-30-12

SHEET 13 OF 20

V-1
1994 TWO-LANE RESURFACING PROGRAM

UTILITIES (CATCH BASIN, MANHOLE, INLET, WATERVALVE, BOX AND MONUMENT BOX)

COUNTY LUCASROUTE SR 2SECTION 412

R = RAISE F = FEATHER

STATION	OUT (FT) RT/LT OF C	CATCH BASIN	MAN- HOLE	INLET	W V BOX	MON BOX	CASTING		REMARKS ie: RECONSTRUCT, NO WORK
							R	F	
219+52	9					X	X		No Work
241+12	19' Rt		X				X		No Work
247+42	Lt CURB			X			X		No Work
247+80	Rt CURB			X			X		No Work
250+07	29' Rt		X				X		No Work
250+11	22 Lt		X				X		No Work
258+42	00					X	X		No Work
258+46	40' Lt		X				X		No Work
278+72	00					X	X		
284+27	00					X	X		
282+19	35 Lt		X				X		
295+42	9					X	X		
307+13	9					X	X		
310+87	10' Rt					X	X		
314+60	9					X	X		
341+33	9					X	X		
344+90	15' Rt					X	X		
347+47	7' Rt					X	X		
376+78	9					X	X		
282+24	Rt GUTTER			X					PAV BREAKING, DOWN AROUND IT 6' x 3'

DATE 5-3-12

SHEET 14 OF 20

1994 TWO-LANE RESURFACING PROGRAM

UTILITIES (CATCH BASIN, MANHOLE, INLET, WATER VALVE, BOX AND MONUMENT BOX)

COUNTY Lucas

ROUTE

S.R. 2

SECTION

412

R = RAISE F = FEATHER

STATION	OUT (FT) RT/LT OF C	CATCH BASIN	MAN- HOLE	INLET	W V BOX	MON BOX	CASTING		REMARKS ie: RECONSTRUCT, NO WORK
							R	F	
430 +29	R					X	X		
435 +40	Rt. CURB			X			X		
435 +40	Lt. CURB			X			X		
439 +26	Lt. CURB			X			X		
439 +79	Rt. CURB			X			X		
442 +09	Lt. CURB			X			X		
443 +07	Rt. CURB			X			X		
443 +07	Lt. CURB			X			X		
443 +44	Lt. CURB			X			X		
446 +29	Lt. CURB			X			X		PLUGGED! SAND
450 +67	Rt. CURB			X			X		
450 +67	Lt. CURB			X			X		
456 +15	Lt. CURB			X			X		
456 +70	R					X	X		
460 +16	Rt. CURB			X			X		
460 +16	Lt. CURB			X			X		
459 +14	32' Lt G		X				X		
462 +67	Lt. CURB			X			X		
463 +52	40' Lt G				GAS		X		
463 +54	32' Lt G		X		GAS		X		

DATE 5-3-93

SHEET 15 OF 28

1994 TWO-LANE RESURFACING PROGRAM

UTILITIES (CATCH BASIN, MANHOLE, INLET, WATERVALVE, BOX AND MONUMENT BOX)

COUNTY Lucas

ROUTE

S.R. 2

SECTION

4.12

R = RAISE F = FEATHER

STATION	OUT (FT) RT/LT OF C	CATCH BASIN	MAN- HOLE	INLET	W V BOX	MON BOX	CASTING		REMARKS ie: RECONSTRUCT, NO WORK
							R	F	
470+60	Rt Curb			Y			X		
470+60	Lt Curb			Y			X		
482+65	38' Rt+L		X				X		
482+95	C					X	X		Holloway Road?
483+15	32' Rt+L		X				Y		
483+15	39' Lt+L		X				Y		
483+21	46' Lt+L		X				Y		
484+16	Rt Curb			X			X		
486+66	Lt Curb			X			X		
490+65	Lt Curb			X			X		
493+77	36' Lt+L		X				X		
494+52	32' Lt+L		X				X		
494+58	Lt Curb			X			X		
495+95	C					X	X		
496+03	Lt Curb			X			X		
499+61	32' Rt+L		X				X		
502+06	C					X	X		
504+12	14' Lt+L					X	X		
510+66	Q PAVT					X	X		
507+97	26' Rt+L		X				X		

28

2024 TWO-WE BESUREFACING PROGRAM

1994 TWO-LANE RESURFACING PROGRAM

4.12

COUNTY LUCAS

ROUTE

S.R. 2

SECTION

R = RAISE
F = FEATHER


[illegible]

P.W. 1
State of Ohio Department of Transportation

LD-5
5-92

Field Notes

PERSONNEL	TITLE	PERSONNEL	TITLE	COUNTY	DATE	SHEET NO.
Loehrer				LUCAS	5-18-93	P.M. 1
Mose				S. R.		
Alexander				S. R. 2		
CANTERBURY				SEC.		
				4, 12		
				TEMP.		
				WEATHER		
				Cloudy		
				JOB NO.		

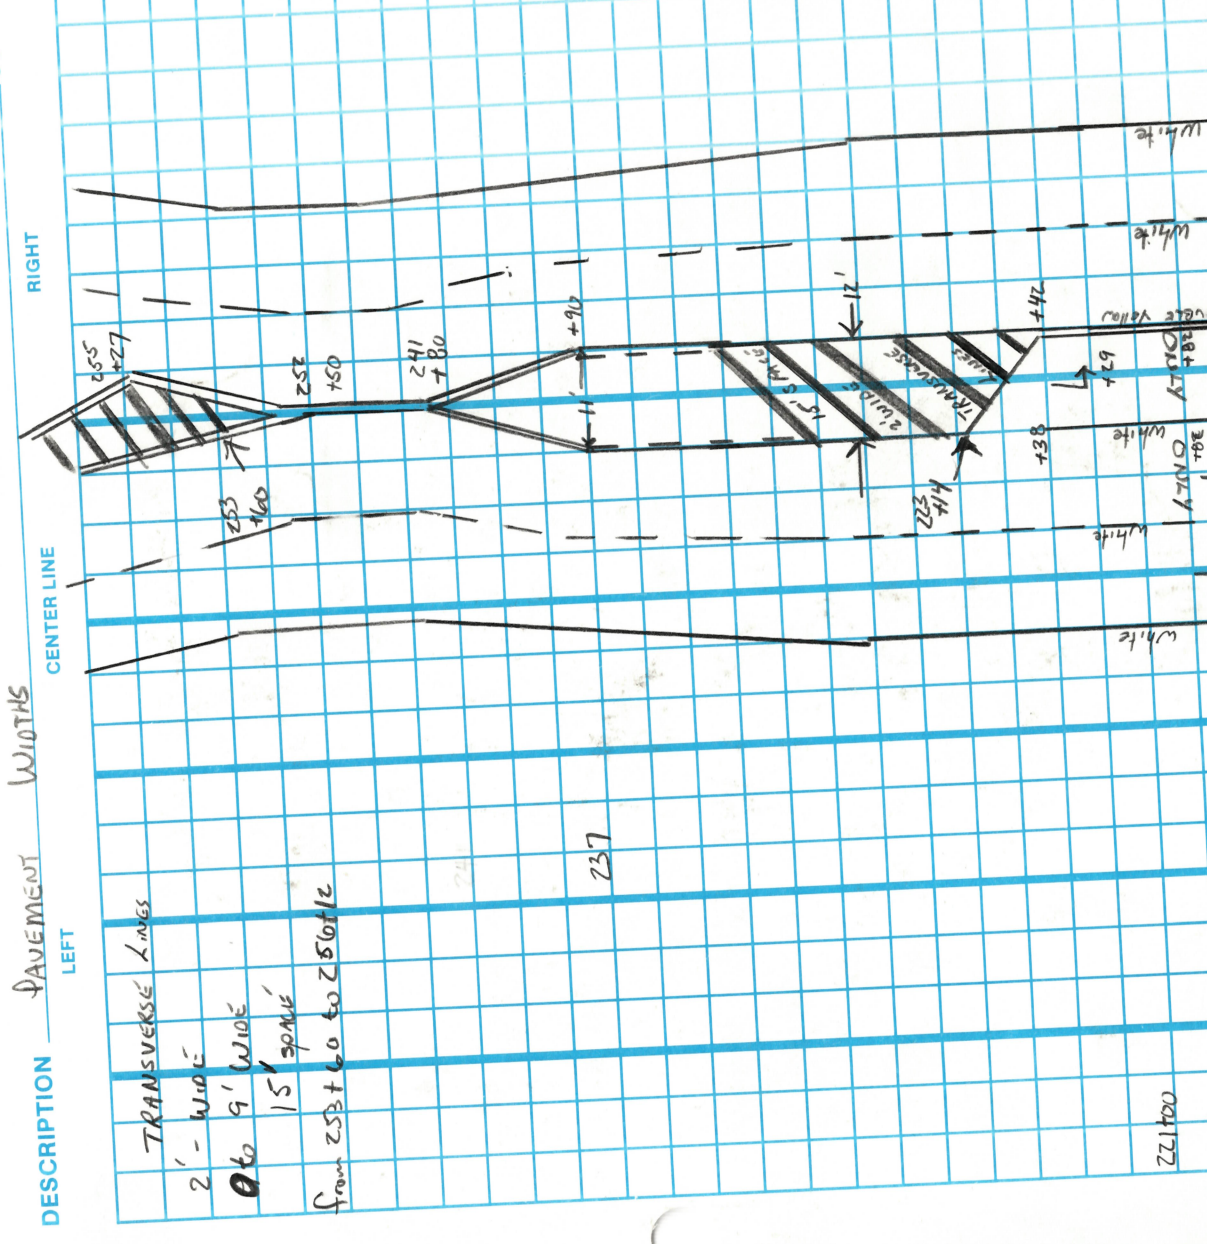

10/60


State of Ohio Department of Transportation

Field Notes

LD-5
5-92


SHEET NO. Page 2 P.M. 2
 DATE 5-18-93
 COUNTY Lucas
 S. R. S.R. 2 WEATHER Cloudy
 SEC. 412 TEMP. +60
 PERSONNEL LOEMKE
Moser
Alexander
CANTERBURY
 JOB NO. _____

DESCRIPTION PAV WIDTHS
 LEFT RIGHT
 CENTER LINE

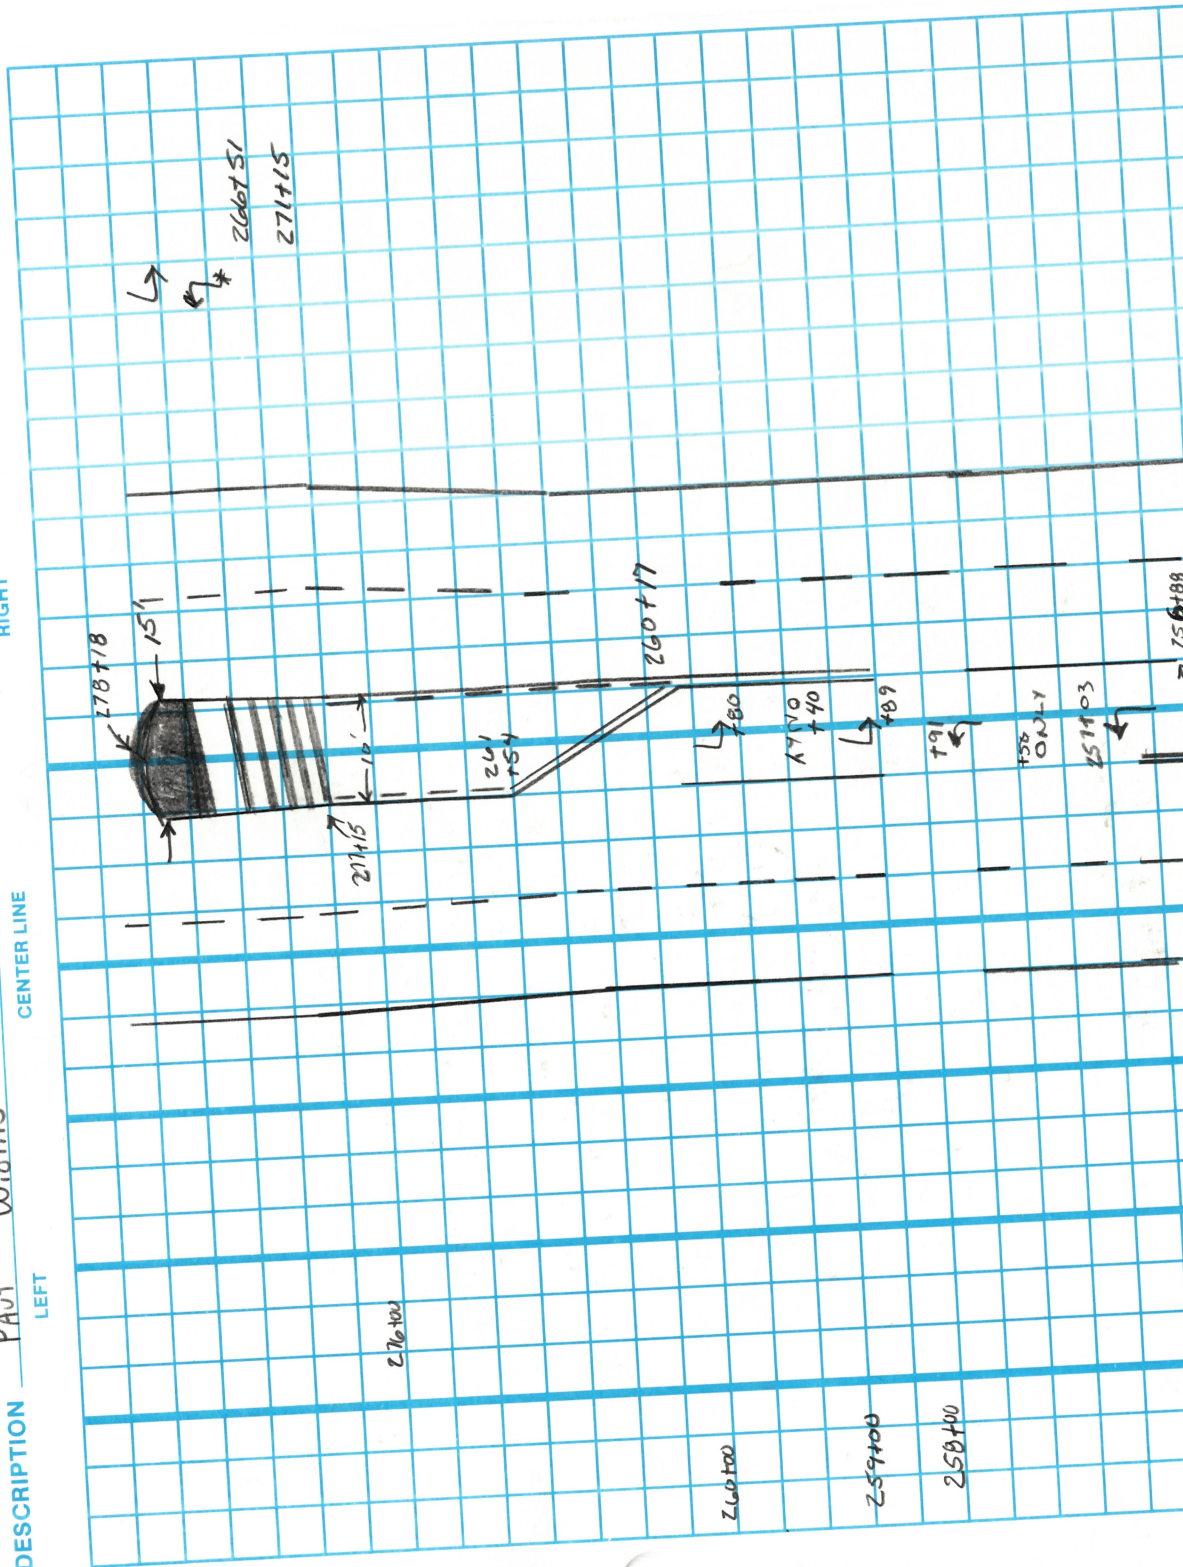

LD Rev. 2-83	COUNTY PERSONNEL TITLE	TITLE	PERSONNEL	TITLE	COUNTY	DATE
	<u>LOEHKE</u>				Lucas	S-19-93
	<u>CANTERBURY</u>				S. R.	
	Alexander				S.R.Z	WEATHER Cloudy
	Newell					TEMP + 50
					SEC.	JOB NO.

DESCRIPTION	PAVT.	MARKINGS	CENTER LINE	STOP BAR	RIGHT	LEFT
					2138	772

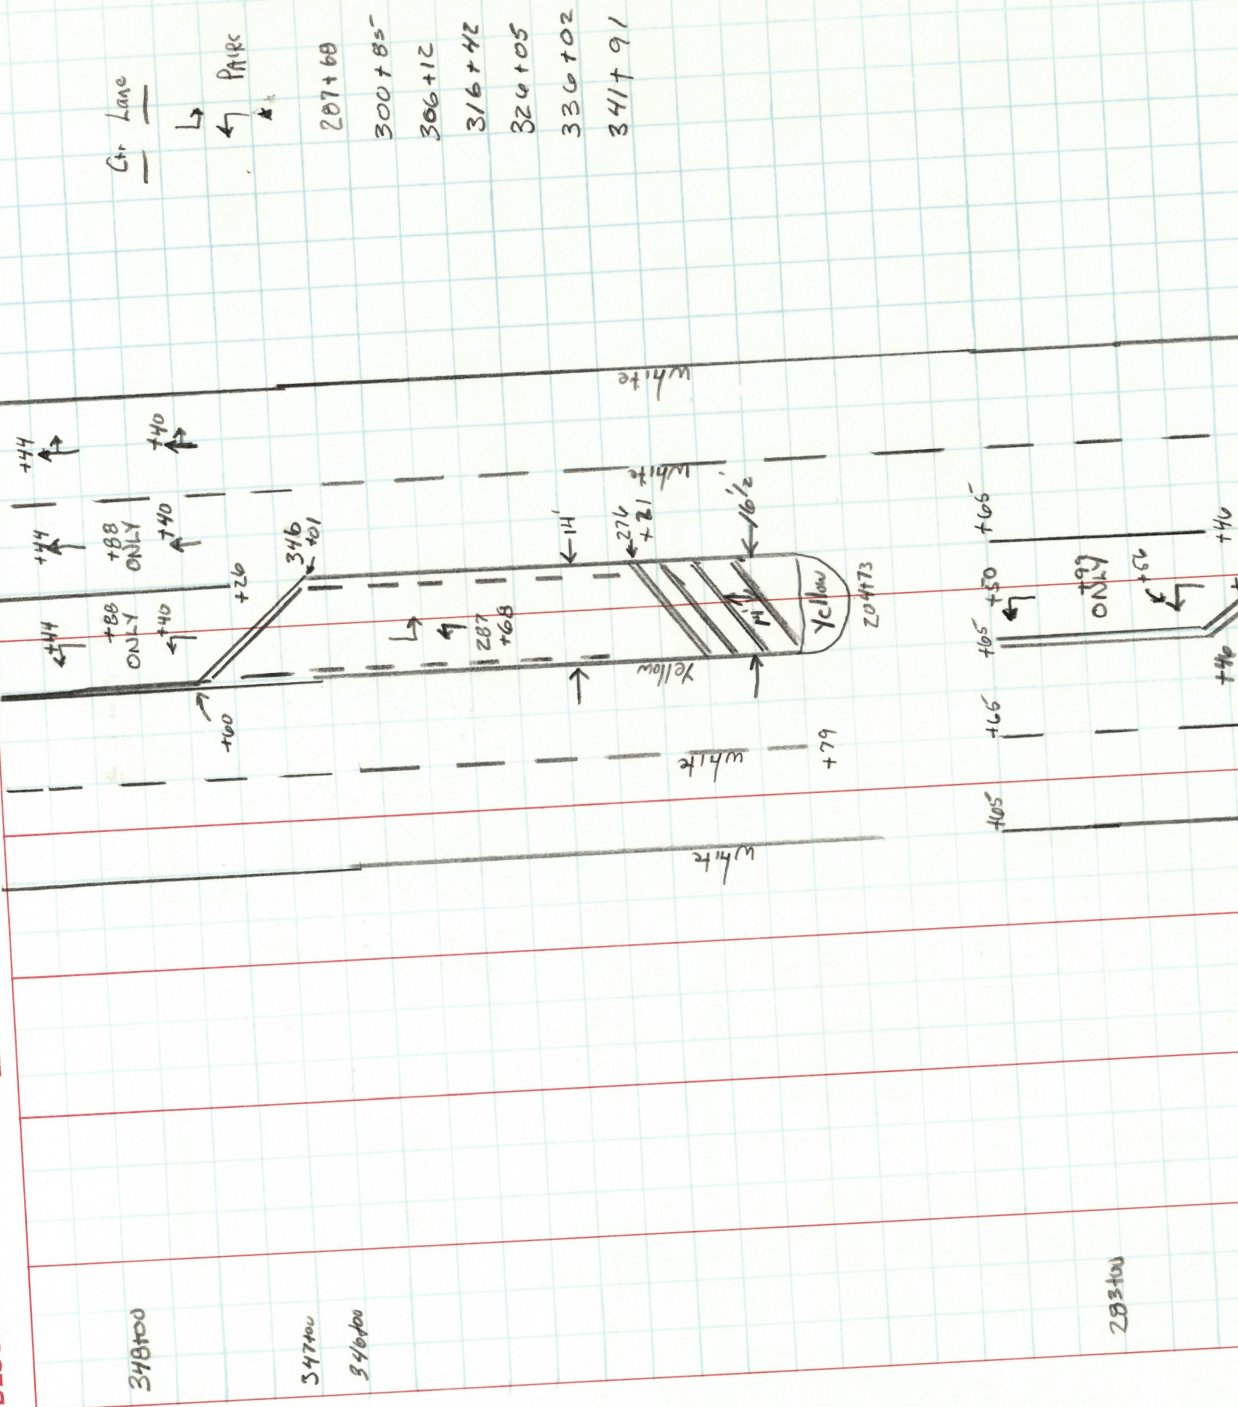

11/20

OHIO DEPARTMENT OF TRANSPORTATION

SHEET NO. P.M. 5

LD-5 Rev. 2-83

DATE 5-19-93

COUNTY Lucas

TITLE

PERSONNEL

TITLE

WEATHER Cloudy

TITLE

PERSONNEL

TITLE

TEMP. +50

TITLE

PERSONNEL

TITLE

JOB NO.

TITLE

PERSONNEL

TITLE

JOB NO.

TITLE

PERSONNEL

TITLE

JOB NO.

TITLE

PERSONNEL

TITLE

JOB NO.

TITLE

PERSONNEL

TITLE

DESCRIPTION

PAVT

MARKINGS

LEFT

RIGHT

CENTER LINE

STOP BAR

Holloway Rd.

482+00

481

480

449+00

448+00

447+00

17

DEPARTMENT OF TRANSPORTATION

PERSONNEL	TITLE	PERSONNEL	TITLE	COUNTY	DATE
LOEHKE				LUCAS	5-21-93
CANTERBURY				S. R. S.R.	WEATHER Clear
Alexander				SEC. 412	TEMP. +50
Howell					JOB NO.

DESCRIPTION	PAVT	MARKINGS	CENTER LINE	RIGHT	LEFT

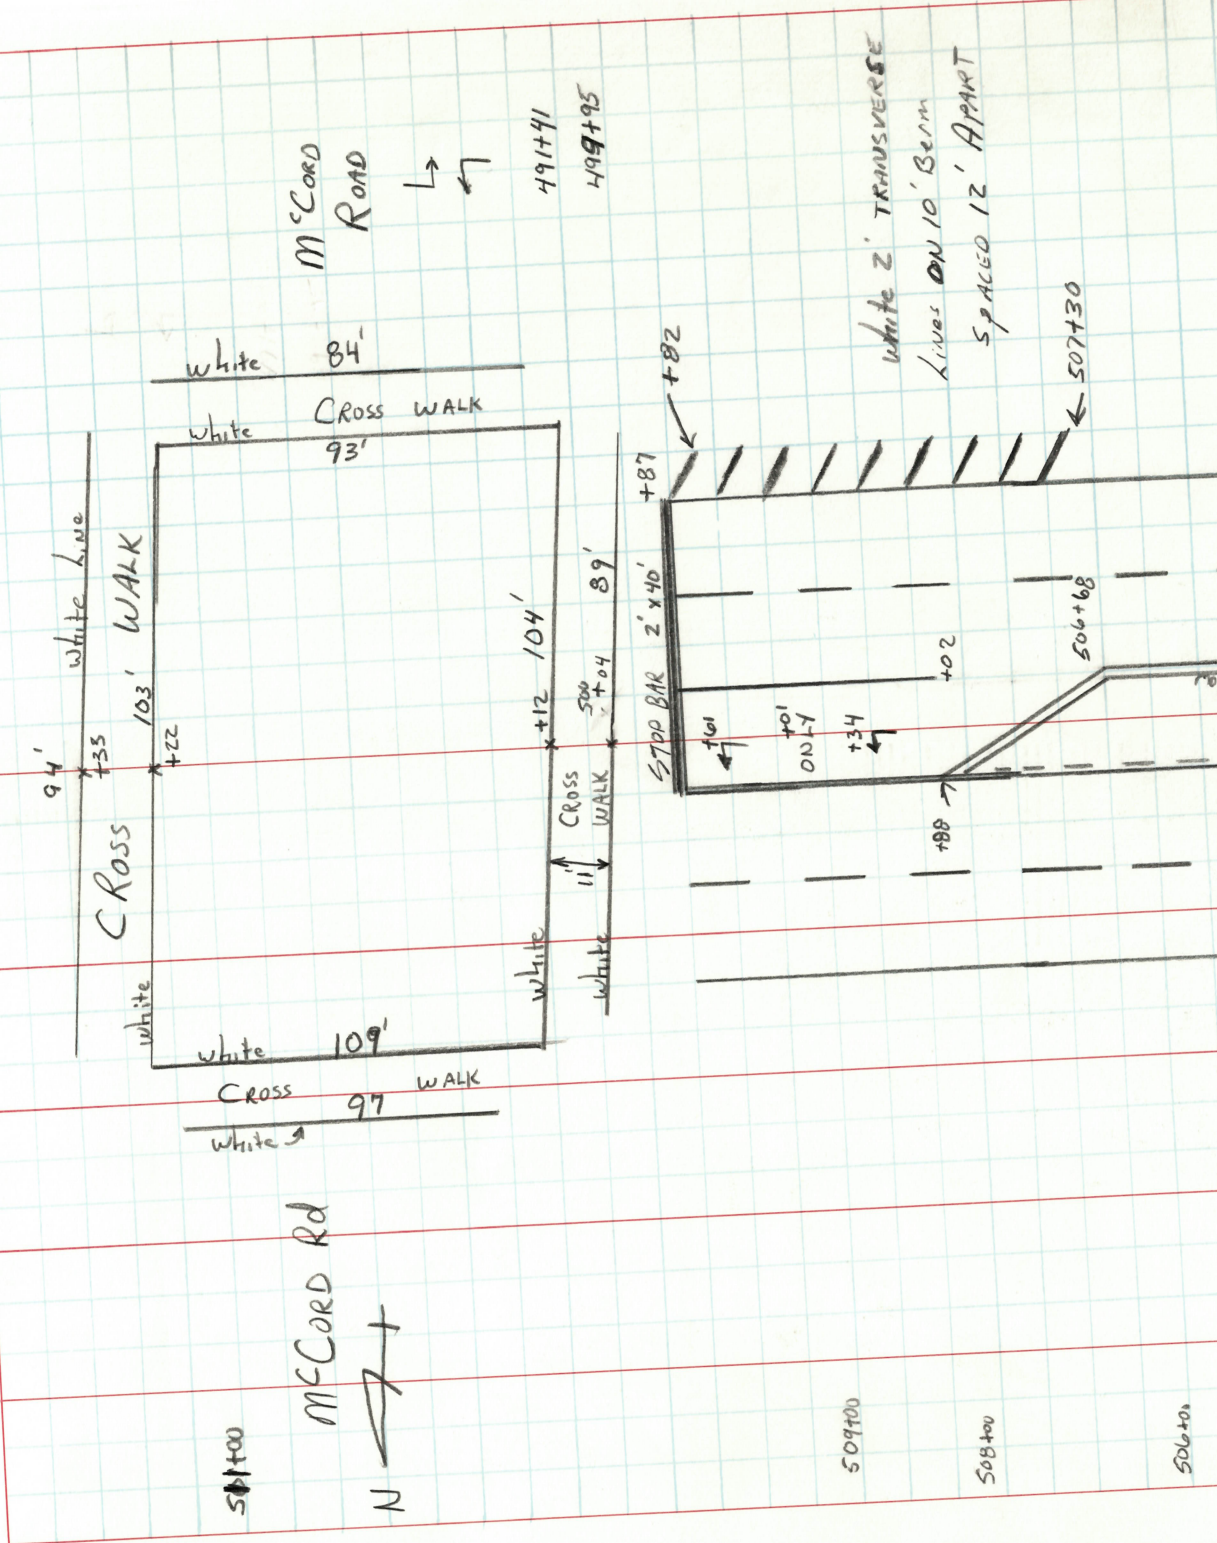


OHIO DEPARTMENT OF TRANSPORTATION

LD-5 Rev. 2-83

SHEET NO. P.M. 7

PERSONNEL Loehrer TITLE _____ PERSONNEL _____ TITLE _____
 COUNTY Locas DATE 5-21-93 WEATHER Clear
 S. R. S.R. 2 TEMP. +50
 SEC. 4.12 JOB NO. _____

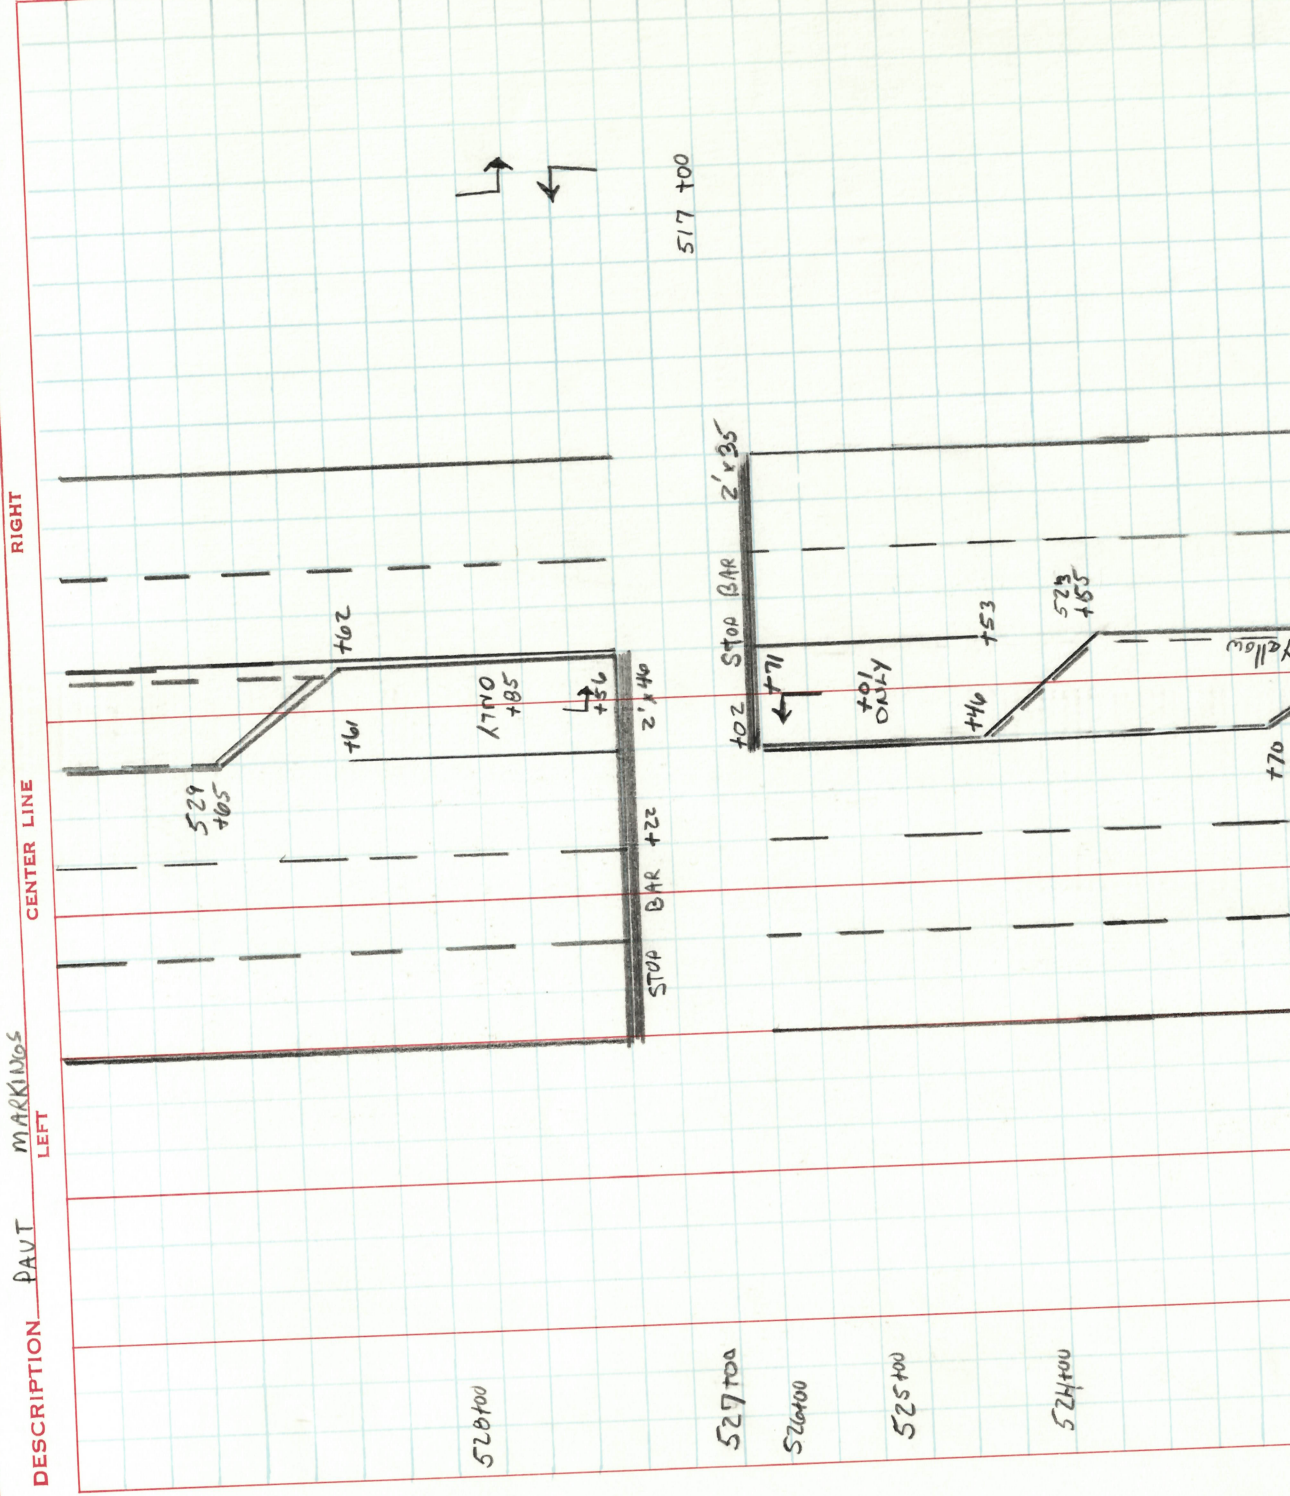

13/10

OHIO DEPARTMENT OF TRANSPORTATION

SHEET NO. 9M.9

LD-5 Rev. 2-83

DATE 5-21-93

COUNTY Lucas

WEATHER Pt Cloudy

TEMP +64

JOB NO.

PAVT MARKINGS

DESCRIPTION

PAVT

MARKINGS

LEFT

RIGHT

CENTER LINE

PAVT

MARKINGS

LEFT

RIGHT

CENTER LINE

PAVT


MARKINGS

LEFT

RIGHT

CENTER LINE

PAVT

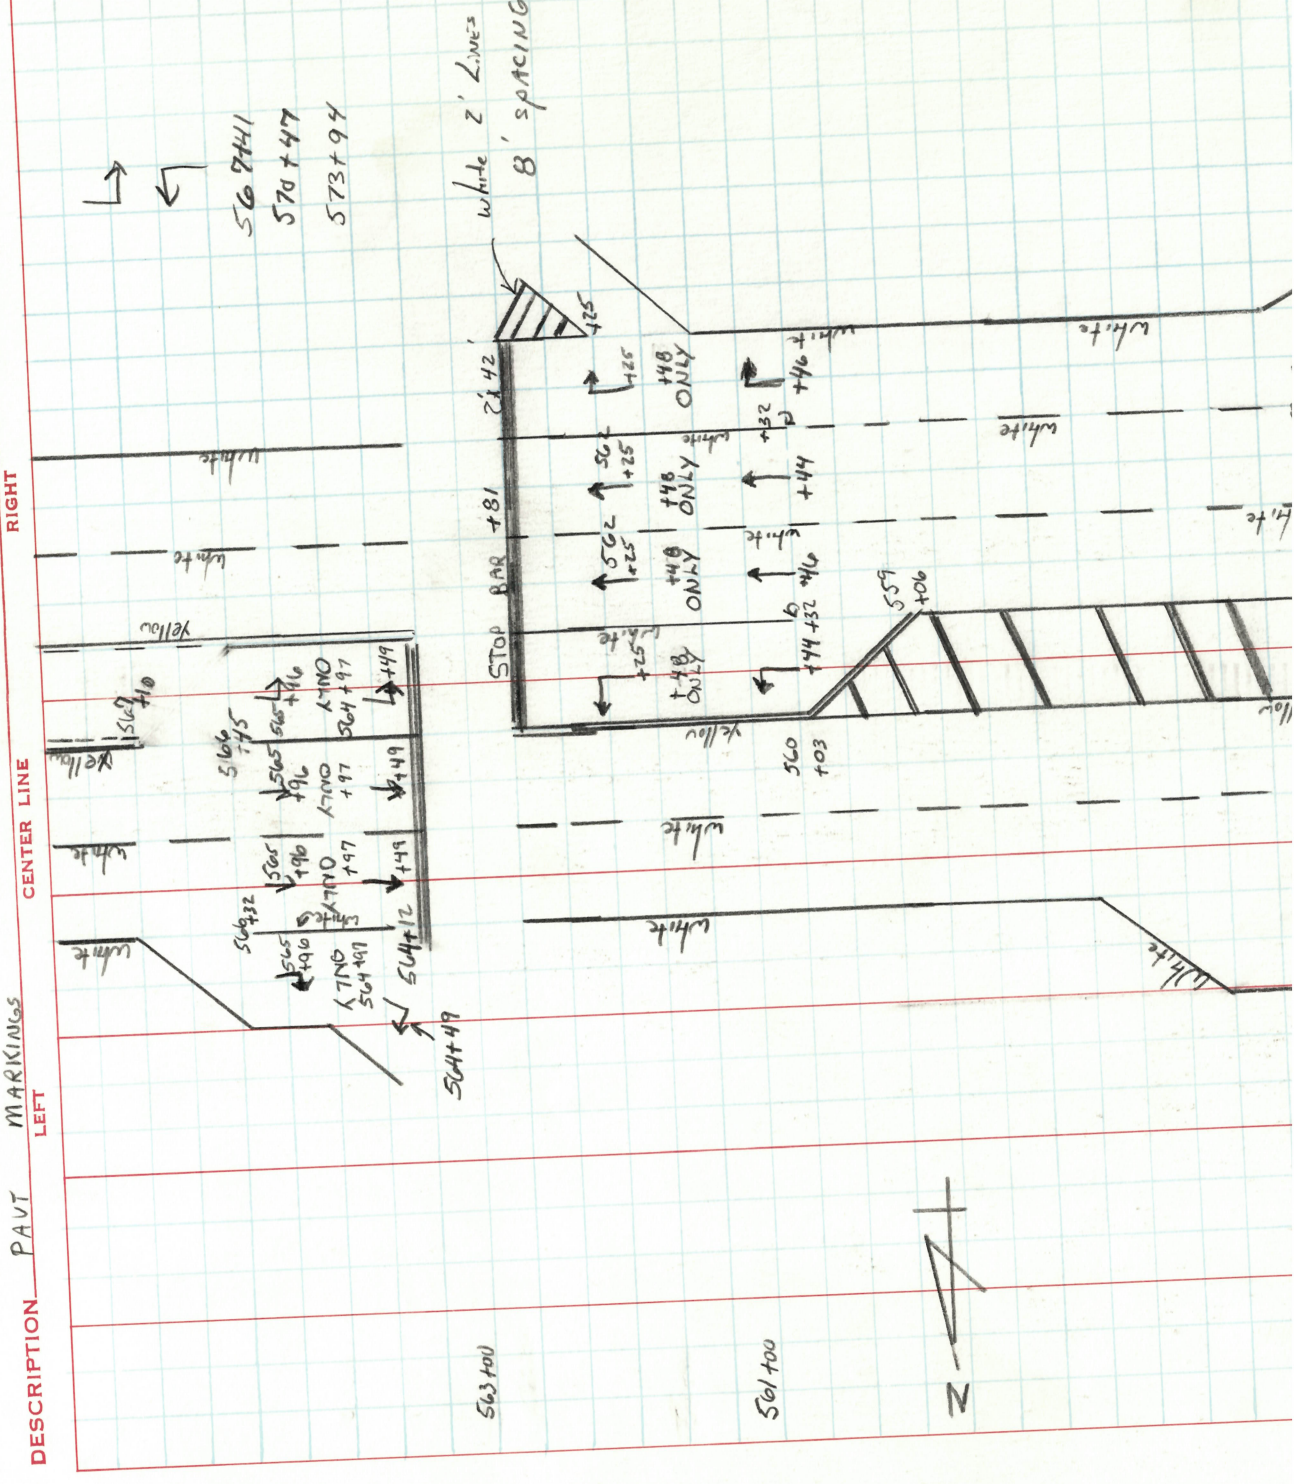

07/28

DATE _____

SHEET 9, M. 10 OF _____

1994 TWO-LANE RESURFACING PROGRAM
CROSSWALKS AND STOP BARS

COUNTY Lucas ROUTE SR 2 SECTION 4.12
R - RAISE F - FEATHER

STATION AT LEADING EDGE	CROSS WALK	STOP BAR	WIDTH OUT/OUT	LENGTH	CROSS HATCHING SIZE/SPACING	A - ACROSS ROUTE P - PARALLEL TO ROUTE
218+68		A	37'			
221+42 to 223+14		A	0' to 12'		2' LINES SPACED 16' Apart	
258+28		P		25'		NORTH GARDEN P
258+60		P		26'		South GARDEN P
278+40 R+		P		24'		S. EBER P
284+20 L+		P		24'		NORTH EBER P
348+72		A		38'		SR 2 west of Crissey A
349+20 R+		P		20'		South Crissey P
350+03		A		36'		SR 2 EAST of Crissey A
376+23		A		38'		SR 2 west of Albion A
377+47		A		43'		SR 2 EAST of Albion A
443+90		A		32'		SR 2 west of Timberwolf A
444+50 L+		P		39'		Timberwolf P
444+91		A		26'		SR 2 EAST of Timberwolf A
482+22		A		37'		SR 2 West of Holloway A
483+52		A		40'		SR 2 EAST of Holloway A
500+04		A		40'		SR 2 West of McCoo A
511+40		A		46'		SR 2 EAST of McCoo A
511+50		A		11'		SR 2 East of McCoo - Little Lane A
						A. F. B.

DATE 5-20-93

1994 TWO-LANE RESURFACING PROGRAM
CROSSWALKS AND STOP BARS

SHEET 0.11 OF

COUNTY Lucas ROUTE S.R. 2 SECTION 4, 12
P - RAISE F - FEATHER

R - RAISE
F - FEATHER

[illegible]

COUNTY Lucas ROUTE SR 2 SECTION 4.12

STATION		LT BERM	LT LANE	RT LANE	RT BERM	SIZE (WIDTH)	EXISTING PAVEMENT CONDITIONS	
FROM	TO						RUTTED	CRACKED BASE FAILURE
272+40	272+80			X		12'		X "Appears to be a 11" BAD LONG CRACK Asphalt GRIND 1 1/2" Deep"
274+50	274+20					10' 6" 12'	Rutted CORIND 1 1/2"	
290+10	292+30			X	X	2'-4"		X CORIND
320+06	322+40			X		6'	X CORIND 1 1/2"	
325+00	326+25			X		12'	X CORIND 1 1/2"	
339+25	346+10			X	X	6'-8'	CORIND 1 1/2"	
348+05	350+72			3 LANES		32'	CORIND 1" Near Intersection	
352+10	353+65			3 LANES		32'	CORIND 1" "	
359+00	361+41			X		13'	CORIND 1 1/2"	
369+61	374+00	X				2'		CORIND 1 1/2" inch Above White Line
354+31	359+00		X			5'	X	Possible
406+05	407+30		X			15'	X	X
415+05	416+50			3 LANES		34'	X CORIND 1 1/2" Near Intersection	
417+56	419+21		3 LANES			34'	X CORIND 1 1/2" Near Intersection	
480+90	482+25			3 LANES		36'	X CORIND 1 1/2" Near Intersection	
483+50	485+80		3 LANES			37'	X CORIND 1 1/2" Near Intersection	
484+95	486+90			X		12'	X	X CORIND 1 1/2"
509+03	509+97			3 LANES		40'	X	CORIND 1 1/2" Near Intersection
511+97	512+25		4 LANES			47'	X	CORIND 1 1/2" Near Intersection