

OHIO DEPARTMENT OF TRANSPORTATION

SHEET NO. 1 of 2

PERSONNEL TITLE PERSONNEL TITLE

VAN DUSEN TAPE

COUNTY LUCAS

DATE 5-5-92

CURTIS TAPE

S. R. 2

WEATHER SUNNY

BARNHISEL III


SEC. 9.69

TEMP. +53°

ROMERO P

DESCRIPTION PAU't WIDTH'S FOR OVERHEAD SIGNS

LEFT CENTER LINE RIGHT

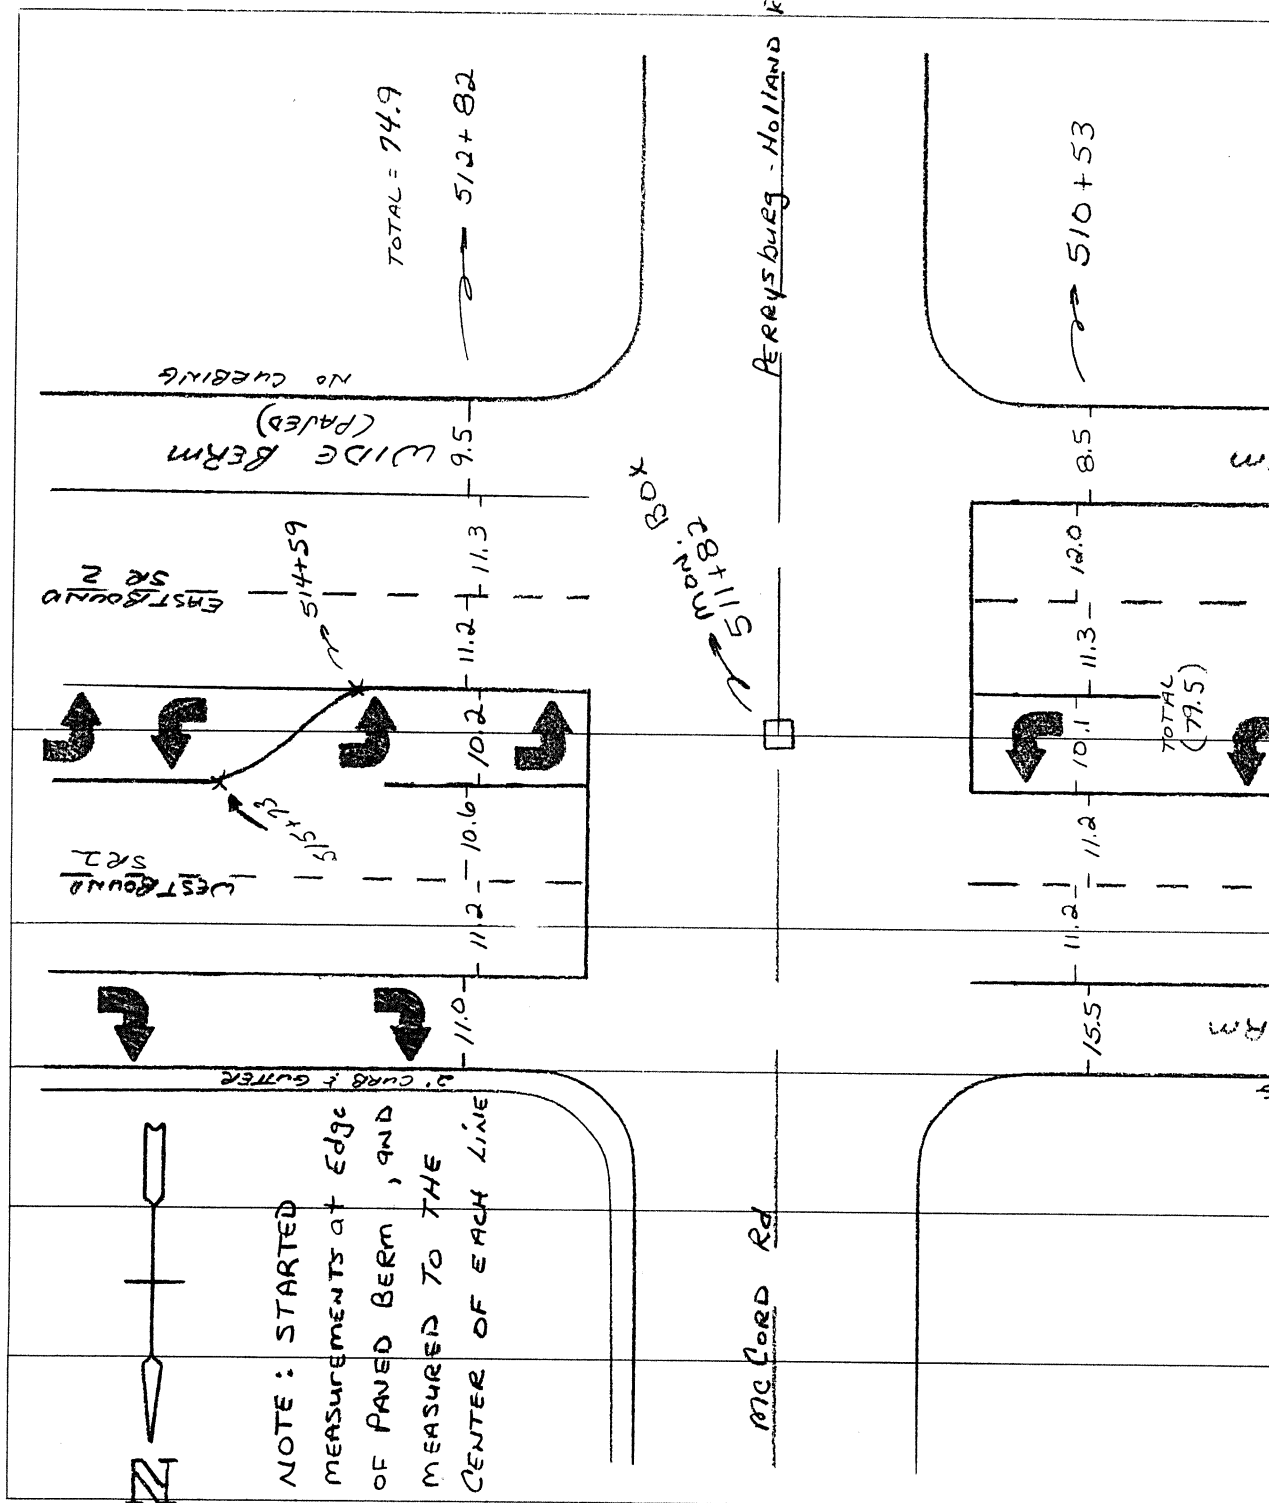

OHIO DEPARTMENT OF TRANSPORTATION

SHEET NO. 2 of 2

PERSONNEL TITLE PERSONNEL TITLE COUNTY LUCAS DATE 5-5-92

IAN DUSEN TAPE S. R. 2 WEATHER SUNNY

CURTIS TAPE SEC. 10.00 TEMP. + 58°

BARNHISEL IN

ROMERO P

DESCRIPTION PAU'T WIDTHS FOR OVERHEAD SIGNS

LEFT CENTER LINE RIGHT JOB NO.

