

1995

1996-14

DATE 12-28-94

TWO-LANE RESURFACING PROGRAM

PERSONNEL LOEHKE

NOTES TO: B. ROSSER 1/5/95

CANTERBURY

ROUSOS

PRIORITY NO. _____ PART 1 OF 2 SHEET 1 OF 9

COUNTY Lucas ROUTE 2 SECTION 19.40

BEGIN LOG (SLM) 19.40 (+) Meas. 1025+35 TERMINII const. joint east of Oak St. Meas. 1025+35

END LOG (SLM) 19.85 Calc 1048+08 TERMINII SR 51

TOTAL LENGTH 0.45 MILES

MUNICIPALITY Toledo BEGIN LOG (SLM) 19.40 END LOG (SLM) 19.85

MUNICIPALITY _____ BEGIN LOG (SLM) _____ END LOG (SLM) _____

PROPOSED WORK: Grind entire pavement to concrete, repair bad part joint, resurface

PAVEMENT 1 3/4" 402 - 1 1/4" 404 SHOULDER curb

OTHER rigid removal & rigid replacement of part joints

STATION ESTABLISHED FROM:

From G₂ PAVT Intersection of S.R. 2 to East and Woodville Road

Referred to As Sta 1048+08 Project measured in Reverse

from East to West, Sta Running West to East 12-28-94 C.L.

NOTE: Fd NO Monumentation at
S.R. 2 & Woodville Rd.

PAINTED ON South Sidewalk.

STRUCTURES:

NUMBER	STATION	WIDTH	LENGTH	PROPOSED WORK
	NONE			

RAILROAD CROSSING:

(NO WORK)

NAME NONE STATION _____ NO. TRACKS _____ LENGTH ALONG C L _____ FT

NAME _____ STATION _____ NO. TRACKS _____ LENGTH ALONG C L _____ FT

MISCELLANEOUS:


NO RAISED PAVEMENT MARKERS; EDGE OF PAVEMENT N/A CENTERLINE _____

NO. MAILBOX APPROACHES N/A MAILBOX SUPPORTS N/A

REMARKS: scarcity existing concrete part 1/4" min, use rubberized tack,
use polymer modified 402 & 404

PERSONNEL	TITLE	PERSONNEL	TITLE	COUNTY	DATE	WEATHER	TEMP.
LOEHRKE				LUCAS	12-30-94	SUNNY	+32°
CANTERBURY				S. R. 2			
ROUSOS				SEC. 19.40			

DESCRIPTION INTERSECTION OF S.R. 2 AND S.R. 51
LEFT CENTER LINE RIGHT

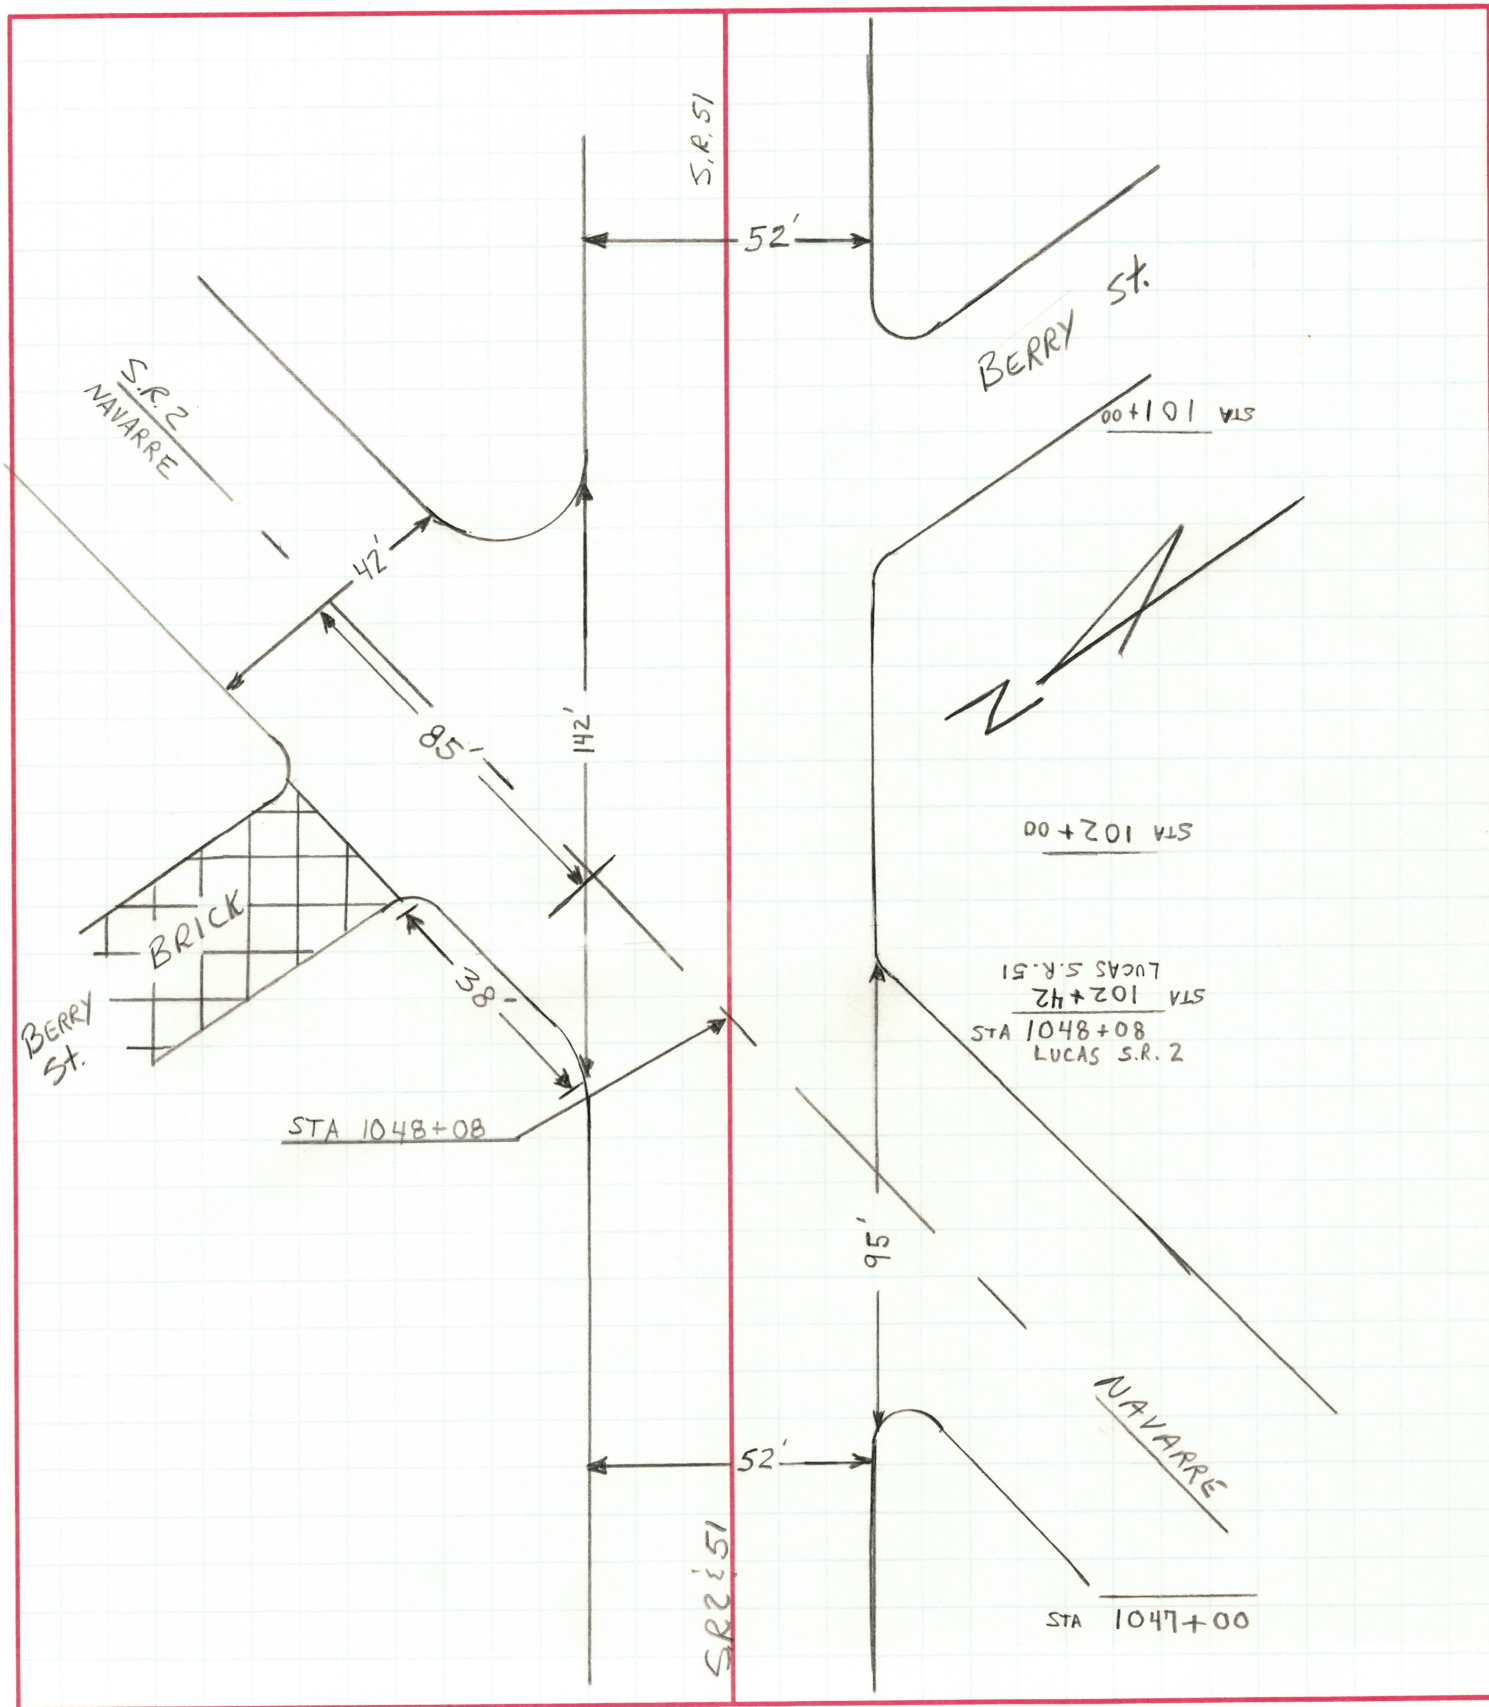

DATE 12-30-94

4-

~~TWO~~-LANE RESURFACING PROGRAMSHEET 4 OF 9

UTILITIES (CATCH BASIN, MANHOLE, INLET, WATER VALVE, BOX AND MONUMENT BOX)

COUNTY LUCAS ROUTE S.R. 2 SECTION 19.40

R = RAISE F = FEATHER

STATION	OUT (FT) RT/LT OF C	CATCH BASIN	MAN- HOLE	INLET	W V BOX	MON BOX	CASTING		REMARKS ie: RECONSTRUCT, NO WORK
							R	F	
1026+77	Lt CURB			X			X		GOOD COND.
1026+87	20' Lt		X				X		Sewer - R
1027+03	20' Rt		X					X	SEWER
1027+15	Rt CURB			X				X	GOOD COND
1027+52	21' Lt		X					X	SEWER
1027+92	2' Rt		X					X	WATER
1028+05	Lt CURB			X				X	GOOD
1029+08	1' Lt		X					X	SANIT.
1032+27	Ctr		X					X	SANIT
1032+41	Rt CURB			X				X	FAIR
1032+41	Lt CURB			X				X	FAIR
1035+27	Ctr		X					X	SEWER
1035+90	20' Rt		X					X	WATER
1038+76	Rt CURB			X				X	GOOD
1038+76	Lt CURB			X				X	GOOD
1038+81	Ctr		X					X	SANIT
1041+10	Ctr		X					X	SANIT
1041+33	Rt CURB			X				X	GOOD
1041+39	22' Rt		X					X	WATER
1041+43	Lt CURB			X				X	GOOD
1041+54	6' Rt		X					X	WATER
1044+81	Rt CURB			X				X	GOOD
1044+81	Lt CURB			X				X	GOOD
1046+97	19' Lt		X					X	SANIT.
1047+19	Rt CURB			X				X	GOOD
1047+21	1' Lt Ctr.		X					X	SANITARY
1047+95	Lt CURB		X	X				X	GOOD

NOTE: LOCATE ALL
CHANGES IN PVMT WIDTH

COUNTY LUCAS

1995; 4-
1994 TWO-LANE RESURFACING PROGRAM
PAVEMENT DATA


DATE 12-30-97
SHEET 5 OF 9

COUNTY LUCAS ROUTE S.R. 2 SECTION 19, 40

[illegible]


PERSONNEL	TITLE	PERSONNEL	TITLE	COUNTY	DATE	S. R.	WEATHER	TEMP.
GEHRKE				LUCAS	12-29-94	S.R. 2	FAIR	+32
Crew						19.40		

DESCRIPTION	PAVT' MARKINGS	JOB NO.

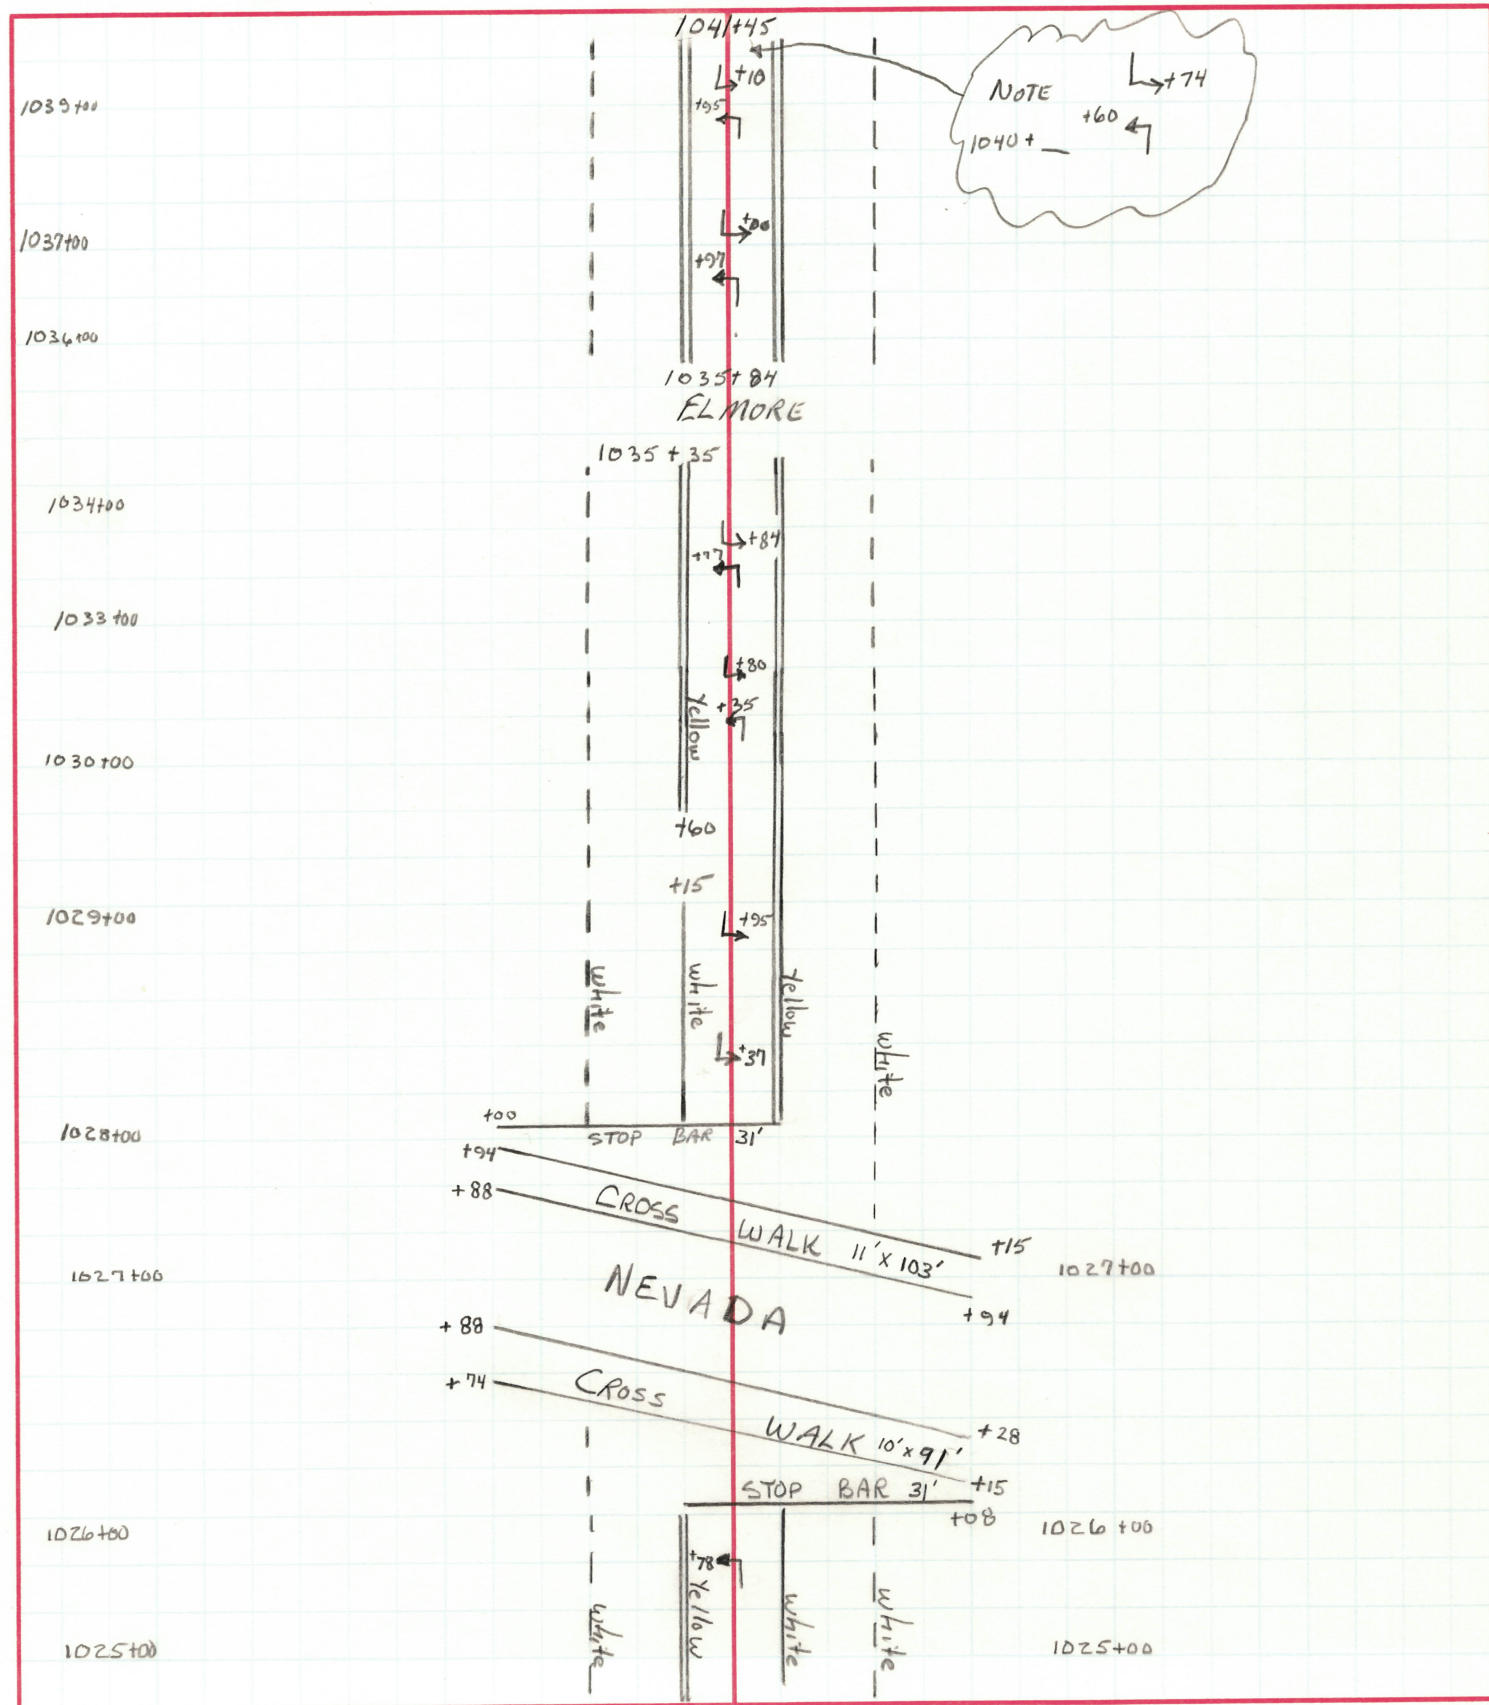

PERSONNEL	TITLE	PERSONNEL	TITLE	COUNTY	DATE	WEATHER	TEMP.
LOEHKE				LUCAS	12-29-94	FAIR	+36
E				S.R. 2			
Crew				SEC. 19.40			

DESCRIPTION	PAVT	MARKINGS	JOB NO.

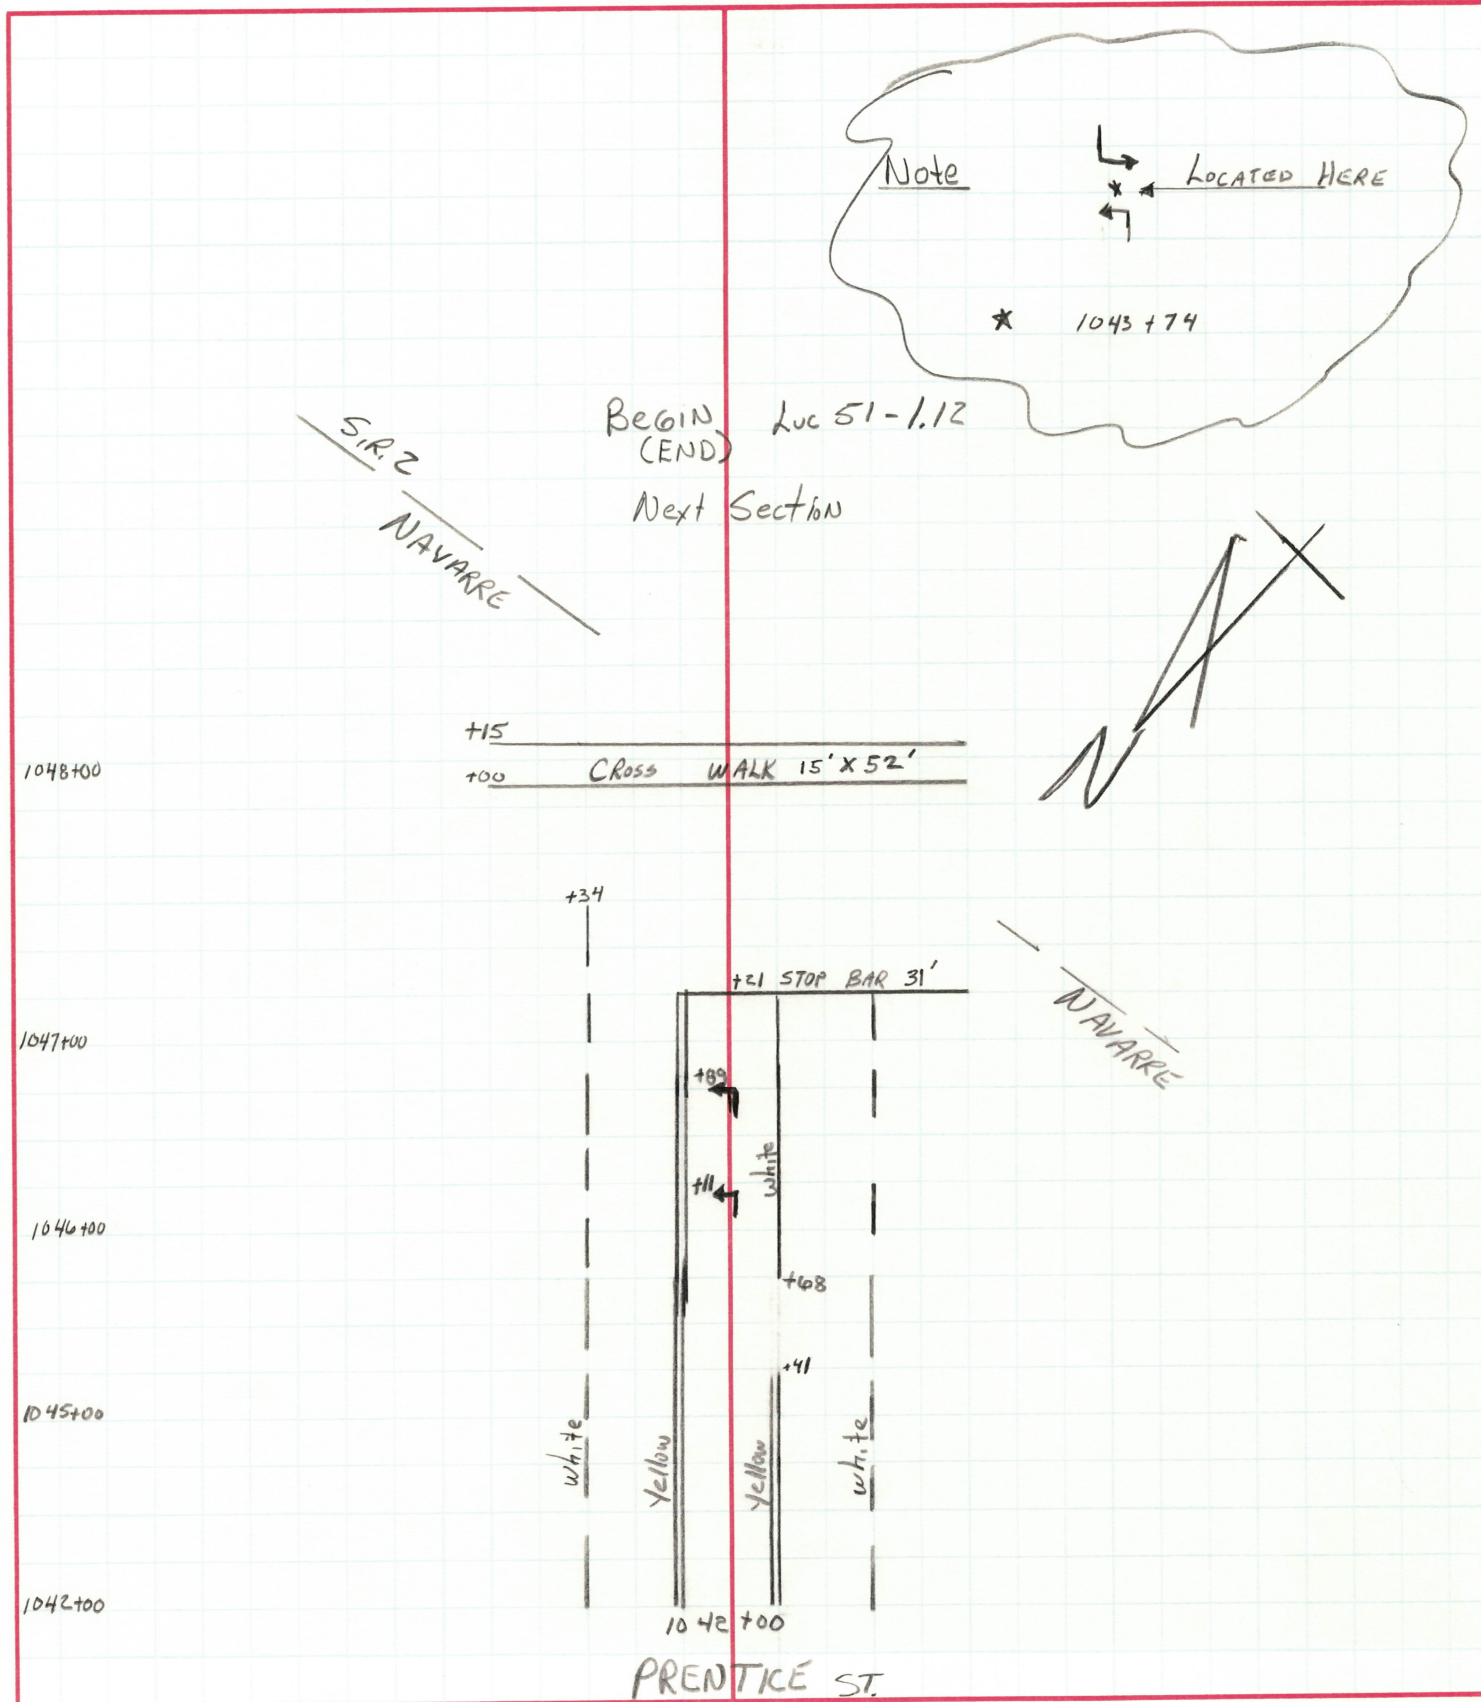

1995 4-
[REDACTED] TWO-LANE RESURFACING PROGRAM
CROSSWALKS AND STOP BARS

SHEET 8 OF 9

[illegible]

194SWH

OHIO DEPARTMENT OF TRANSPORTATION

SHEET NO. 9 of 9

PERSONNEL

TITLE

PERSONNEL

TITLE

COUNTY

Lucas

DATE

1-3-95

LOEHKE

Crew

S. R.

S.R. 2

WEATHER

Cloudy - Cold

SEC.

19.40

TEMP.

+20

DESCRIPTION

MANHOLE & INLETS NOT ON SH#4

JOB NO.

LEFT

CENTER LINE

RIGHT



CURB Inlet

+19/25 Lt

M. Hole

+13/17 Lt

BERRY st

NOTE: outs from
PAVT S.R. 2
EAST

(2) C. Basins
SIDE by SIDE

+55/16 Lt

+1048+50

+38/18 Lt

M. Hole

RAISE

+24/17 Lt

+19/35
RT M. HOLE
RAISE

S.R. 51

1048+08

S.R. 2 & S.R. 5

NAVARRE

Post-It Fax Note

7671

Date

12/5/96

of pages

4

To

STEVE HOFFMAN

From

David Hohenberger

Co./Dept.

ODOT

Co.

City of Toledo

Phone #

353-8131

Phone #

245-1345


Fax #

353-1468


Fax #

245-1310

MONUMENT REFERENCE

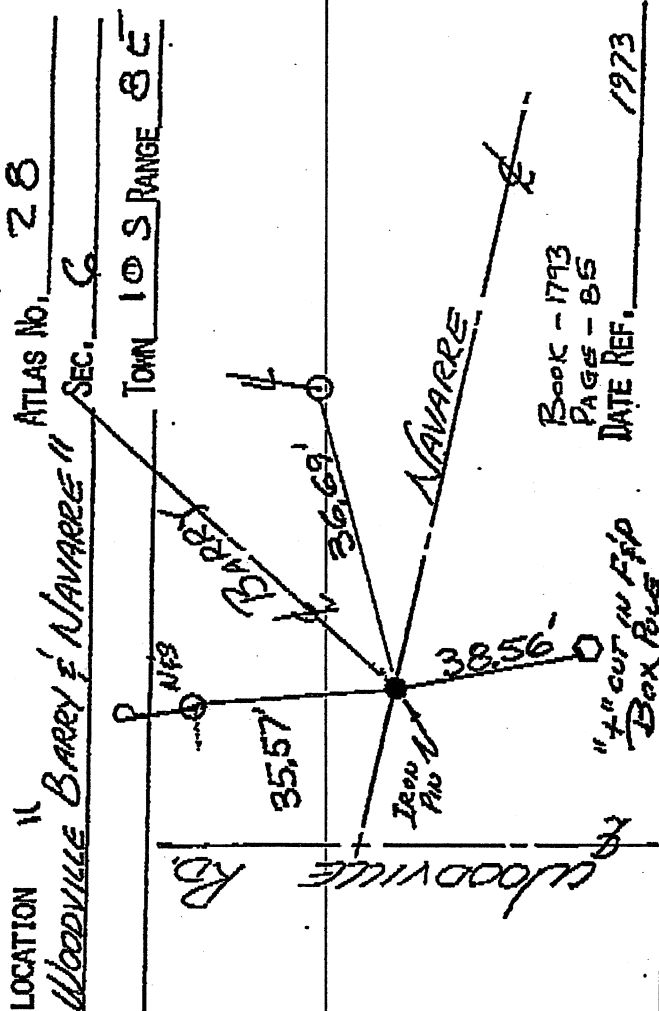

MONUMENT REFERENCE

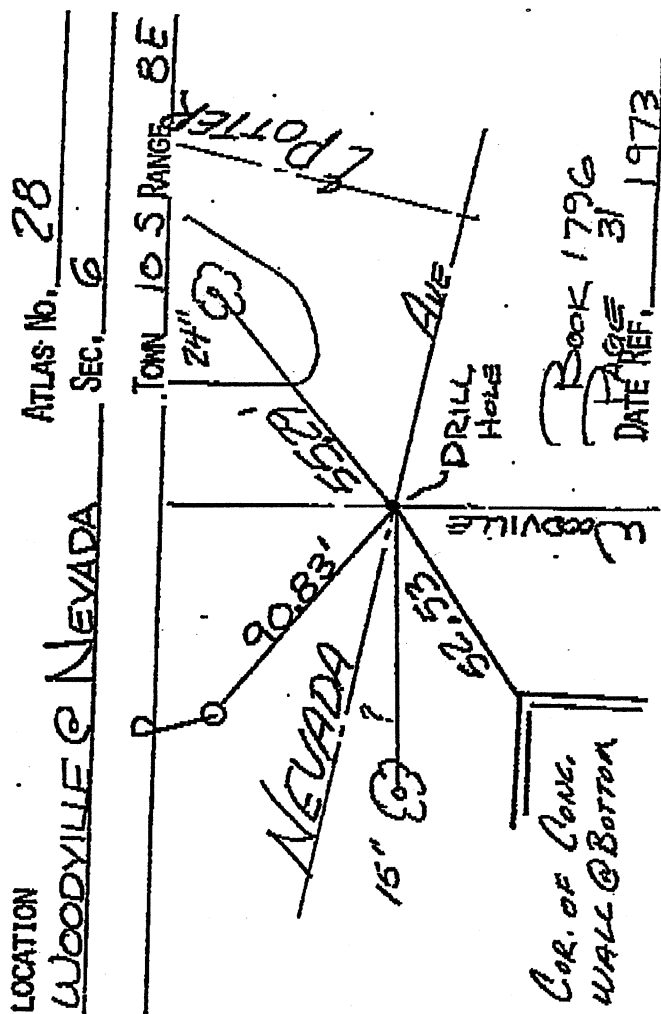

MONUMENT REFERENCE

LOCATION

ATLAS No. 30

WOODVILLE & EARL

SEC. 7

TOWN 10.5. RANGE 8. E.

"T" CUT IN
1ST STEPBook 1793
PAGE 79EARL N⁸ 31.12'

WOODVILLE

BRASS
MON."T" CUT IN
1ST STEP

DATE REF. 1973

MONUMENT REFERENCE

LOCATION

ATLAS No. 30

WOODVILLE (City Line -
E. Broadway)

SEC. 7

TOWN 12.5. RANGE 8. E.

SEE BOOK #1793
PAGE 78

GLENS

COR. OF BLDG.

P N⁸ S

40.21'


36.82'

BRASS
MON.41.23' P N⁸ S


DATE REF. 1973

Book - 1793
PAGE - 78

MONUMENT REFERENCE

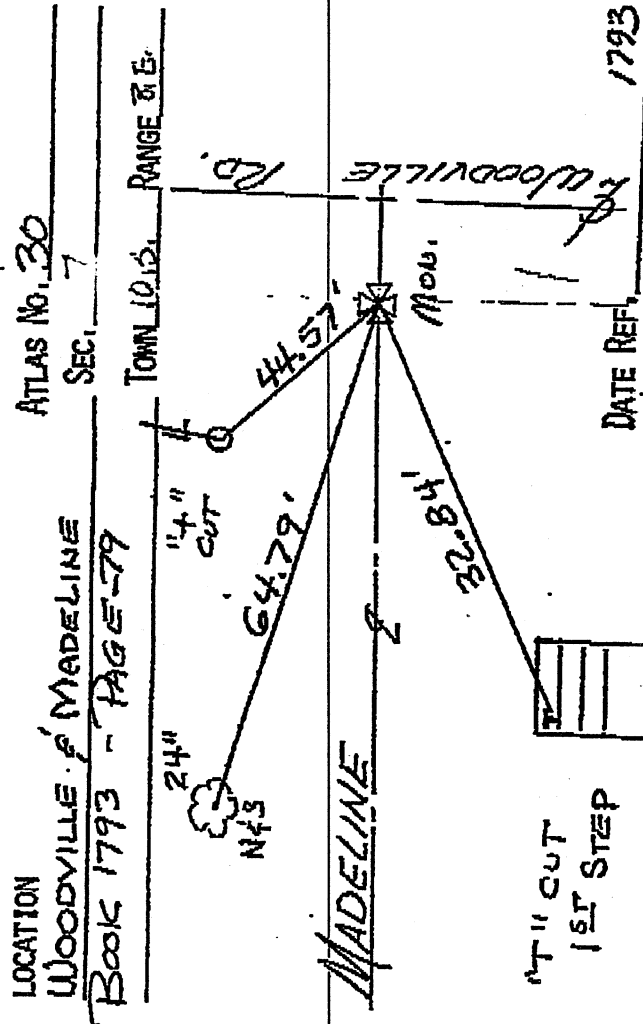

MONUMENT REFERENCE

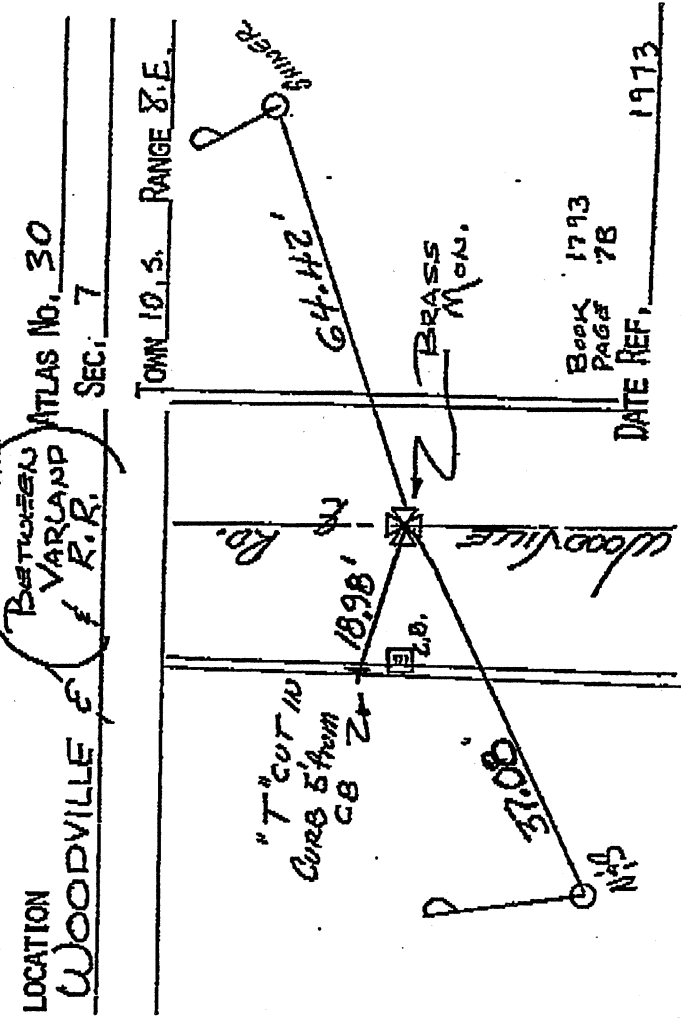


PLANNED REFERENCE

LOCATION
E. BROADWAY & WOODVILLE SEC. 30

ATLAS No. 30

SEC.

TOWN RANGE

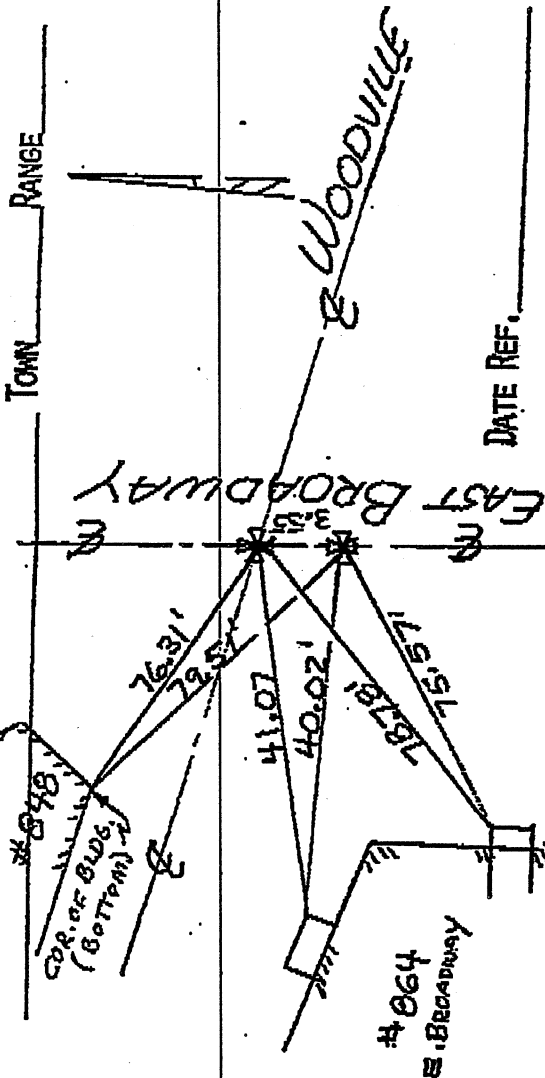

DATE REF.

SEC. 7 30

