


O.D.O.T. DISTRICT 2 SURVEY OFFICE (USE ONLY)


PERSONNEL _____ REFERENCE NO. 8 A SHEET 10 OF 31
 NOTES HOMAN DATE 7/29/16 ROUTE SR 2
 H.C. HOMAN WEATHER SUNNY COUNTY LUCAS
 R.C. RYALL TEMP. 84°F TOWNSHIP SWANTON
 SECTION 3
 T 7 N R 5 E

TYPE MONUMENT MON BOX W/ IPIN
 ON SURFACE - ~~BELOW~~ ON
 LEFT - ☉ PAV'T - RIGHT ON
 TO EDGE PAVEMENT
 S.L.M. 200+57

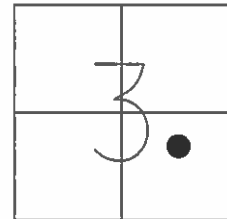

GRID: NORTHING: 705022.4238 EASTING: 1610279.754


RECORD:
 FD MON BOX
 W/ IPIN
 GPS, REFA8
 07/29/16

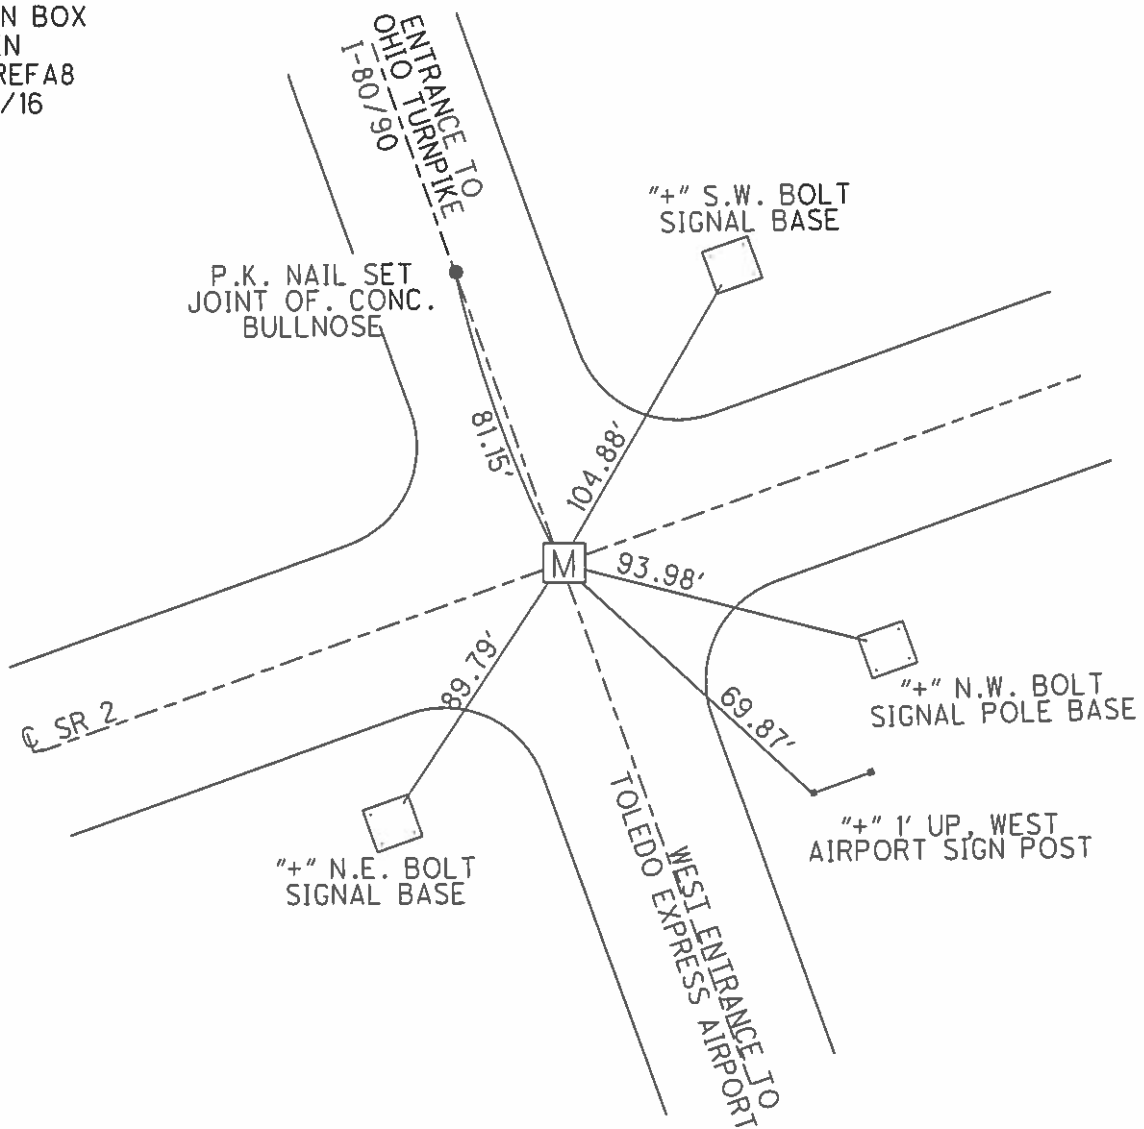


O.D.O.T. DISTRICT 2 SURVEY OFFICE (USE ONLY)

PERSONNEL _____ REFERENCE NO. 8 A SHEET 10 OF 11
 NOTES HOMAN DATE 6-15-03 ROUTE SR 2
 H.C. HOMAN WEATHER FAIR COUNTY LUCAS
 R.C. RYALL TEMP. 75° TOWNSHIP SWANTON
 _____ SECTION 3
 _____ T 7 N R 5 E

TYPE MONUMENT MON.BOX
 ON SURFACE - BELOW _____ ON _____
 LEFT - ☉ PAV'T - RIGHT _____ ON _____
 _____ TO _____ EDGE PAVEMENT
 S.L.M. 208+57

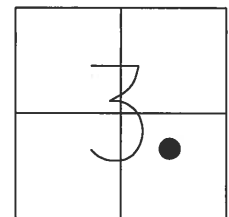

GRID: NORTHING: 705022.346 EASTING: 1610279.754

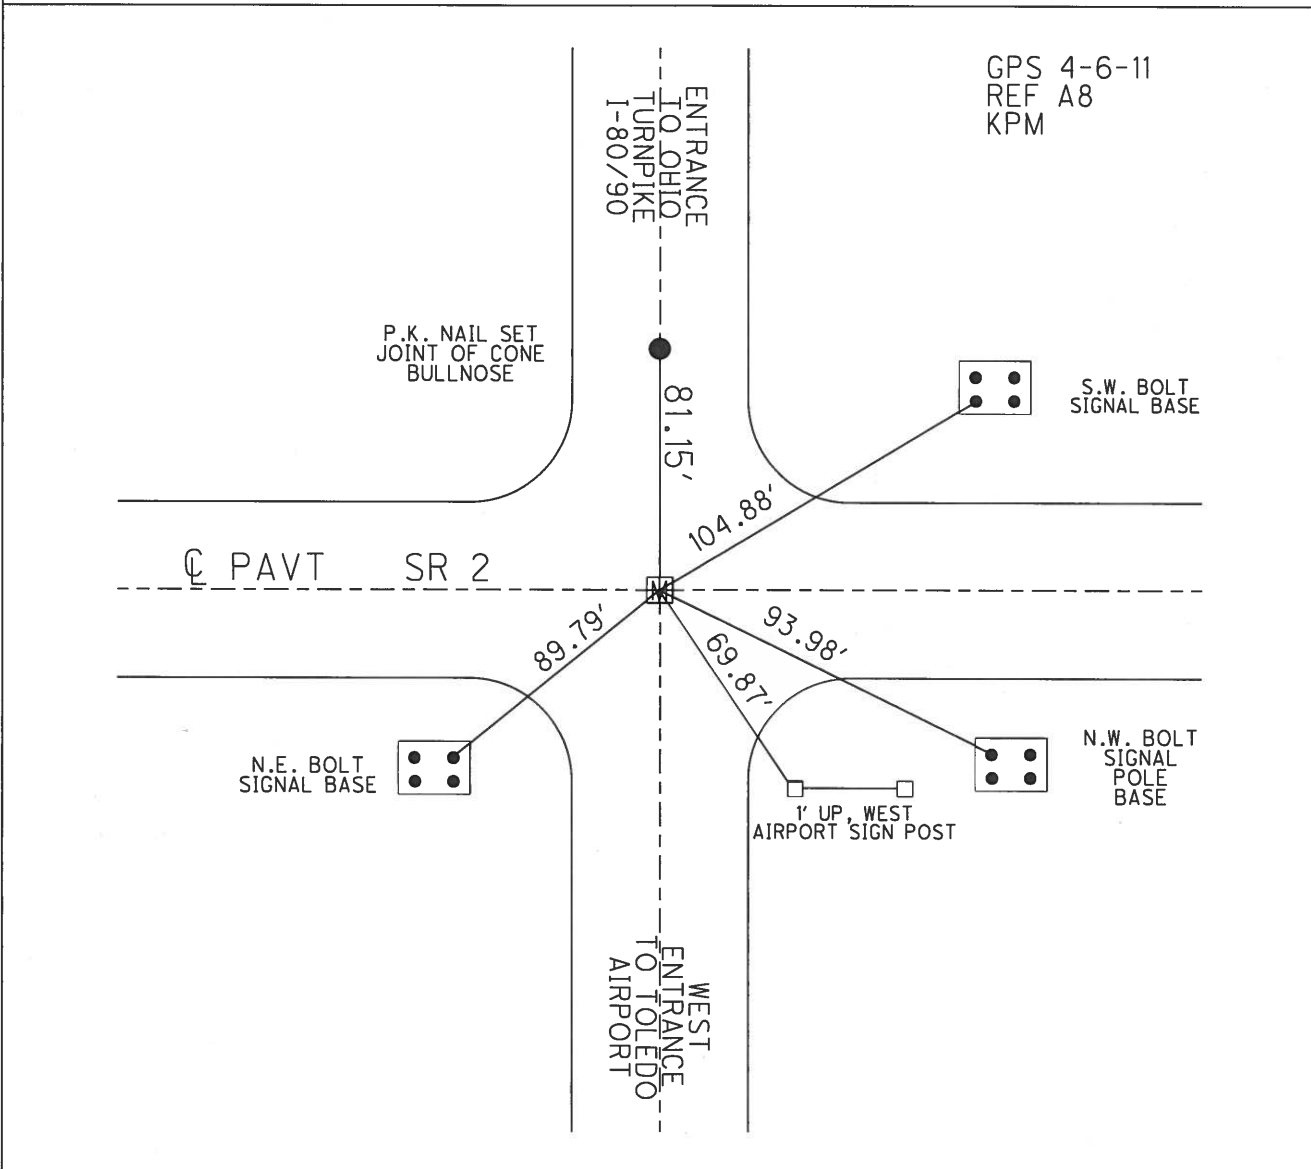

O.D.O.T. DISTRICT 2 SURVEY OFFICE

PERSONNEL _____

REFERENCE NO. B-A

SHEET 10 OF 11

NOTES Homant

H.C. Homant

R.C. Ryall

DATE 6-15-03

WEATHER Fair

TEMP. 75'

ROUTE SR 2

COUNTY Lucas

TOWNSHIP Swanton

SECTION 3

T 7 N R 5 E



TYPE MONUMENT I.P.W. - monument Box

ON SURFACE - ~~BELOW~~ yes

~~LEFT - & PAV'T. - RIGHT~~ yes

~~- TO -~~ EDGE PAVEMENT

S.L.M. 208 + 57

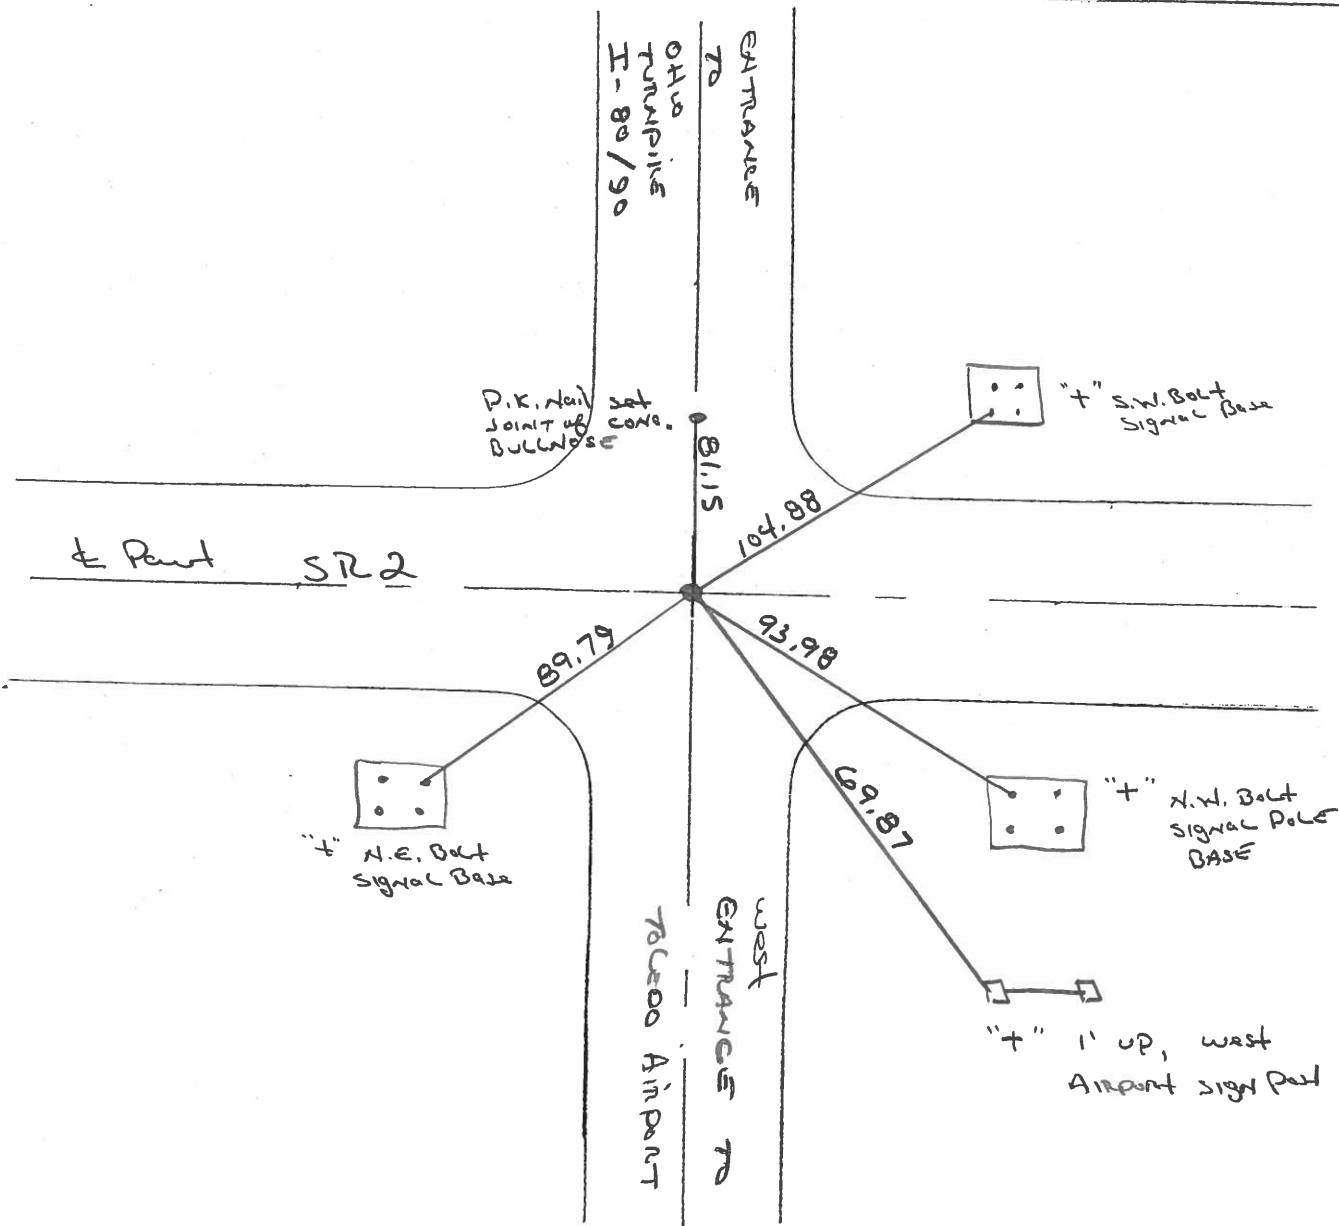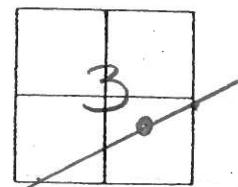

PERSONNEL TITLE PERSONNEL TITLE

Radzinski _____
 Carpenter _____
 Stone _____
 Brindley _____

COUNTY Lucas DATE 4-13-54

S. R. 2 WEATHER Good

SEC. _____ TEMP. 70°

DESCRIPTION

Mon. Setting

LEFT

CENTER LINE

RIGHT

JOB NO. _____

