

O.D.O.T. DISTRICT 2 SURVEY OFFICE (USE ONLY)

PERSONNEL

REFERENCE NO. 11 AC

SHEET 17 OF 29

NOTES LEU

DATE 6/1/17

ROUTE SR 2

H.C. HOMAN

WEATHER SUNNY

COUNTY LUCAS

R.C. CARSON

TEMP. 70°

TOWNSHIP SPRINGFIELD

DWG BY RHOADES PID 88525

SECTION 36

T 8 N R 9 E

TYPE MONUMENT MAG/WASHER

ON SURFACE - ~~BELOW~~ ON

OFFSET Q PAVEMENT ON LT : RT

 TO EDGE PAVEMENT


STATION: 302+98.46

HORIZ.DATUM: NAD83 2011


GEOID: NAVD88 2012A

GRID: NORTHING: 708648.499

EASTING: 1618973.614

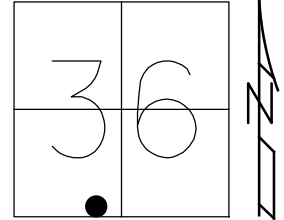

RECORD:
FD P.K.NAIL
SET MAG/WASHER
NEWREFAC11
6/01/17, JLL
FD MAG/WASHER
REFAC11
8/18/20, DSA
4/30/21, DSA
11/21/22, TDN

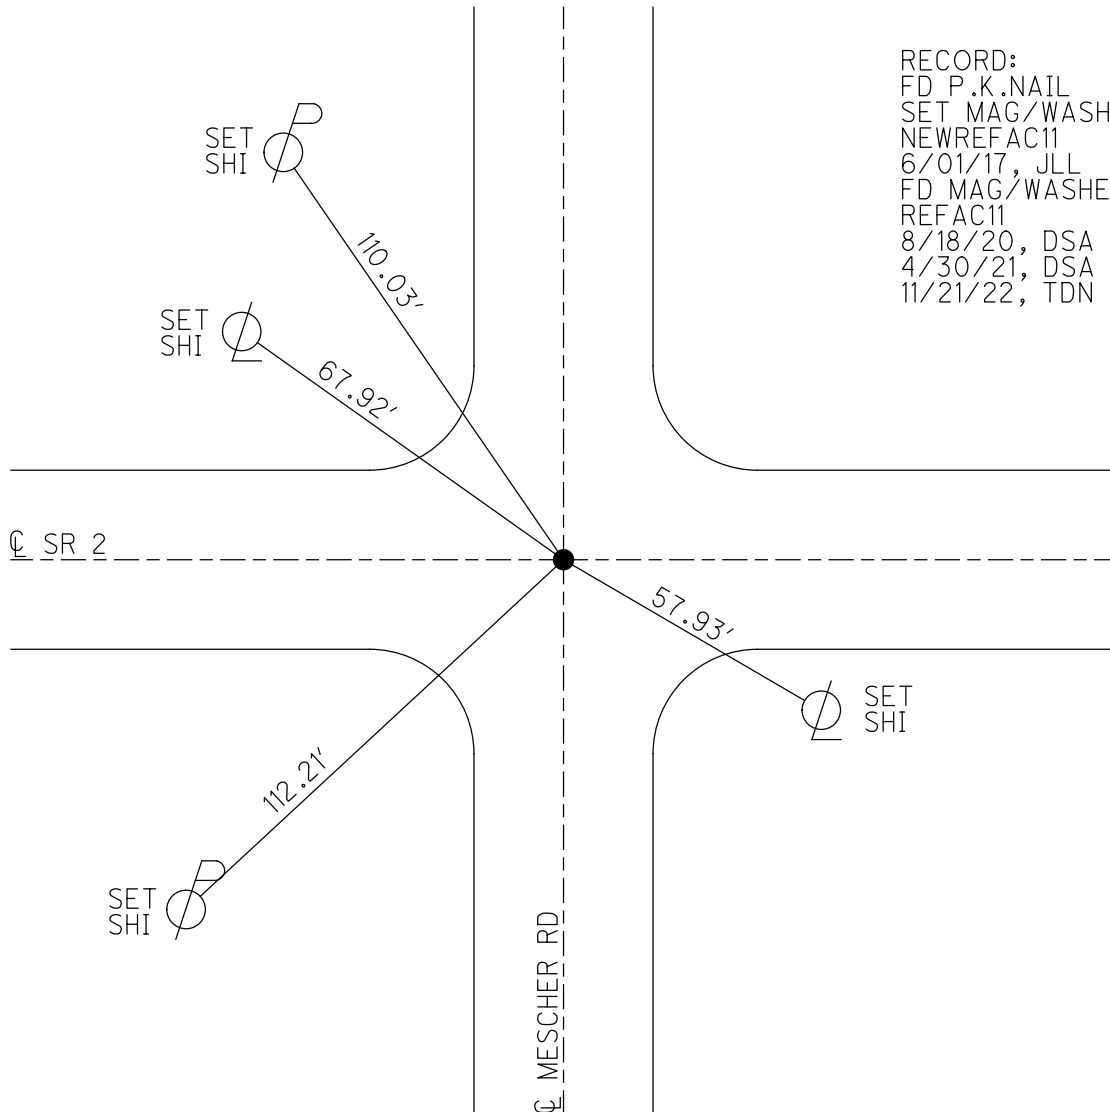

O.D.O.T. DISTRICT 2 SURVEY OFFICE (USE ONLY)

PERSONNEL

REFERENCE NO. 11 AC

SHEET 17 OF 31

NOTES LEU

DATE 6/01/17

ROUTE SR 2

H.C. HOMAN

WEATHER SUNNY

COUNTY LUCAS

R.C. CARSON

TEMP. 70°

TOWNSHIP SPRINGFIELD

SECTION 36

DWG BY NIESE

PID 11616

T 8 N R 9 E

TYPE MONUMENT MAG/WASHER

ON SURFACE - ~~BELOW~~ ON

OFFSET ☉ PAVEMENT ON LT : RT

TO EDGE PAVEMENT



STATION: 302+98.46

HORZ.DATUM: NAD83(2011)

GEOID: NAVD88 2018

GRID: NORTHING: 708648.517

EASTING: 1618973.596

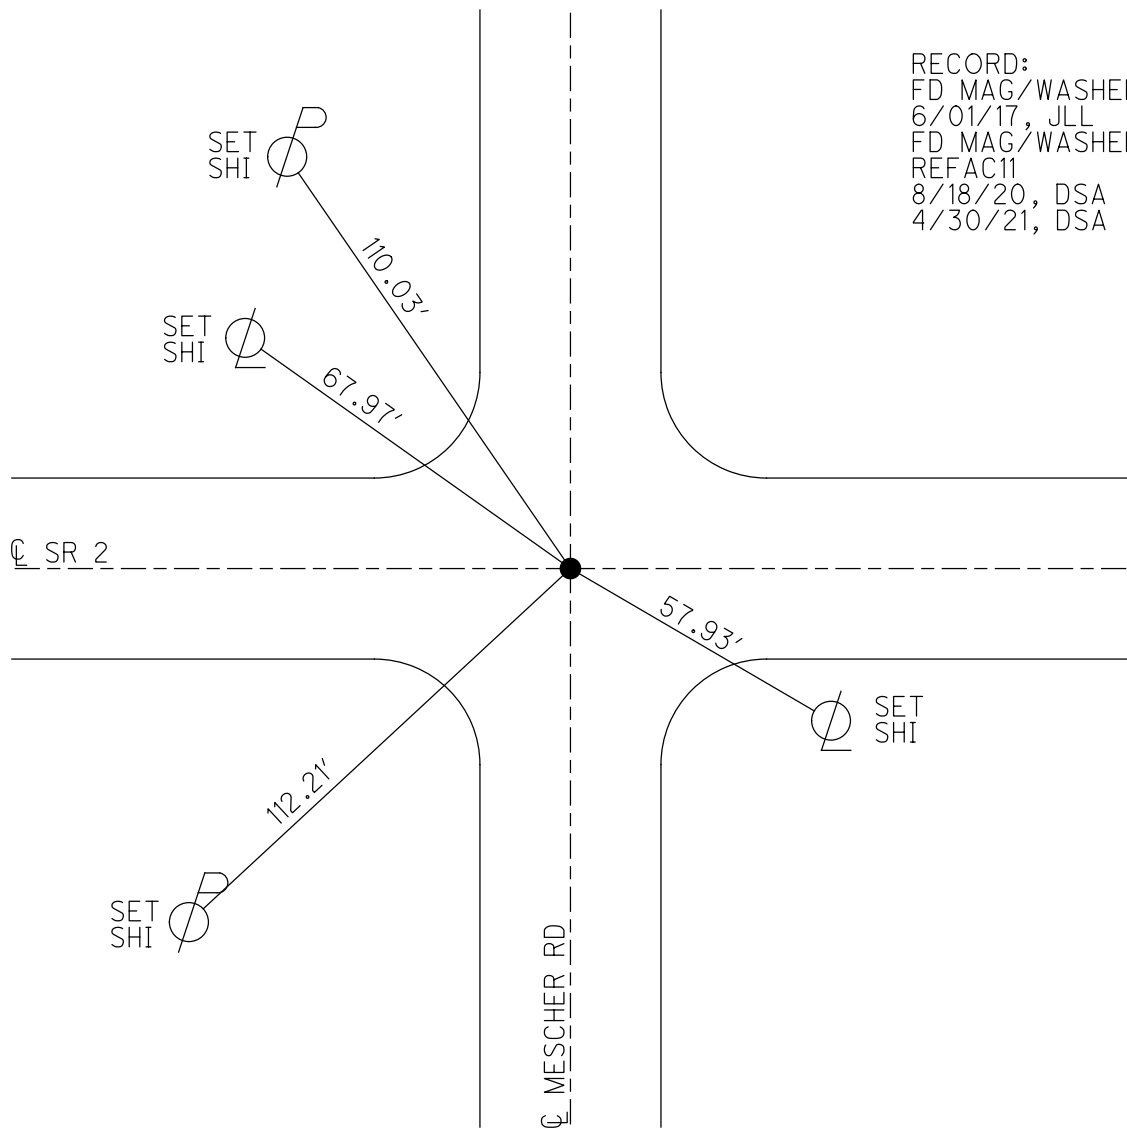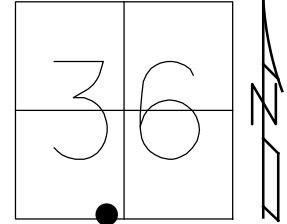

RECORD:
FD MAG/WASHER
6/01/17, JLL
FD MAG/WASHER
REFAC11
8/18/20, DSA
4/30/21, DSA

O.D.O.T. DISTRICT 2 SURVEY OFFICE (USE ONLY)

PERSONNEL _____ REFERENCE NO. 11 AC SHEET 17 OF 31
NOTES LEU DATE 6/01/2017 ROUTE SR 2
H.C. HOMAN WEATHER SUNNY COUNTY LUCAS
R.C. CARSON TEMP. 70° TOWNSHIP SPRINGFIELD
SECTION 36
T 8 N R 9 E

TYPE MONUMENT MAG/WASHER
ON SURFACE - BELOW _____
LEFT - ☉ PAV'T - RIGHT _____
_____ TO _____ EDGE PAVEMENT
S.L.M. 302+98.46
GRID: NORTHING: 708648.499 EASTING: 1618973.614

