

O.D.O.T. DISTRICT 2 SURVEY OFFICE (USE ONLY)

PERSONNEL

REFERENCE NO. 18 A

SHEET 4 OF 18

NOTES LOEHRKE

DATE 4-1-94

ROUTE SR 2

H.C. CANTERBURY

WEATHER NICE

COUNTY LUCAS

R.C. VOGEL

TEMP. 46°

TOWNSHIP SPRINGFIELD

SECTION 16

DWG BY JAMES PID 95717

T 8 N R 10 E

TYPE MONUMENT MONBOX

ON SURFACE - ~~BELOW~~ ON

OFFSET CL PAVEMENT ON LT : RT  
28' TO RT EDGE PAVEMENT


STATION: 495+95

HORZ. DATUM: NAD83 2011


GEOID: NAVD88 2012A

GRID: NORTHING: 710592.059

EASTING: 1638013.350

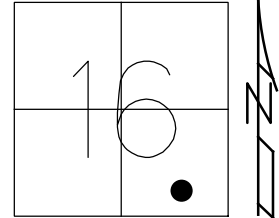

RECORD: P.T.  
FD MONBOX  
4-1-94, CL  
FD MONBOX  
W/ 1" IPIN  
REFA18  
6-23-16, JFO

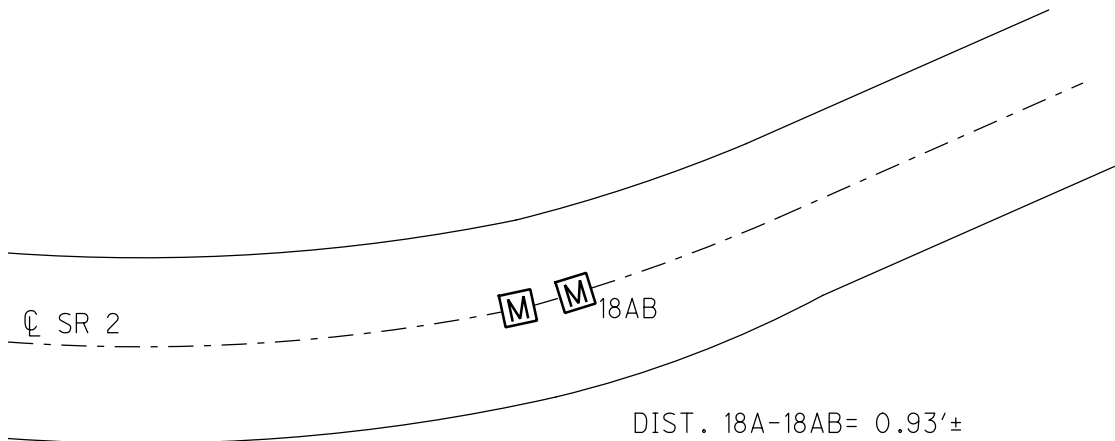

O.D.O.T. DISTRICT 2 SURVEY OFFICE

PERSONNEL

REFERENCE NO. 18-1A

SHEET 19 OF 25

NOTES Loehrke

H.C. CANTERBURY

R.C. VOGEL

DATE 4-1-94

WEATHER Nice

TEMP. +46

ROUTE S.R. 2

COUNTY LUCAS

TOWNSHIP SPRINGFIELD

SECTION 16

T8 N R 10 E


TYPE MONUMENT Mon Box

ON SURFACE - BELOW Yes


LEFT - & PAV'T. - RIGHT Yes

28' TO RT EDGE PAVEMENT

S.L.M. 495+95

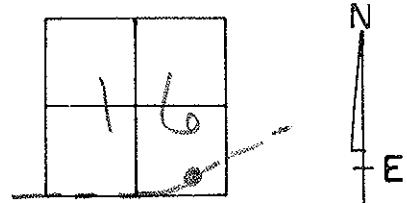

Appears To be P.T.

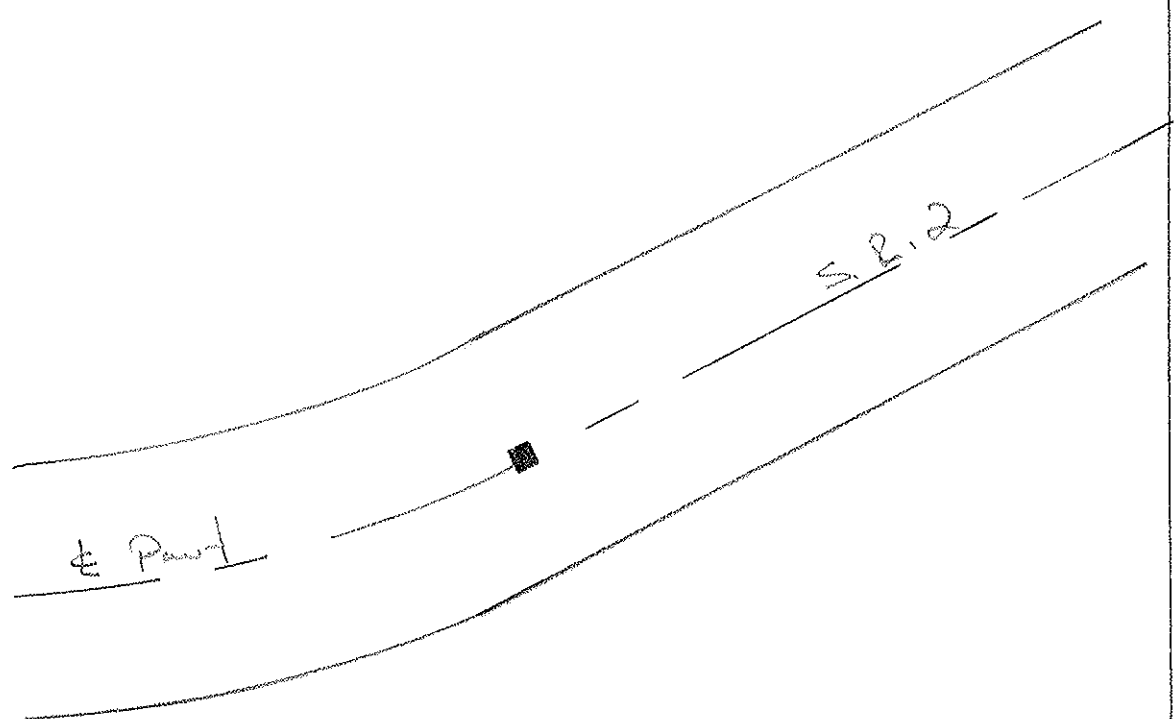

PERSONNEL	TITLE	PERSONNEL	TITLE	COUNTY	DATE
				Lucas	9-20-57 4-30-62
				S. R. #2	WEATHER
				SEC.	TEMP.

DESCRIPTION	LEFT	CENTER LINE	RIGHT	JOB NO.
Sta. 178+83.15 Holloway Rd. Iron cap	#135 (18)		S.W. to N.E. cor. conc. block fdn. 75.57' S.E. to point of "V" in P. B.M. 44.06' N.E. to S.W. cor. Gas. Sta. bldg. 93.48'	
Sta. 185+20.37 P.C. of curve Brass Cap	#136		S. to E/W men. 30.03' N. to E/W men. (Rent over) 30.19' N.W. to witness man. 41.72' N.E. to witness man. 41.17'	
Sta. 187+99.76 P.I. of curve Fd. old stake - Fd. Brass Plate.	#137		S.W. to shiner in 18" apple <del>28.94</del> 28.68 S.S.W. to shiner in 18" apple <del>16.17</del> 16.17 S.E. to shiner in 20' pine 44.10 <del>43.96</del>	
Sta. 190+63.98 P.T. of curve Brass plate	#138 (18-A)	Could not Find Ties gone	N.N.W. to witness man. 36.58' S.E. to shiner in P.P. 29.89' N. to shiner in T.P. 35.30' N.W. to shiner in 20' apple 75.17'	
Sta. 193+52.76 P.C. curve Brass Cap.	#139		E.N.E. to S.W. cor. of bridge rail 74.86 E.S.E. to N.W. cor. of bridge rail 78.40 N.W. to shi in Guard rail post 31.58 S.W. to shi. in Guard rail post 32.78 N.W. to witness man. 40.63' N.E. to witness man. 34.92' S.S.W. to witness man. 25.37'	