

O.D.O.T. DISTRICT 2 SURVEY OFFICE (USE ONLY)

PERSONNEL \_\_\_\_\_

REFERENCE NO. 19 AA

SHEET 9 OF 18

NOTES LOEHRKE DATE 4/1/94  
 H.C. CANTERBURY WEATHER NICE  
 R.C. VOGEL TEMP. 48°

ROUTE SR 2  
 COUNTY LUCAS  
 TOWNSHIP SPRINGFIELD  
 SECTION 15  
 T 2 USR

DWG BY RHOADES PID -

TYPE MONUMENT P.K.NAIL

ON SURFACE - ~~BELOW~~ ON


OFFSET ☉ PAVEMENT ON LT : RT

26.9' TO RT EDGE PAVEMENT


STATION: 520+87

HORZ.DATUM: \_\_\_\_\_ GEOID: \_\_\_\_\_

GRID: NORTHING: \_\_\_\_\_ EASTING: \_\_\_\_\_

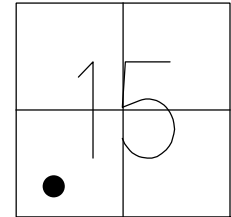

RECORD:  
 STA. 519+71.2  
 FD P.K.NAIL  
 4/1/94, CL  
 SET P.K./WASHER  
 5/9/94, CL

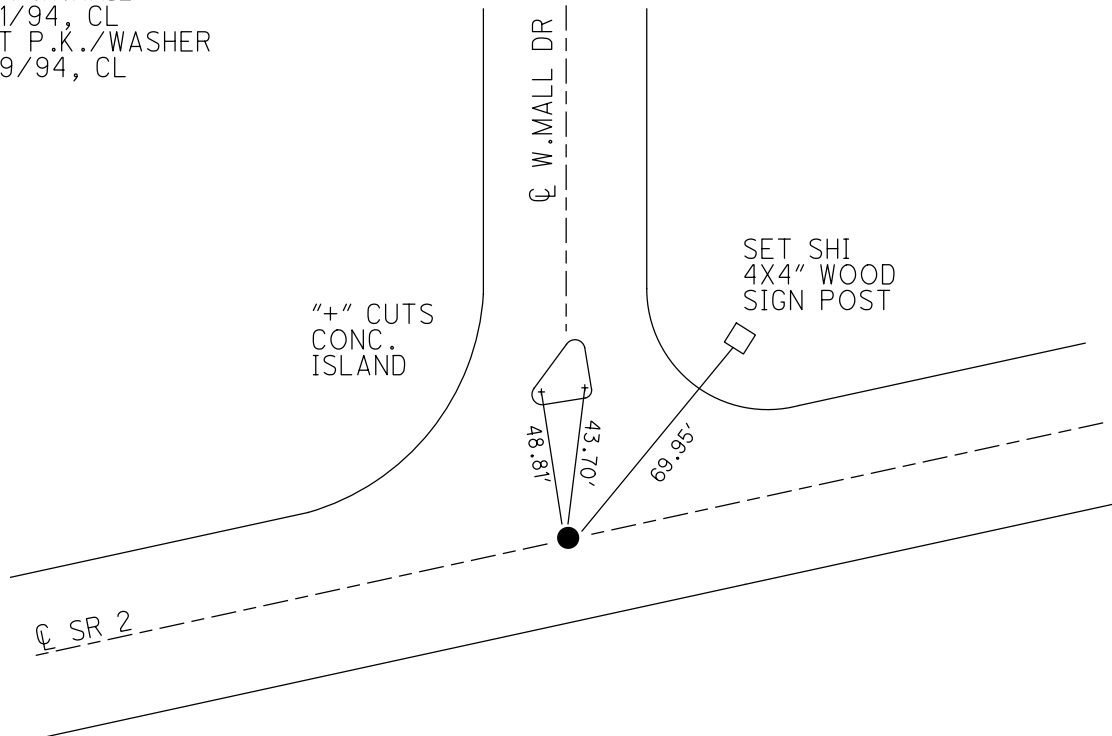

# O.D.O.T. DISTRICT 2 SURVEY OFFICE

PERSONNEL \_\_\_\_\_

REFERENCE NO. 19-A

SHEET 23 OF 25

NOTES Lochrke

H.C. CANTERBURY

R.C. VOGEL

DATE 4-1-94

WEATHER Nice

TEMP. + 48

ROUTE S.R. 2

COUNTY Lucas

TOWNSHIP Springfield

SECTION 15

T 10 N R 10 E

Reset P.K./WASHER  
5-9-94  
C.L.

TYPE MONUMENT PK

ON SURFACE - ~~BELOW~~ Yes

LEFT- & PAV'T. - RIGHT BOTH

26.9 TO Rt EDGE PAVEMENT

S.L.M. 519 712

