

O.D.O.T. DISTRICT 2 SURVEY OFFICE (USE ONLY)

PERSONNEL

REFERENCE NO. 19 AB

SHEET 10 OF 18

NOTES LOEHRKE DATE 4/1/94
 H.C. CANTERBURY WEATHER NICR
 R.C. VOGEL TEMP. 48°

ROUTE SR 2
 COUNTY LUCAS
 TOWNSHIP SPRINGFIELD
 SECTION 15
 T 2 USR

DWG BY RHOADES PID -

TYPE MONUMENT P.K.NAIL

ON SURFACE - ~~BELOW~~ ON


OFFSET \varnothing PAVEMENT ON LT : RT

27' TO RT EDGE PAVEMENT


STATION: 527+76

HORZ.DATUM: _____ GEOID: _____

GRID: NORTHING: _____ EASTING: _____

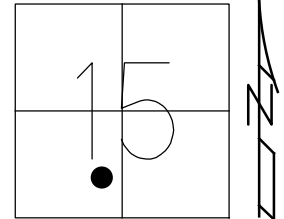

RECORD:
 STA. 526+60
 FD P.K.NAIL
 4/1/94, CL
 SET P.K./WASHER
 5/9/94, CL

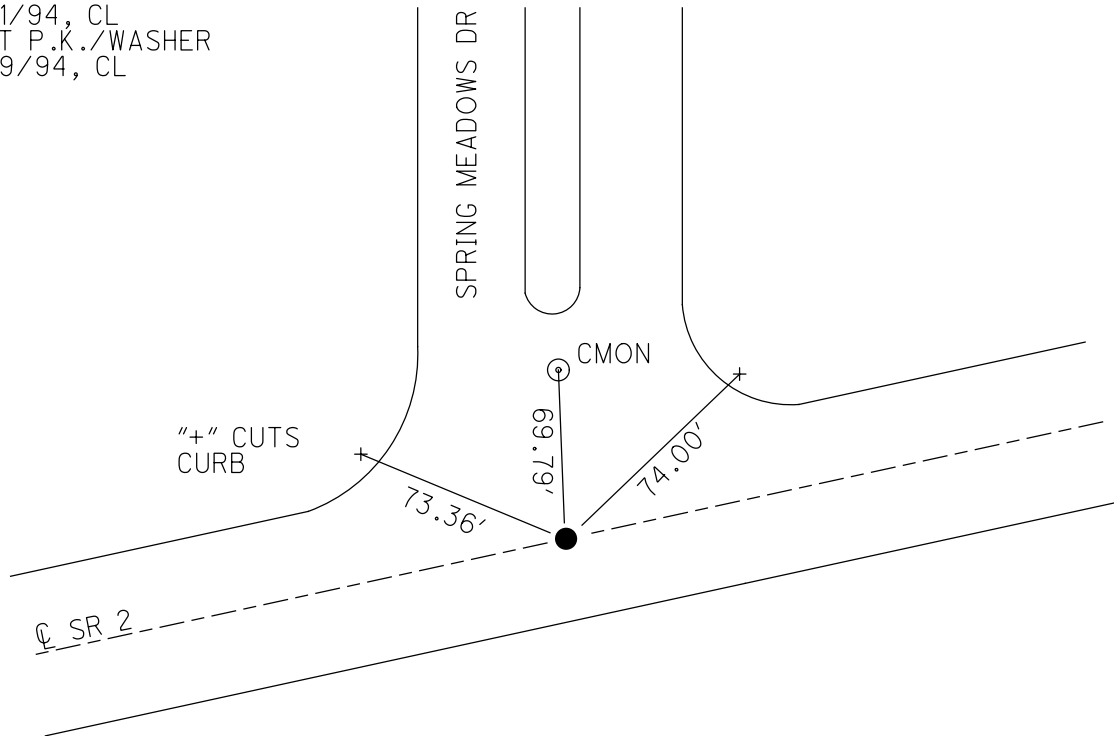

O.D.O.T. DISTRICT 2 SURVEY OFFICE

PERSONNEL _____

REFERENCE NO. 19-B

SHEET 24 OF 25

NOTES LOEHRKE

H.C. CANTERBURY

R.C. VOGEL

DATE 4-1-94

WEATHER Nice

TEMP. +48

ROUTE SR. 2

COUNTY LUCAS

TOWNSHIP Springfield

SECTION 15

T. N R. 10 E


TYPE MONUMENT P.K.

ON SURFACE - ~~BELOW~~ YES

LEFT-~~☐~~ PAV'T. - ~~RIGHT~~ BOTH

27 TO RT EDGE PAVEMENT

S.L.M. 526 + 60

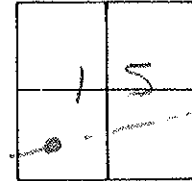

Reset P.K/WASHER
5-9-94
C.L.

