


PERSONNEL	TITLE	PERSONNEL	TITLE
Stone			
E			
Crew			

COUNTY Lucas DATE 7 Sep 62

S. R. #2 WEATHER Cool

SEC. TEMP. 58°

DESCRIPTION References to Control LEFT CENTER LINE RIGHT JOB NO.

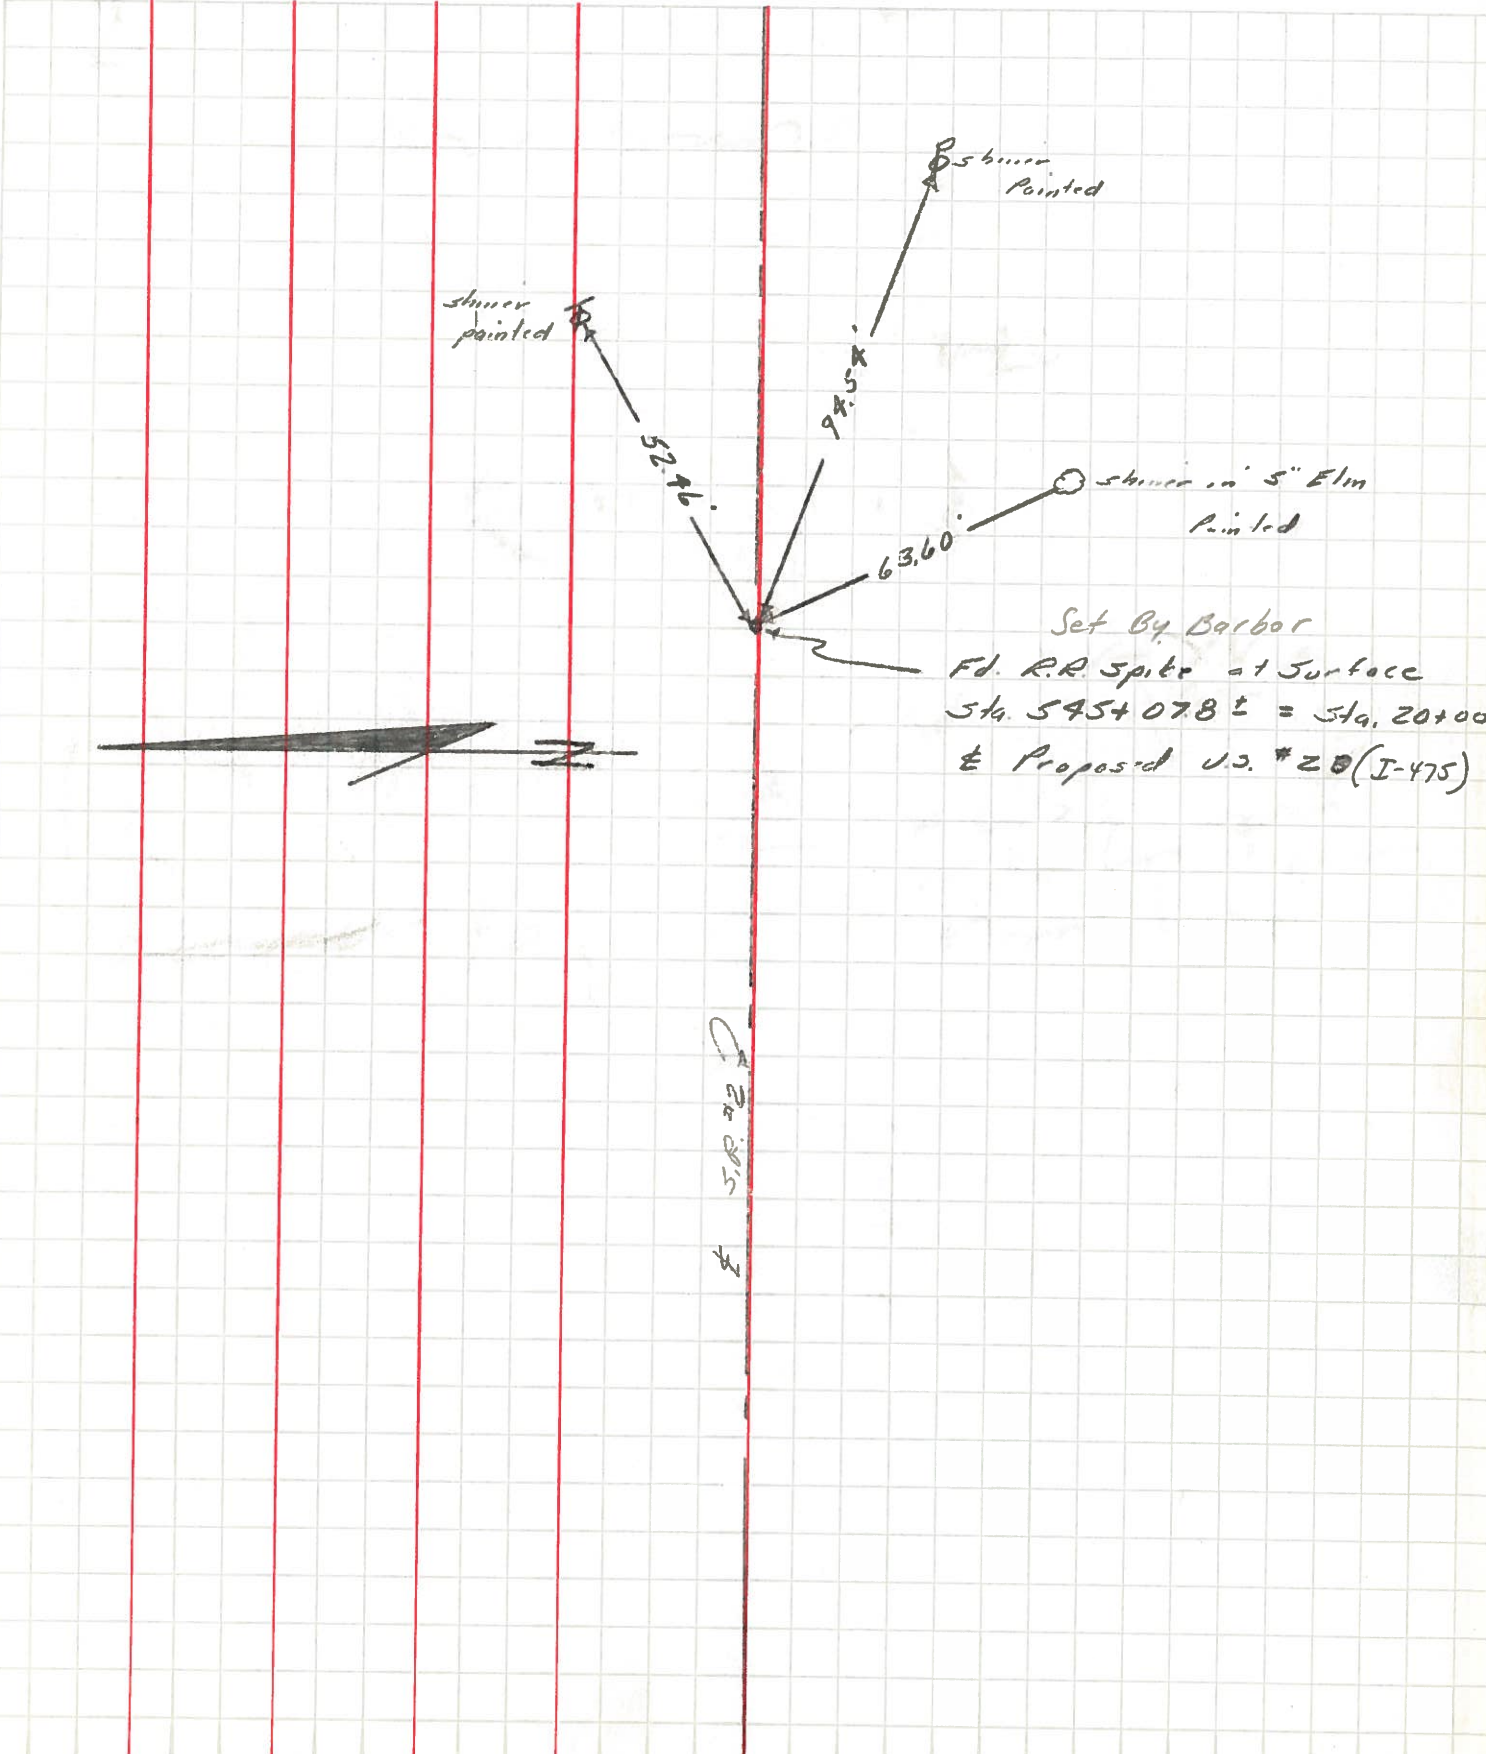

Set By Barbor
 Fd. R.R. Spike at Surface
 Sta. 545+07.8 ± = Sta. 20+00
 ± Proposed U.S. #20 (I-475)

± S.R. #2