


O.D.O.T. DISTRICT 2 SURVEY OFFICE (USE ONLY)


PERSONNEL _____ REFERENCE NO. 20 SHEET 12 OF 18
 NOTES HOMAN DATE 8-8-07 ROUTE SR 2
 H.C. ROUSOS WEATHER SUNNY COUNTY LUCAS
 R.C. HOUDSHELL TEMP. 85° TOWNSHIP SPRINGFIELD
 VIETH SECTION 15
 DWG BY JAMES PID 95717 T 8 N R 10 E

TYPE MONUMENT MONBOX W/ 1" IPIN
 ON SURFACE - ~~BELOW~~ ON
 OFFSET ☐ PAVEMENT ON LT : RT
- TO - EDGE PAVEMENT
 STATION: 563+37.60

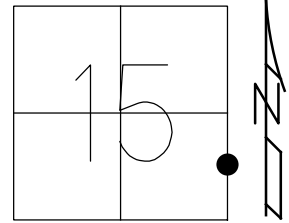

HORIZ.DATUM: NAD83 2011 GEOID: NAVD88 2012A
 GRID: NORTHING: 711570.001 EASTING: 1644699.422

RECORD:
 STA.563+43
 FD MONBOX
 3-30-94, CL
 SV9
 8-8-07, DCH
 FD MONBOX
 CNPT2
 4-18-16, DCH
 FD MONBOX
 W/ 1" IPIN
 REF20
 6-23-16, JFO

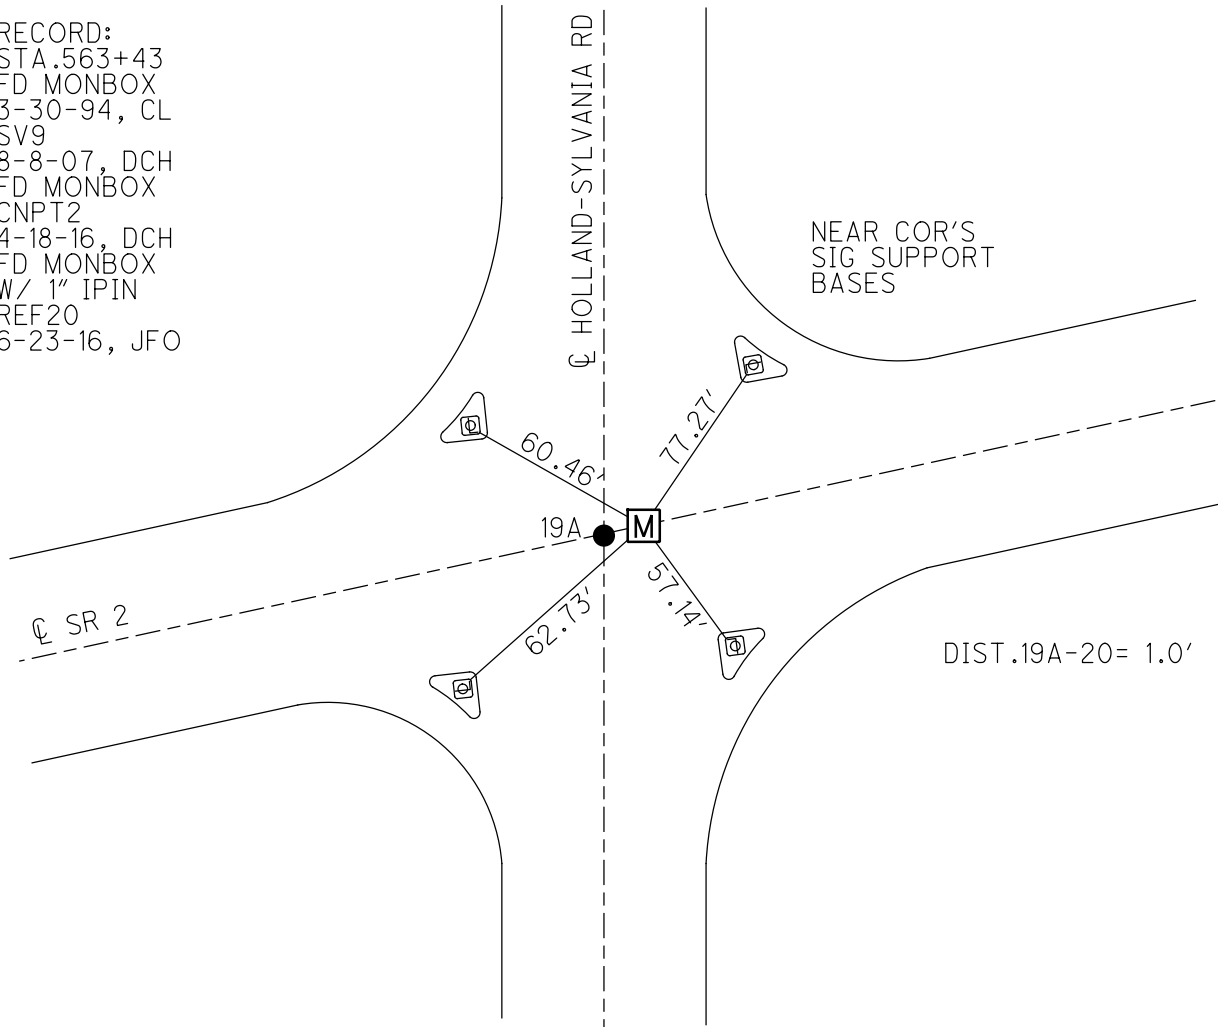

O.D.O.T. DISTRICT 2 SURVEY OFFICE (USE ONLY)

PERSONNEL

REFERENCE NO. 20

SHEET 5 OF 11

NOTES HOMAN
 H.C. ROUSOS
 R.C. HOUESHELL
VIETH

DATE 8/8/07
 WEATHER SUNNY
 TEMP. 85°

ROUTE SR 2
 COUNTY LUCAS
 TOWNSHIP SPRINGFIELD
 SECTION 15
 T 2 USR

DWG BY RHOADES PID 94724

TYPE MONUMENT MONBOX

ON SURFACE - ~~BELOW~~ ON

OFFSET \varnothing PAVEMENT ON LT : RT

- TO - EDGE PAVEMENT


STATION: 564+90.03

HORIZ.DATUM: NAD83 2011


GEOID: NAVD88 2012A

GRID: NORTHING: 711569.117

EASTING: 1644699.746

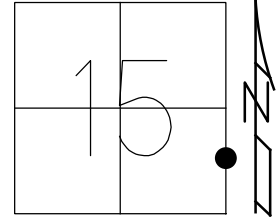


RECORD:
 STA.563+43
 FD MONBOX
 3/30/94, CL
 SV9
 8/8/07, DCH
 FD MONBOX
 CNPT2
 4/18/16, DCH

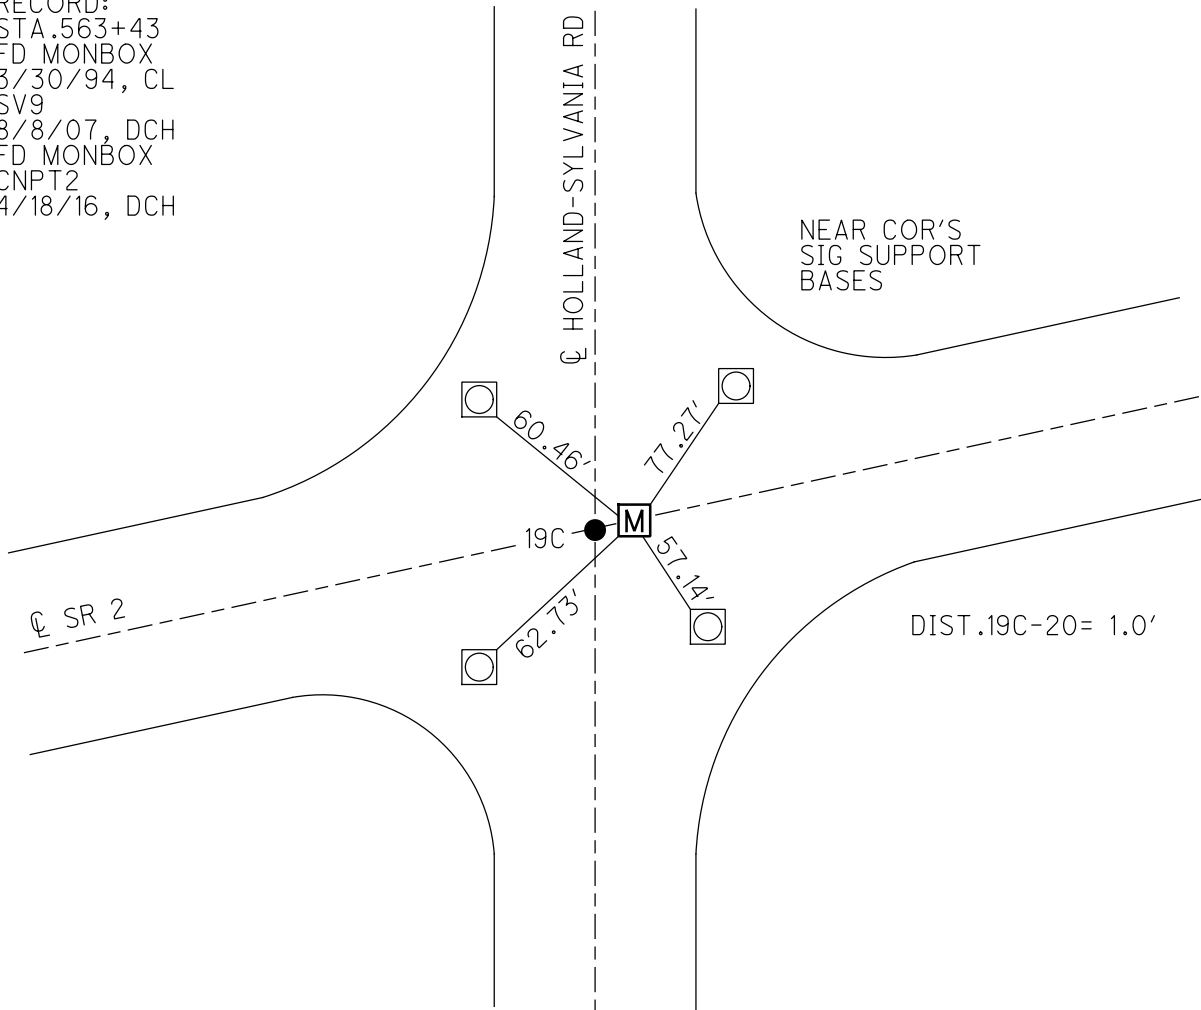

O.D.O.T. DISTRICT 2 SURVEY OFFICE (USE ONLY)

PERSONNEL	REFERENCE NO. <u>20</u>	SHEET <u>1</u> OF <u>5</u>
NOTES <u>HOMAN</u>	DATE <u>08-08-07</u>	ROUTE <u>SR 2</u>
H.C. <u>ROUSOS</u>	WEATHER <u>SUNNY</u>	COUNTY <u>LUCAS</u>
R.C. <u>HOUDSHELL</u>	TEMP. <u>+85°</u>	TOWNSHIP <u>SPRINGFIELD</u>
<u>VIETH</u>		SECTION <u>15</u>
		T <u>8</u> N R <u>10</u> E

TYPE MONUMENT "A"=PK SHANK, "B"=MON. BOX
 ON SURFACE - ~~BELOW~~ ON SURFACE
~~LEFT - C PAV'T - RIGHT~~ "A" IS ON CL.
TO EDGE PAVEMENT
 S.L.M. 563+43 (SV9)
 GPS Northing=711569.996 Easting=1644699.396

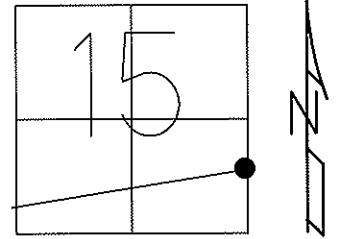

SET PK/WASHER @ "A"
05-09-94 CL

SET MAG/WASHER @ "A"
11-13-07 SAH

NOTE: ALL REFERENCES ARE FROM
THE NEAR CORNER OF THE
STEEL SIGNAL SUPPORT BASE.

"A" TO "B" = 1.0'

