

O.D.O.T. DISTRICT 2 SURVEY OFFICE (USE ONLY)

PERSONNEL _____

REFERENCE NO. 28 B

SHEET 9 OF 13

NOTES TOMSIK

DATE 9/8/60

ROUTE SR 2

H.C. DRAUR

WEATHER CLEAR-HOT

COUNTY LUCAS

R.C. CHOPPURESS

TEMP. 90°

TOWNSHIP ADAMS

ORLOK/NORRIS

SECTION 13

DWG BY NIESE PID _____

T 2 US R E

TYPE MONUMENT "+" IN BRICK _____

ON SURFACE - ~~BELOW~~ _____ ON _____


OFFSET \varnothing PAVEMENT _____ LT : RT

_____ TO _____ EDGE PAVEMENT


STATION: 723+98.58

HORZ.DATUM: _____ GEOID: _____

GRID: NORTHING: _____ EASTING: _____

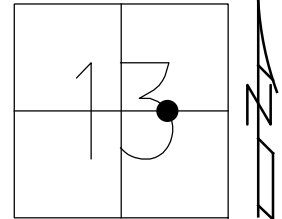

RECORD:
FD "+" IN BRICK
9/8/60

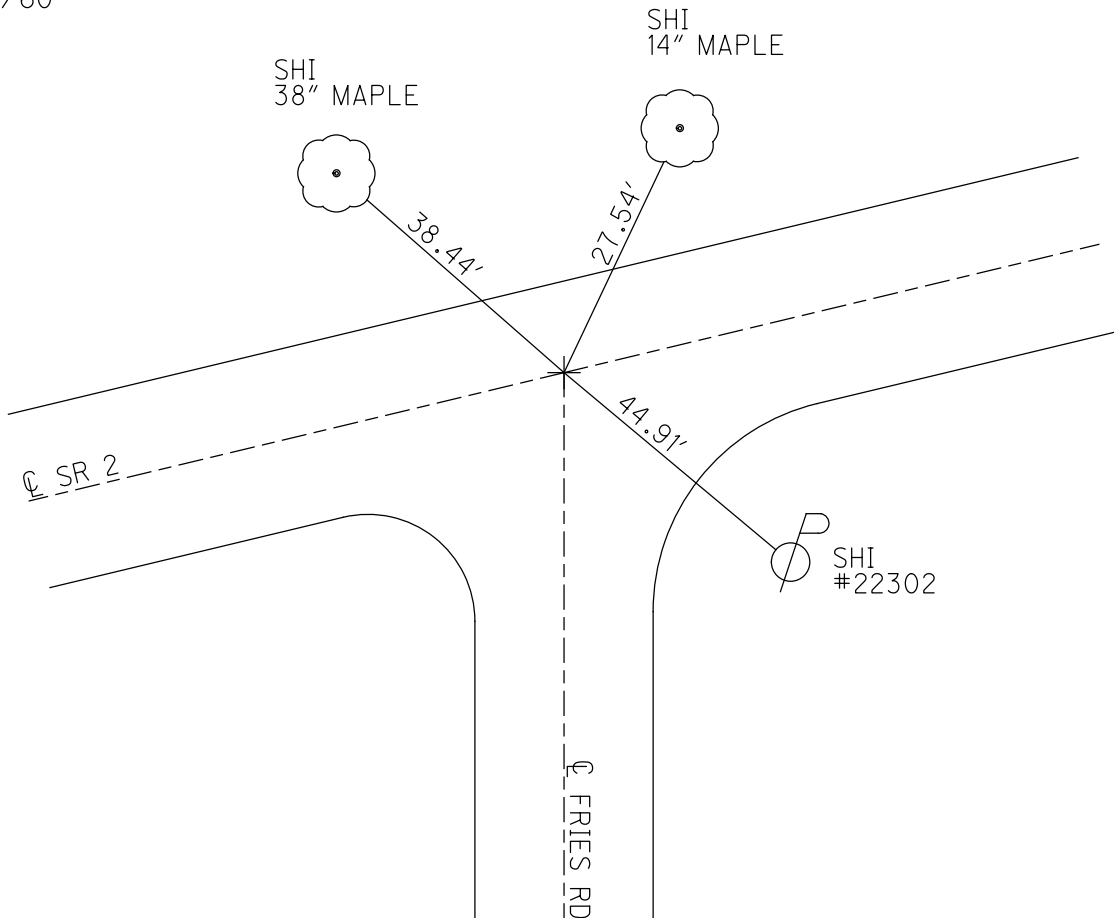

PERSONNEL TITLE PERSONNEL TITLE

Tomasic

Drake

Chappuis

Oluk

Norris

COUNTY Lucas

DATE Sept.-8-60

S. R. Lu-2

WEATHER clear-hot

SEC. Pt Byrne Rd

TEMP. 90°

DESCRIPTION Monument Reference

LEFT

CENTER LINE

RIGHT

JOB NO. _____

