

O.D.O.T. DISTRICT 2 SURVEY OFFICE (USE ONLY)

PERSONNEL

REFERENCE NO. 28 C

SHEET 10 OF 13

NOTES TOMSIC
 H.C. DRAUR
 R.C. CHOPPURESS
ORLOK/NORRIS

DATE 9/8/60
 WEATHER CLEAR-HOT
 TEMP. 90°

ROUTE SR 2
 COUNTY LUCAS
 TOWNSHIP ADAMS
 SECTION 13
 T 2 US R E

DWG BY NIESE PID _____

TYPE MONUMENT BRASS PLATE


ON SURFACE - ~~BELOW~~ ON

OFFSET Q PAVEMENT _____ LT : RT
 _____ TO _____ EDGE PAVEMENT


STATION: 729+69.60

HORZ. DATUM: _____ GEOID: _____

GRID: NORTHING: _____ EASTING: _____

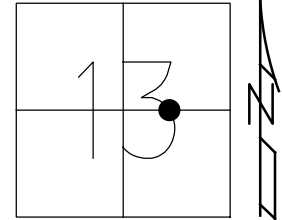

RECORD:
 FD BRASS PLATE
 9/8/60

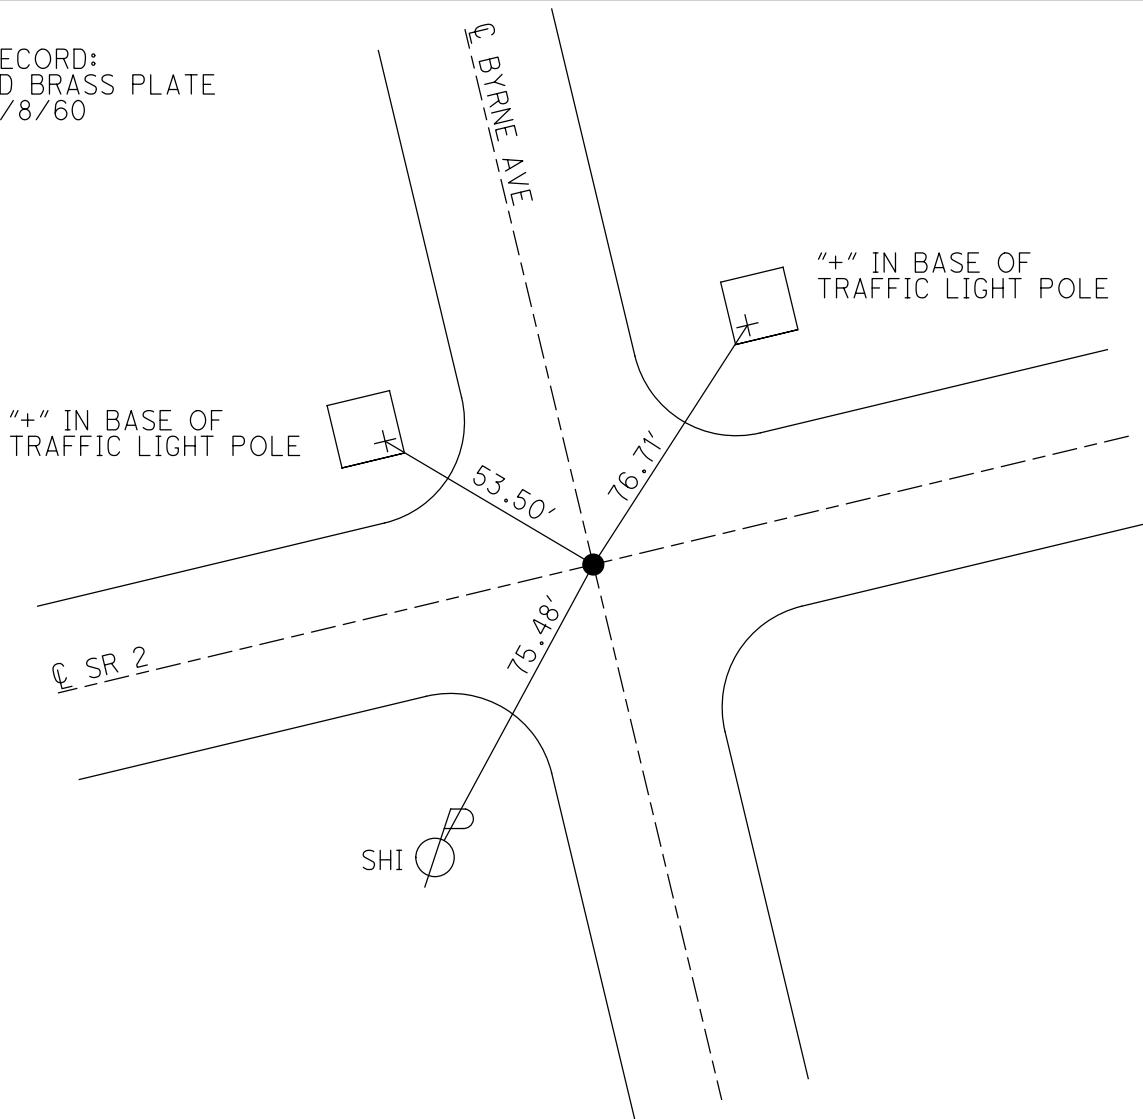

PERSONNEL TITLE PERSONNEL TITLE

Tomasic

Drake

Chappuis

Oluk

Norris

COUNTY Lucas

DATE Sept.-8-60

S. R. Lu-2

WEATHER clear-hot

SEC. Pt Byrne Rd

TEMP. 90°

DESCRIPTION Monument Reference

LEFT

CENTER LINE

RIGHT

JOB NO. _____

