

O.D.O.T. DISTRICT 2 SURVEY OFFICE (USE ONLY)

PERSONNEL _____

REFERENCE NO. 28 D

SHEET 11 OF 13

NOTES TOMSIK DATE 9/8/60
 H.C. DRAUR WEATHER CLEAR-HOT
 R.C. CHOPPURESS TEMP. 90°
ORLOK/NORRIS

ROUTE SR 2
 COUNTY LUCAS
 TOWNSHIP ADAMS
 SECTION 13

DWG BY NIESE PID _____

T 2 US R E

TYPE MONUMENT "+" IN PAVEMENT _____

ON SURFACE - ~~BELOW~~ _____ ON _____


OFFSET ☉ PAVEMENT _____ LT : RT

_____ TO _____ EDGE PAVEMENT


STATION: 735+06.38

HORIZ.DATUM: _____ GEOID: _____

GRID: NORTHING: _____ EASTING: _____

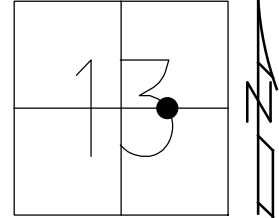

RECORD:
 FD BRASS PLATE
 9/8/60

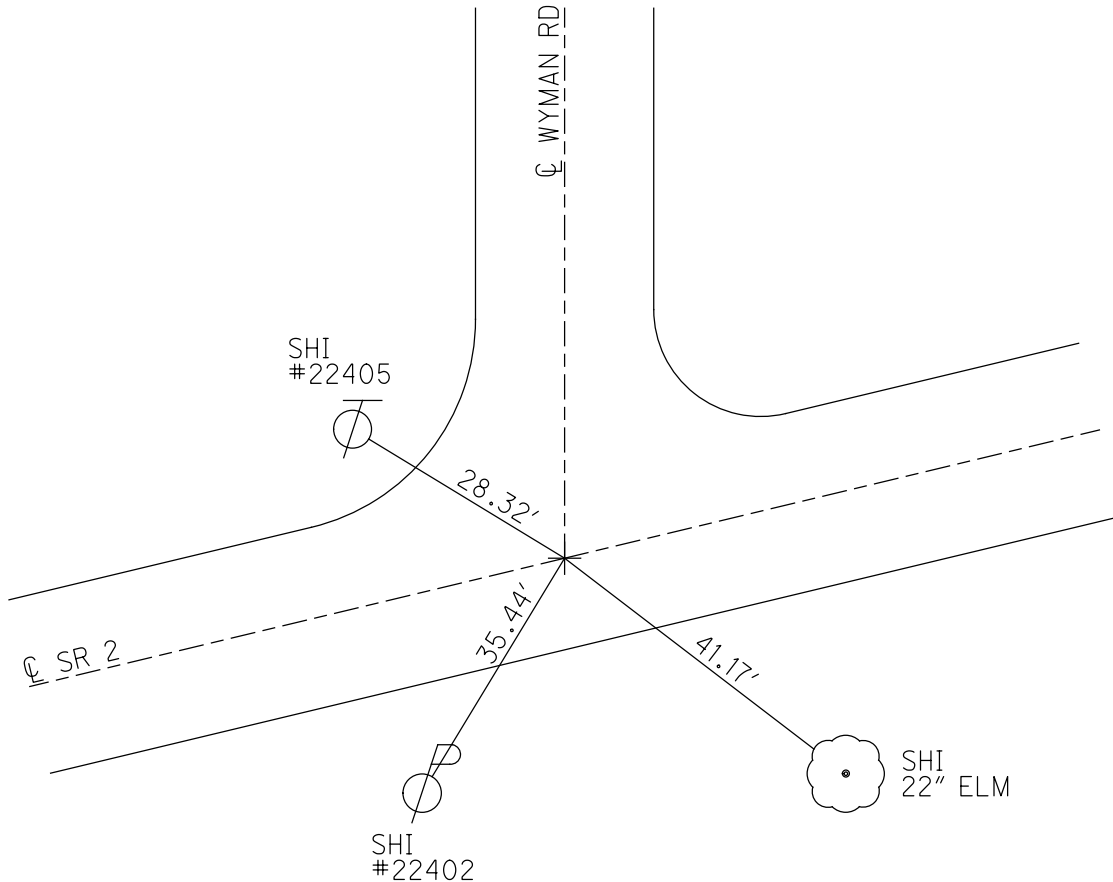

PERSONNEL TITLE PERSONNEL TITLE

Tomasic _____
 Drayr _____
 Chappuis _____
 Orluk _____

COUNTY Lucas DATE Sept. -8-60
 S. R. Lu-2 WEATHER clear-hot
 SEC. H + Byrne Rd TEMP. 90°

DESCRIPTION Monument Reference JOB NO. _____

LEFT CENTER LINE RIGHT

