

O.D.O.T. DISTRICT 2 SURVEY OFFICE (USE ONLY)

PERSONNEL

REFERENCE NO. 30

SHEET 2 OF 3

NOTES CURTIS

DATE 6/1/88

ROUTE SR 2

H.C. HOUSEHOLDE

WEATHER WARM

COUNTY LUCAS

R.C. \_\_\_\_\_

TEMP. 90°

TOWNSHIP CITY OF OREGON

DWG BY RHOADES PID \_\_\_\_\_

SECTION 8

T 10 S R 8 E

TYPE MONUMENT MONBOX W/ 1" IPIN

ON SURFACE - ~~BELOW~~ ON \_\_\_\_\_

OFFSET  $\odot$  PAVEMENT ON \_\_\_\_\_ LT : RT  
 - TO - EDGE PAVEMENT


STATION: 1128+16.17

HORZ. DATUM: \_\_\_\_\_


GEOID: \_\_\_\_\_

GRID: NORTHING: \_\_\_\_\_

EASTING: \_\_\_\_\_

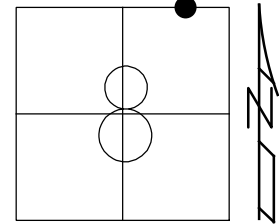

RECORD:  
 FD MONBOX  
 W/1" IPIN  
 6/1/88, DC

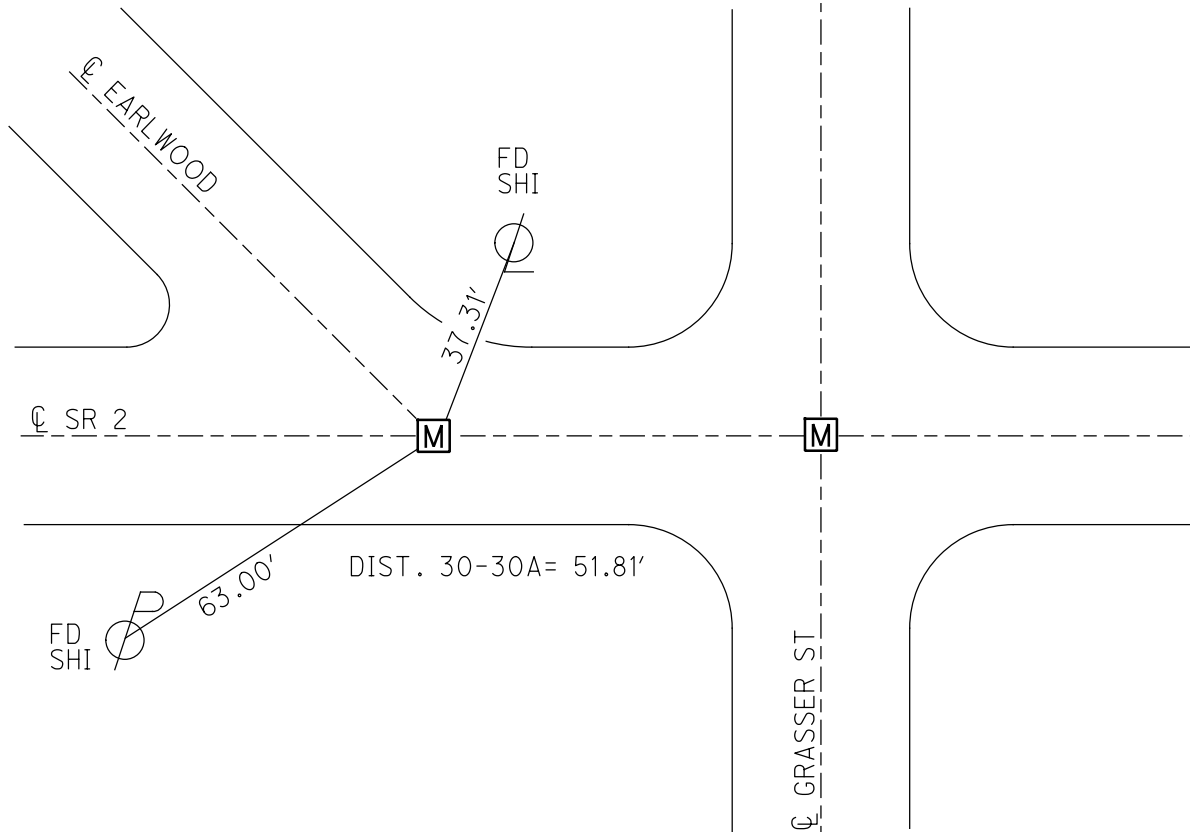

# O.D.O.T. DISTRICT 2 SURVEY OFFICE

PERSONNEL \_\_\_\_\_

REFERENCE NO. 30/30-A SHEET 2 OF 5

NOTES D. CURTIS

H.C. J. HOUSEHOLDER

R.C. \_\_\_\_\_

DATE 6-1-88

WEATHER WARM

TEMP. 90° ±

ROUTE S. R. #2

COUNTY LUGAS

TOWNSHIP \_\_\_\_\_

SECTION OTT. CO. LINE W.

T \_\_\_\_\_ R \_\_\_\_\_


TYPE MONUMENT 1" I. PINS IN MON. BOXES

ON SURFACE - BELOW 1" BELOW


LEFT- & PAV'T. - RIGHT & PAV'T

TO \_\_\_\_\_ EDGE PAVEMENT

S.L.M. 1127+83 & 1128+35

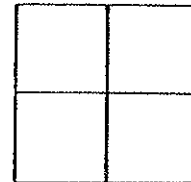

OK 7/8/88 RES

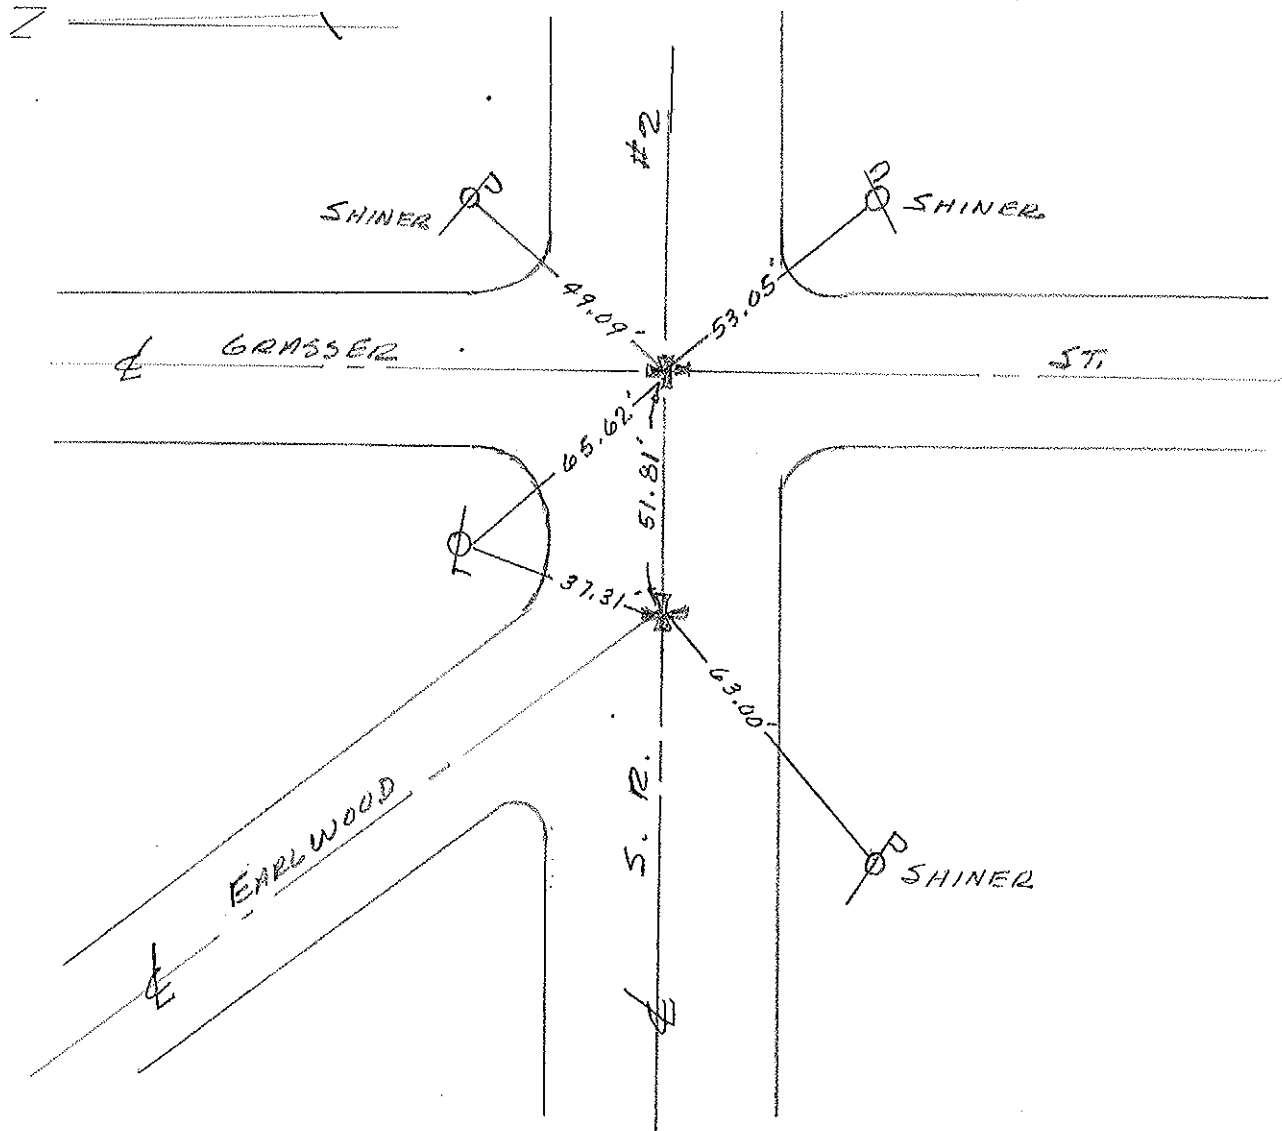


PERSONNEL	TITLE	PERSONNEL	TITLE	COUNTY	DATE	WEATHER	TEMP.
Stone	Notes			Lucas	9 July 71	Woods	80°
Michalak	H.C.			#2			
Schrader	P.C.						
				SEC. Off. Co. Line West			

DESCRIPTION References to Central Points JOB NO. \_\_\_\_\_

LEFT CENTER LINE RIGHT

30

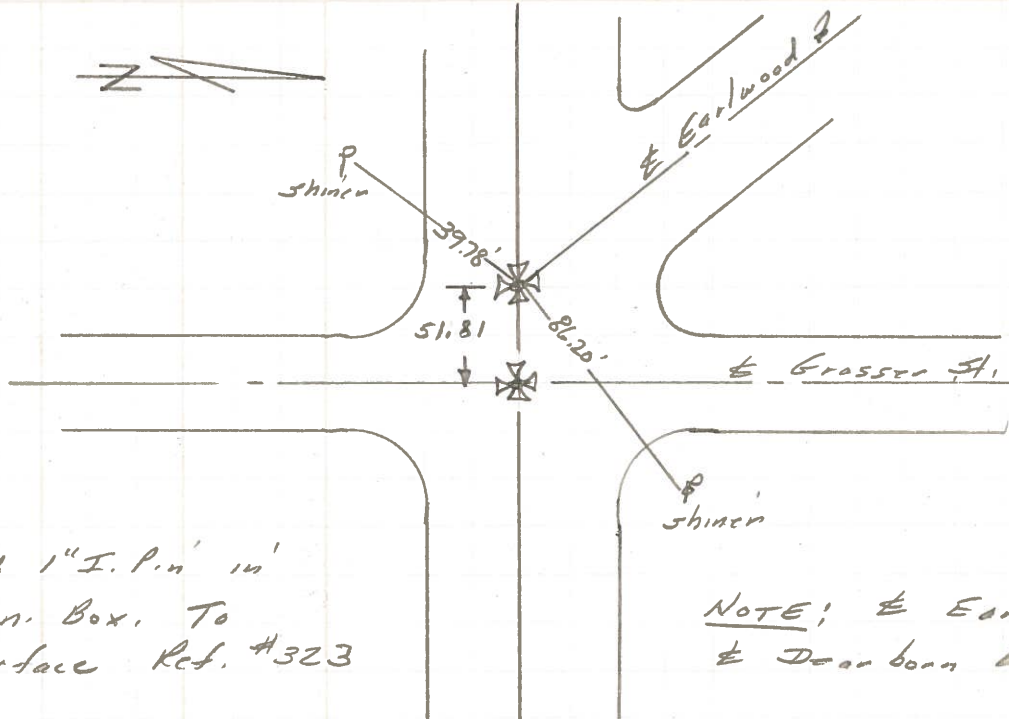


Fd. 1" I. Pin in Mon. Box. To Surface Ref. #323

NOTE: Earlwood = Dearborn Extended

30

30-A

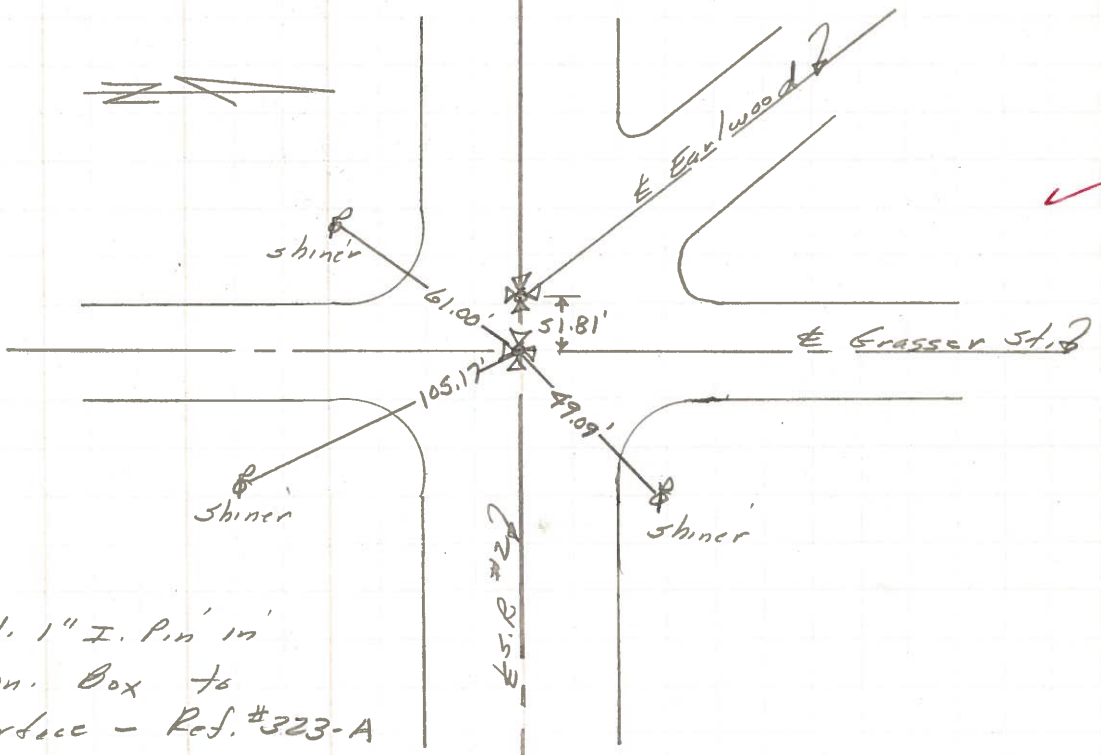

Fd. 1" I. Pin in Mon. Box to Surface - Ref. #323-A


PERSONNEL	TITLE	PERSONNEL	TITLE
W. Denno	_____	_____	_____
D. Curtis	_____	_____	_____
D. Granata	_____	_____	_____
F. Oney	_____	_____	_____

COUNTY Lucas DATE Jan. 28, 1966

S. R. 2 WEATHER Sunny

SEC. \_\_\_\_\_ TEMP. 8°

DESCRIPTION Navarre Ave - Ref. Mon. & Control Points JOB NO. \_\_\_\_\_

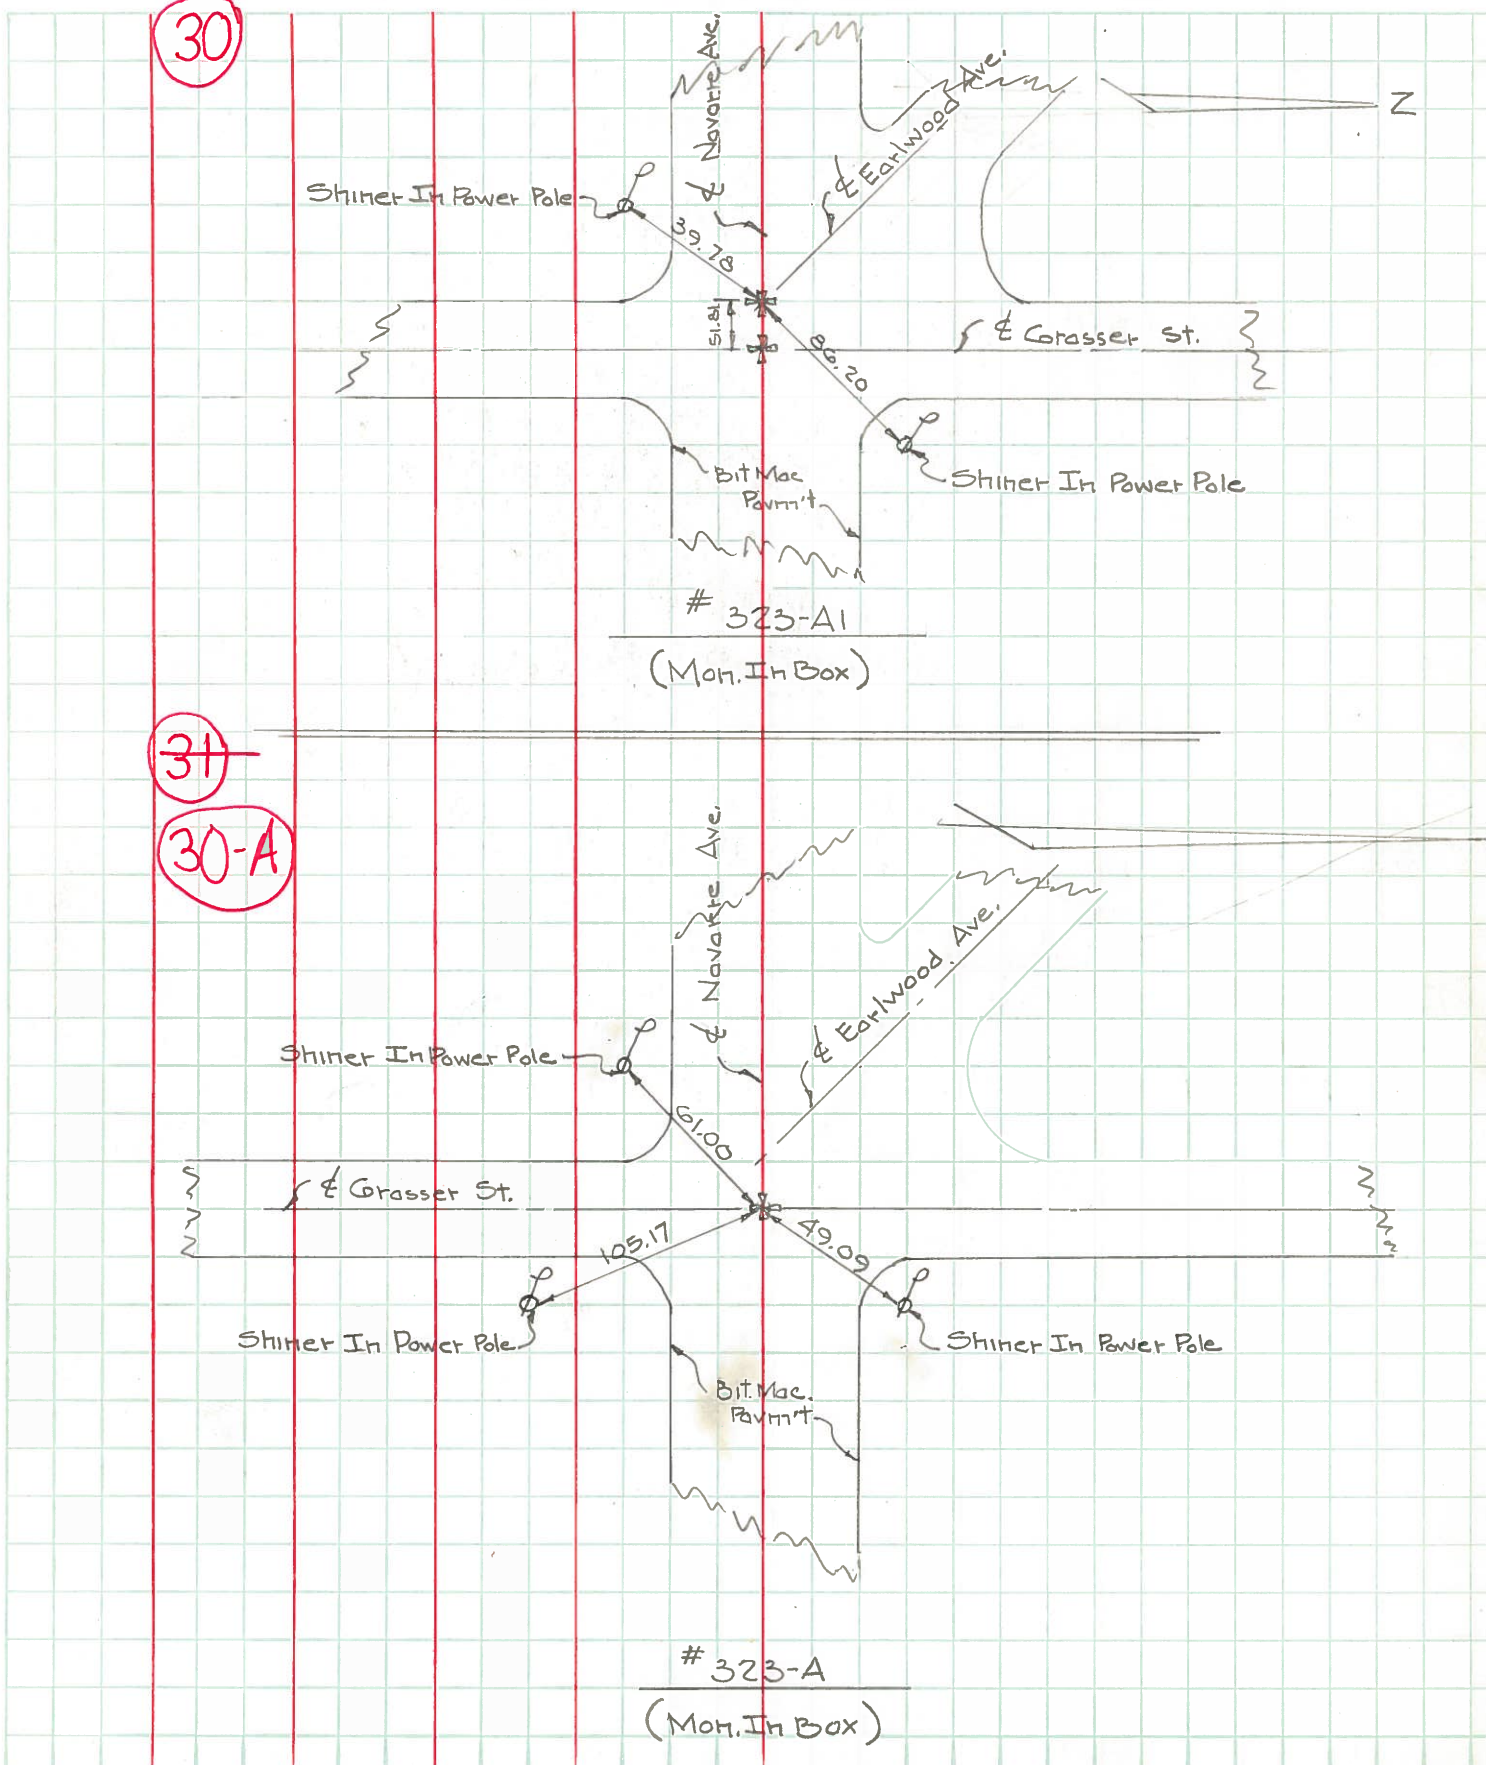

PERSONNEL	TITLE	PERSONNEL	TITLE	COUNTY	DATE
Blay	P.C.	Medford	Tape	Lucas	3/27/63
Pcleuses	?			S. R. #2	WEATHER clear
Chappuis	Tape				TEMP. 55°
Buhler	Paint				

DESCRIPTION Ref - Mon. + control Points - etc. JOB NO. \_\_\_\_\_

