


PERSONNEL	TITLE	PERSONNEL	TITLE	COUNTY	DATE	WEATHER	TEMP.
Stone	Notes			Lucas	9 July 71	Warm	81°
Michalak	H.C.			S. R. #2			
Schroder	R.C.						
DESCRIPTION				SEC. Off. Co. Line West			
	LEFT	CENTER LINE	RIGHT	JOB NO. _____			



38A

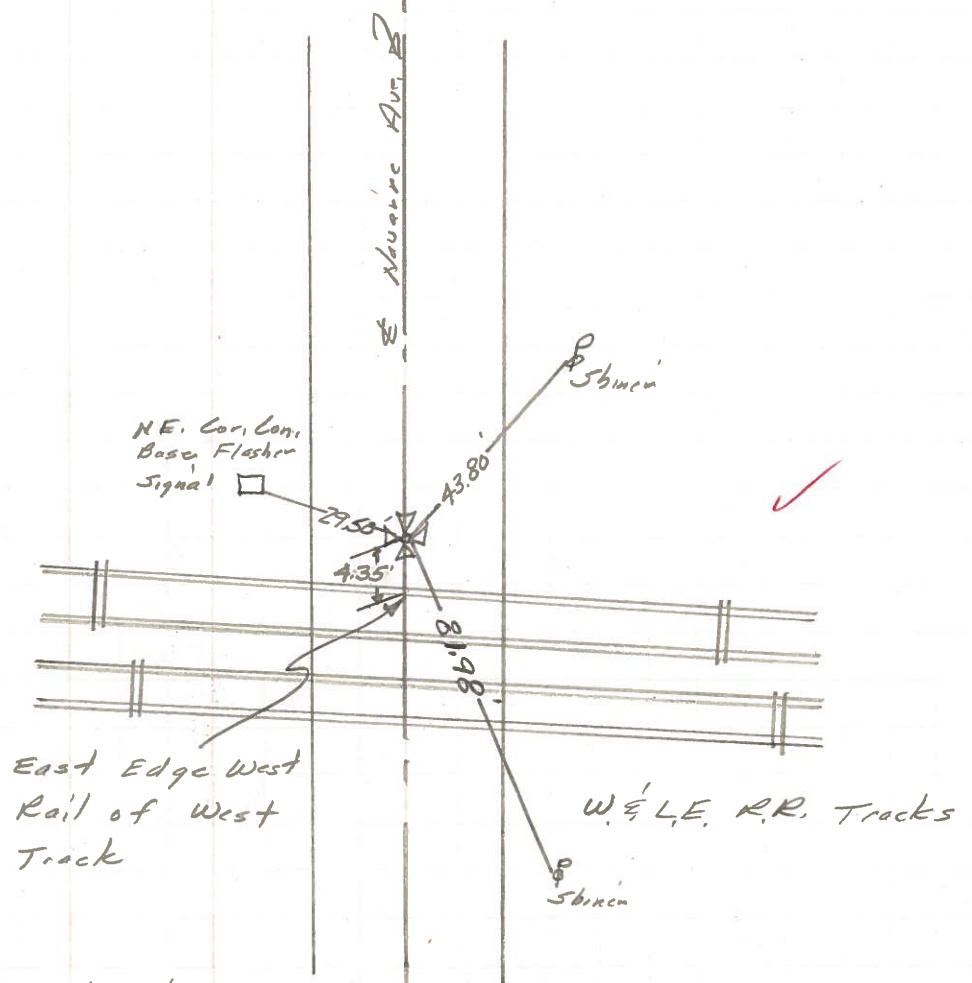


Fd. 1" I. Pin 1"  
 Con. Men. To Surface  
 Ref # 321

PERSONNEL	TITLE	PERSONNEL	TITLE	COUNTY	DATE	WEATHER	TEMP.
W. Denno				Lucas	Jan. 28, 1966	Sunny	8°
D. Curtis				S. R. 2			
D. Gramata							
F. Oney				SEC.			

DESCRIPTION Navarre Ave. - Ref. Mon. & Control Points JOB NO. \_\_\_\_\_

38-A

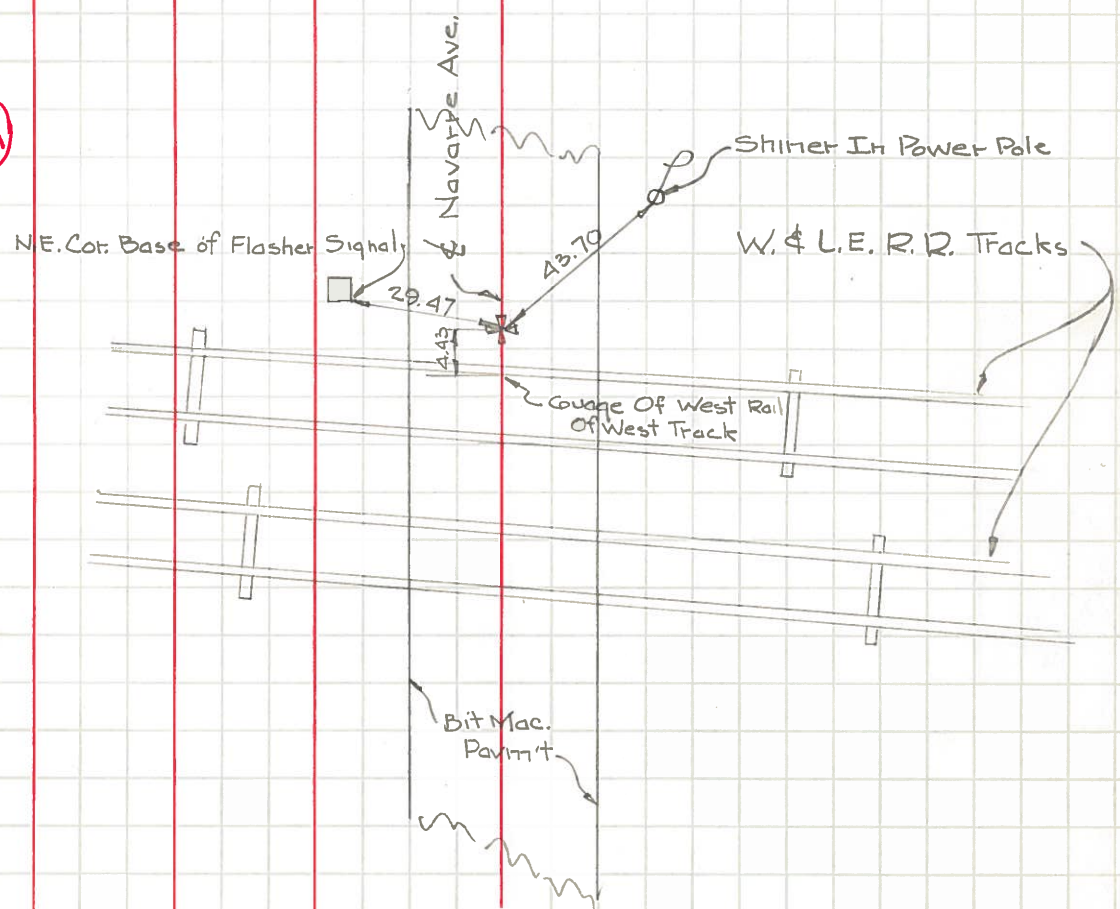

#321  
(Iron Pin In Con. Mon. Flush With Pavmt)