



O.D.O.T. DISTRICT 2 SURVEY OFFICE (USE ONLY)

PERSONNEL _____ REFERENCE NO. 54 SHEET 14 OF 20
NOTES WESTFALL DATE 3/17/15 ROUTE 2
H.C. WESTFALL WEATHER FAIR COUNTY LUCAS
R.C. LEU TEMP. 47° TOWNSHIP JERUSALEM
SECTION 8
T 10 S R 10 E

TYPE MONUMENT MONBOX W/1" IPIN
ON SURFACE - ~~BELOW~~ ON _____
LEFT - ☉ PAV'T - RIGHT ON _____
- TO - EDGE PAVEMENT
S.L.M. 1732+17.74
GRID: NORTHING: 719389.145 EASTING: 1758483.367

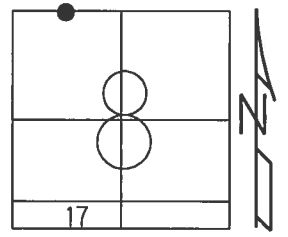

RECORD:
FD MONBOX W/1" IPIN
REF54
3/17/15, EBW

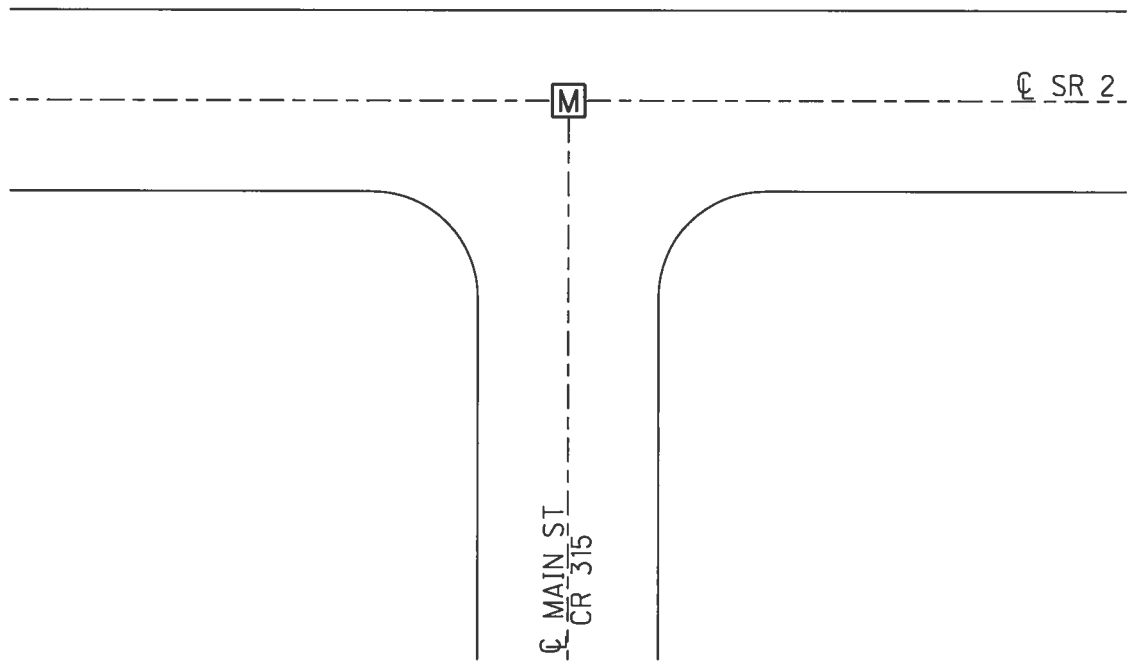

PERSONNEL	TITLE	PERSONNEL	TITLE	COUNTY	DATE
Stone	Notes			Lucas	28 June 71
Michalaka	H.C.			S. R. #2	WEATHER Hot
Schroder	P.C.			SEC. Ottawa Co. Line West	TEMP. 99°
Farr	PA				

DESCRIPTION References to Control Points JOB NO. _____

