



O.D.O.T. DISTRICT 2 SURVEY OFFICE (USE ONLY)

PERSONNEL _____ REFERENCE NO. 54 A SHEET 15 OF 20
NOTES WESTFALL DATE 3/17/15 ROUTE 2
H.C. WESTFALL WEATHER FAIR COUNTY LUCAS
R.C. LEU TEMP. 47° TOWNSHIP JERUSALEM
SECTION 8
T 10 S R 10 E

TYPE MONUMENT MONBOX W/ 1" IPIN
ON SURFACE - ~~BELOW~~ ON
LEFT - ☉ PAV'T - RIGHT ON
- TO - EDGE PAVEMENT
S.L.M. 1740+29.43
GRID: NORTHING: 719392.625 EASTING: 1759295.053

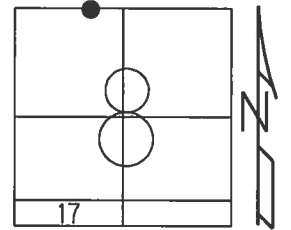

RECORD: P.C.
FD MONBOX W/1" IPIN
REFA54
3/17/15, EBW

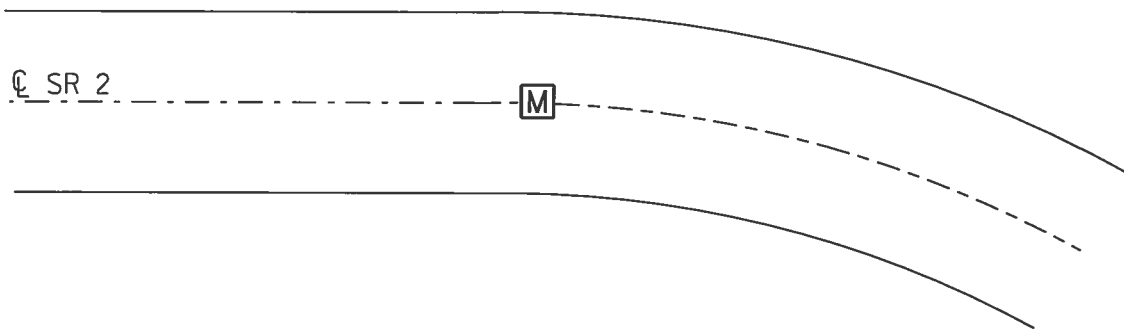

PERSONNEL	TITLE	PERSONNEL	TITLE
W. Denno			
D. Curtis			
D. Granata			
F. Orney			

COUNTY Lucas DATE Jan. 26, 1966
 S. R. 2 WEATHER Sunny
 SEC. _____ TEMP. 16°

DESCRIPTION Jerusalem Rd. - Ref. Mon. & Control Points JOB NO. _____

