
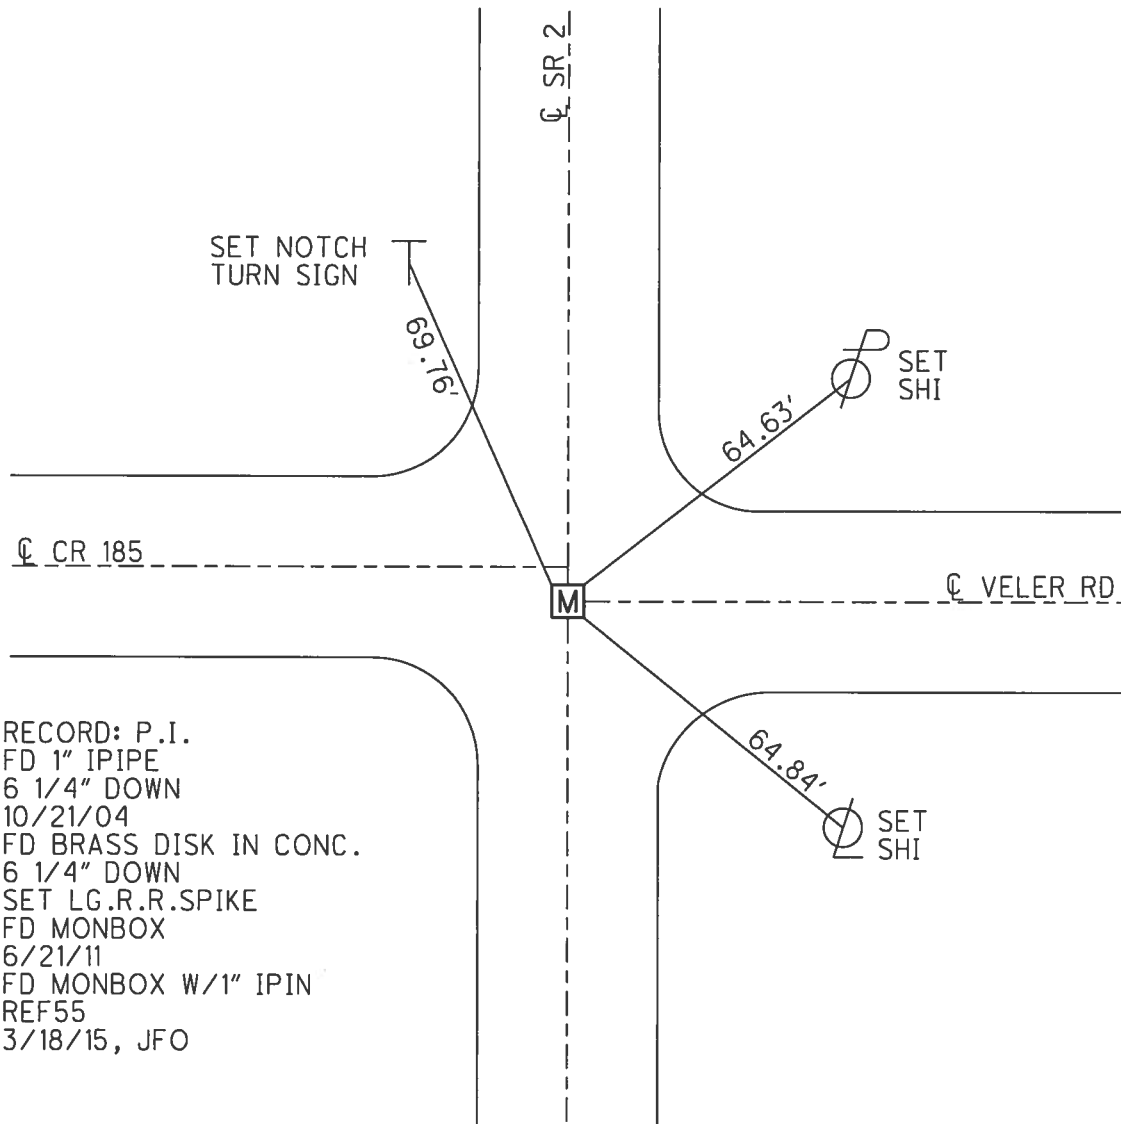


O.D.O.T. DISTRICT 2 SURVEY OFFICE (USE ONLY)

PERSONNEL _____ REFERENCE NO. 55 SHEET 19 OF 20
 NOTES FINGER _____ DATE 6/21/11 ROUTE 2
 H.C. ROUSOS _____ WEATHER SUNNY COUNTY LUCAS
 R.C. FINGER _____ TEMP. 80° TOWNSHIP JERUSALEM
 _____ SECTION 8
 _____ T 10 S R 10 E

TYPE MONUMENT MONBOX W/ 1" IPIN
 ON SURFACE - ~~BELOW~~ ON
 LEFT - ☉ PAV'T - RIGHT ON, 9' S OF ☉ W
- TO - EDGE PAVEMENT
 S.L.M. 1775+42.43
 GRID: NORTHING: 716765.943 EASTING: 1760791.027

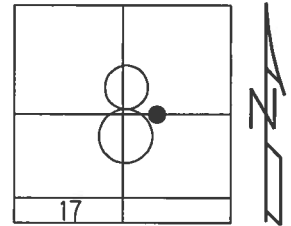


RECORD: P.I.
 FD 1" IPIPE
 6 1/4" DOWN
 10/21/04
 FD BRASS DISK IN CONC.
 6 1/4" DOWN
 SET LG.R.R.SPIKE
 FD MONBOX
 6/21/11
 FD MONBOX W/1" IPIN
 REF55
 3/18/15, JFO

O.D.O.T. DISTRICT 2 SURVEY OFFICE

PERSONNEL _____ REFERENCE NO. 55 SHEET _____ OF _____
 NOTES Finger DATE 6/21/11 ROUTE SR 2
 H.C. Rousos WEATHER 80° F Sunny COUNTY Lucas
 R.C. Finger TEMP. _____ TOWNSHIP Jerusalem
 _____ SECTION 8
 _____ T N R E

TYPE MONUMENT Mon. Box
 ON SURFACE - BELOW Surface
 LEFT - ℄ PAV'T - RIGHT _____
 _____ TO _____ EDGE PAVEMENT
 S.L.M. 33.61

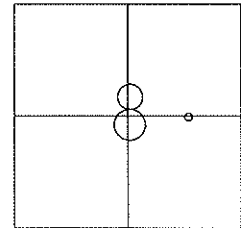


Grid: Northing: 716765.815 Easting: 1760790.823

Record

P.I. For Bon Curve
 Fnd. 1" Iron Pipe 6 1/4" Down
 10/21/04

Fnd. Brass Disc in Conc
 6 1/4" Down, Placed Lrg.
 RR Spike on Surface

Fnd. Mon. Box
 6/21/11

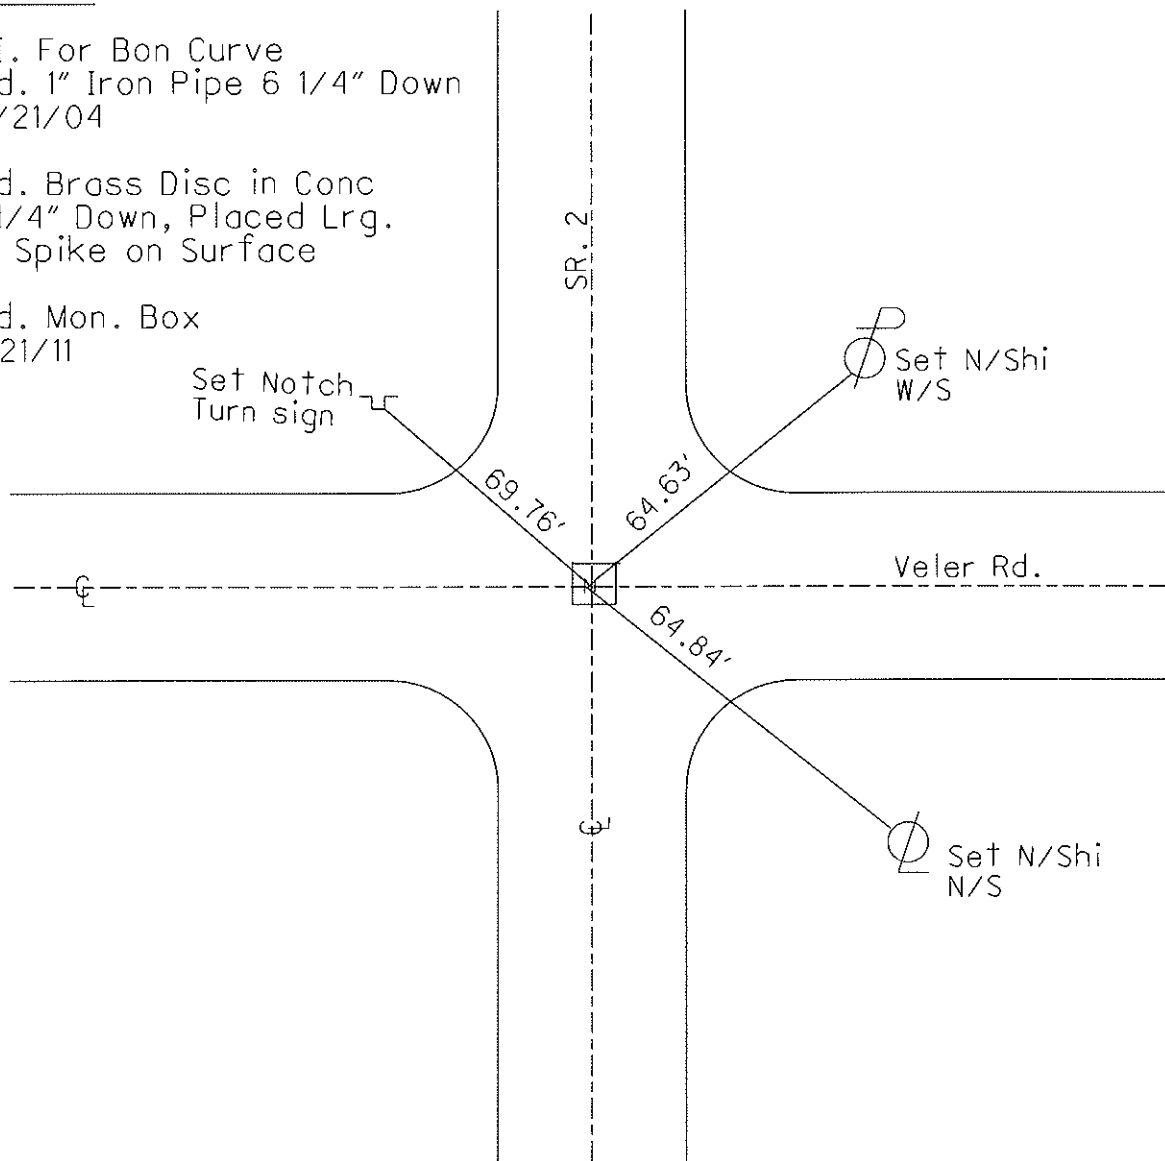

Q.D.O.T. DISTRICT 2 SURVEY OFFICE

Sht. ___ of ___

County Lucas S.R.# 2

Date ~~11/22/82~~ 6/21/11

Township JERUSALEM

Weather sunny ✓

Section 8

Temp. 50° 80°

T. N, R. E

Personnel Cronin Finger


Ripple Rausos

Geyman

Mosser

Barbour

55

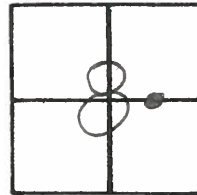

PI. For Bon Curve
Fd 1" Iron Pipe 6'1/4" Down,
Placed Large RR Spike on
Surface, 10-21-04


Homan
Barnhisel
Canterbury

Fd Brass Disk in Conc.
6'1/4" Down, Placed Large
RR Spike on surface
10-21-04

Homan
Barnhisel
Canterbury



Set P.K. & washer atop
P.K. & washer

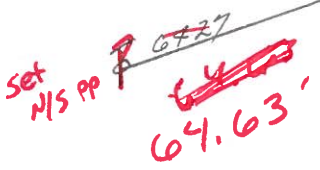

FD Man Box
6/21/11 EAF

GPS
Ref 55
6-21-11

S.R.# 2

Q.D.O.T. DISTRICT 2 SURVEY OFFICE

Sht. ___ of ___

County Lucas S.R.#2

Date 11/22/82

Township JERUSALEM

Weather sunny

Section 8

Temp. 50°

T N, R E

Personnel Cronin


Ripple

Geyman

Mosser

Barbour

55

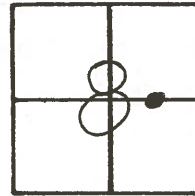

PI. For Bon Curve
Fd 1" Iron Pipe 6'4" Down,
Placed Large RR Spike on
Surface, 10-21-04


Homan
Barnhisel
Canterbury

Fd Brass Disk in Conc.
6'4" Down, Placed Large
RR Spike on surface
10-21-04

Homan
Barnhisel
Canterbury



Set P.K. & washer atop
P.K. & washer

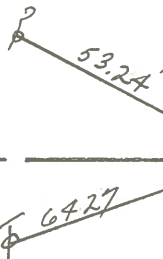

Veter Road




S.R.#2

PERSONNEL	TITLE	PERSONNEL	TITLE	COUNTY	DATE	WEATHER	TEMP.
Stone	Notes			Lucas	28 June 71	Hot	
Michalak	H.C.			S. R. #2			
Schroder	R.C.						
Farr	PA			SEC. Ottawa Co. Line West			96°

DESCRIPTION References to Control Points JOB NO. _____

LEFT CENTER LINE RIGHT

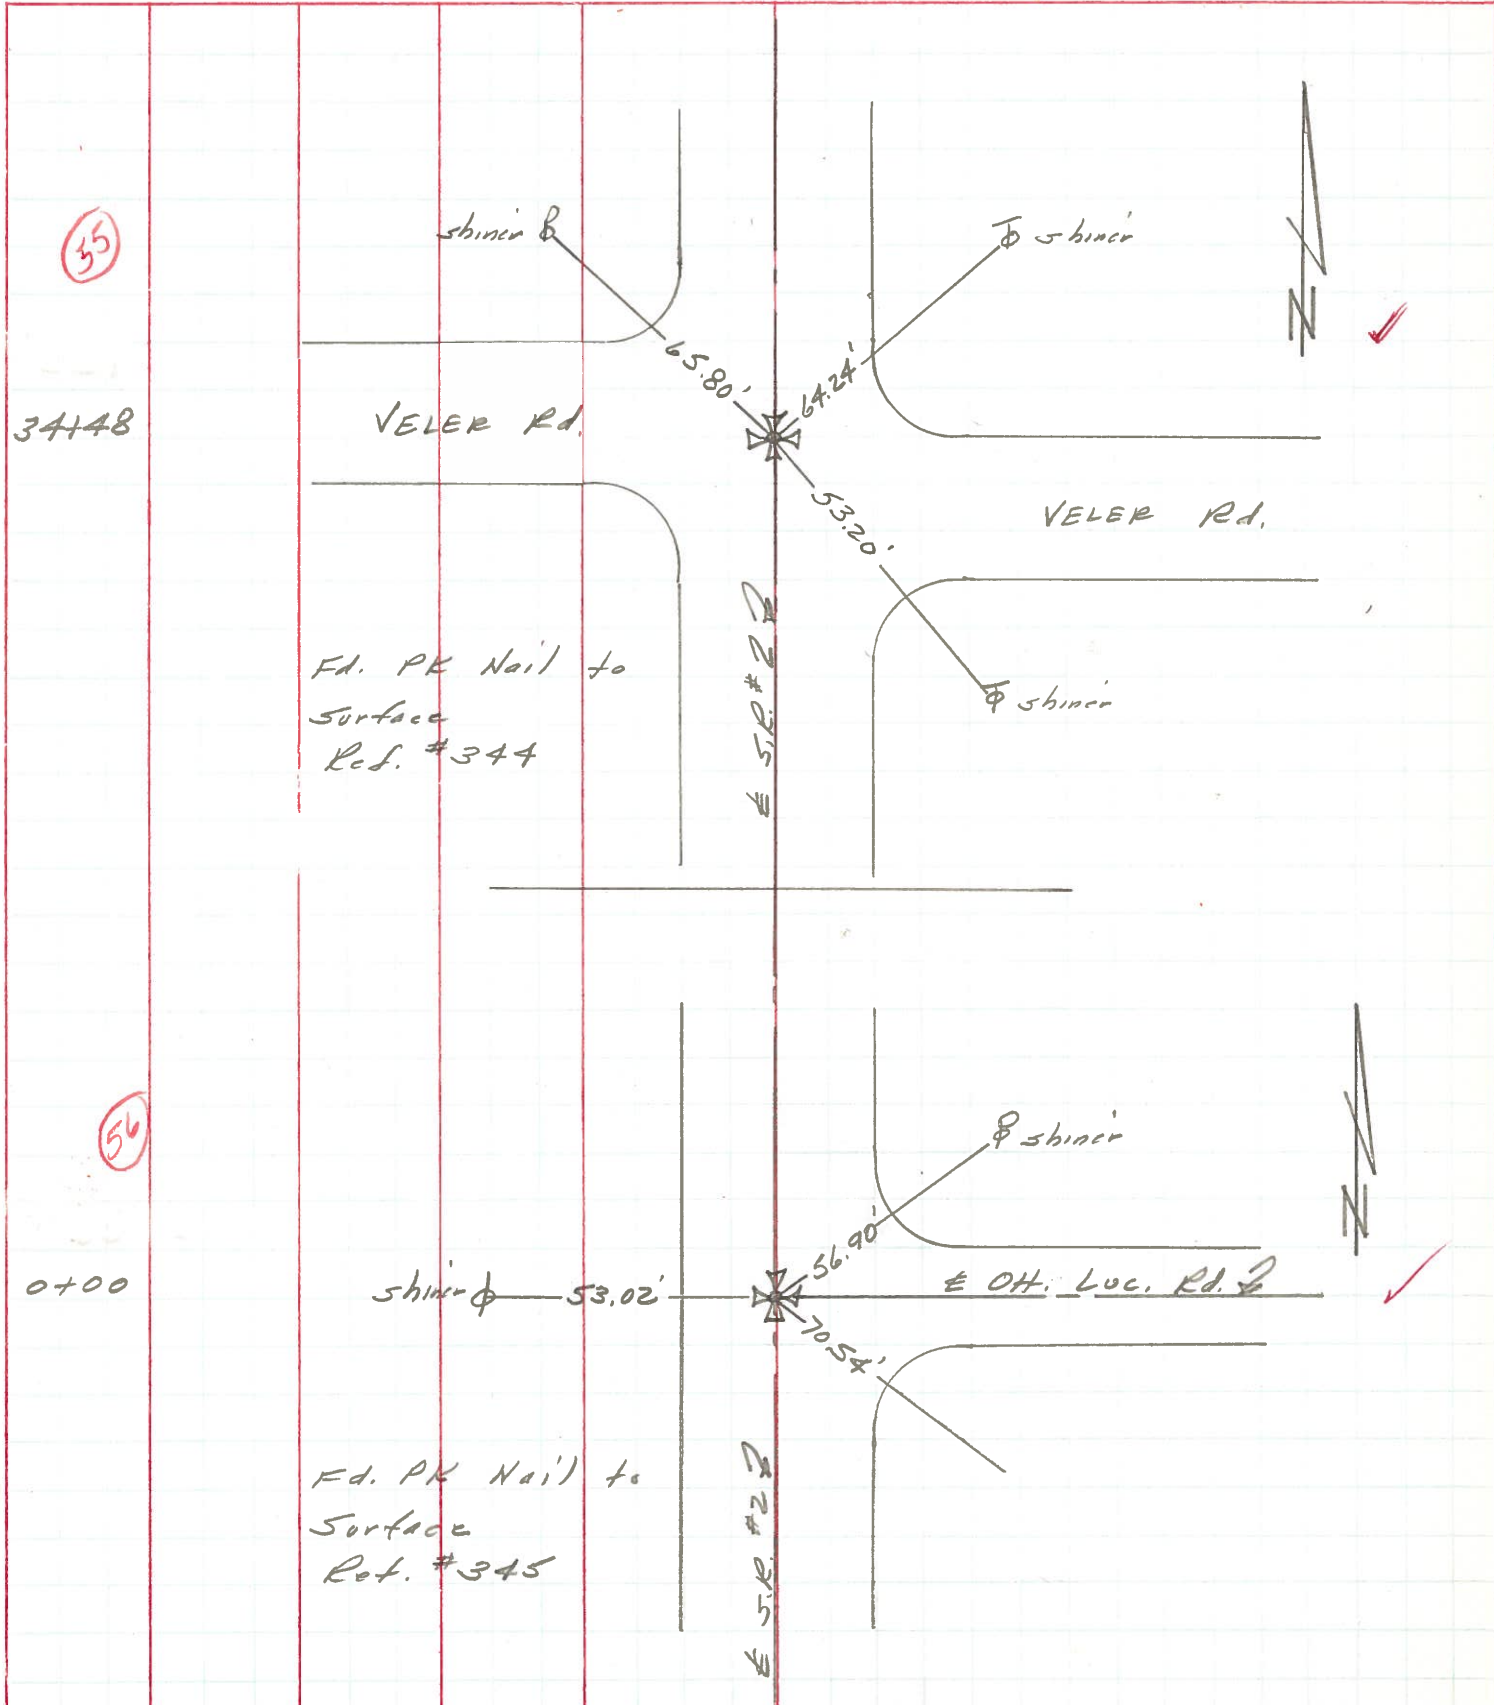


PERSONNEL TITLE PERSONNEL TITLE

Schneider
Mosser
Radding
Potts

COUNTY Lu DATE 6-5-67
S. R. 2 WEATHER F
SEC. .39 TEMP. 75°

DESCRIPTION Ties for Control JOB NO. _____

LEFT CENTER LINE RIGHT

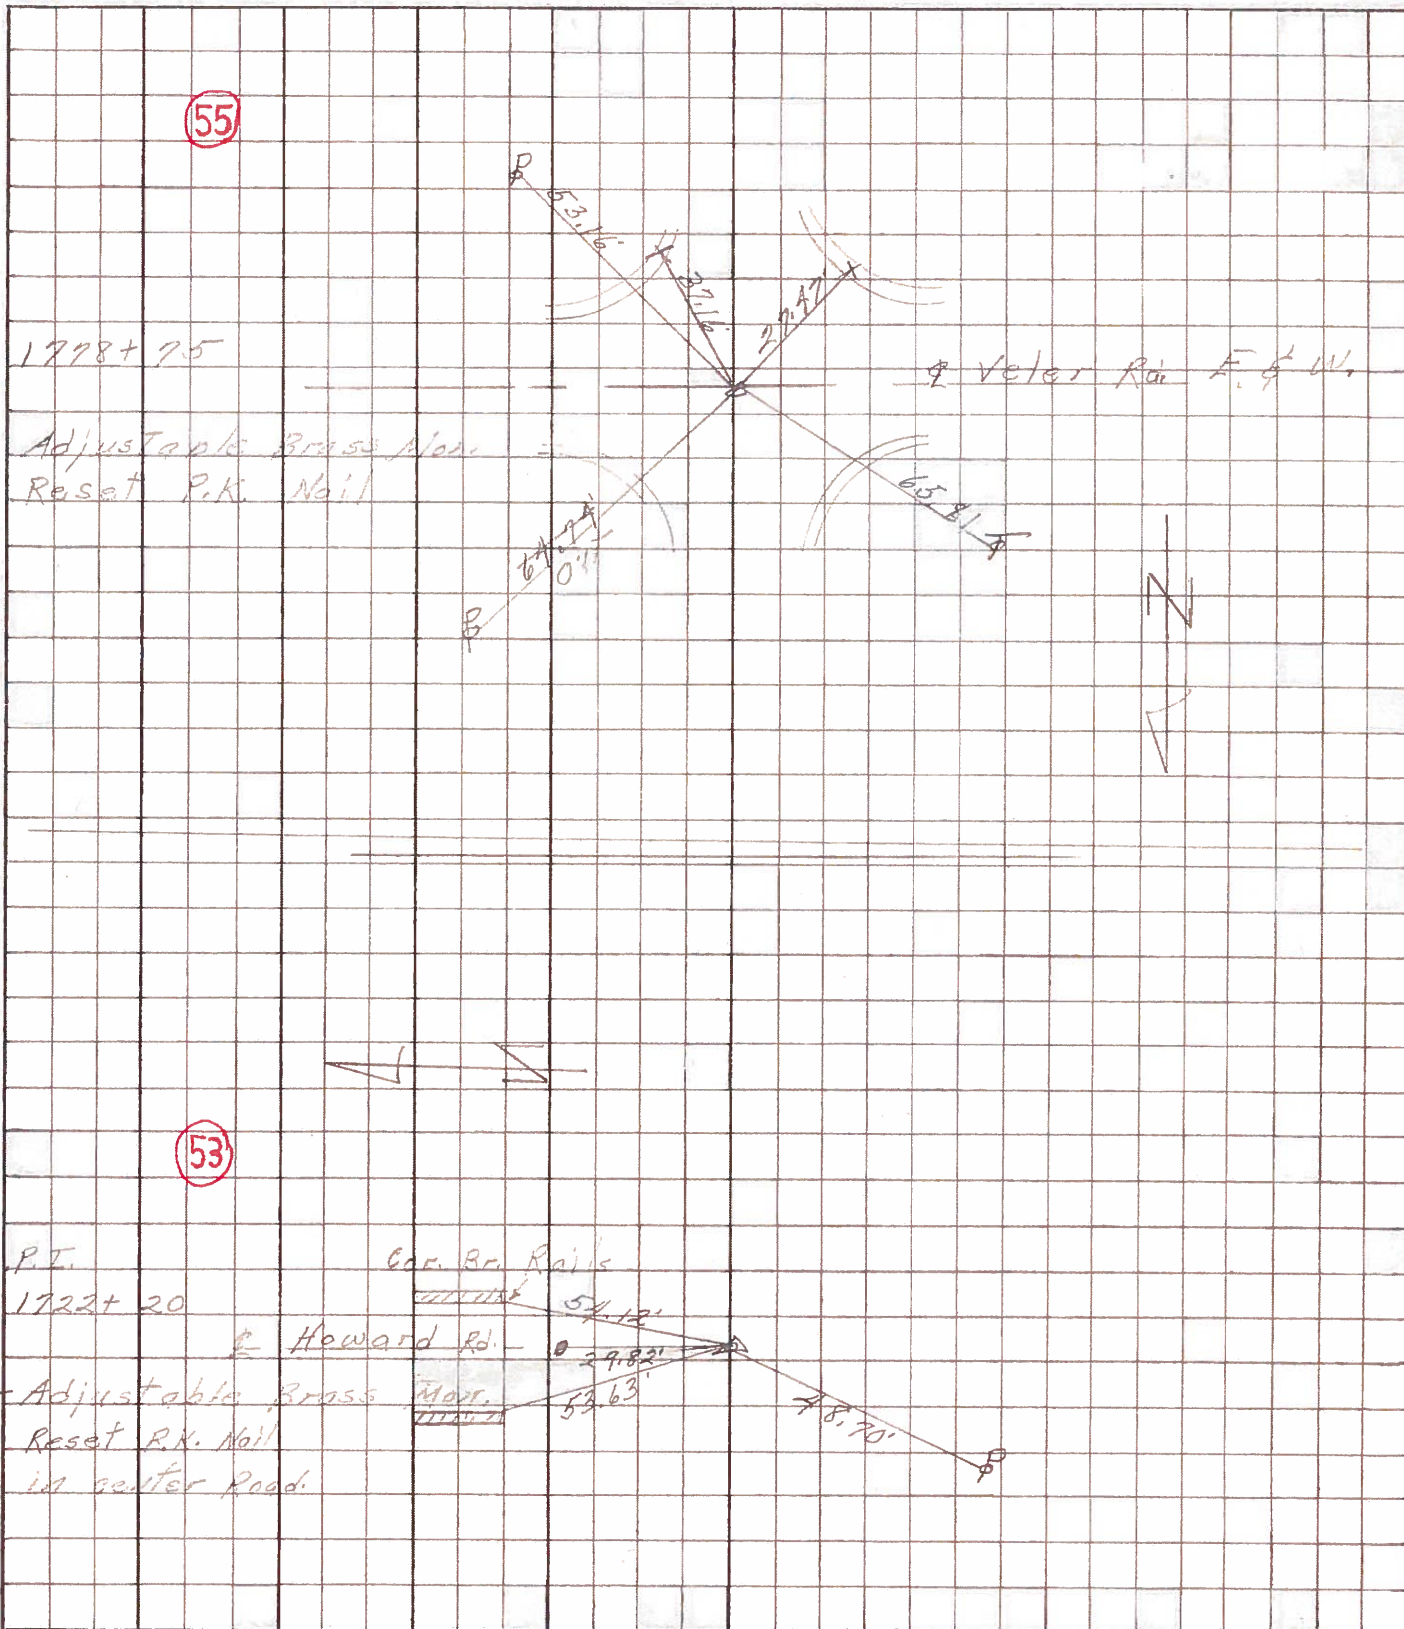

PERSONNEL	TITLE	PERSONNEL	TITLE	COUNTY	DATE
w. Denno				Lucas	Jan. 26, 1966
D. Curtis				2	SUNNY
D. Granata					14°
F. Omev					

DESCRIPTION Jerusalem Rd. - Ref. Mon. & Control Points JOB NO. _____

