

DATE 11/11/11

PERSONNEL Loehrké

PRIORITY NO. 2 PART 1 OF 2 SHEET 1 OF 24

COUNTY LUCAS ROUTE 20 SECTION 7.01

BEGIN LOG (SLM) 7.01 ± TERMINII CENTENNIAL

END LOG (SLM) 9.48 TERMINII Meet Previous I-475 Project

TOTAL LENGTH 2.47 MILES

MUNICIPALITY _____ BEGIN LOG (SLM) _____ END LOG (SLM) _____

MUNICIPALITY _____ BEGIN LOG (SLM) _____ END LOG (SLM) _____

PROPOSED WORK: PAVEMENT PLACING VARIOUS # RESURFACING
PAVEMENT 13" 446 Type 2, 14" 446 Type 1 SHOULDER

OTHER _____

STATION ESTABLISHED FROM:
Metric

STRUCTURES: Dune				
NUMBER	STATION	WIDTH	LENGTH	PROPOSED WORK

RAILROAD CROSSING: None

NAME _____ STATION _____ NO. TRACKS _____ LENGTH ALONG C L _____ FT (NO WORK)

DATE 11/28/11TWO-LANE RESURFACING PROGRAM
DEFECTIVE PAVEMENT AREASSHEET 2 OF 24COUNTY LUCAS ROUTE 20 SECTION 11.281 SKT

WEST BOUND ONLY

STATION		LT BERM	LT LANE	RT LANE	SIZE (WIDTH)	EXISTING PAVEMENT CONDITIONS		
FROM	TO					RUTTED	CRACKED	BASE FAILURE
15+000	15+145		X		2.0m	X	X	X
15+075	15+100	X			1.5m	X	X	X
14+955	15+075	X			1.0m	X	X	X
14+901	14+955		X		0.5m		X DEEP	
14+847	14+868	X			0.5m		X	
14+795	14+840		X		0.5m		X	
14+733	14+745	X			0.7m		X NOTE: PAV'T MISSING	
14+684	14+733			X		X	NOTE: PAV'T	RUTTED IN LT. TURN LANE
14+500	14+574			X	0.5m		X DEEP	
14+318	14+513	X			1.5m	X	X	X
14+165	14+254	X	X		0.6m	X	X	X
13+766	14+021	X			1.0m	X	X	X
13+659	13+748		X	X	3.6m	X		
13+640	13+689	X			2.0m	X	X	
13+171	13+193	X			1.0m	X	X	X
13+030	13+122	X	X	X		X PAV'T	RUTTED FROM BREAKING	
13+040	13+122	X			1.0m	X	X	X
12+770	12+900	X			0.6m	X	X	
12+353	12+368	X			0.6m	X	X	
12+281	12+230		X		0.5m		X	

COUNTY LUCAS

ROUTE US 20 SECTION 11.281 SK

STATION		LT LANE	RT LANE	RT BERM	SIZE (WIDTH)	EXISTING PAVEMENT CONDITIONS		
FROM	TO					RUTTED	CRACKED	BASE FAILURE
11+027	11+041		X		1.5m	X	X	X
11+041	11+115		X		1.0m	X	X	
11+115	11+242	X			0.5m		X	
11+300	11+395	X	X	X		X		* COMMENT ALL 4 LANES RUTTED DUE TO BREAKING
11+525	11+530			X	1.0m		X	X
11+908	11+912			X	2.5m	X	X	X
12+850	12+950		X		3.6m	X		* NOTE: PAVT RUTTED DUE TO BREAKING
12+950	13+000	X	X		7.2m	X		
13+520	13+610		X		3.6m	X		* NOTE: PAVT RUTTED DUE TO BREAKING
13+592	13+610	X			3.6m	X		
14+505	14+560			X	1.0m	X	X	MISSING
14+590	14+560	X				X		* NOTE: PAVT RUTTED DUE TO BREAKING
14+723	14+730	X			3.0m	X	X	DEEP CRACK
14+787	14+784				1.0m		X	DEEP CRACKS
14+784	14+825	X		X	0.4m		X	DEEP CRACKS
14+930	15+002		X		0.3m		X	DEEP CRACKS
15+056	15+145	X	X		7.2m	X	X	* NOTE: PAVT IN POOR COND.

* EAST

BOUND

ONLY

*

PERSONNEL TITLE PERSONNEL TITLE COUNTY DATE 5-7-97 WEATHER Fair

LOEHMKE S.R. Lucas

CORDES SLM 7.01 & 10.05 TEMP. +58°

St. flieg SEC.

DESCRIPTION PRECONSTRUCTION CROSS SECTIONS - METRIC CENTER LINE RIGHT

For Bench MARKS -		Cut "4" @ each		Top Center of Rt Side Curb		Assumed 100.000 m		Rt	
Lt	Top	OUTSIDE GUTTER	INSIDE GUTTER	CR WBL	CR WBL	CR FOP	CR FOP	INSIDE GUTTER	OUTSIDE GUTTER
12+000	1.727	1.783	1.752	1.661	1.581	1.532	1.505	1.523	1.589
	24.83	24.68	24.10	21.78	18.25	14.60	12.55	10.60	6.95
								3.25	0.78
								0.2	0
12+800	1.507	1.585	1.529	1.431	1.383	1.313	1.294	1.303	1.385
	24.85	24.70	24.10	21.75	18.25	14.60	12.60	10.60	7.00
								3.25	0.78
								0.2	0
13+500	1.503	1.640	1.578	1.429	1.378	1.351	1.325	1.323	1.343
	26.05	26.90	25.30	21.75	18.25	14.60	12.60	10.60	7.00
								3.25	0.80
								0.2	0
14+300	1.703	1.805	1.758	1.639	1.568	1.505	1.466	1.465	1.525
	24.90	24.70	24.10	21.75	18.25	14.60	12.60	10.60	7.00
								3.25	0.80
								0.2	0
15+000	1.627	1.760	1.691	1.569	1.498	1.445	1.434	1.442	1.491
	24.90	24.70	24.10	21.75	18.25	14.60	12.60	10.60	7.00
								3.25	0.80
								0.2	0
15+900	1.611	1.765	1.708	1.585	1.511	1.441	1.405	1.407	1.465
								3.25	0.80
								0.2	0

GUTTER
NO Asphalt
COVER

Exposed
Curb Gutter

Exposed
Curb Gutter

194SWH

OHIO DEPARTMENT OF TRANSPORTATION

SHEET NO. 24/24

PERSONNEL	TITLE	PERSONNEL	TITLE	COUNTY	DATE	WEATHER	TEMP.
LOEHRKE				LUCAS	5-13-97	Clear & Windy	+52
CORDES				S.R.	V.S. 20		
				SEC.			



DESCRIPTION	NEW PAVT	APRIL 1997	CENTER LINE	RIGHT	JOB NO.

LEFT

New Asphalt Joints

NBL

SBL

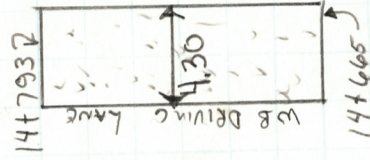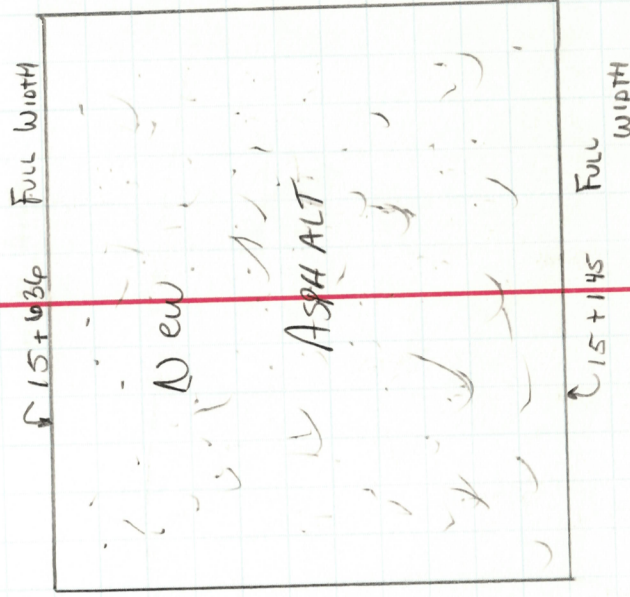

14+718

McCord Rd.

DATE April 11

SHEET 4 OF 24

TWO-LANE RESURFACING PROGRAM

UTILITIES (CATCH BASIN, MANHOLE, INLET, WATER VALVE, BOX AND MONUMENT BOX)

COUNTY LUC.

ROUTE U.S. 20

SECTION 11.281 SLK

R = RAISE

F = FEATHER

STATION	OUT (FT) RT/LT OF C	CATCH BASIN	MAN- HOLE	INLET	W V BOX	MON BOX	CASTING		REMARKS ie: RECONSTRUCT, NO WORK
							R	F	
11+204.5	On C					X	X		
11+218	Curb Rt.			X					
11+279	Curb Rt			X					
11+279	Curb Lt			X					
11+400	6.5m Rt.		X						
11+404	On C					X	X		
11+414	11.0m Lt		X						
11+415	13.8m Lt.		X						
11+415	9.0m Rt		X						
11+416	6.2m Lt		X						
11+418	6.2m Lt		X						
11+520	4.5m Lt		X						
11+521	Curb Rt			X					
11+525	Curb Lt			X					
11+549	Curb Lt			X					
11+544	Curb Rt			X					
11+620	Curb Lt			X					
11+672	7.8m Rt		X						
11+692	Curb Lt								
11+700	Curb Rt			X					

COUNTY LVC. ROUTE US 20 SECTION 11.281 SLK

R = RAISE F = FEATHER

STATION	OUT (FT) RT/LT OF Q	CATCH BASIN	MAN- HOLE	INLET	W V BOX	MON BOX	CASTING		REMARKS ie: RECONSTRUCT, NO WORK
							R	F	
12+080	Curb Lt			X					
12+100	Curb Rt			X					
12+107	Curb Lt			X					
12+124	Curb Rt			X					
12+169	1 m inside Curb Lt		X						
12+201.9	5.5 m Lt					X	X		
12+217.1	5.5 m Lt					X	X		
12+222	Curb Lt			X					
12+222	Curb Rt			X					
12+336	Curb Lt			X					
12+336	Curb Rt			X					
12+344.7	5.5 m Lt					X	X		
12+495	Curb Lt			X					
12+495	Curb Rt			X					
12+496.7	5.5 m Lt					X	X		
12+596	Curb Lt			X					
12+596	Curb Rt			X					
12+608.4	5.5 m Lt					X	X		
12+649.2	5.5 m Lt					X	X		
12+650	Curb Lt			X					

DATE APRIL SHEET 6 OF 24
 TWO-LANE RESURFACING PROGRAM
 UTILITIES (CATCH BASIN, MANHOLE, INLET, WATERVALVE, BOX AND MONUMENT BOX)
 COUNTY LUC ROUTE U.S. 20 SECTION 11.281 SLK

R = RAISE F = FEATHER

STATION	OUT (FT) RT/LT OF C	CATCH BASIN	MAN- HOLE	INLET	W V BOX	MON BOX	CASTING		REMARKS ie: RECONSTRUCT, NO WORK
							R	F	
12+910	Curb Lt			X					
12+910	Curb Rt			X					
13+011	7.0m Lt					X	X		
13+117	5.5m Lt					X	X		
13+122	Curb Lt			X					
13+122	Curb Rt			X					
13+226	Curb Rt			X					
13+250.5	11.1m Lt		X						
13+336	Curb Lt			X					
13+411.2	5.3m Lt					X	X		
13+415	Curb Lt			X					
13+421	Curb Rt			X					
13+503	Curb Rt			X					
13+524	Curb Lt			X					
13+563.6	5.25m Lt					X	X		
13+604	Curb Lt			X					
13+660	Curb Lt			X					
13+690.1	5.6 Lt					X	X		
13+692	Curb Lt		X						
13+718	Curb Lt			X					

DATE April 91

TWO-LANE RESURFACING PROGRAM

SHEET 7 OF 24

UTILITIES (CATCH BASIN, MANHOLE, INLET, WATER VALVE, BOX AND MONUMENT BOX)

COUNTY LUC ROUTE U.S. 20 SECTION 11.281 SLK

R = RAISE F = FEATHER

STATION	OUT RT RT/LT OF C	CATCH BASIN	MAN- HOLE	INLET	W V BOX	MON BOX	CASTING		REMARKS ie: RECONSTRUCT, NO WORK
							R	F	
13+987	5.4 Lt.					X	X		
14+044.6	5.5 Lt.					X	X		
14+112.2	5.5 Lt.					X	X		
14+133	Curb Lt.			X					
14+133	Curb Rt.			X					
14+149.7	5.4 Lt.					X	X		
14+194	Curb Lt.			X					
14+264.6	5.5 Lt.					X	X		
14+272	Curb Lt.			X					
14+272	Curb Rt.			X					
14+298	Curb Lt.			X					
14+304	9.6 Lt.		X				X		WATER
14+307	Curb Rt.			X					
14+356	Curb Lt.			X					
14+417	5.5 Lt.					X	X		
14+503	Curb Lt.			X					
14+525	Curb Lt.			X					
14+555	5.4 Lt.					X	X		
14+575	Curb Rt.			X					
14+597	10.1 Lt.		X					X	

[illegible]

DATE April
SHEET 9 OF 24

TWO-LANE RESURFACING PROGRAM
PAVEMENT DATA

NOTE: LOCATE ALL
CHANGES IN PVMT WIDTH

COUNTY LUC ROUTE U.S. 20 SECTION 11.281 SLK

PAVEMENT MARKINGS:

[illegible]

194SWH

9w1
OHIO DEPARTMENT OF TRANSPORTATION

SHEET NO. 10/24

DATE April - 97

COUNTY LUC

WEATHER

TITLE

PERSONNEL

TITLE

PERSONNEL

S. R. U.S. 20

WEATHER

TITLE

PERSONNEL

TITLE

PERSONNEL

SEC. 11.281 SLK

TEMP.

TITLE

PERSONNEL

TITLE

PERSONNEL

JOB NO.

RIGHT

TITLE

PERSONNEL

TITLE

PERSONNEL

PAVT. WIDTHS

LEFT

TITLE

PERSONNEL

TITLE

PERSONNEL

CENTER LINE

RIGHT

TITLE

PERSONNEL

TITLE

PERSONNEL

CENTENNIAL ROAD

25.4 PACE TO FACE

11+385.5

25.4m

11+299.5

24.6m

11+284

BEGIN
CURB AND
0.61m GUTTER
ON LT SIDE
11+278.2

FACE OF CURB
TO
FACE OF CURB

BEGIN CURB
AND 0.61m
GUTTER
11+216.8
RT SIDE ONLY

19.6m

11+144

1945WH

PW 2

OHIO DEPARTMENT OF TRANSPORTATION

SHEET NO. 11 / 24


PERSONNEL	TITLE	PERSONNEL	TITLE	COUNTY	DATE
Loehrke				LVC	April 97
Cordes					
Stiffler					

S.R.	WEATHER
U.S. 20	

SEC.	TEMP.
11.281 SLK	

DESCRIPTION _____ PAVT WIDTHS _____ JOB NO. _____

LEFT _____ RIGHT _____

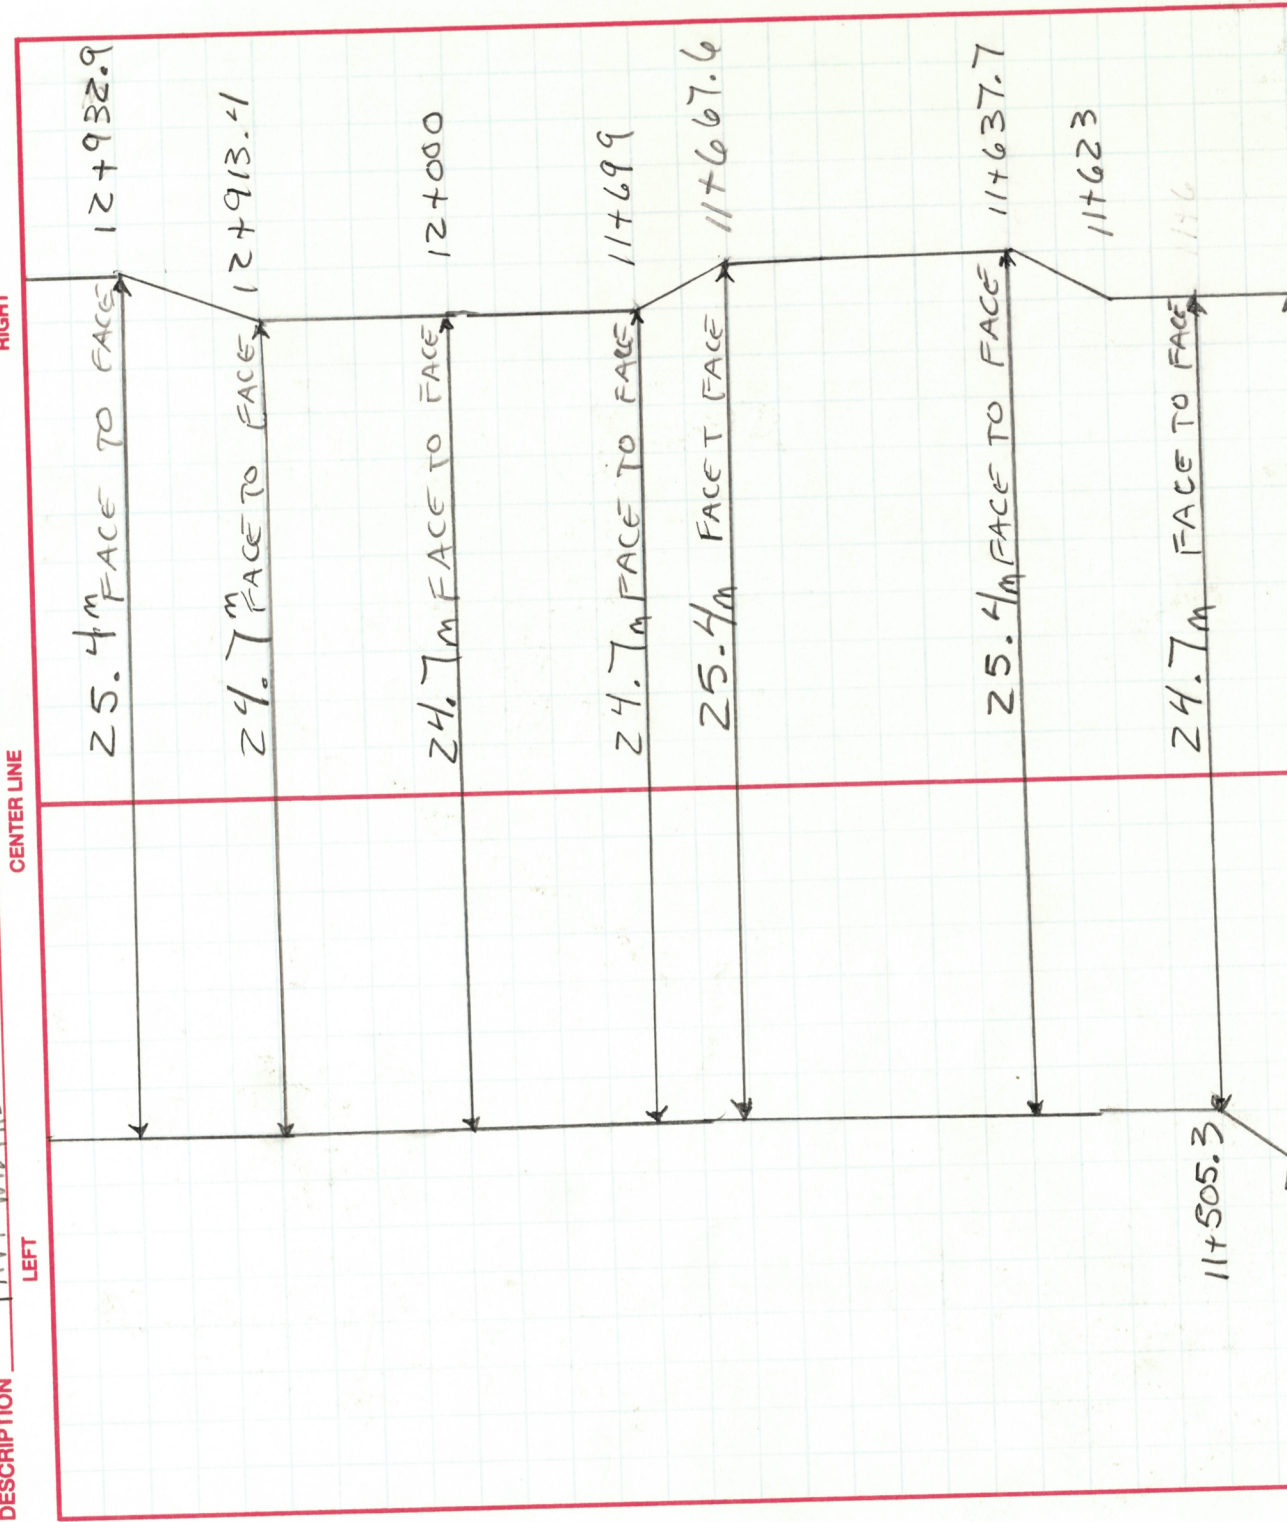

194SWH

OHIO DEPARTMENT OF TRANSPORTATION

SHEET NO. 12/24

PERSONNEL

TITLE

PERSONNEL

TITLE

COUNTY LVC

DATE

April - 87

Loehrke

Cordes

Stiffler

S. R. U.S. 20

WEATHER

SEC. 11.281 SLK

TEMP.

PAVT. WIDTHS


JOB NO.

DESCRIPTION

LEFT

CENTER LINE

RIGHT

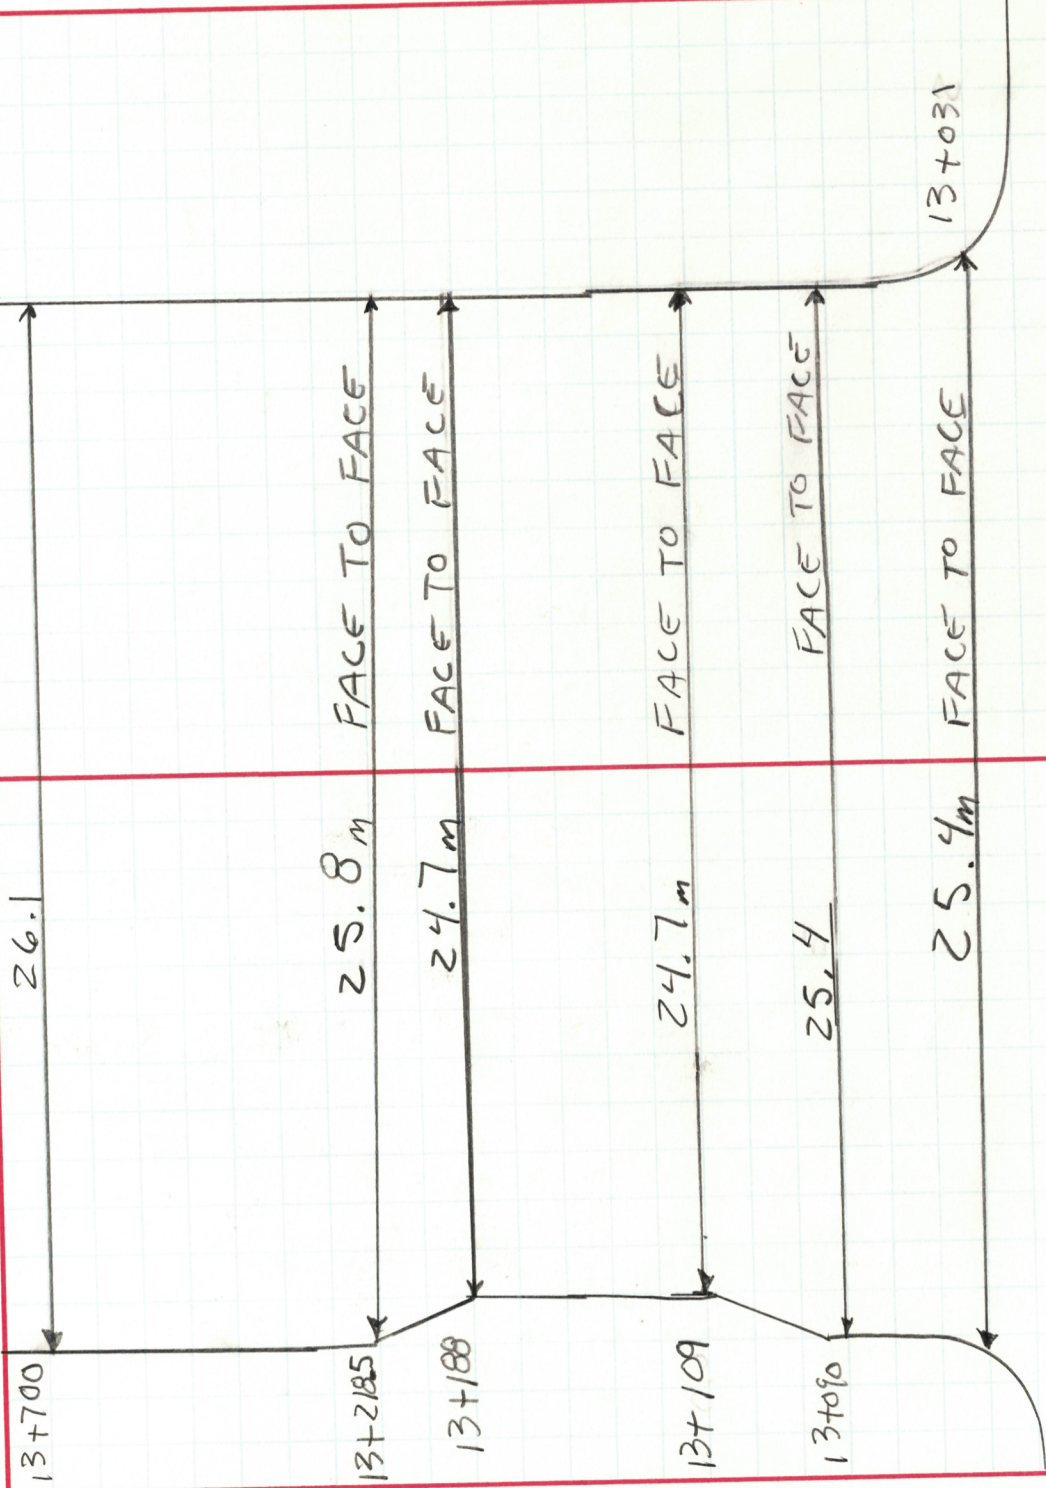

194SWH

PWS

OHIO DEPARTMENT OF TRANSPORTATION

SHEET NO.

14/24

PERSONNEL

TITLE

PERSONNEL

TITLE

LOERKE

CORDES

COUNTY

LUCAS

DATE

4-1-97

S.R.

U.S. 20

WEATHER

Wice

SEC.

11.281

TEMP.

+46° F

DESCRIPTION PAUT

WIDTH'S

LEFT

CENTER LINE

RIGHT

JOB NO.

W1FORD RD

Note: Width Changes - Next sheet

24.5m

FACE TO FACE

14+970

24.5m


FACE TO FACE

14+790

ZONE
RD

25.3m

DESCRIPTION	CENTER LINE	RIGHT	JOB NO.
PAV. WIDTHS			

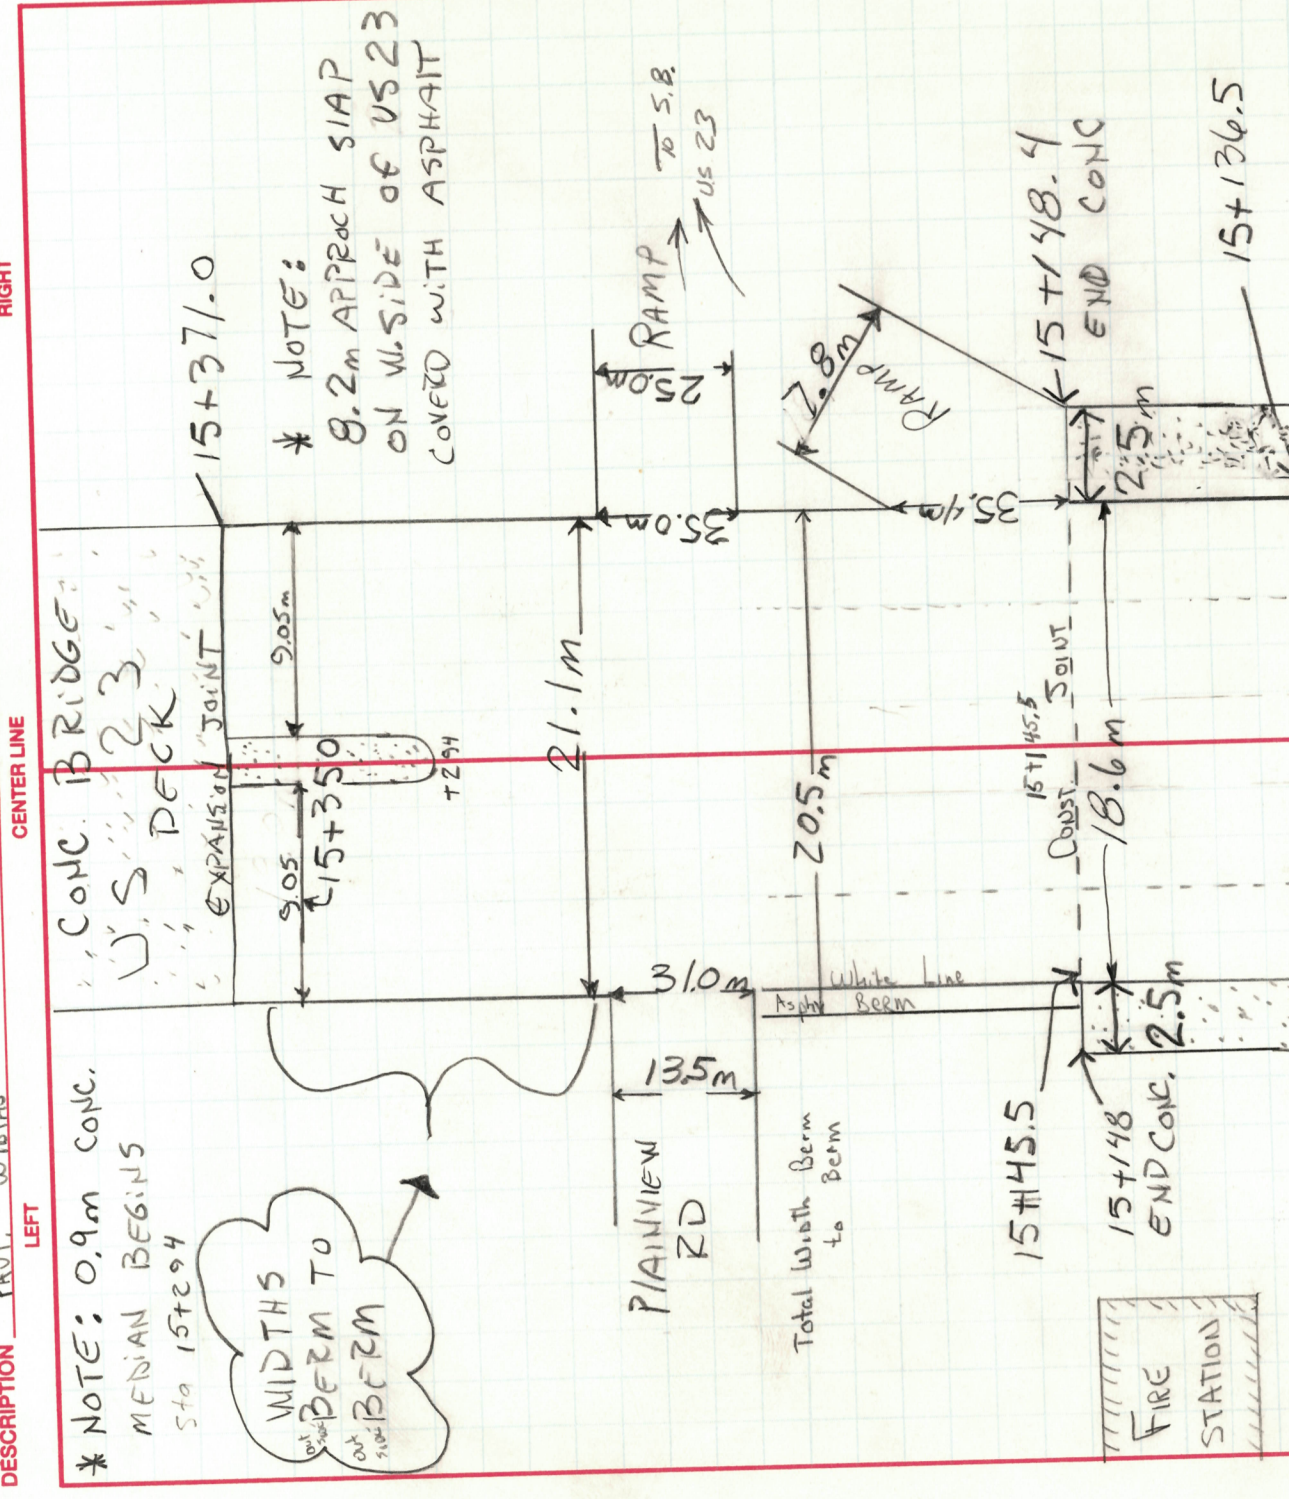

194SWH

PM 1

OHIO DEPARTMENT OF TRANSPORTATION

SHEET NO.

16/24

PERSONNEL

TITLE

PERSONNEL

TITLE

Loehrke

Cordes

Stiffler

COUNTY

LUC

S.R.

U.S. 20

SEC.

11.281 SLK

DATE

3-26-97

WEATHER

CLOUDY

TEMP.

+ 40 F

DESCRIPTION

Pavt Markings


LEFT

CENTER LINE

RIGHT

JOB NO.

CENTENNIAL ROAD

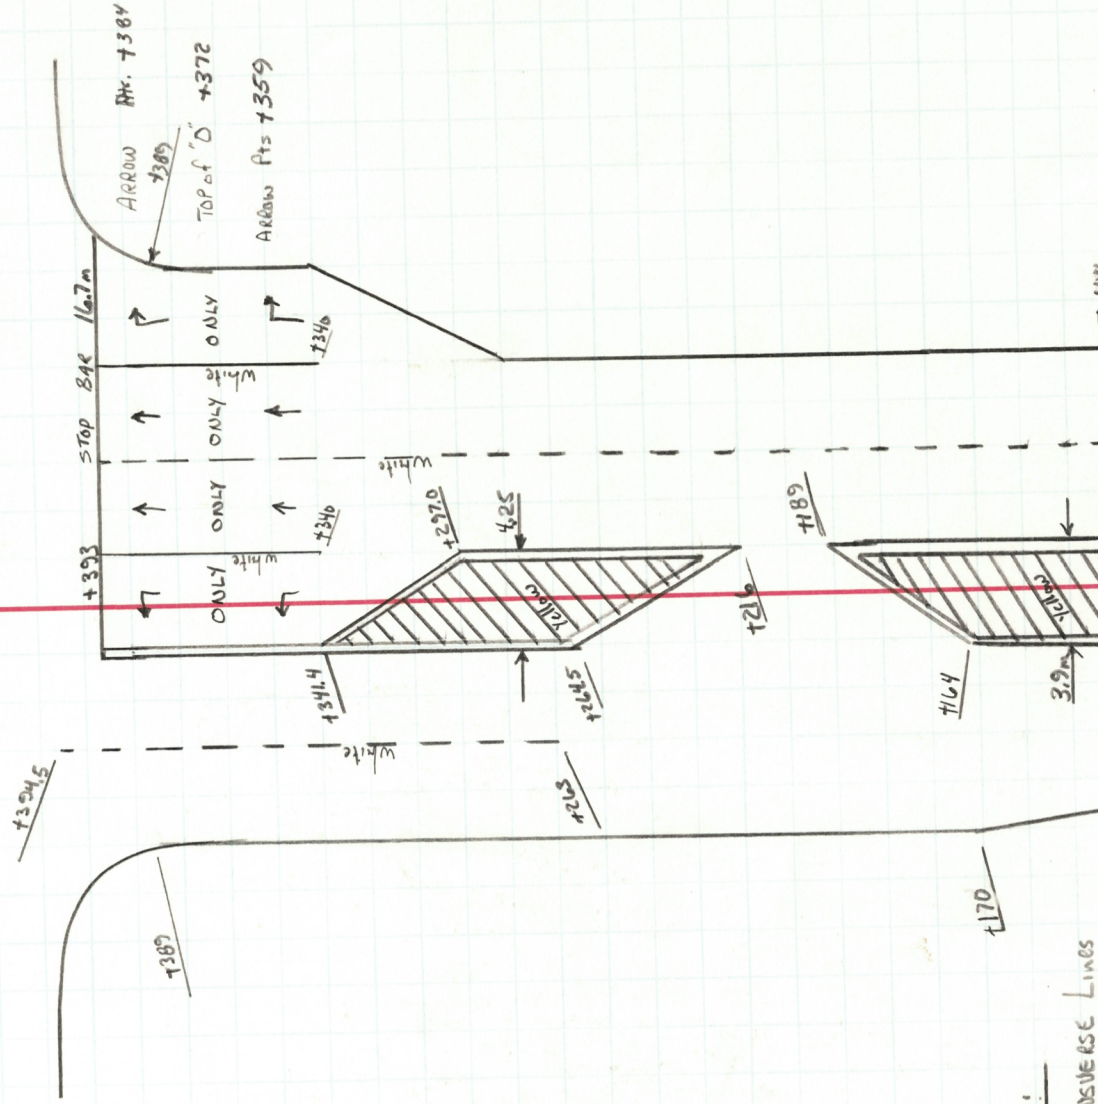


194SWH

OHIO DEPARTMENT OF TRANSPORTATION

SHEET NO. 19/24

pm 4

PERSONNEL	TITLE	PERSONNEL	TITLE	COUNTY	LVC	DATE	9-31-97
Boehrke						WEATHER	FAIR
Cordes				S. R.	U.S. 20	TEMP.	+38°F
Stiffler				SEC.	11.281 SLK		
DESCRIPTION				PAVT. MARKINGS		JOB NO.	

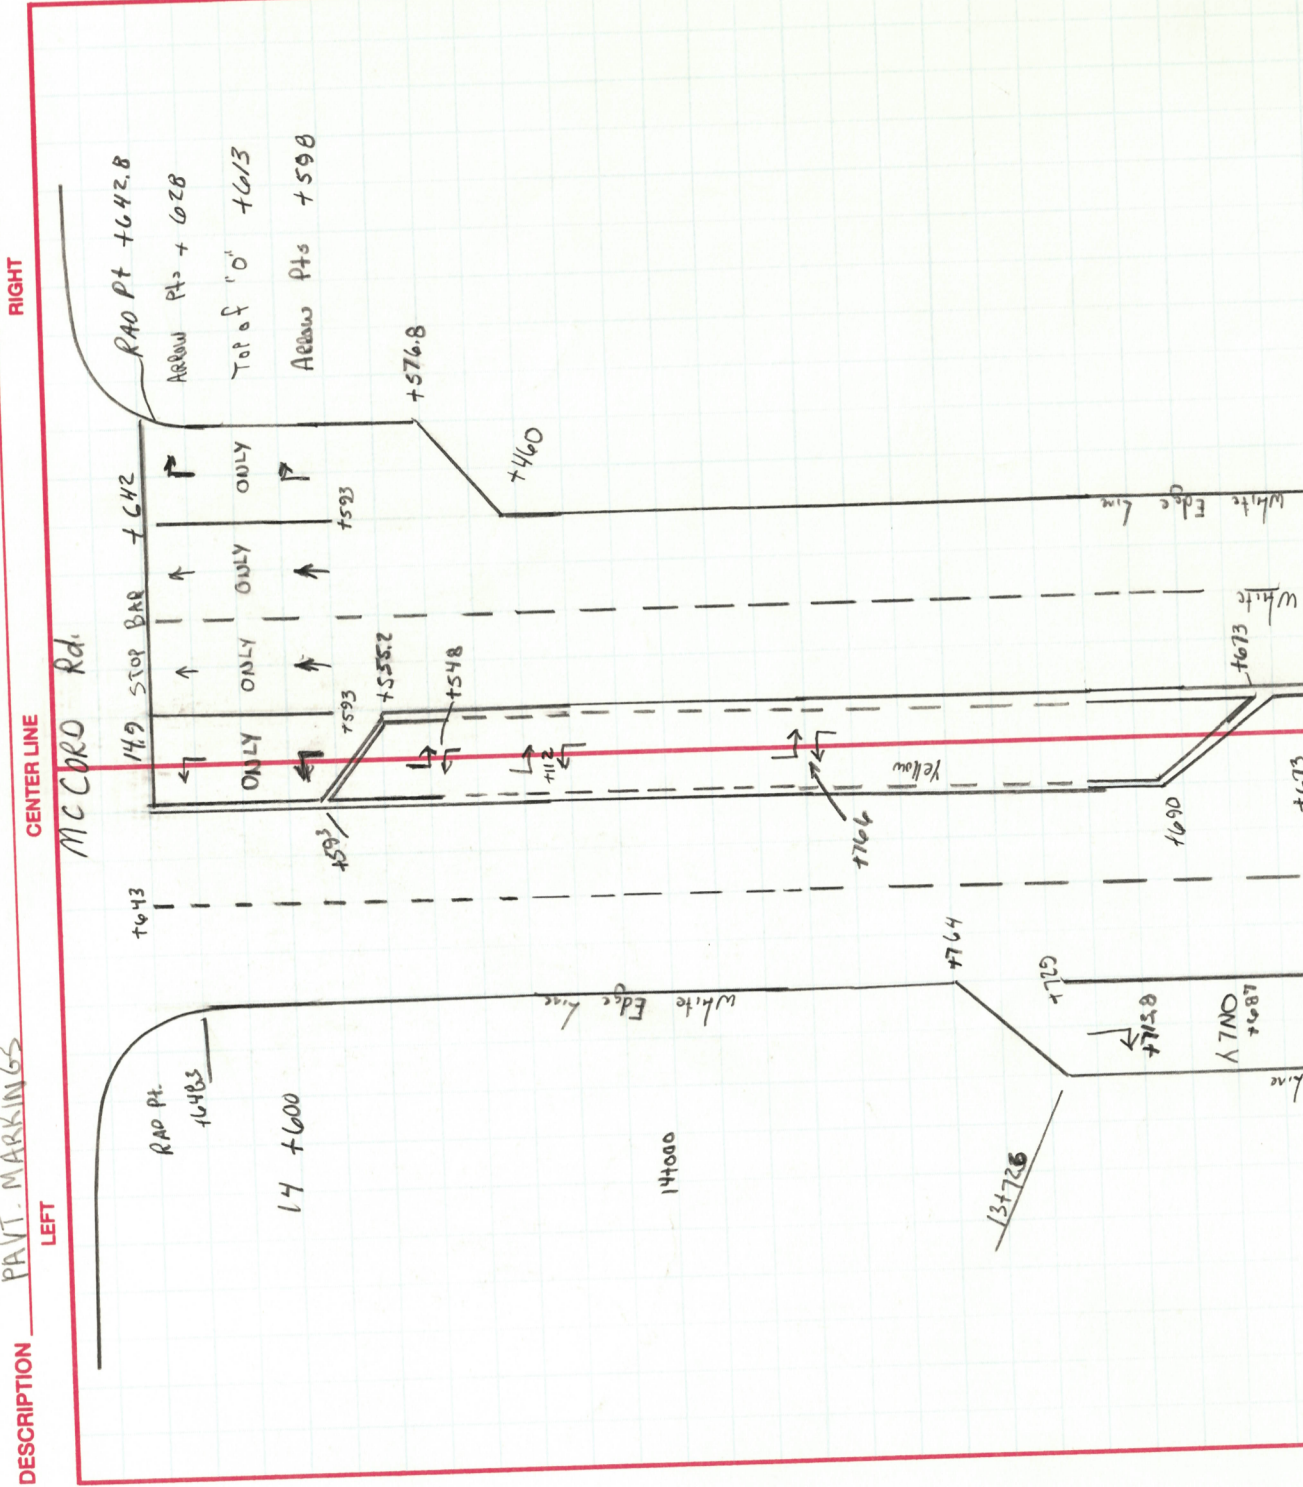

4-1-97

11.50

—

158

1

1

white lines 0.3" wide
spaced 8" apart

TWO-LANE RESURFACING PROGRAM

UTILITIES (CATCH BASIN, MANHOLE, INLET, WATER VALVE, BOX AND MONUMENT BOX)

COUNTY LUCROUTE 1520SECTION 11.281 SLK

R = RAISE F = FEATHER

STATION	OUT (FT) RT/LT OF C	CATCH BASIN	MAN- HOLE	INLET	W V BOX	MON BOX	CASTING		REMARKS ie: RECONSTRUCT, NO WORK
							R	F	
14+842.2	On C					X	X		
14+844	Curb Rt.			X					
14+881	Lt.		X						Telephone Manhole
14+905	Curb Lt.			X					
15+063	Curb Lt.			X					
15+063	Curb Rt.			X					
15+099.2	On C					X	X		
15+102.8	On C					X	X		
15+107	Lt.		X						Encased in concrete
15+851	Curb Lt. Extended		X						
15+932	Curb Rt.			X					
15+938	Curb Lt. in radius			X					
15+956	Lt.				X		X		
15+957	Lt.		X				X		
15+993	Curb Rt.			X					
16+045	Curb Lt. in radius			X					
16+113	Curb Rt.			X					
16+151	Curb Lt.			X					
16+154	Lt. in radius		X						
16+190	Curb Lt.			X					

DATE April 24 1971

TWO-LANE RESURFACING PROGRAM
INTERSECTIONS

SHEET 22 OF 24

COUNTY LUC ROUTE 1520 SECTION 11.281 SLK

L - PROP PAVT DEPTH (IN) X IO; W - WIDTH @ MOUTH; W-I - WIDTH @ THROAT

STATION	SIDE	NAME OR NO.	L	W	W-I	ASPH	CONC	REMARKS
11+204.5	R	VILLA RD	4.7	23.4	12.8	X		
11+405	L	CENTENNIAL	4.7	31.6	17.1	X		
11+405	R	CENTENNIAL	4.7	30.2	17.8	X		
11+807.3	L	GRADWOHL RD	4.7	21.2	11.2	X		
11+201.9	L	SHETLAND RD	4.7	25.9	11.5	X		
12+608.4	L	HESLER RD	4.7	21.8	11.5	X		
13+011	L	KING RD	4.7	31.7	14.5	X		
13+011	R	KING RD	4.7	30.3	16.7	X		
13+517.4	R	SPRING WATER DR	4.7	22.5	9.1	X		
13+632.5	L	MEIJER DR	4.7	42	27.2	X		
13+743.7	R	STONE/LEIGH DR	4.7	31.5	20.0	X		
13+916.0	R	SQUIRREL BEND DR	4.7	33.3	21.9	X		
14+004.6	L	PERCENTUM RD	4.7	21.6	11.2	X		
14+147	R	SEQUOIA RD	4.7	22.8	13.3	X		
14+664.6	R	McCogo Rd	4.7	42.3	22.5	X		Asph over Conc
14+664.6	L	McCogo Rd	4.7	37.4	18.7	X		"
14+774.0	L	ZONE Rd	4.7	36.3	14.9	X		Asph over Conc
14+886	L	Central Park West	4.7	32.4	13.1	X		
	L	WILFORD	See	See	See		X	
			See	See	See		X	