

1998 TWO-LANE RESURFACING PROGRAM

DATE MAY 1991
 PERSONNEL LOEHKE
COPDES

PRIORITY NO. 2 PART 2 OF 2 SHEET 1 OF 17
 COUNTY LUCLAS ROUTE 20 SECTION 10.05
 BEGIN LOG (SLM) 10.05 (16+173) TERMINII Meet Previous I-475 Project
 END LOG (SLM) 10.65 TERMINII Reynolds Rd.
 TOTAL LENGTH .60 MILES
 MUNICIPALITY BEGIN LOG (SLM) END LOG (SLM)
 MUNICIPALITY BEGIN LOG (SLM) END LOG (SLM)

PROPOSED WORK: PAVEMENT PLANING & RESURFACING

PAVEMENT 1 1/2" 446 Type 1 SHOULDER
 OTHER USE 1 3/4" 446 Type 2 & 1 1/2" 446 Type 1 at the intersection

STATION ESTABLISHED FROM:

Metric
Station CARRIED IN FROM County Line
For A Resurf. Job Previously Done Just West
of PART ONE: This CARRIED OVER U.S. 23 to
BEGIN PART TWO

STRUCTURES: NONE

NUMBER	STATION	WIDTH	LENGTH	PROPOSED WORK

RAILROAD CROSSING: NONE

(NO WORK)

NAME STATION NO. TRACKS LENGTH ALONG C L FT

PERSONNEL TITLE PERSONNEL TITLE COUNTY TITLE DATE 5-7-97
LOEHRKE
CORDES
St. Pflieg
S. R. U.S. 20
SLM 7.01 E 10.05
SEC. TEMP. 75.0°
WEATHER FINE

DESCRIPTION PRECONSTRUCTION Cross Sections - METRIC JOB NO.
LEFT CENTER LINE RIGHT

For Bench Marks - Cut "x" Top Center of Rt Side Curb									
@ each Station = Assumed 100.000 m									
Lt	TOP	OUTSIDE	INSIDE	CR	YELLOW	CR	FOF	INSIDE	TOP
Curb	Gutter	Gutter	Gutter	WBL	Line	FDL		Gutter	Curb
12+000	1.727	1.783	1.752	1.581	1.532	1.505	1.589	1.755	1.721
	24.83	24.68	24.10	21.78	18.25	2.55	10.60	0.78	0
12+500	1.507	1.585	1.529	1.431	1.313	1.294	1.385	1.549	1.507
	24.85	24.70	24.10	21.75	18.25	12.60	7.00	0.78	0
13+000	1.503	1.640	1.578	1.429	1.351	1.325	1.343	1.520	1.485
	26.05	26.90	25.30	21.75	18.25	12.60	7.00	0.80	0
14+000	1.703	1.805	1.758	1.639	1.568	1.466	1.465	1.701	1.685
	24.90	24.70	24.10	21.75	18.25	12.60	7.00	0.80	0
15+000	1.627	1.760	1.691	1.569	1.498	1.445	1.442	1.672	1.618
	24.90	24.70	24.10	21.75	18.25	12.60	7.00	0.80	0
15+500	1.131	1.265	1.208	1.305	1.111	1.041	1.017	1.213	1.132
	10.05	19.80	19.18	17.15	15.15	10.00	8.00	0.80	0

COUNTY LUCAS

ROUTE

$$\frac{20}{N}$$

SECTION.

16-17351K

EAST BOUND ONLY	
-----------------	--

[illegible]

COUNTY LUCAS ROUTE 20 SECTION 16.115 SIN

WEST BOUND ONLY

[illegible]

COUNTY LUC ROUTE U.S. 20 SECTION 11.281 SLK
 R - RAISE F - FEATHER

STATION	OUT (FT) RT/LT OF C	CATCH BASIN	MAN- HOLE	INLET	W V BOX	MON BOX	CASTING		REMARKS ie: RECONSTRUCT, NO WORK
							R	F	
14+842.2	On C					X	X		
14+844	Curb Rt.			X					
14+881	Lt.		X						Telephone Manhole
14+905	Curb Lt.			X					
15+063	Curb Lt.			X					
15+063	Curb Rt.			X					
15+099.2	On C					X	X		
15+102.8	On C					X	X		
15+107	Lt.		X						Encased in concrete
15+851	Curb Lt. Extended		X						
15+932	Curb Rt.			X					
15+938	Curb Lt. in radius			X					
15+956	Lt.				X		X		
15+957	Lt.		X				X		
15+993	Curb Rt.			X					
16+045	Curb Lt in radius			X					
16+113	Curb Rt.			X					
16+151	Curb Lt.			X					
16+154	Lt in radius		X						
16+190	Curb Lt.			X					

STATION	OUT (FT) RT/LT OF C	CATCH BASIN	MAN- HOLE	INLET	W V BOX	MON BOX	CASTING		REMARKS ie: RECONSTRUCT, NO WORK
							R	F	
16+374	Lt		X					X	
16+378	Lt		X					X	
16+410	Rt		X				X		
16+430	Curb Lt.			X					
16+460	Curb Lt			X					
16+468	Curb Rt			X					
16+562	Curb Lt in radius			X					
16+562	Curb Rt.			X					
16+578	Rt		X						
16+579	Curb Lt			X					
16+579.5	Lt.				X			X	
16+669	Curb Lt. Extended		X						
16+773	Curb Lt in radius			X					
16+782	Curb Rt.			X					
16+789	Curb Lt in radius			X					
16+829	Lt.		X						
16+848	Curb Rt			X					
16+915	Curb Lt			X					
16+929	Curb Rt.			X					
16+955	Curb Rt			X					

COUNTY	VC	ROUTE	1520	SECTION	11.281 SLK
--------	----	-------	------	---------	------------

R = RAISE F = FEATHER

[illegible]

TWO-LANE RESURFACING PROGRAM
INTERSECTIONS

SHEET 8 OF 17

COUNTY LVC ROUTE U.S. 20 SECTION 11.281 SLK

L - PROP PAVT DEPTH (IN) X IO; W - WIDTH @ MOUTH; W-I - WIDTH @ THROAT

STATION	SIDE	NAME OR NO.	L	W	W-I	ASPH	CONC	REMARKS
11+204.5	R	VIIIA RD	4.7	23.4	12.8	X		
11+405	L	CENTENNIAL	4.7	31.6	17.1	X		
11+405	R	CENTENNIAL	4.7	30.2	17.8	X		
11+807.3	L	GRADWOHL RD	4.7	21.2	11.2	X		
11+201.9	L	SHEPHERD RD	4.7	25.9	11.5	X		
12+608.4	L	HESYLER RD	4.7	21.8	11.5	X		
13+011	L	KING RD	4.7	31.7	14.5	X		
13+011	R	KING RD	4.7	30.3	16.7	X		
13+517.4	R	SPRING WATER DR	4.7	22.5	9.1	X		
13+632.5	L	MEIJER DR	4.7	42	27.2	X		
13+743.7	R	STONEIEGH DR	4.7	31.5	20.0	X		
13+9100	R	SQUIRREL BEND DR	4.7	33.3	21.9	X		
14+004.6	L	PERCENTUM RD	4.7	21.6	11.2	X		
14+147	R	SEQUOIA RD	4.7	22.8	13.3	X		
14+6640	R	McCord Rd	4.7	112.3	22.5	X		Asph over Conc
14+6646	L	McCord Rd	4.7	37.4	18.7	X		" "
14+7740	L	ZONE Rd	4.7	36.3	14.9	X		Asph over Conc
14+886	R	Central Park West	4.7	32.4	13.1	X		
	L	WILFORD	See	See	See		X	
	R	WILFORD	See	See	See		X	

COUNTY Lucas ROUTE U.S. 20 SECTION _____

L - PROP PART DEPTH (INJ X 10; W - WIDTH @ MOUTH; W-I - WIDTH @ THROAT

[illegible]

1945WH

OHIO DEPARTMENT OF TRANSPORTATION


SHEET NO.

10/17

PERSONNEL	TITLE	PERSONNEL	TITLE	COUNTY	DATE	WEATHER
HOEHRKE				LUCAS	4-1-97	Nice
CORDES				S. R.	U.S. 20	
				SEC.	11, 281	TEMP. + 58° F

DESCRIPTION	PAVT	MARKINGS	CENTER LINE	RIGHT	JOB NO.

ARROW¹⁵ + 669
 ONLY¹⁵ + 651
 ARROW¹⁵ + 634.5

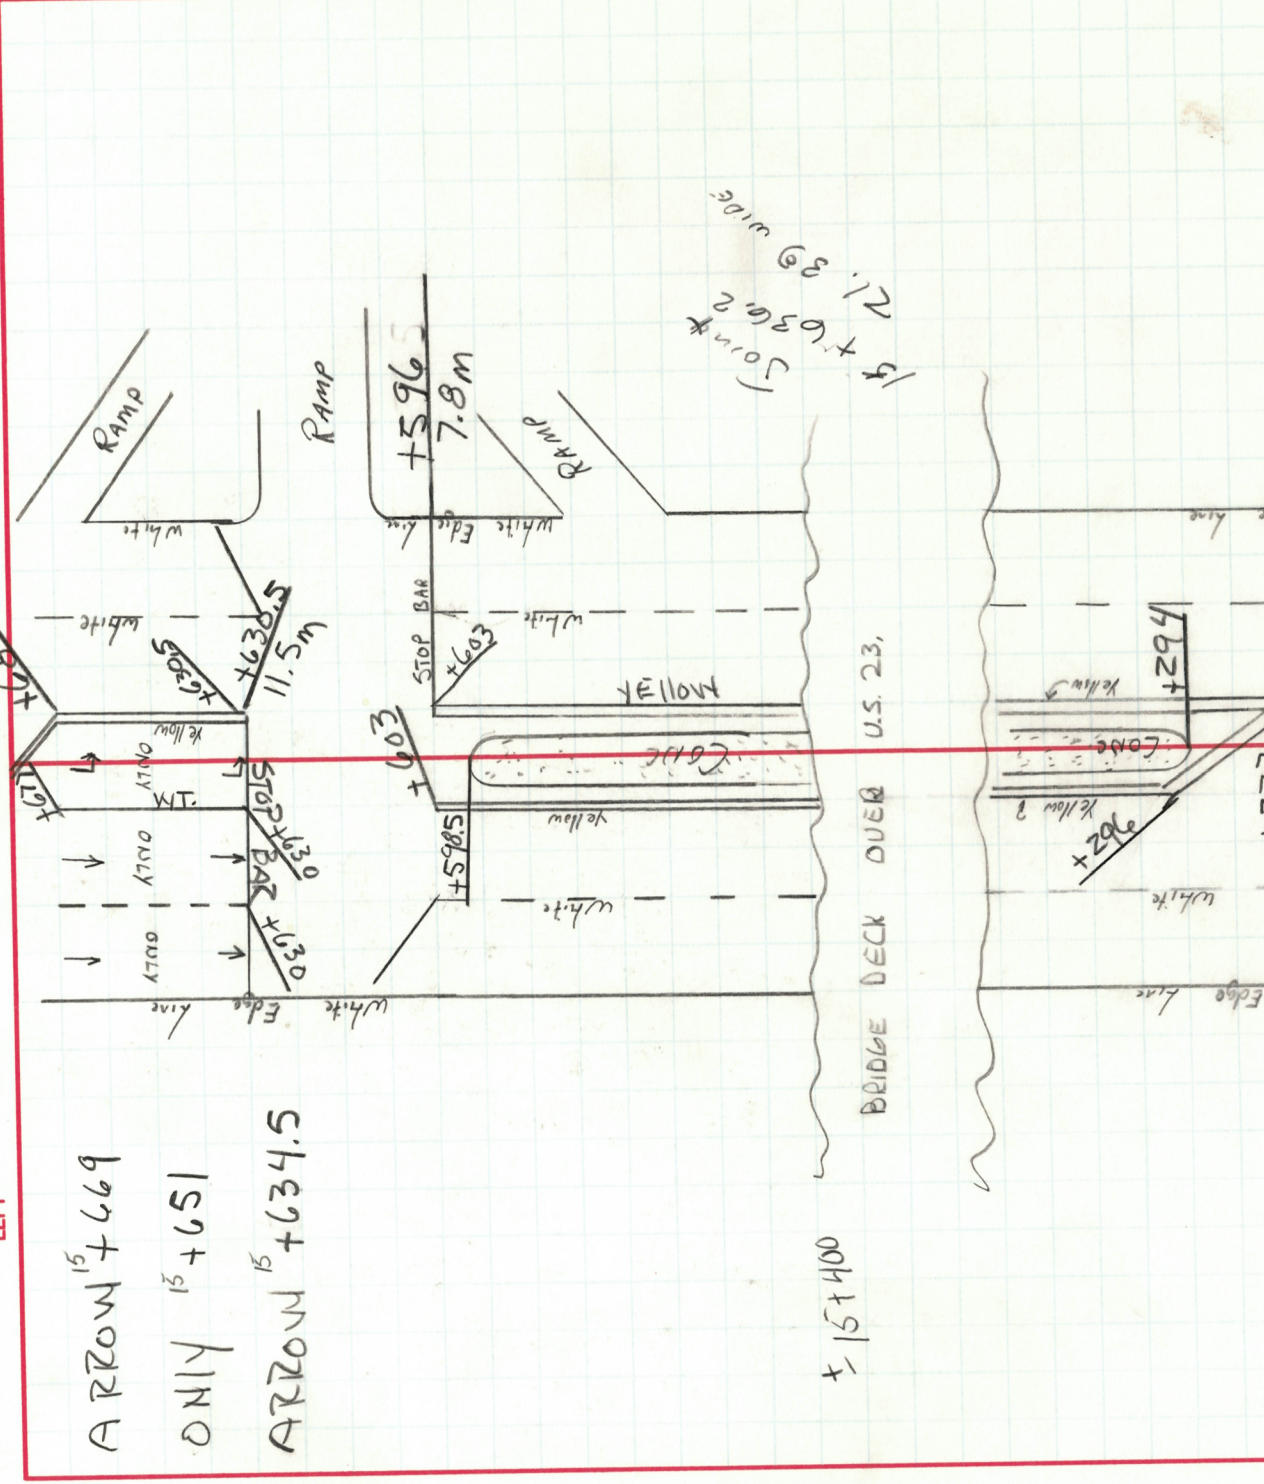


194SWH

OHIO DEPARTMENT OF TRANSPORTATION

SHEET NO. 11/17

PERSONNEL	TITLE	PERSONNEL	TITLE	COUNTY	DATE	WEATHER	TEMP.
C. LOENHAK				Lucas	5-6-57	Cool - Windy	+55
BEN CORDES				S. R.	U.S. 20		
				SEC.	11.281		

DESCRIPTION	PAVT	MARKINGS	JOB NO.
	PAVT	MARKINGS	

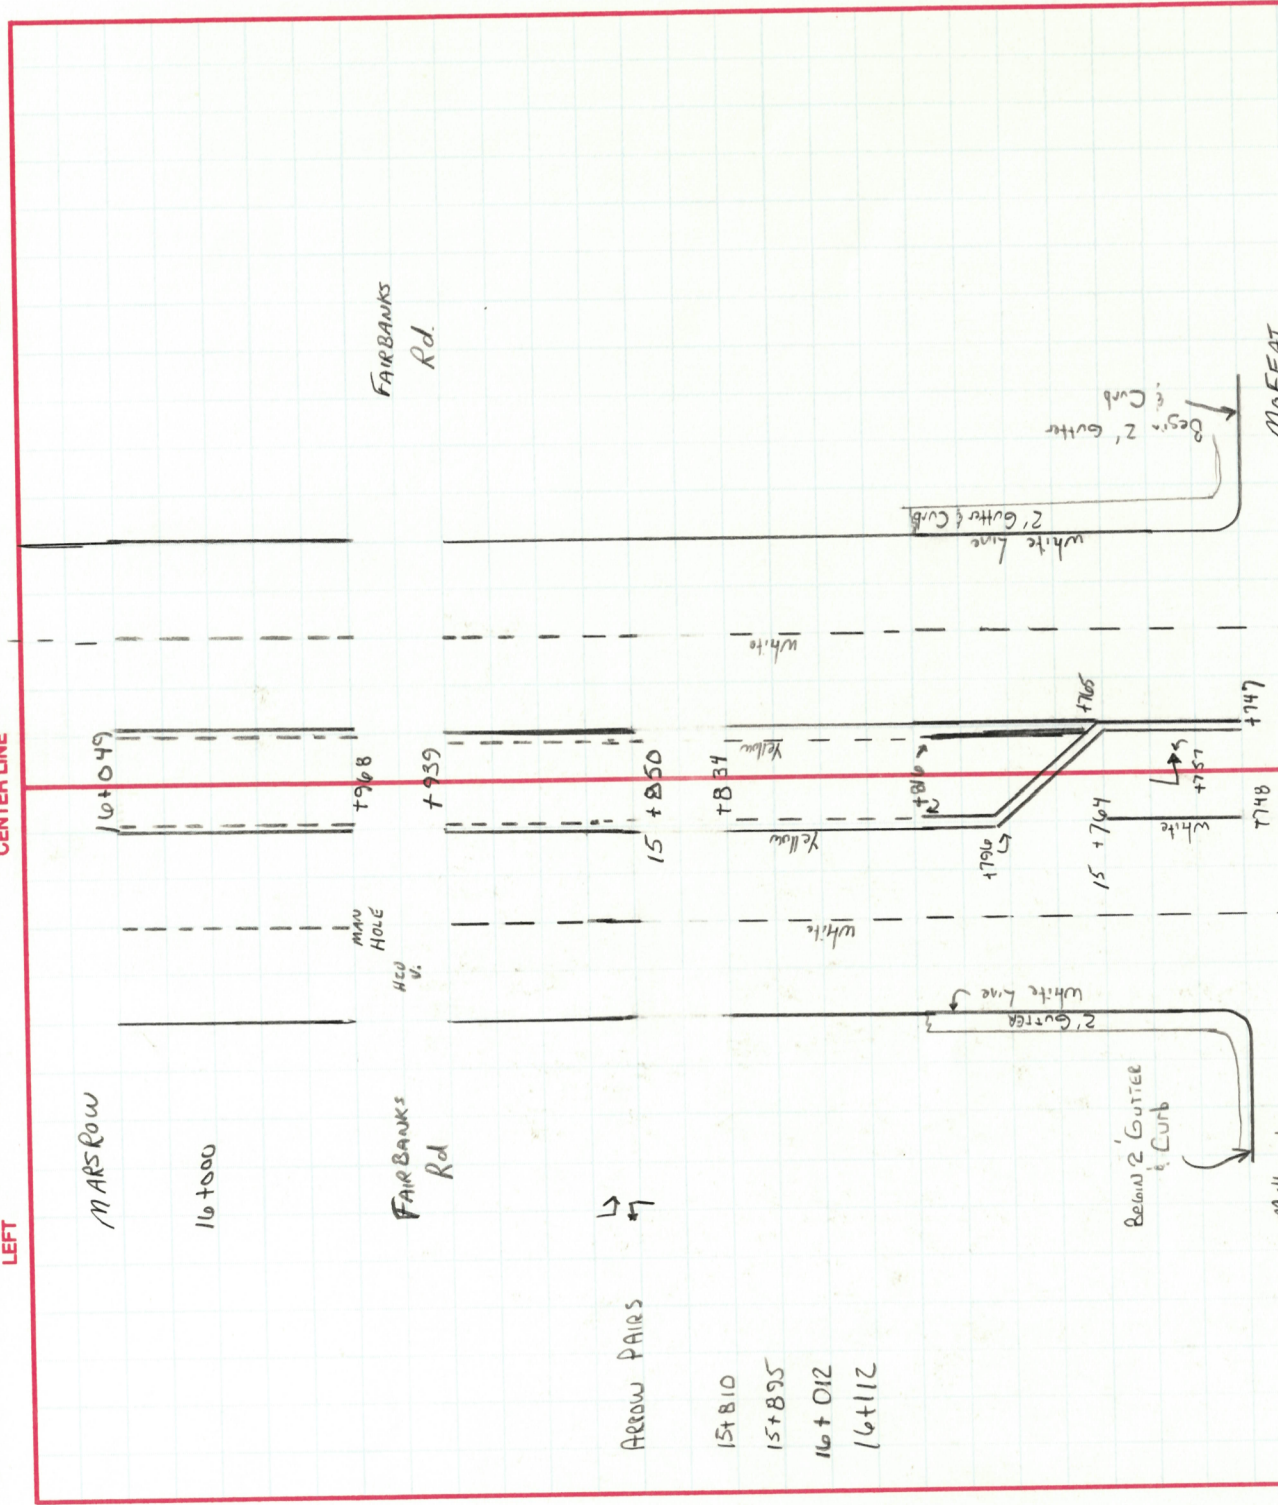

194SWH


OHIO DEPARTMENT OF TRANSPORTATION

SHEET NO. 14/17

P.M. 10

PERSONNEL	TITLE	PERSONNEL	TITLE	COUNTY	DATE	5-8-97
LEHRKE				LUCAS		
CORDES				S. R. U.S. 20	WEATHER	RAIN
				SEC. 11.281	TEMP.	+48° F

DESCRIPTION	PAV	MARKINGS	CENTER LINE	JOB NO.
	LEFT			RIGHT

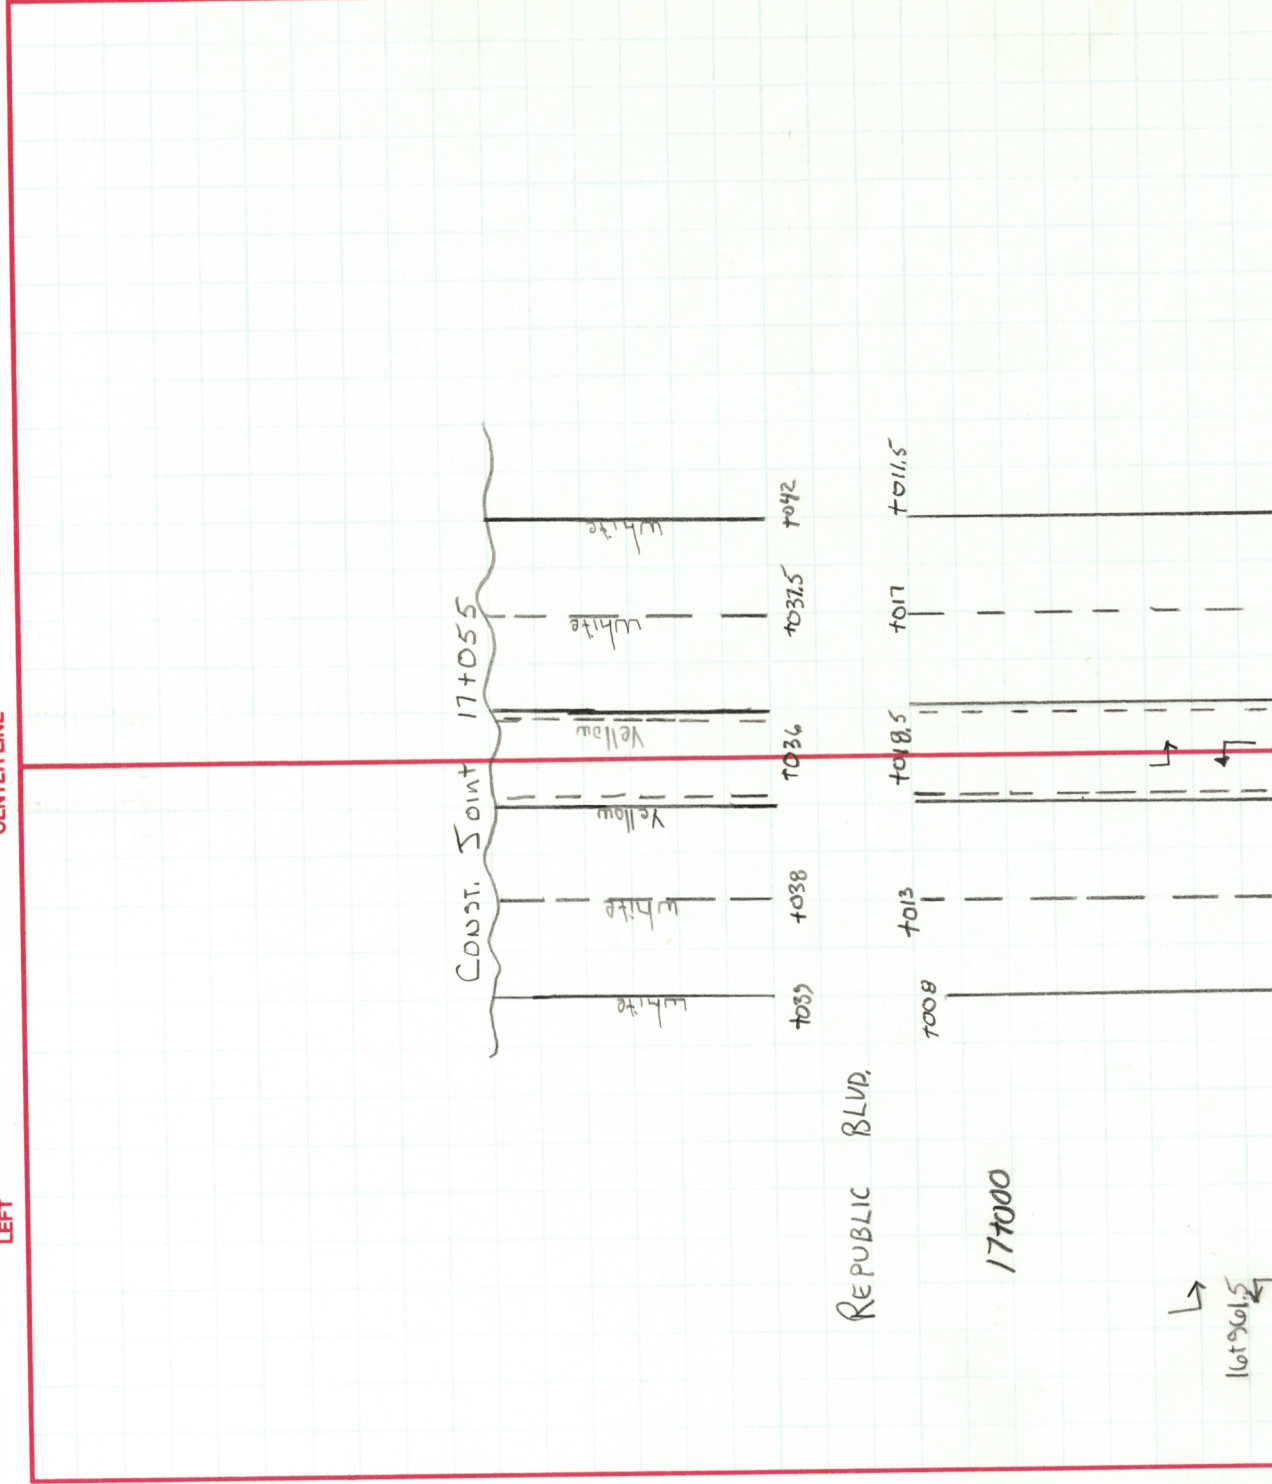


194SWH

OHIO DEPARTMENT OF TRANSPORTATION

SHEET NO. 15/17

PERSONNEL TITLE PERSONNEL TITLE COUNTY Lucas DATE MAY 7, 1992
LOERKE S. R. U.S. 20 WEATHER FAIR
COBES
STIFFLER SEC. 11.281 TEMP. +62

DESCRIPTION PAVT WIDTHS JOB NO. _____
LEFT RIGHT

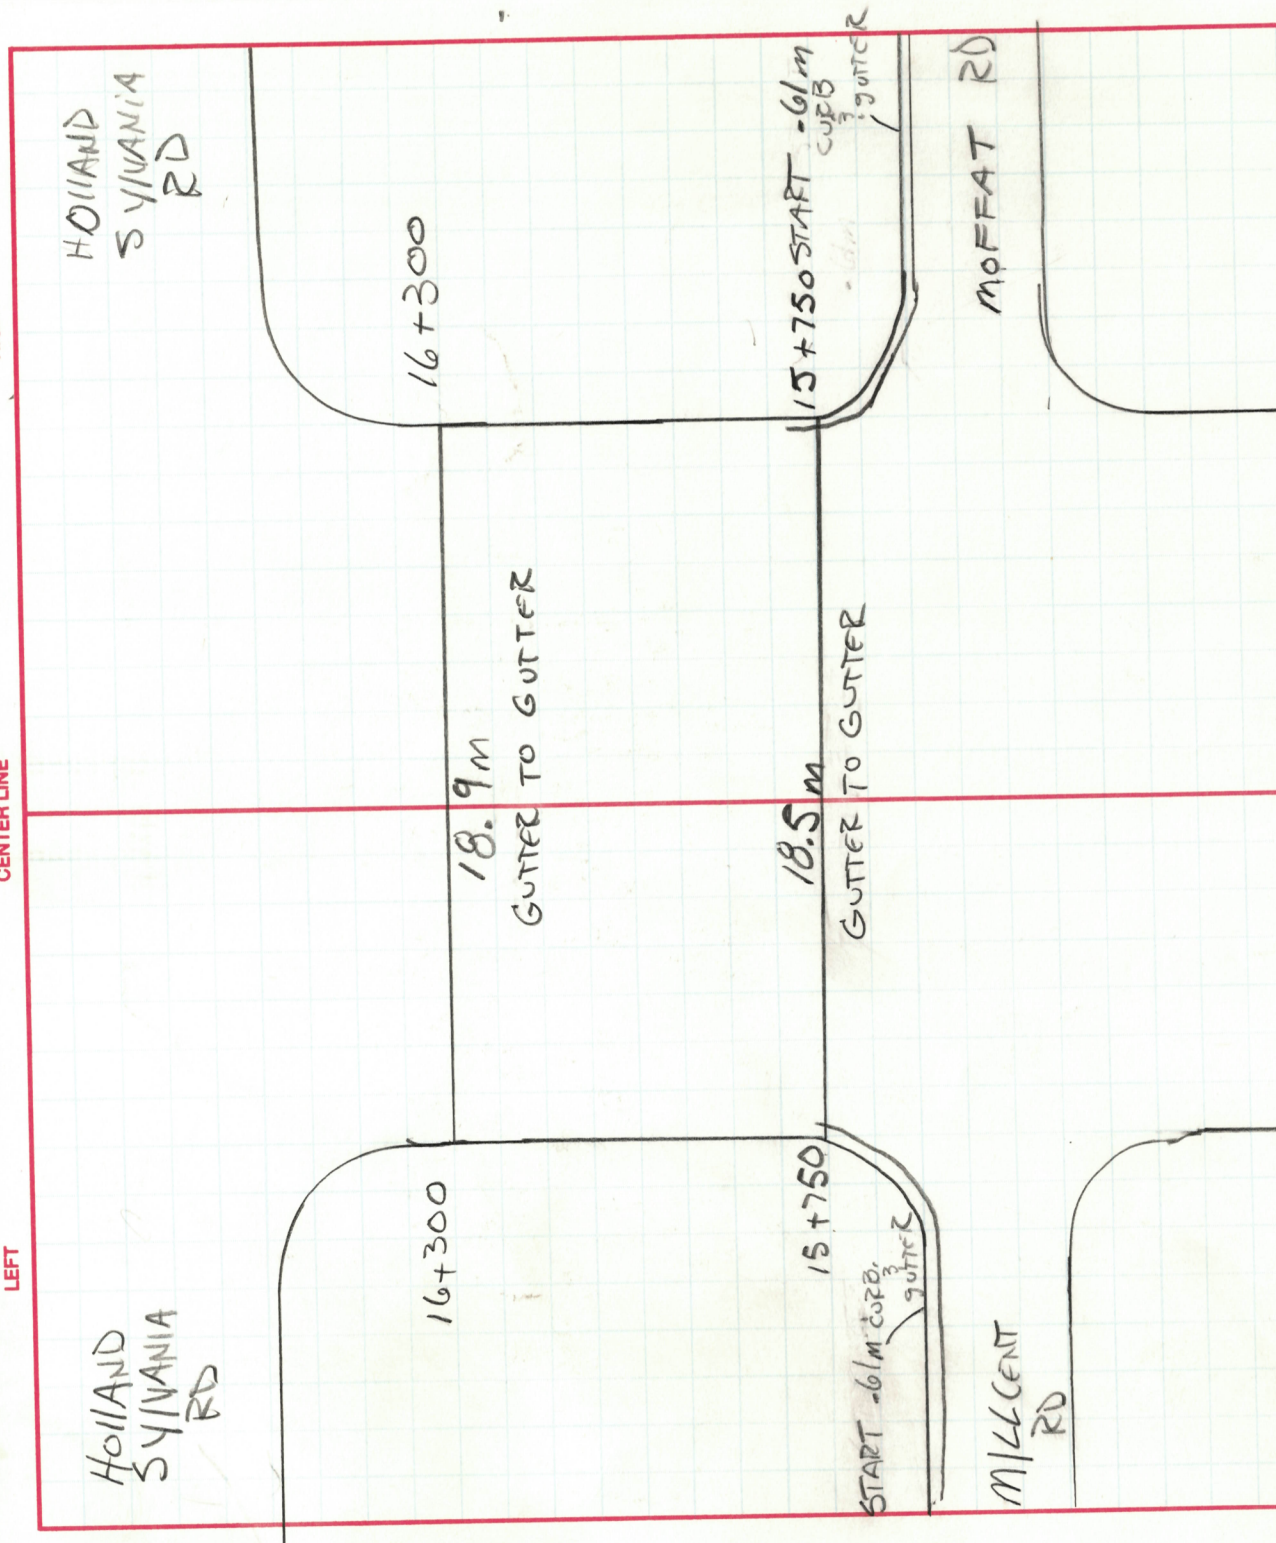

DESCRIPTION		LEFT	CENTER LINE	RIGHT	JOB NO.
<i>New PWT</i>	<i>APRIL</i>	<i>1997</i>			

