

GEOT (1-2)

1997

~~ROAD~~ TWO-LANE RESURFACING PROGRAM

PERSONNEL LOEHMKE

DATE 8-13-96

Notes to:
J. HUSS
8-15-96

CANTERBURY

Rousos

PRIORITY NO. 22 PART 2 OF 2 SHEET 1 OF 14

COUNTY LUCAS ROUTE US 20 SECTION 17.45

CALC 281082

BEGIN LOG (SLM) 17.45 TERMINUS HOLLAND ROAD

CALC 281740

END LOG (SLM) 18.48 TERMINUS U.S. 24

TOTAL LENGTH 1.03 MILES

MUNICIPALITY Maumee BEGIN LOG (SLM) _____ END LOG (SLM) _____

MUNICIPALITY _____ BEGIN LOG (SLM) _____ END LOG (SLM) _____

PROPOSED WORK: Grind 5' along curb & gutter, resurface existing pavement

PAVEMENT 3/4" 403 & 1 1/4" 404 SHOULDER curb

OTHER Locate rutted areas @ US20A intersection (grind-3 1/4")

STATION ESTABLISHED FROM:

1963-1964 PLANS
LUCAS -20-17.25 PAGE 26/129

FD MON BOX @ INTERSECTION U.S. 20 & PERRYSBURG - HOLLAND ROAD

PLAN Sta for Box: 918+96.50 Ft. => EQUALS 28+00.9 SLK

MEAS. from Box to CONSTRUCTION JOINT: JOINT => Sta 28+095.80

FD CONSTRUCTION JOINT North of U.S. 24 Measured = 29+965.8

STRUCTURES: None

NUMBER	STATION	WIDTH	LENGTH	PROPOSED WORK

RAILROAD CROSSING:

(NO WORK)

29+467.46 JOINT } No WORK

NAME _____ STATION 2029+485.0 JOINT } NO. TRACKS 1 LENGTH ALONG C L FT

COUNTY	Lucas	ROUTE	U.S. 20	SECTION	28.082	Km
--------	-------	-------	---------	---------	--------	----

L = PROP PAVT DEPTH (IN) X 10; W = WIDTH @ MOUTH; W-1 = WIDTH @ THROAT

[illegible]

SHEET 3 OF 14

TWO-LANE RESURFACING PROGRAM
PAVEMENT DATA


NOTE: LOCATE ALL
CHANGES IN PVMT WIDTH

COUNTY Lucas ROUTE U.S. 20 SECTION 28.082 Km

[illegible]

PERSONNEL	TITLE	PERSONNEL	TITLE	COUNTY	DATE
LOFENKE				Lucas	8-13-96
E					
Crew					
				S. R. V.S. 20	WEATHER Nice
				SEC. 28.082 Km	TEMP. +78

DESCRIPTION	PAVT	W _D TNS	RIGHT	JOB NO.
			CENTER LINE	
			LEFT	

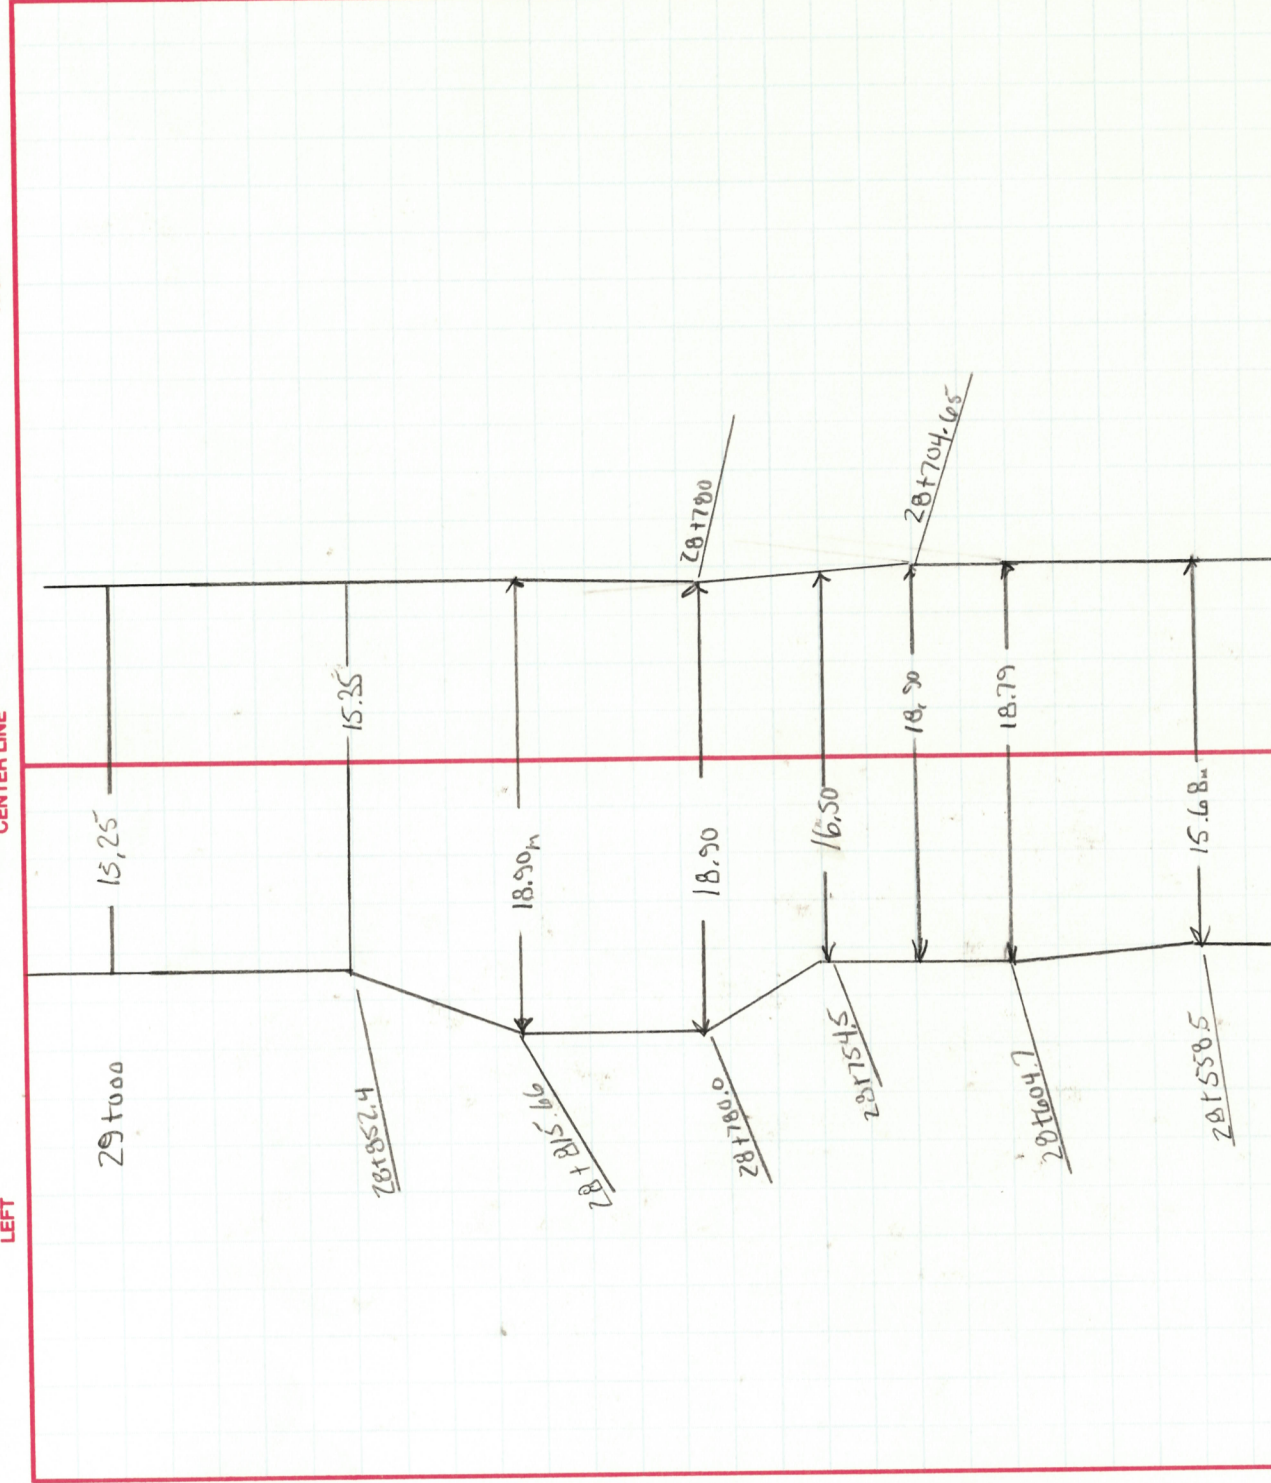

LOWE

TITLE

PERSONNEL

TITLE

COUNTY

LUCAS

DATE _____

8-13-96

3

1

100

1

6

12.5, 20

WEATHER

Nice

Case

1

1

33

+76


DESCRIPTION

PAUT W. Oths

CENTER LINE

RIGHT

No. _____

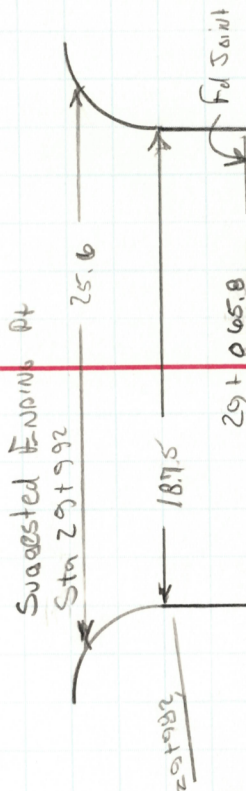

194SWH


OHIO DEPARTMENT OF TRANSPORTATION

SHEET NO. 6 of 14

P.M.

PERSONNEL	TITLE	PERSONNEL	TITLE	COUNTY	DATE
LOPARKÉ				LUCAS	8-6-96
				S. R.	U.S. 20
				SEC.	28.028
				TEMP.	790
Crew					

DESCRIPTION	LEFT	CENTER LINE	RIGHT	JOB NO.
-------------	------	-------------	-------	---------

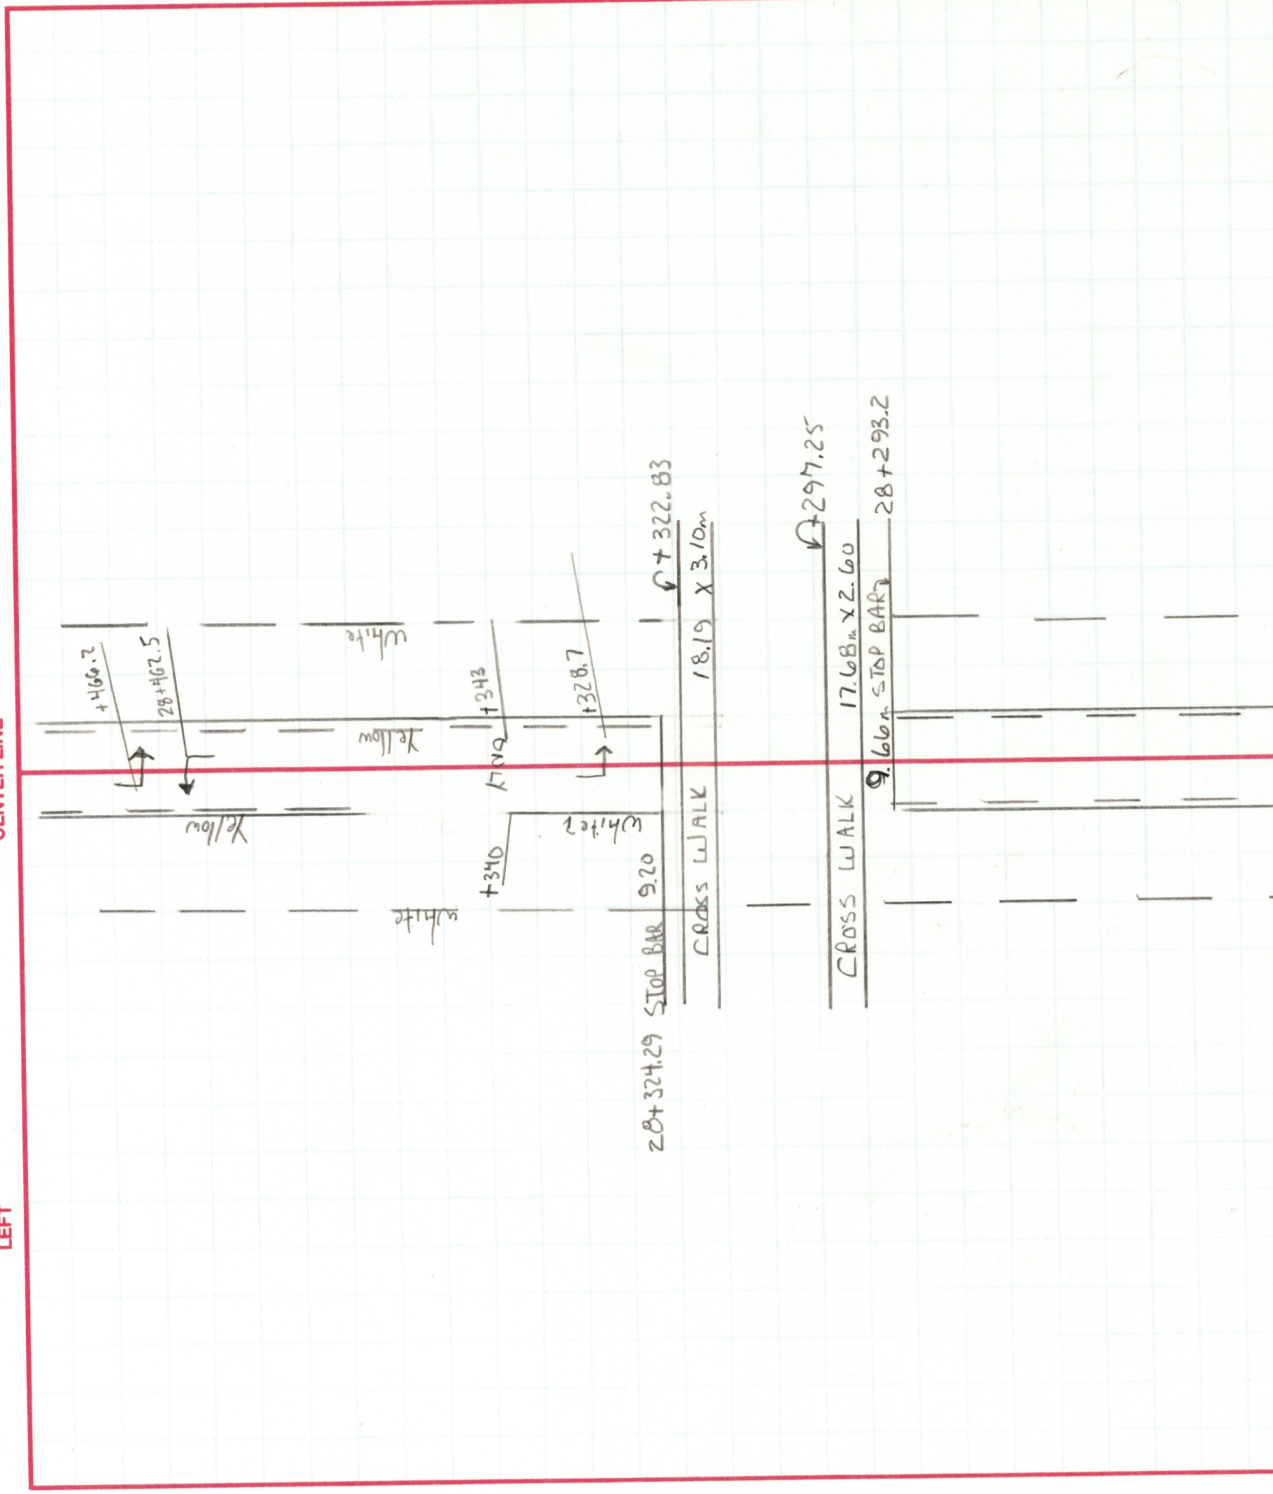

SHEET NO. 10 of 17

TITLE

COUNTY _____

10

11520

1131


CE

PAUT MARKINGS

JOB NO. —

LEFT

CENTER LINE

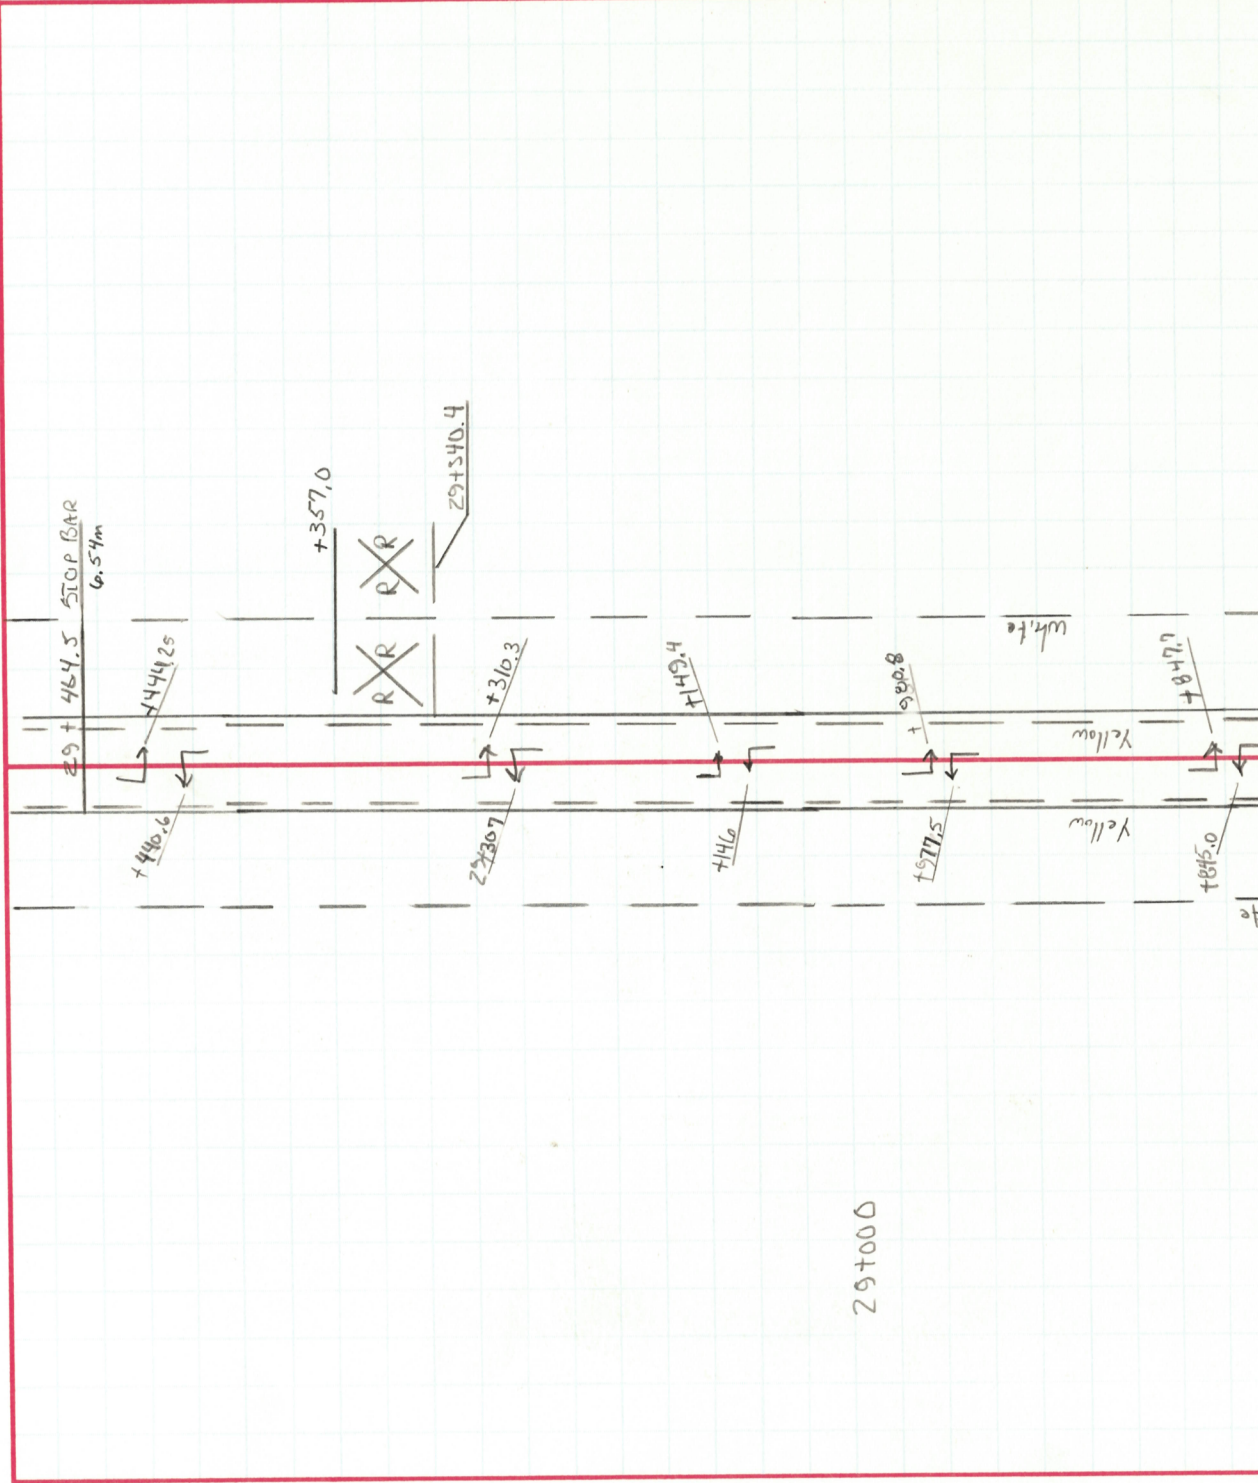RIGHT

9. f 14

COUNTY LUCAS

DATE 8-13-96

S.R. U.S. 20

WEATHER Wice

1001

SEC. 28,082


TEMP. +72

PAUT MARKINGS

JOB NO. _____

CENTER LINE

RIGHT

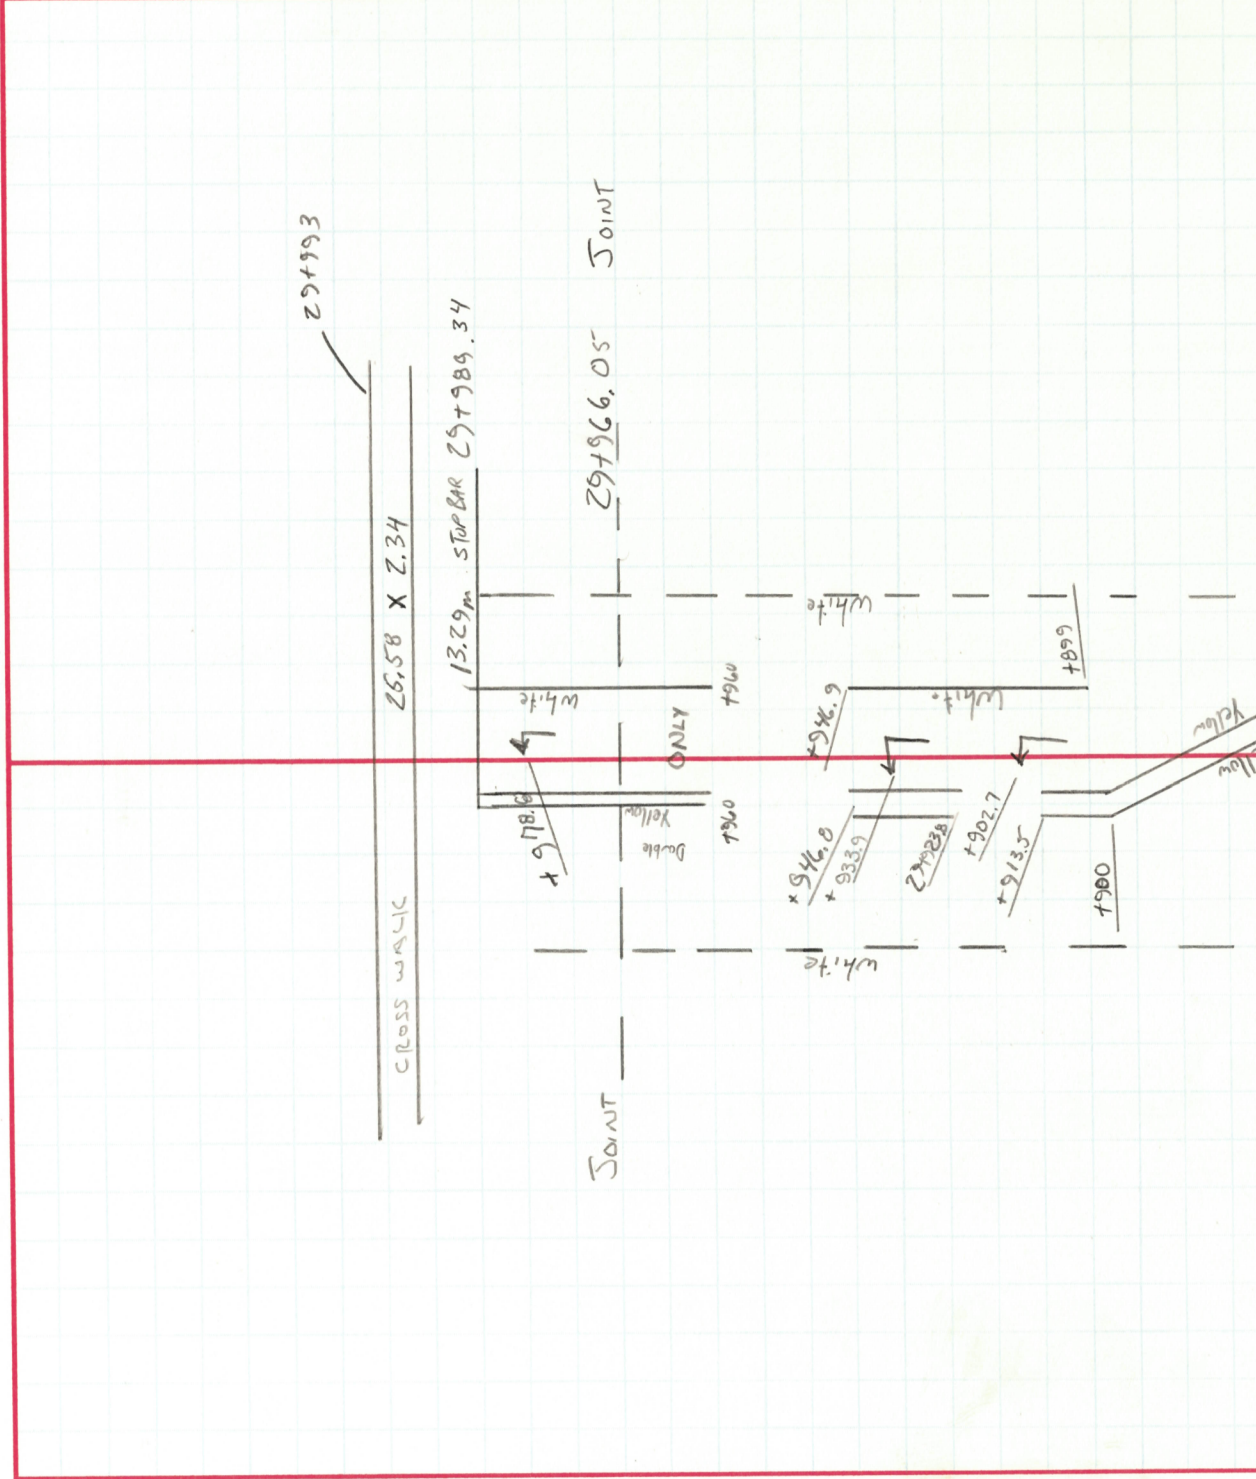

DATE 8-13-96

SHEET 10 OF 14

TWO-LANE RESURFACING PROGRAM

NOTE: LOCATE ALL
CHANGES IN PVMT WIDTH

SECTION.

PAVEMENT MARKINGS:

[illegible]

DATE 8-13-96
SHEET 11 OF 14

TWO-LANE RESURFACING PROGRAM
CROSSWALKS AND STOP BARS

COUNTY LUCAS ROUTE U.S. 20 SECTION Z8, 08Z

[illegible]

DATE 8-13-96SHEET 12 OF 14

TWO-LANE RESURFACING PROGRAM

UTILITIES (CATCH BASIN, MANHOLE, INLET, WATERVALVE, BOX AND MONUMENT BOX)

COUNTY LUCAS ROUTE U.S. 20 SECTION 28.082

R = RAISE F = FEATHER

STATION	OUT (FT) RT/LT OF C	CATCH BASIN	MAN- HOLE	INLET	W V BOX	MON BOX	CASTING		REMARKS ie: RECONSTRUCT, NO WORK
							R	F	
28+284.81	ON C					✓	✓		NO LID
28+414.50	ON C					✓	✓		NO LID
28+483.65	0.7 RT OF LT EOP					✓		✓	NO LID
28+551.20	ON C					✓	✓		NO LID
28+900.60	.7 LT OF RT EOP				✓			✓	
29+028.90	ON RT EOP				✓			✓	
29+071.05	ON RT EOP							✓	
29+255.50	ON C					✓	✓		
29+412.40	ON RT EOP				✓		✓		
29+498.22	ON RT EOP				✓		✓		
29+519+98	ON C				✓		✓		
29+542.20	2.95 ^M LT OF C				✓		✓		
29+579.2	ON C					✓	✓		NO LID
29+655.4	ON C				✓		✓		
29+656.25	3.3 ^M LT C				✓		✓		
29+704.15	7.23 ^M LT C		✓				✓		
29+777.34	11.44 RT C		✓						
29+783.25	13.16 RT C				✓		✓		
29+784.60	11.44 RT C		✓				✓		
29+785.63	7.70 ^M LT C		✓				✓		

TWO-DANE RESURFACING PROGRAM

SHEET 13 OF 14

UTILITIES (CATCH BASIN, MANHOLE, INLET, WATER VALVE, BOX AND MONUMENT BOX)

COUNTY LUCAS ROUTE 0.5.20 SECTION 28.08Z

R = RAISE F = FEATHER

[illegible]

DATE 6.15.96

TWO-LANE RESURFACING PROGRAM
DEFECTIVE PAVEMENT AREAS

COUNTY LUCAS ROUTE U. S. 120 SECTION 28.082

[illegible]