


O.D.O.T. DISTRICT 2 SURVEY OFFICE (USE ONLY)


PERSONNEL _____ REFERENCE NO. 27A SHEET 30 OF 36
 NOTES LEU DATE 08/03/16 ROUTE US 20
 H.C. HOMAN WEATHER PARTLY CLOUDY COUNTY LUCAS
 R.C. LEU TEMP. 87° TOWNSHIP SYLVANIA
 _____ SECTION 20
 _____ T 9 S R 6 E

TYPE MONUMENT _____ MON BOXES _____
 ON SURFACE - ~~BELOW~~ _____ ON _____
 LEFT - ~~C PAV'T~~ - ~~RIGHT~~ _____ ±18' _____
12.6' TO LT EDGE PAVEMENT
 S.L.M. _____ 400+32 _____

Grid: Northing: 733604.128 Easting: 1631807.814

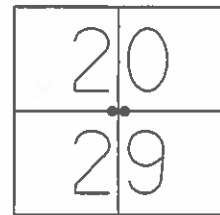

REFA27
 FD IPIN IN
 MON BOX
 NEWREFA27
 FD IPIN
 IN MON BOX
 10/25/16

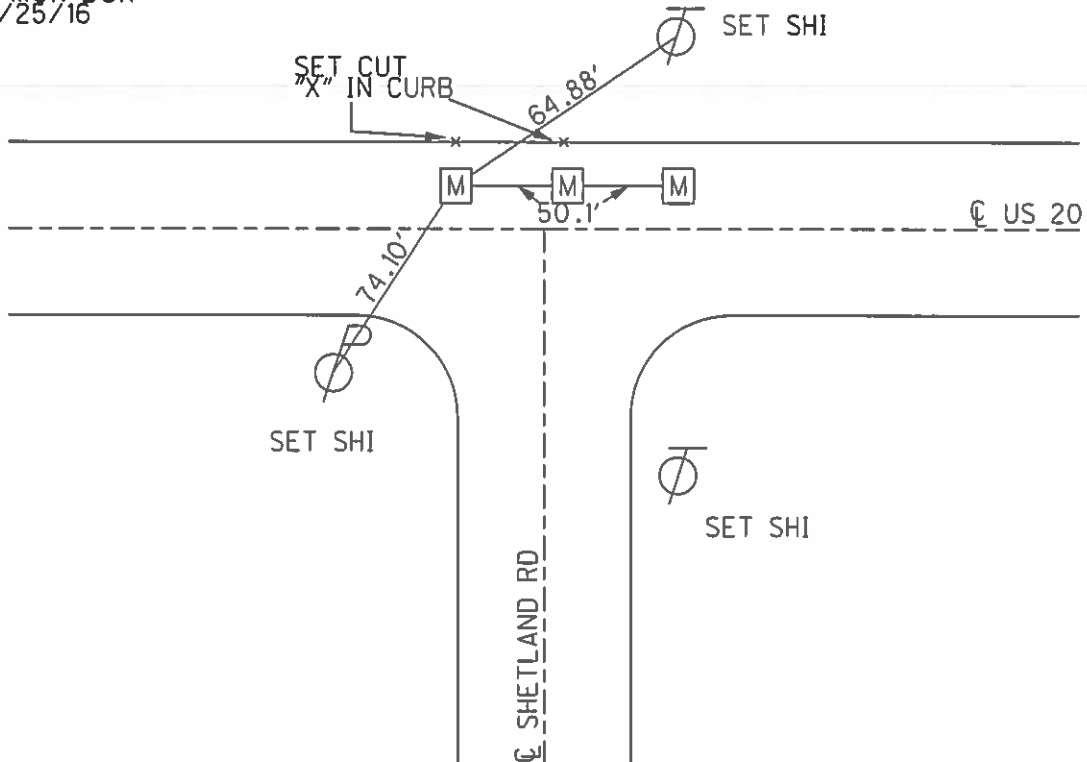

O.D.O.T. DISTRICT 2 SURVEY OFFICE

PERSONNEL

REFERENCE NO. 27

SHEET 4 OF 27

NOTES LOEHRKE

H.C. CANTERBURY

R.C. HELM

DATE 7-7-98

WEATHER FAIR

TEMP. +80°

ROUTE U.S. 20

COUNTY LUCAS

TOWNSHIP SYLVANIA

SECTION 20

T R

TYPE MONUMENT MON BOXES

ON SURFACE - ~~BELOW~~ Yes

LEFT- & PAVT. - ~~RIGHT~~ ± 18'

12.6 TO ± EDGE PAVEMENT

S.L.M. 400+32 & 400+82

20	20
29	29

