


O.D.O.T. DISTRICT 2 SURVEY OFFICE (USE ONLY)


PERSONNEL _____ REFERENCE NO. 27B SHEET 31 OF 36
 NOTES LEU DATE 08/03/16 ROUTE US 20
 H.C. HOMAN WEATHER PARTLY CLOUDY COUNTY LUCAS
 R.C. LEU TEMP. 87° TOWNSHIP SYLVANIA
 _____ SECTION 20
 _____ T 9 S R 6 E

TYPE MONUMENT MON BOXES
 ON SURFACE - ~~BELOW~~ ON
 LEFT - ~~C PAV'T~~ - ~~RIGHT~~ ±18'
12.6' TO LT EDGE PAVEMENT
 S.L.M. 400+82

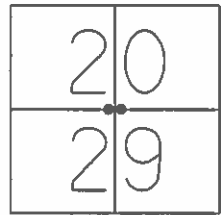

Grid: Northing: 733604.870 Easting: 1631858.014

REFB27
 PD IPIN IN
 MON BOX
 NEWREFB27
 IPIN IN
 MONBOX
 10/25/16

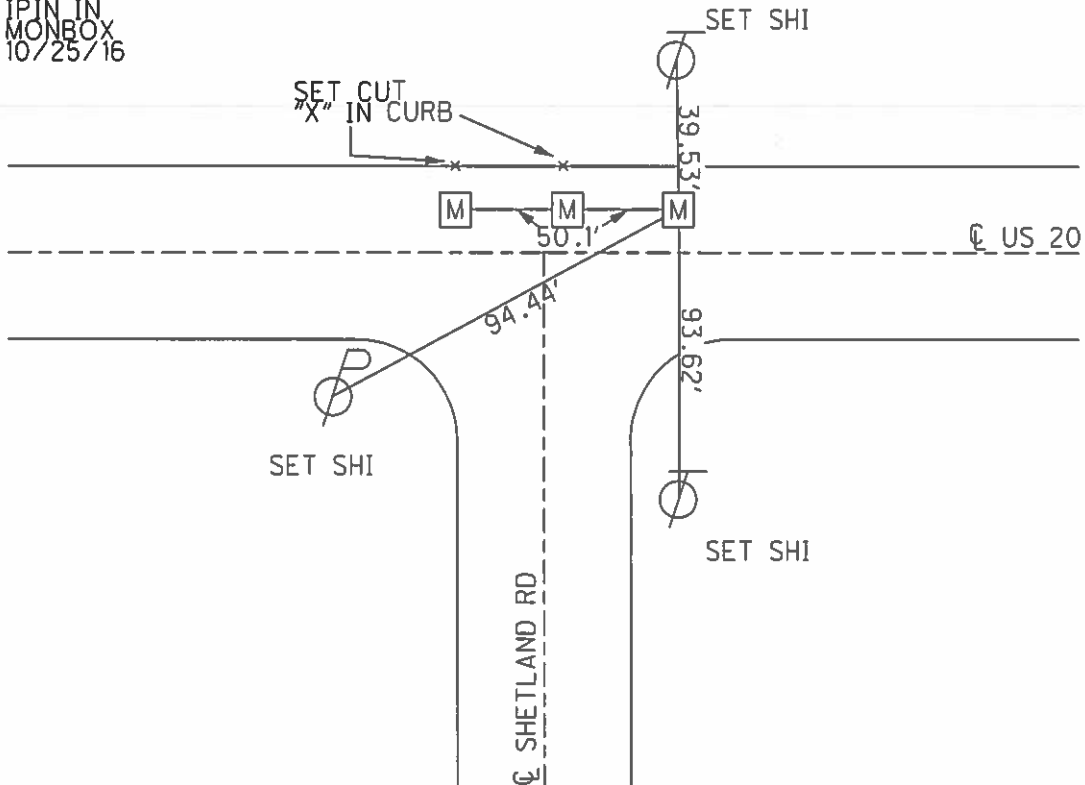

O.D.O.T. DISTRICT 2 SURVEY OFFICE

PERSONNEL

REFERENCE NO. 27

SHEET 4 OF 27

NOTES LOEHRKE

H.C. CANTERBURY

R.C. HELM

DATE 7-7-98

WEATHER FAIR

TEMP. +80°

ROUTE U.S. 20

COUNTY LUCAS

TOWNSHIP SYLVANIA

SECTION 20

T R

TYPE MONUMENT MON BOXES

ON SURFACE - ~~BELOW~~ Yes

LEFT- & PAVT. - ~~RIGHT~~ ± 18'

12.6 TO ± EDGE PAVEMENT

S.L.M. 400+32 & 400+82

| | |
|----|----|
| 20 | 20 |
| 29 | 29 |

