


O.D.O.T. DISTRICT 2 SURVEY OFFICE (USE ONLY)


PERSONNEL	REFERENCE NO.	<u>27 D</u>	SHEET	<u>33</u> OF <u>36</u>	
NOTES	<u>HOMAN</u>	DATE	<u>10/25/16</u>	ROUTE	<u>US 20</u>
H.C.	<u>HOMAN</u>	WEATHER	<u>SUNNY</u>	COUNTY	<u>LUCAS</u>
R.C.	<u>LEU</u>	TEMP.	<u>35°</u>	TOWNSHIP	<u>SYLVANIA</u>
				SECTION	<u>20</u>
				<u>T 9 S</u>	<u>R 6 E</u>

TYPE MONUMENT MON BOX
 ON SURFACE - ~~BELOW~~ ON
 LEFT - ~~C PAV'T~~ - ~~RIGHT~~ ±18'
12.5' TO LT EDGE PAVEMENT
 S.L.M. 405+09

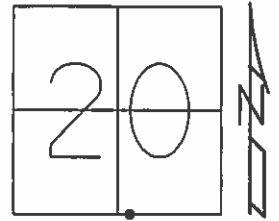

Grid: Northing: 733610.845 Easting: 1632275.342

REFD27
 COULD NOT OPEN
 SHOT CENTER OF
 MON BOX
 REFD27
 IPIN IN
 MONBOX

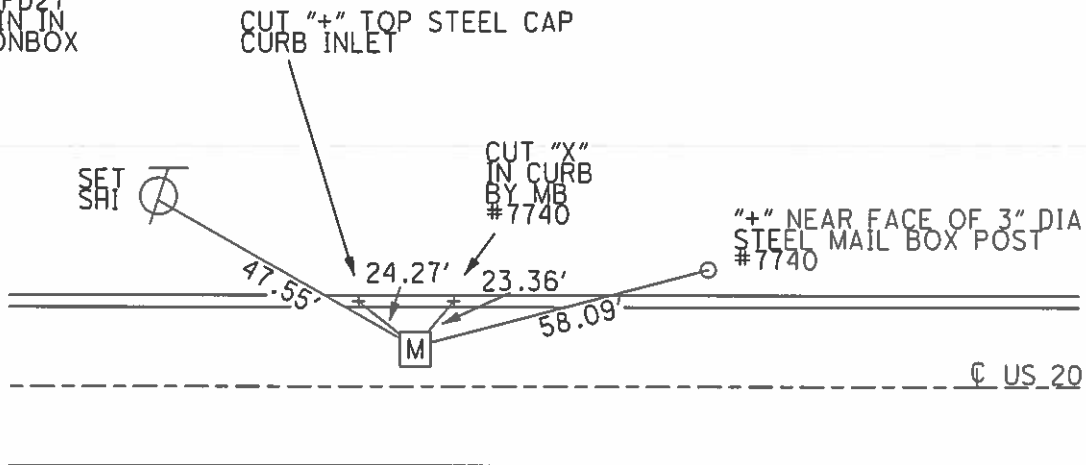

O.D.O.T. DISTRICT 2 SURVEY OFFICE

PERSONNEL

REFERENCE NO. 27B

SHEET 6 OF 27

NOTES LOEHRKE

H.C. CANTERBURY

R.C. HELM

DATE 7-7-98

WEATHER CLOUDY

TEMP. +84

ROUTE U.S. 20

COUNTY LUCAS

TOWNSHIP SYLVANIA

SECTION 20

T R

TYPE MONUMENT MON Box

~~ON~~ SURFACE - BELOW Yes

LEFT - Q PAV'T. - RIGHT ±18'

±13 TO Lt EDGE PAVEMENT

S.L.M. 409+97

