


O.D.O.T. DISTRICT 2 SURVEY OFFICE (USE ONLY)


PERSONNEL _____ REFERENCE NO. 28 SHEET 35 OF 36
 NOTES HOMAN DATE 10/25/16 ROUTE US 20
 H.C. HOMAN WEATHER SUNNY COUNTY LUCAS
 R.C. LEU TEMP. 35° TOWNSHIP SYLVANIA
 _____ SECTION 20
 _____ T 9 S R 6 E

TYPE MONUMENT 2 MON BOXES
 ON SURFACE - ~~BELOW~~ ON
 LEFT - ~~C PAV'T~~ - ~~RIGHT~~ ±18' RT
12.5' TO LT EDGE PAVEMENT
 S.L.M. 415+00

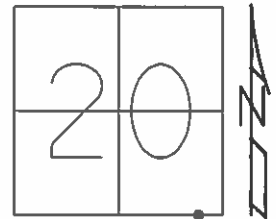

Grid: Northing: 733625.156 Easting: 1633275.322

REFB28
 IRON PIN IN MONBOX
 NEWREFB28
 COULD NOT OPEN
 SHOT CENTER OF
 MONBOX

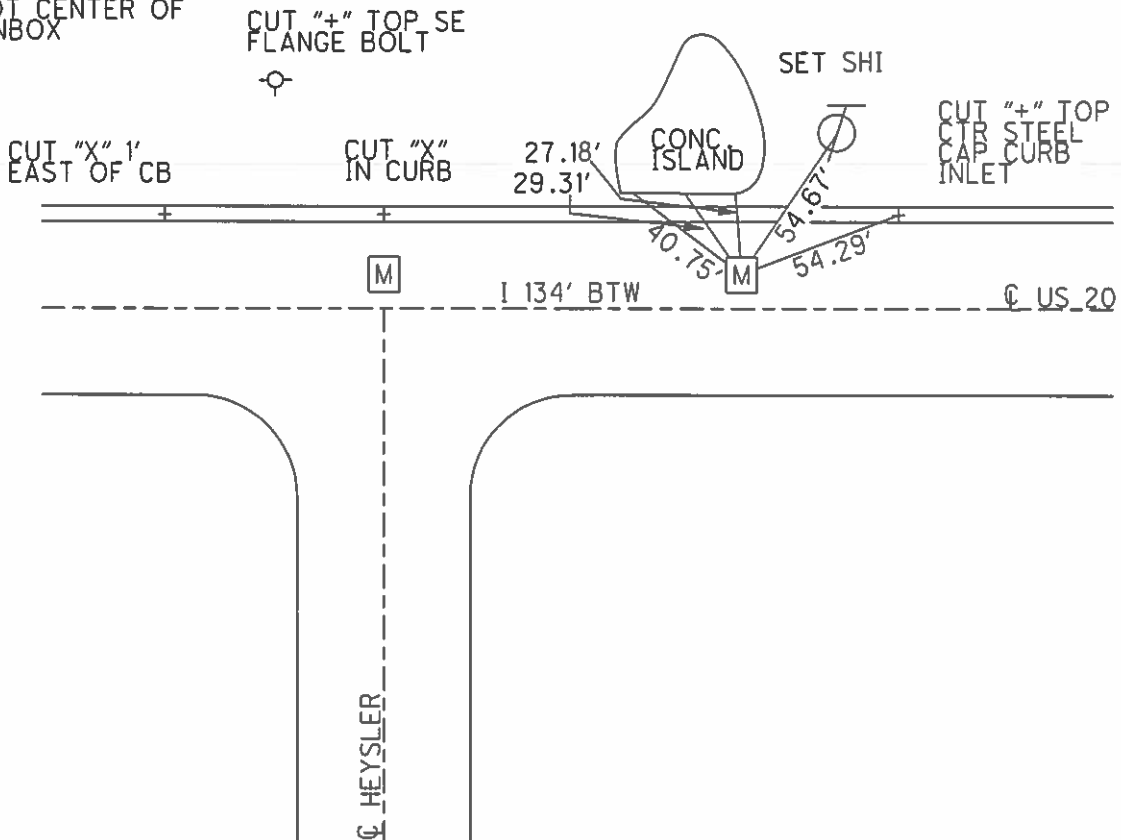

O.D.O.T. DISTRICT 2 SURVEY OFFICE

PERSONNEL

REFERENCE NO. 28

SHEET 7 OF 27

NOTES LOEHRKE

H.C. CANTERBURY

DATE 7-7-98

ROUTE U.S. 20

R.C. HELM

WEATHER Sticky

COUNTY LUCAS

TEMP. +84

TOWNSHIP SYLVANIA

SECTION 20

T R


TYPE MONUMENT 2 Mon Boxes

ON SURFACE - ~~BELOW~~ Yes

LEFT- & PAV'T. - ~~RIGHT~~ ±18' Rt

12.5' TO Lt EDGE PAVEMENT

S.L.M. 413+66 & 415+00

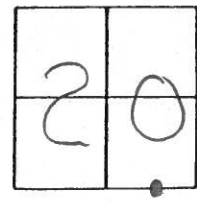

Pt "A" Record Sta 413+65.94

