


O.D.O.T. DISTRICT 2 SURVEY OFFICE (USE ONLY)

PERSONNEL _____ REFERENCE NO. 30 SHEET 6 OF 15
NOTES NUHFER DATE 8/13/07 ROUTE US 20
H.C. HUSS WEATHER HOT COUNTY LUCAS
R.C. MOSER TEMP. 86° TOWNSHIP SYLVANIA
SECTION 21
DWG BY MILLER PID 102808 T 9 N R 6 E


TYPE MONUMENT MONBOX W/ 1" IPIN
ON SURFACE - ~~BELOW~~ ON
OFFSET ☐ PAVEMENT 17.6' LT : ~~RT~~
26' TO LT EDGE PAVEMENT
STATION: 449+15

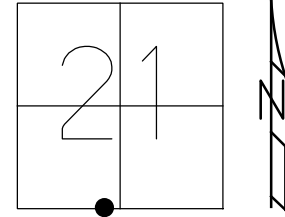

HORIZ.DATUM: NAD83(2011) GEOID: 2012A
GRID: NORTHING: 733548.124 EASTING: 1636687.610

RECORD:
FD MONBOX
W/ 1" IPIN
7-08-98, CAL
FD MONBOX
W/ 1" IPIN
REF30
4-24-18, JFO
RAISED BOX
10-1-18, JFO



AAA AUTO CLUB

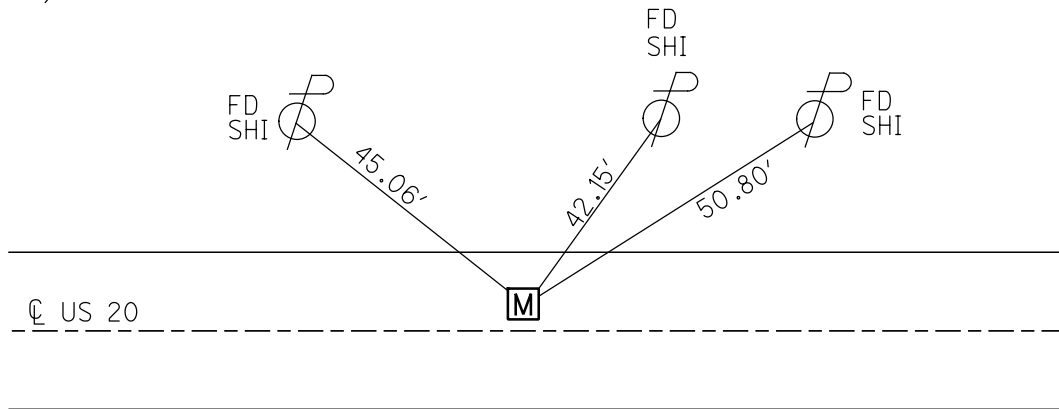

O.D.O.T. DISTRICT 2 SURVEY OFFICE (USE ONLY)

PERSONNEL	REFERENCE NO.	<u>30</u>	SHEET	<u>6</u> OF <u>11</u>
NOTES	DATE	<u>8/13/07</u>	ROUTE	<u>US 20</u>
H.C.	WEATHER	<u>HOT</u>	COUNTY	<u>LUCAS</u>
R.C.	TEMP.	<u>86°</u>	TOWNSHIP	<u>SYLVANIA</u>
			SECTION	<u>21</u>
				<u>T 9 S R 6 E</u>


TYPE MONUMENT 1" IPIN MON. BOX
 ON SURFACE - BELOW ON
 LEFT - \odot PAV'T - RIGHT 17.6'
26' TO LT EDGE PAVEMENT
 S.L.M. 449+15

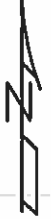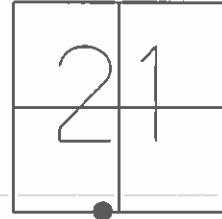

GRID: NORTHING: 733548.19 EASTING: 1636687.43

RECORD:
 FD 1" IPIN MON. BOX
 7/08/98, CAL



AAA AUTO CLUB BUILDING

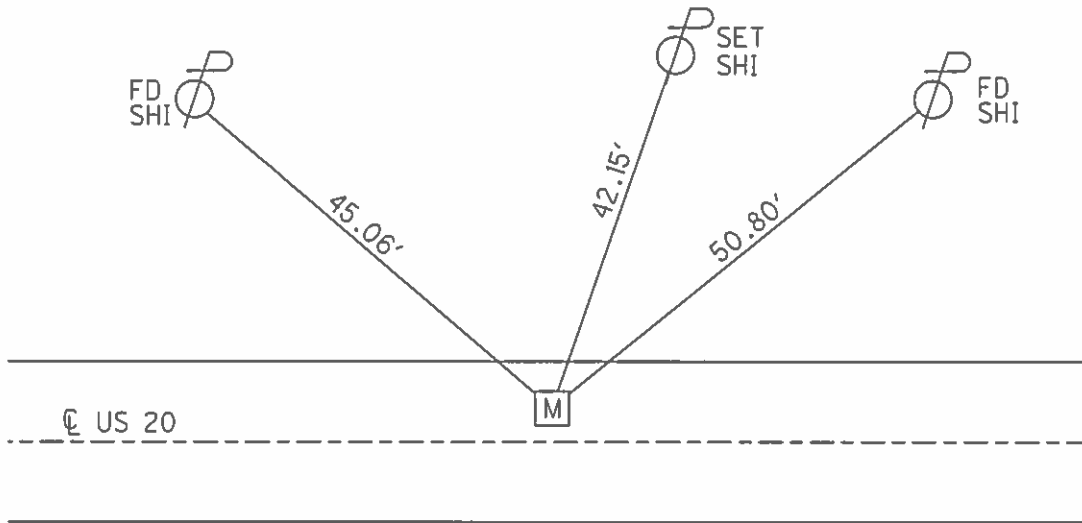

O.D.O.T. DISTRICT 2 SURVEY OFFICE (USE ONLY)


PERSONNEL	REFERENCE NO. <u>30</u>	SHEET <u>6</u> OF <u>11</u>
NOTES <u>NUHFER</u>	DATE <u>08-13-07</u>	ROUTE <u>SR 20</u>
H.C. <u>HUSS</u>	WEATHER <u>HOT</u>	COUNTY <u>LUCAS</u>
R.C. <u>MOSER</u>	TEMP. <u>+86°</u>	TOWNSHIP <u>SYLVANIA</u>
		SECTION <u>21</u>
		T <u>9</u> S R <u>6</u> E

TYPE MONUMENT 1" I.P. MON. BOX
 ON SURFACE - ~~BELOW~~ ON SURFACE
 LEFT - C PAV'T - ~~RIGHT~~ 17.6' LT.
26' TO LT. EDGE PAVEMENT
 S.L.M. 449+15 POSSIBLE PC
 GPS Northing=733548.19 Easting=1636687.43

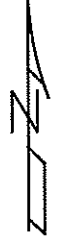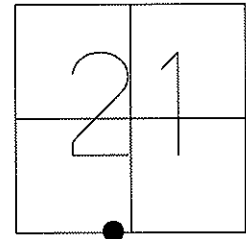

FD. 1" I.P. MON. BOX
 07-08-98 CAL

AAA AUTO CLUB BUILDING

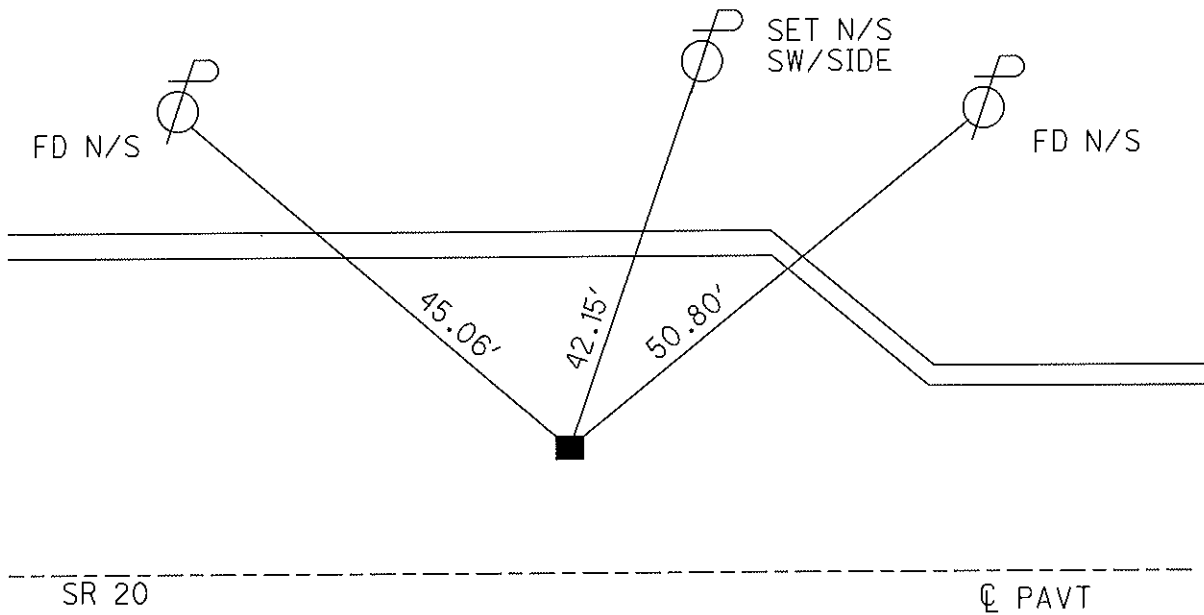

PERSONNEL TITLE PERSONNEL TITLE

COUNTY LUCAS

DATE 4AUG71

D. CURTIS

D. STEVENS

S. R. U.S. 20

WEATHER CLOUDY

SEC.

TEMP. 65°±

DESCRIPTION REFERENCES TO CONTROL POINTS

JOB NO.

LEFT

CENTER LINE

RIGHT

