


PERSONNEL	TITLE	PERSONNEL	TITLE	COUNTY	Lucas	DATE	June 15, 1971
W. Denna				S. R.	20	WEATHER	Sunny-mild
D. Curtis				SEC.		TEMP.	75° ±
R. Branham							
D. Stevens							


DESCRIPTION References To Control Points JOB NO. \_\_\_\_\_

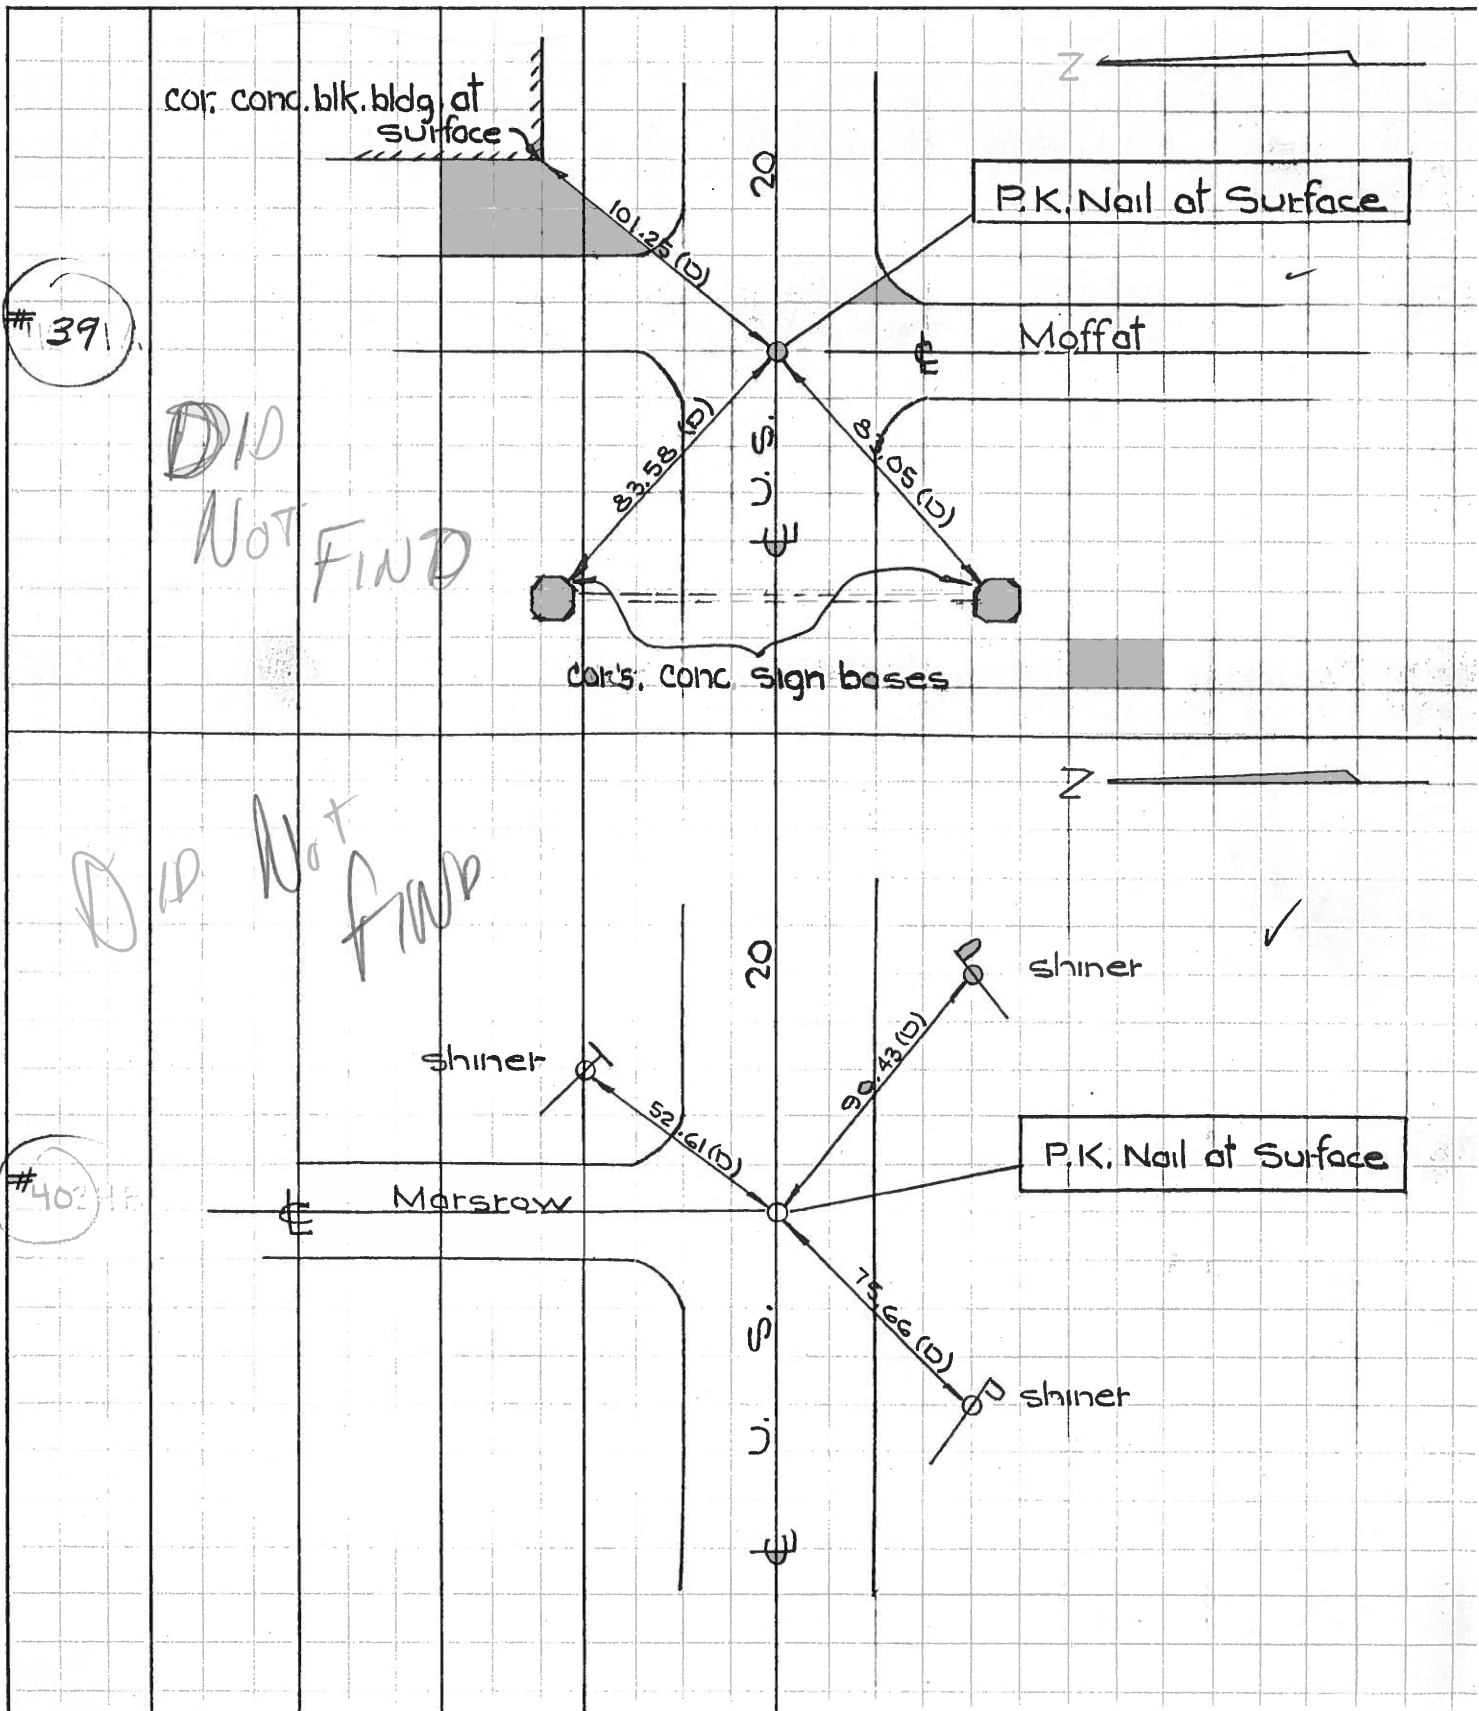

PERSONNEL TITLE PERSONNEL TITLE COUNTY Lucas DATE June 15, 1971  
 W. Denna \_\_\_\_\_  
 D. Curtis \_\_\_\_\_  
 R. Brannan \_\_\_\_\_  
 D. Stevens \_\_\_\_\_  
 S. R. 20 WEATHER Sunny-mild  
 SEC. \_\_\_\_\_ TEMP. 75° ±

DESCRIPTION References To Control Points LEFT CENTER LINE RIGHT JOB NO. \_\_\_\_\_

# 39

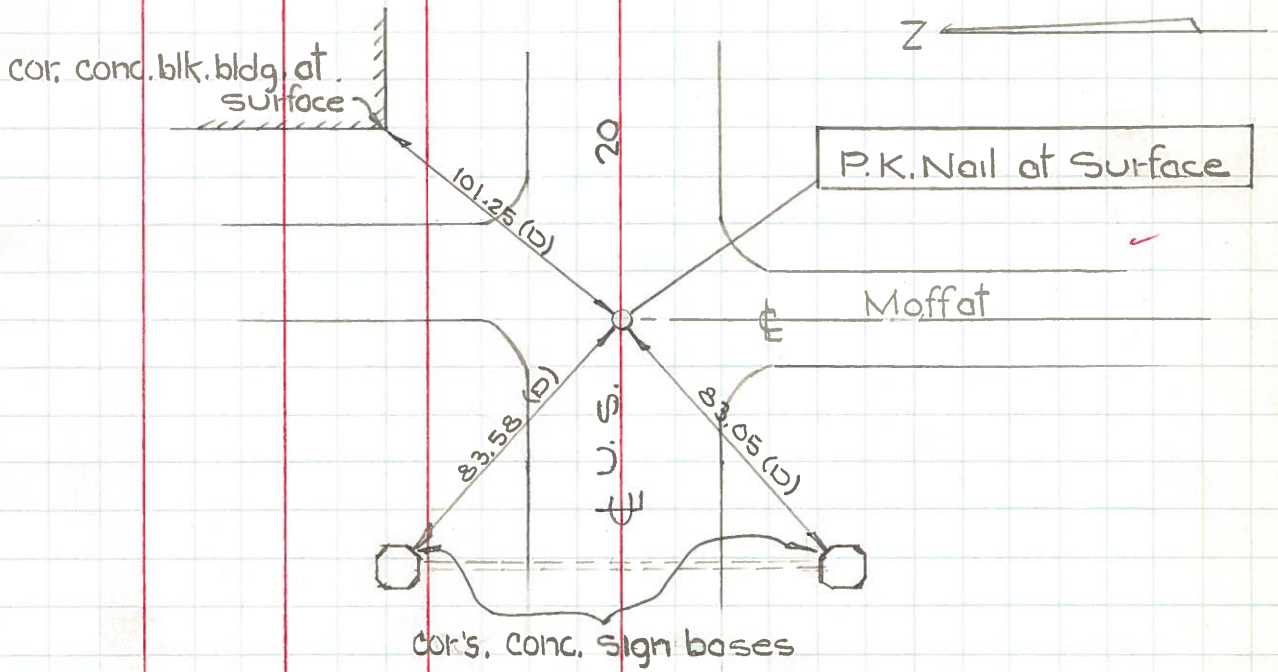

# 40

