

O.D.O.T. DISTRICT 2 SURVEY OFFICE (USE ONLY)

PERSONNEL \_\_\_\_\_ REFERENCE NO. 57 SHEET 11 OF 55  
 NOTES CURTIS DATE 8/10/71 ROUTE US 20  
 H.C. STEVENS WEATHER SUNNY COUNTY LUCAS  
 R.C. BRANNAN TEMP. 80° TOWNSHIP SYLVANIA  
 SECTION 35  
 DWG BY NIESE PID \_\_\_\_\_ T 9 S R 6 E


TYPE MONUMENT P.K. NAIL  
 ON SURFACE - ~~BELOW~~ ON  
 OFFSET  $\text{C}$  PAVEMENT ON LT : RT  
- TO - EDGE PAVEMENT  
 STATION: 626+73

35



HORZ. DATUM: \_\_\_\_\_ GEOID: \_\_\_\_\_  
 GRID: NORTHING: \_\_\_\_\_ EASTING: \_\_\_\_\_


RECORD:  
 FD P.K. NAIL  
 8/10/71, DC

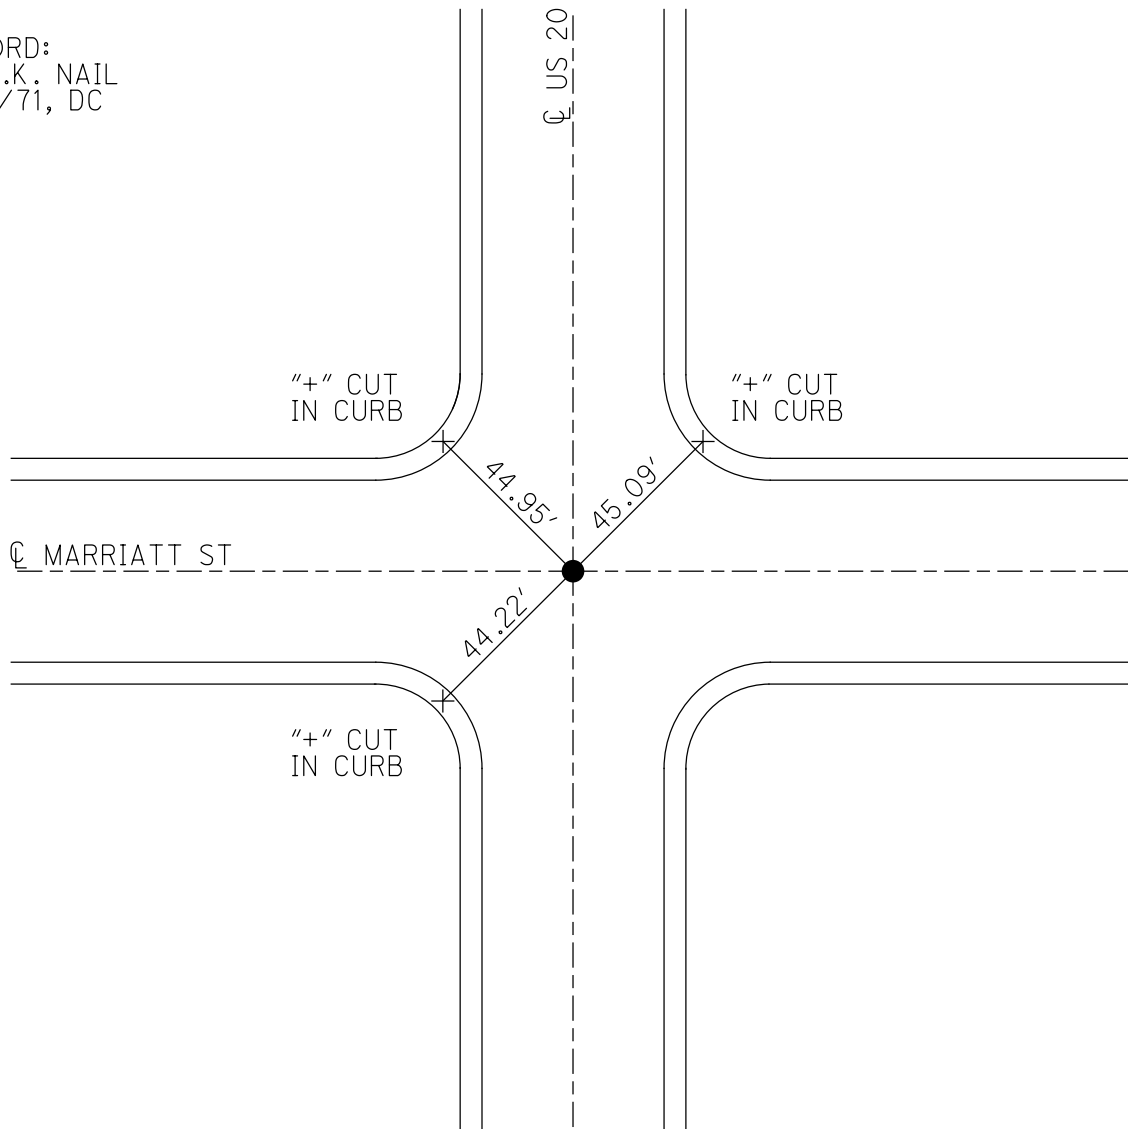

PERSONNEL	TITLE	PERSONNEL	TITLE
D. CURTIS			
D. STEVENS			
R. BRANNAN			

COUNTY LUCAS DATE AUGUST 10, 1971  
 S. R. U.S. 20 WEATHER SUNNY  
 SEC. \_\_\_\_\_ TEMP 80° ±

DESCRIPTION REFERENCES TO CONTROL POINTS JOB NO. \_\_\_\_\_  
 LEFT CENTER LINE RIGHT

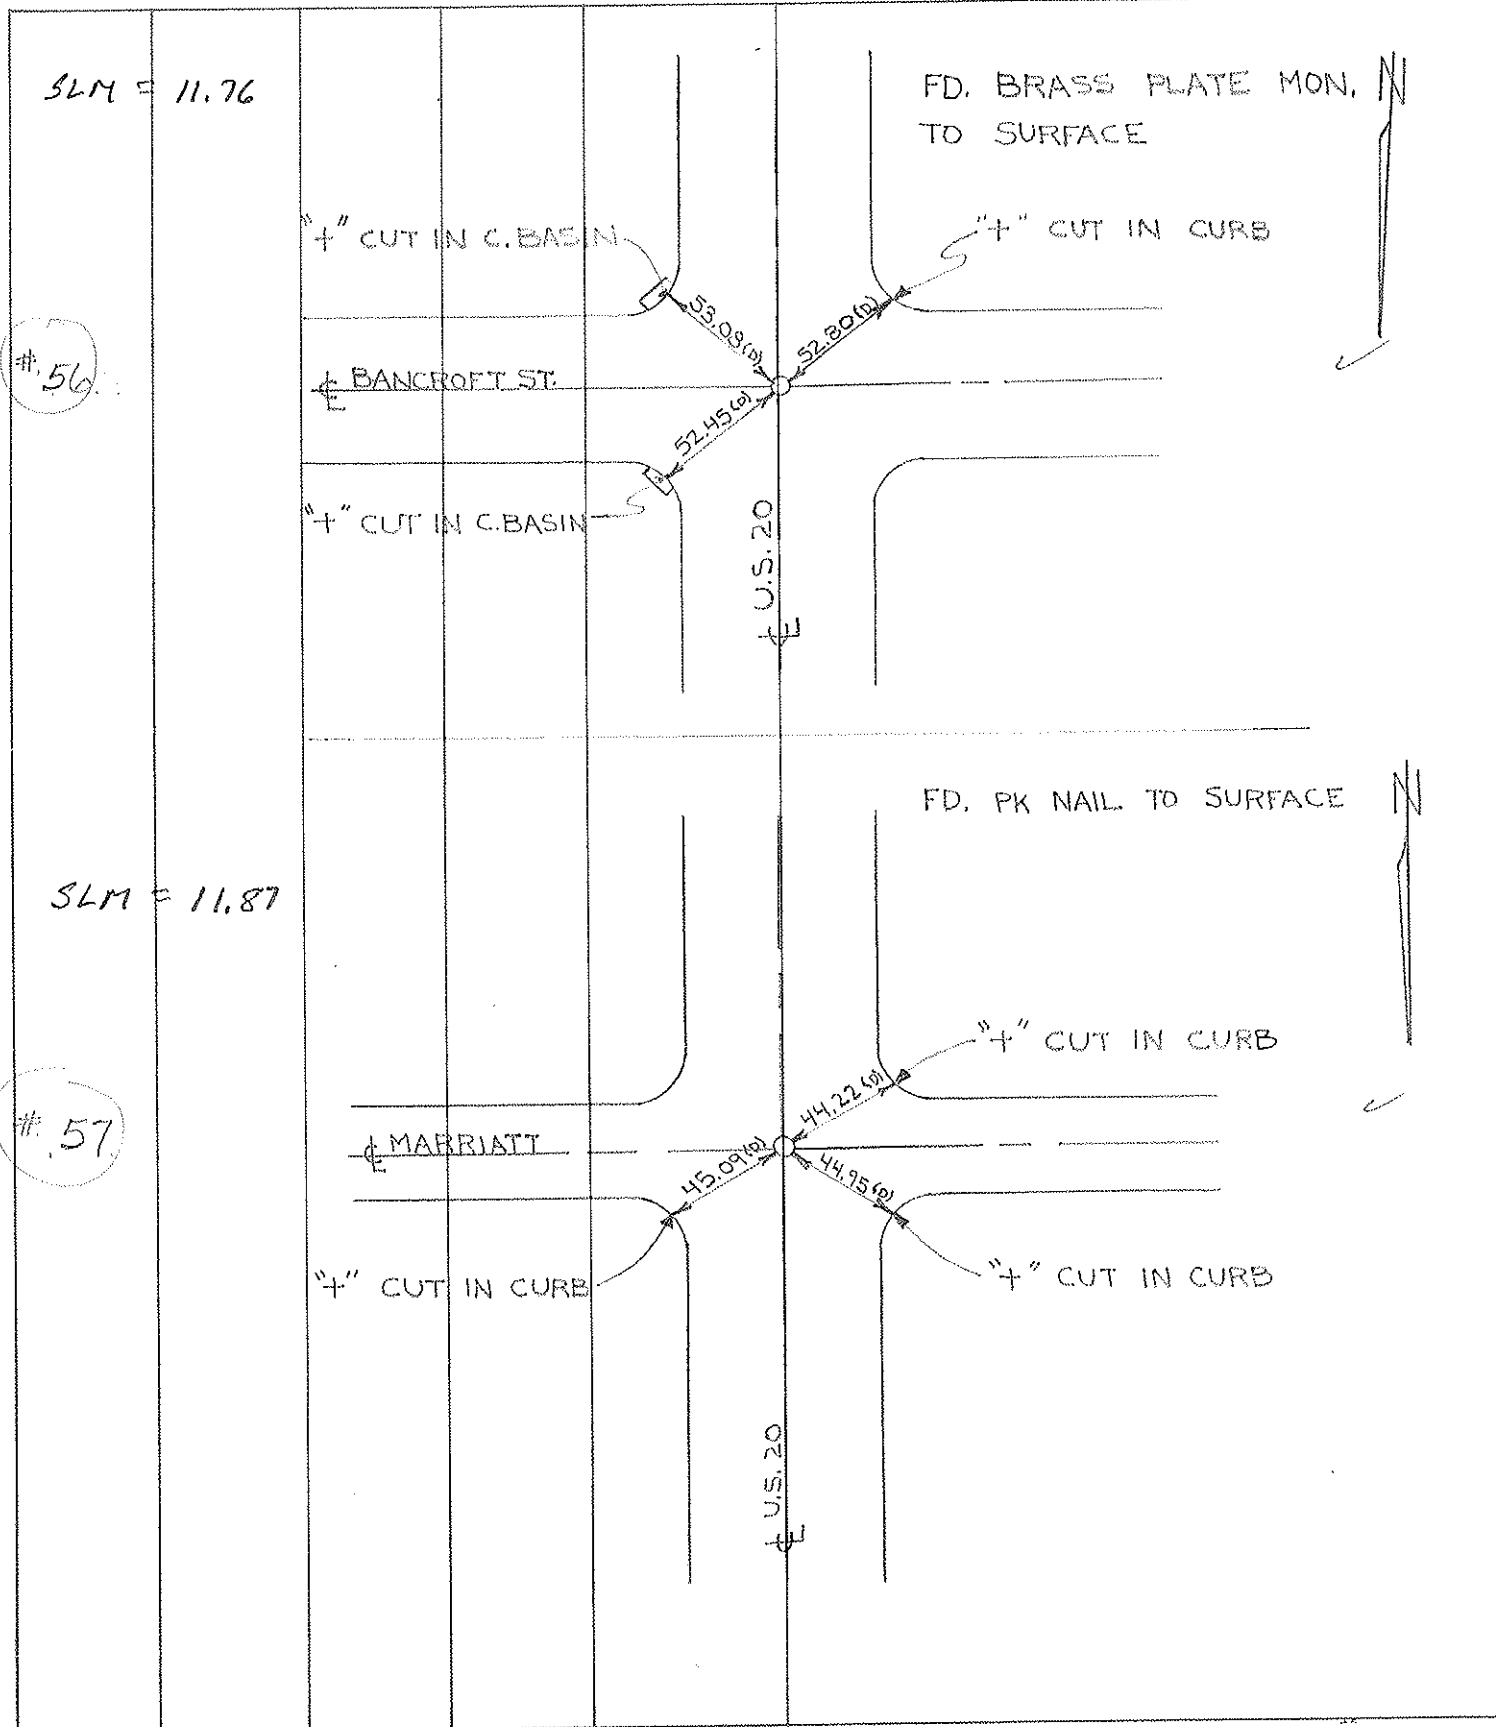

PERSONNEL TITLE PERSONNEL TITLE

COUNTY Lucas DATE May 3, 1966

Denna \_\_\_\_\_

Curtis \_\_\_\_\_

S. R. US 20-23 24-25 bypass WEATHER Sunny

Granata \_\_\_\_\_

Oney \_\_\_\_\_

SEC. \_\_\_\_\_ TEMP. 50°

DESCRIPTION Monumenting Reynolds Road

LEFT CENTER LINE RIGHT JOB NO. \_\_\_\_\_

