

O.D.O.T. DISTRICT 2 SURVEY OFFICE (USE ONLY)

PERSONNEL

REFERENCE NO. 59

SHEET 13 OF 55

NOTES CURTIS DATE 8/10/71

ROUTE US 20

H.C. STEVENS WEATHER SUNNY

COUNTY LUCAS

R.C. BRANNAN TEMP. 80°

TOWNSHIP SYLVANIA

SECTION 35

DWG BY NIESE PID _____

T 9 S R 6 E

TYPE MONUMENT P.K. NAIL


ON SURFACE - ~~BELOW~~ ON

OFFSET ϕ PAVEMENT ON LT : RT

- TO - EDGE PAVEMENT

STATION: 633+07

35

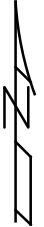


HORIZ.DATUM: _____

GEOID: _____

GRID: NORTHING: _____

EASTING: _____

RECORD:
FD P.K. NAIL
8/10/71, DC

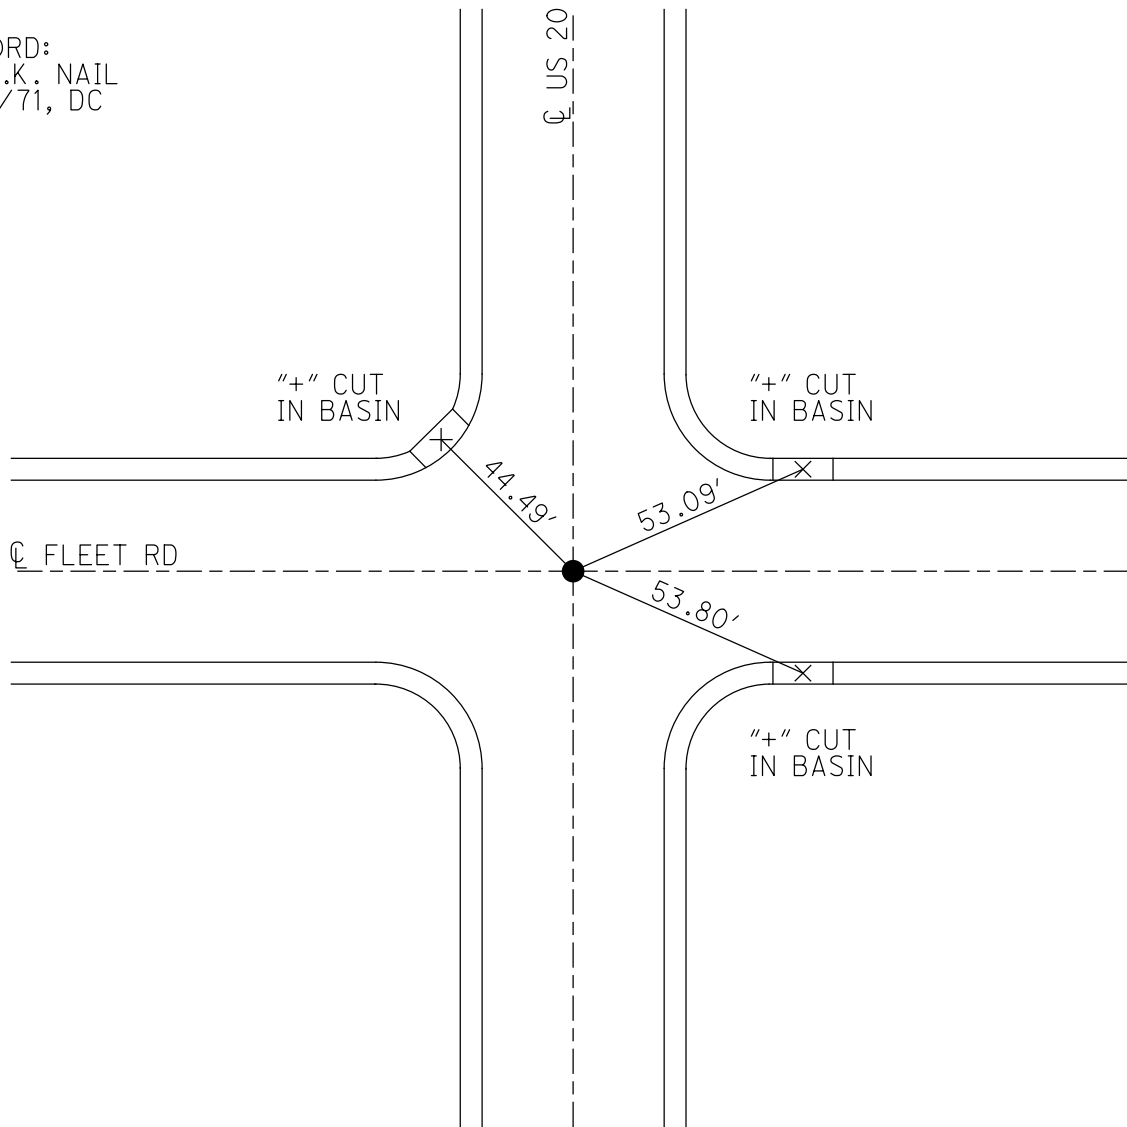

PERSONNEL	TITLE	PERSONNEL	TITLE
D. CURTIS			
D. STEVENS			
R. BRANNAN			

COUNTY LUCAS DATE AUGUST 10, 1971
 S. R. U.S. 20 WEATHER SUNNY
 SEC. _____ TEMP. 80°±

DESCRIPTION REFERENCES TO CONTROL POINTS JOB NO. _____
 LEFT CENTER LINE RIGHT

