

O.D.O.T. DISTRICT 2 SURVEY OFFICE (USE ONLY)

PERSONNEL

REFERENCE NO. 64

SHEET 18 OF 55

NOTES CURTIS DATE 8/11/71  
H.C. STEVENS WEATHER FAIR  
R.C. BRANNAN TEMP. 75°

ROUTE US 20  
COUNTY LUCAS  
TOWNSHIP 12 MILE RESERVE  
SECTION 1  
T 2 US R E

DWG BY NIESE PID \_\_\_\_\_

TYPE MONUMENT P.K. NAIL


ON SURFACE - ~~BELOW~~ ON

OFFSET ☉ PAVEMENT ON LT : RT  
- TO - EDGE PAVEMENT


STATION: 660+52

HORZ.DATUM: \_\_\_\_\_ GEOID: \_\_\_\_\_

GRID: NORTHING: \_\_\_\_\_ EASTING: \_\_\_\_\_

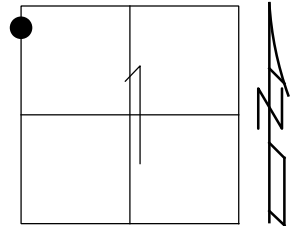

RECORD:  
FD P.K. NAIL  
8/11/71, DC

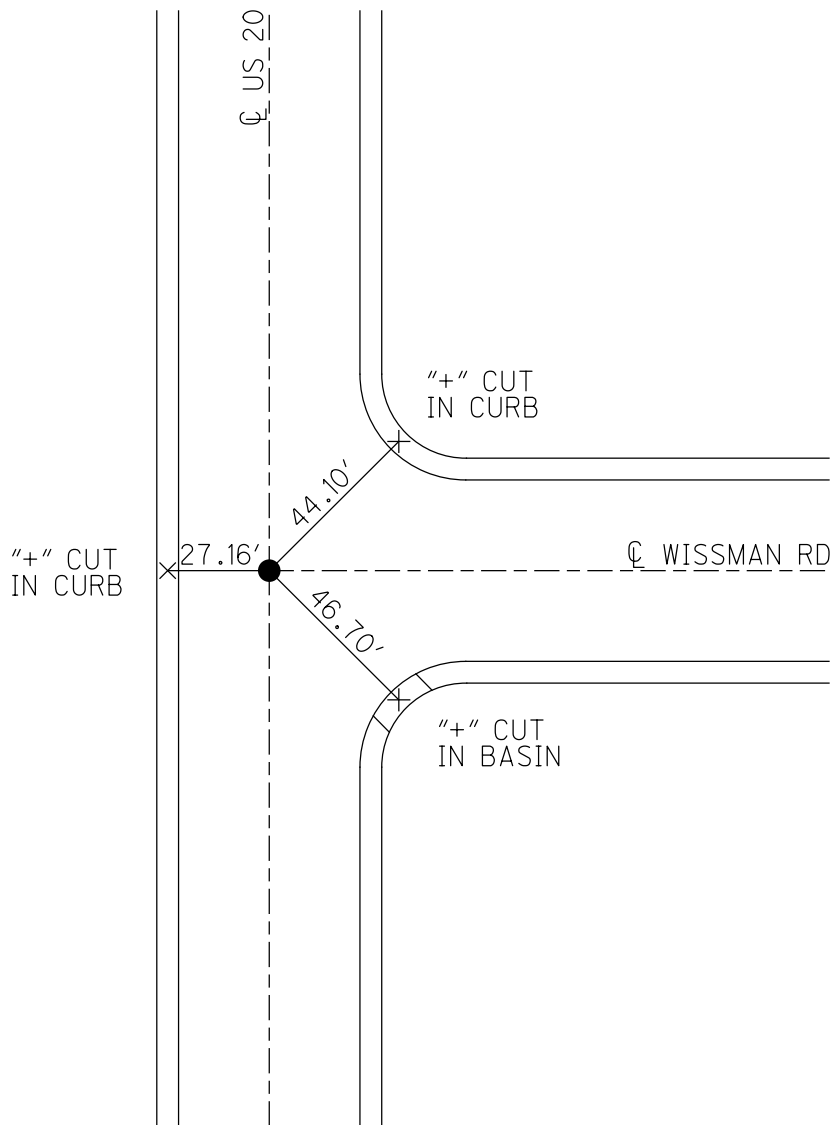

PERSONNEL	TITLE	PERSONNEL	TITLE
D. CURTIS			
D. STEVENS			
R. BRANNAN			

COUNTY LUCAS DATE AUGUST 11, 1971  
 S. R. U.S. 20 WEATHER FAIR  
 SEC. \_\_\_\_\_ TEMP. 75° ±

DESCRIPTION REFERENCES TO CONTROL POINTS JOB NO. \_\_\_\_\_  
 LEFT CENTER LINE RIGHT

