

O.D.O.T. DISTRICT 2 SURVEY OFFICE (USE ONLY)

PERSONNEL _____

REFERENCE NO. 66

SHEET 20 OF 55

NOTES CURTIS DATE 8/11/71
 H.C. STEVENS WEATHER FAIR
 R.C. BRANNAN TEMP. 75°

ROUTE US 20
 COUNTY LUCAS
 TOWNSHIP 12 MILE RESERVE
 SECTION 1
 T 2 US R E

DWG BY NIESE PID _____

TYPE MONUMENT P.K. NAIL

ON SURFACE - ~~BELOW~~ ON

OFFSET ☉ PAVEMENT ON LT : RT

- TO - EDGE PAVEMENT


STATION: 675+84

HORZ. DATUM: _____


GEOID: _____

GRID: NORTHING: _____

EASTING: _____

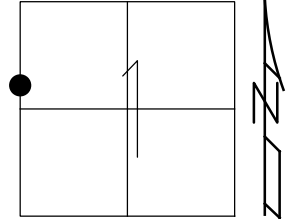

RECORD:
 FD P.K. NAIL
 8/11/71, DC

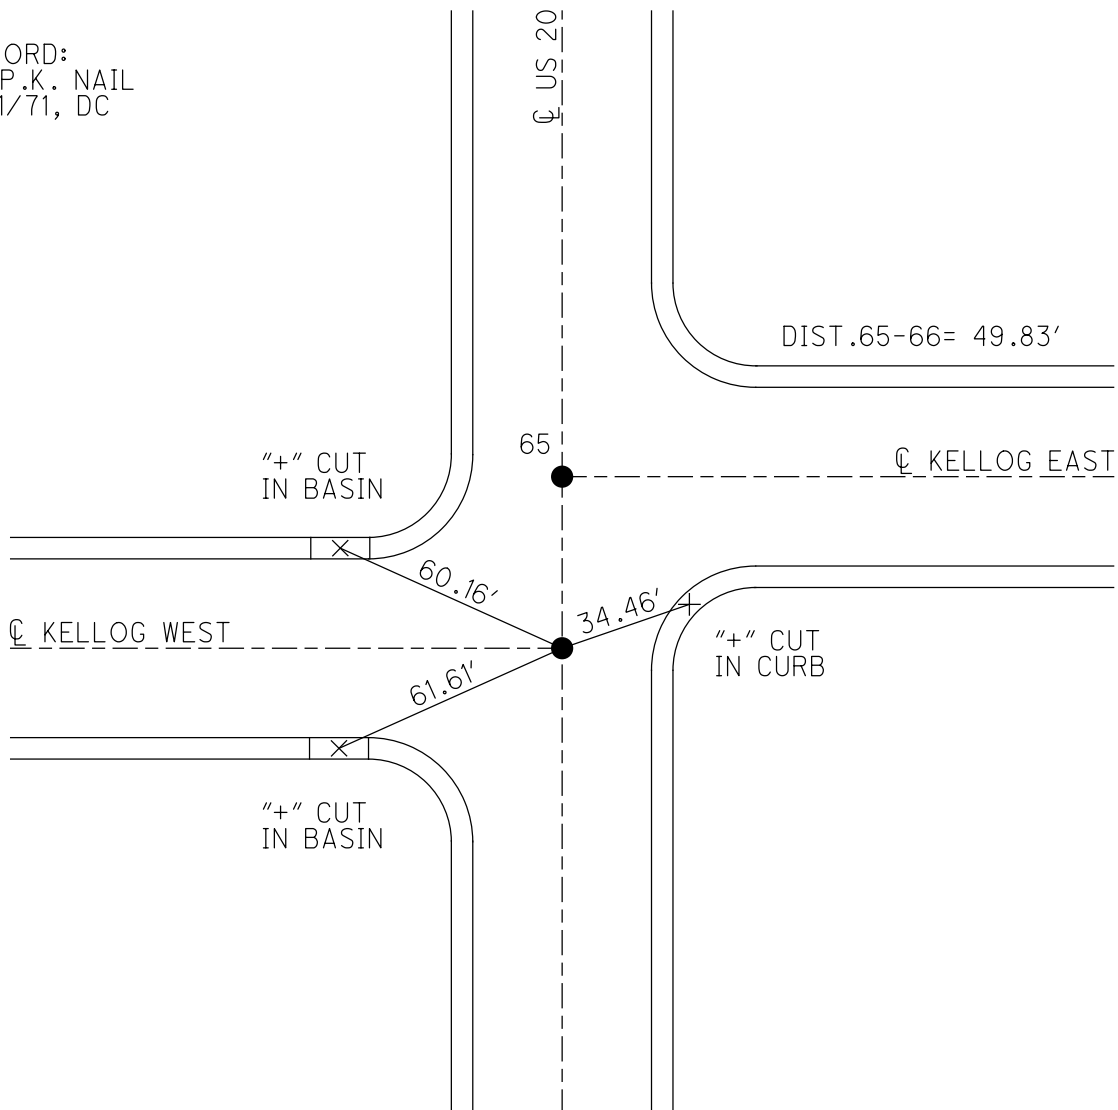

PERSONNEL	TITLE	PERSONNEL	TITLE
D. CURTIS			
D. STEVENS			
R. BRANNAN			

COUNTY LUCAS DATE AUGUST 11, 1971

S. R. U.S. 20 WEATHER FAIR

SEC. _____ TEMP. 75° ±

DESCRIPTION REFERENCES TO CONTROL POINTS JOB NO. _____

LEFT CENTER LINE RIGHT

