

O.D.O.T. DISTRICT 2 SURVEY OFFICE (USE ONLY)

PERSONNEL

REFERENCE NO. 70

SHEET 24 OF 55

NOTES CURTIS DATE 8/12/71

H.C. STEVENS WEATHER SUNNY

R.C. BRANNAN TEMP. 75°

ROUTE US 20

COUNTY LUCAS

TOWNSHIP 12 MILE RESERVE

SECTION 13

DWG BY NIESE PID

T 2 US R E

TYPE MONUMENT R.R. SPIKE

ON SURFACE - ~~BELOW~~ ON

OFFSET ☐ PAVEMENT ON LT : RT

- TO - EDGE PAVEMENT


STATION: 766+65

HORIZ.DATUM:


GEOID:

GRID: NORTHING:

EASTING:

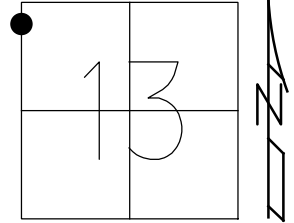

RECORD:
FD R.R. SPIKE
8/12/71, DC

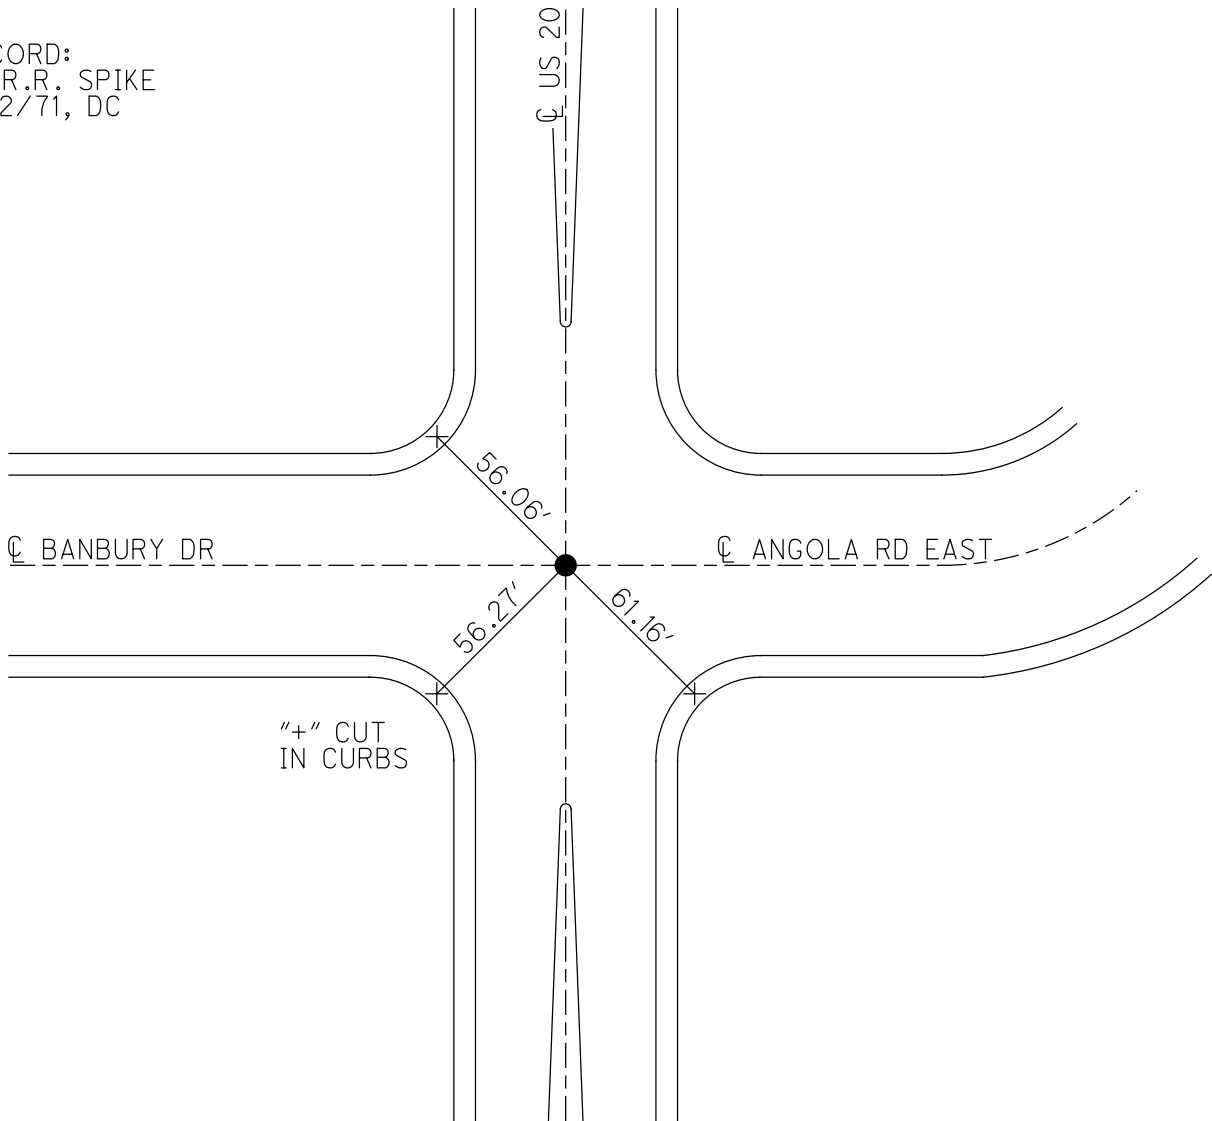

PERSONNEL	TITLE	PERSONNEL	TITLE
D. CURTIS			
D. STEVENS			
R. BRANNAN			

COUNTY LUCAS DATE AUGUST 12, 1971
 S. R. U.S. 20 WEATHER SUNNY
 SEC. _____ TEMP. 75°±

DESCRIPTION REFERENCES TO CONTROL POINTS JOB NO. _____

