


PERSONNEL	TITLE	PERSONNEL	TITLE	COUNTY	DATE
C. KOEHRKE				Lucas	5-28-97
B. CORDES				U.S. 20	WEATHER FAIR
				SEC. 14.94	TEMP. +62

DESCRIPTION TRANSIT TIES - REYNOLDS ROAD Resurf. JOB NO. _____

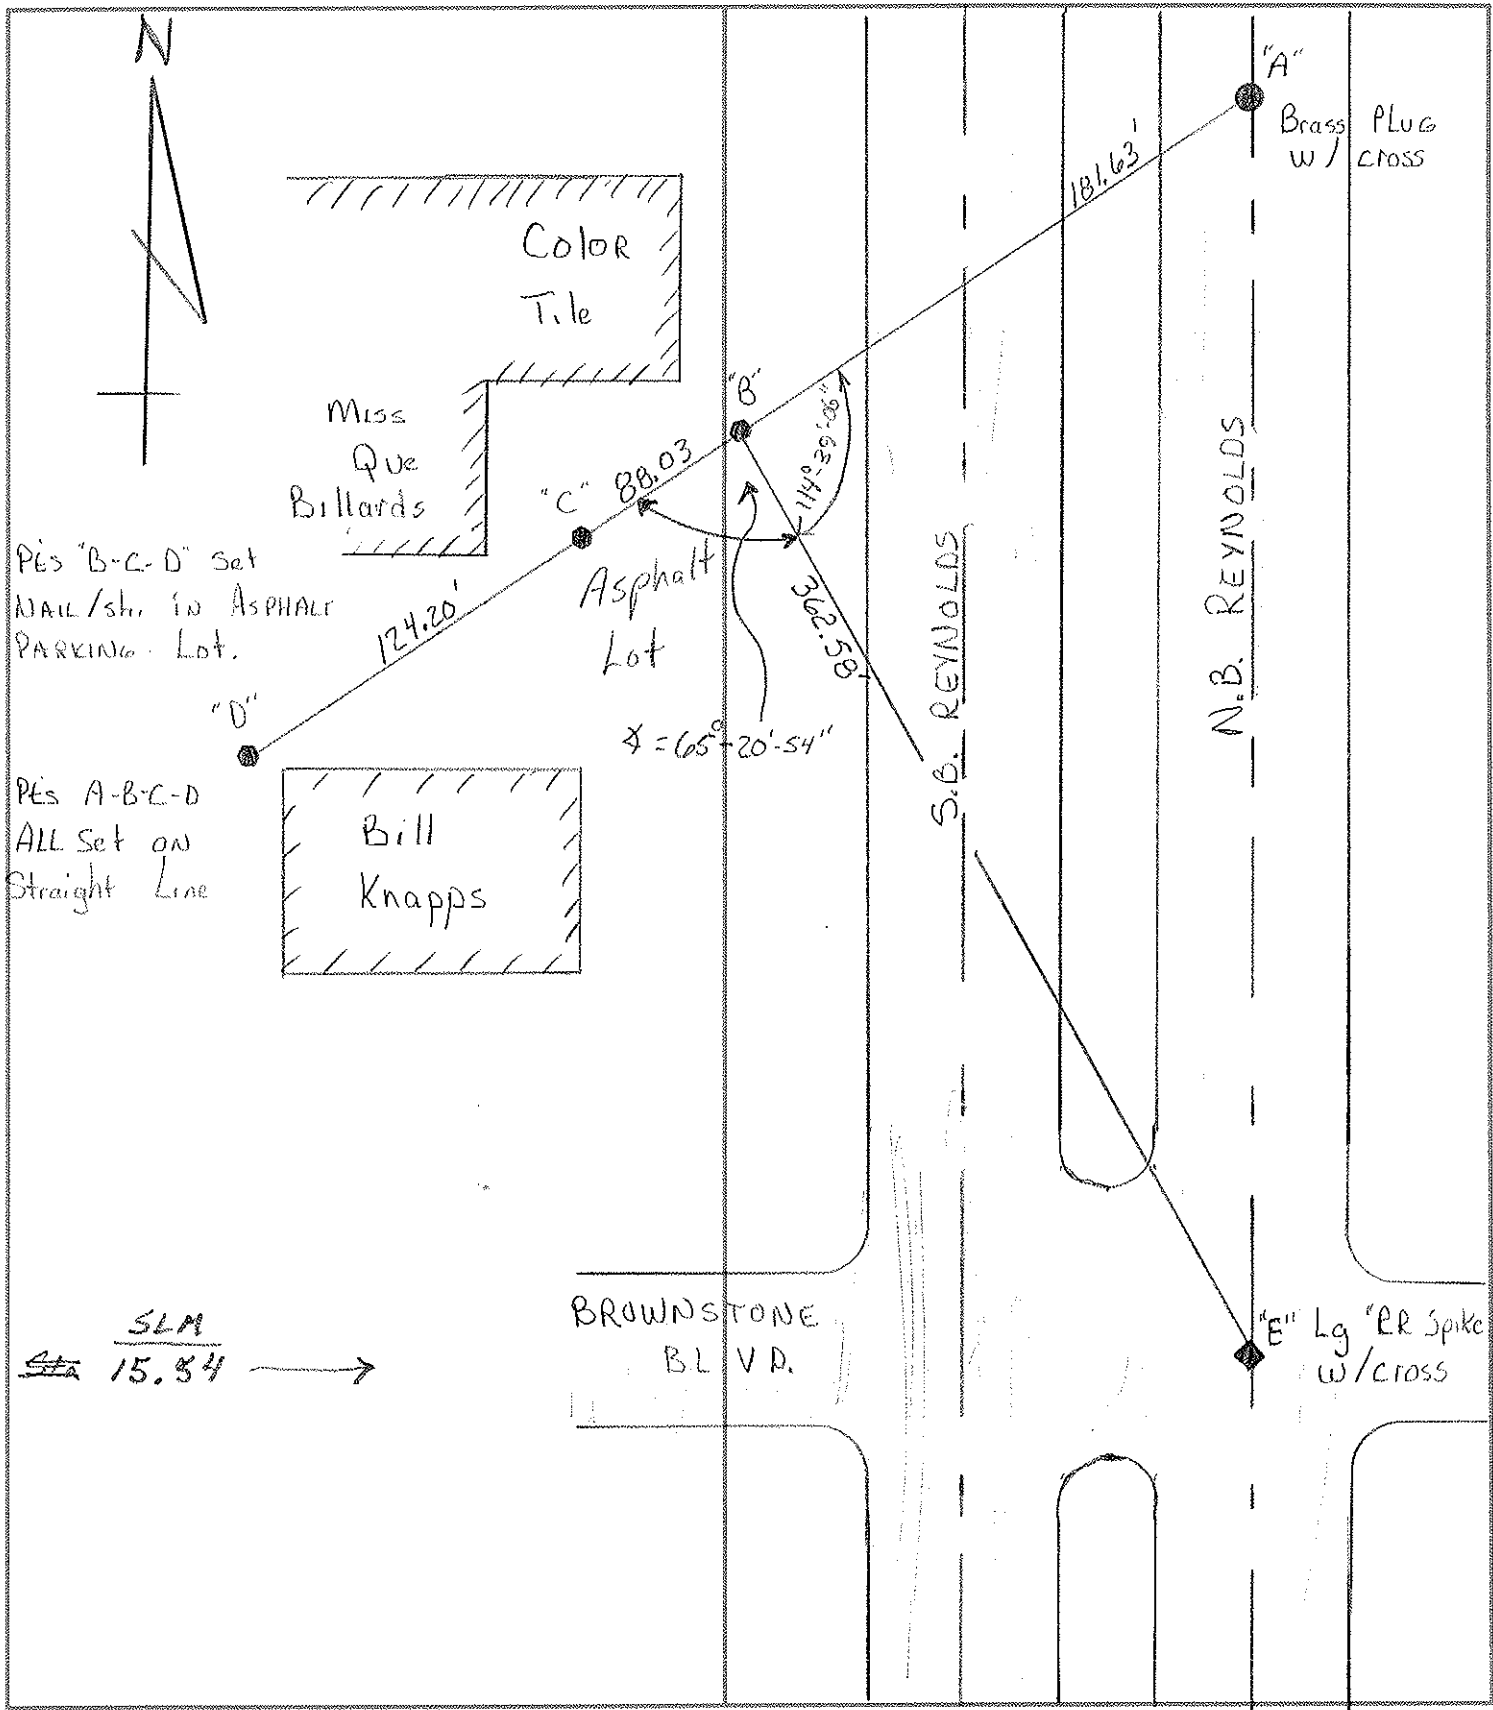

PERSONNEL	TITLE	PERSONNEL	TITLE
D. CURTIS			
D. STEVENS			
R. BRANNAN			

COUNTY LUCAS DATE AUGUST 12, 1971
 S. R. U.S. 20 WEATHER SUNNY
 SEC. _____ TEMP. 75° ±

DESCRIPTION REFERENCES TO CONTROL POINTS JOB NO. _____
LEFT CENTER LINE RIGHT

