

O.D.O.T. DISTRICT 2 SURVEY OFFICE (USE ONLY)

PERSONNEL _____

REFERENCE NO. 80

SHEET 34 OF 55

NOTES CURTIS DATE 8/13/71

ROUTE US 20

H.C. STEVENS WEATHER SUNNY

COUNTY LUCAS

R.C. BRANNAN TEMP. 80°

TOWNSHIP 12 MILE RESERVE

SECTION 24

DWG BY NIESE PID _____

T 2 US R E

TYPE MONUMENT R.R. SPIKE

ON SURFACE - ~~BELOW~~ ON


OFFSET ϕ PAVEMENT ON LT : RT

- TO - EDGE PAVEMENT


STATION: 847+44

HORZ. DATUM: _____ GEOID: _____

GRID: NORTHING: _____ EASTING: _____

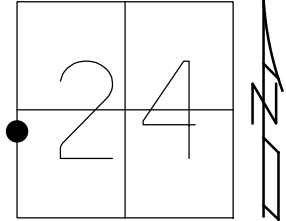

RECORD:
FD R.R. SPIKE
8/13/71, DC

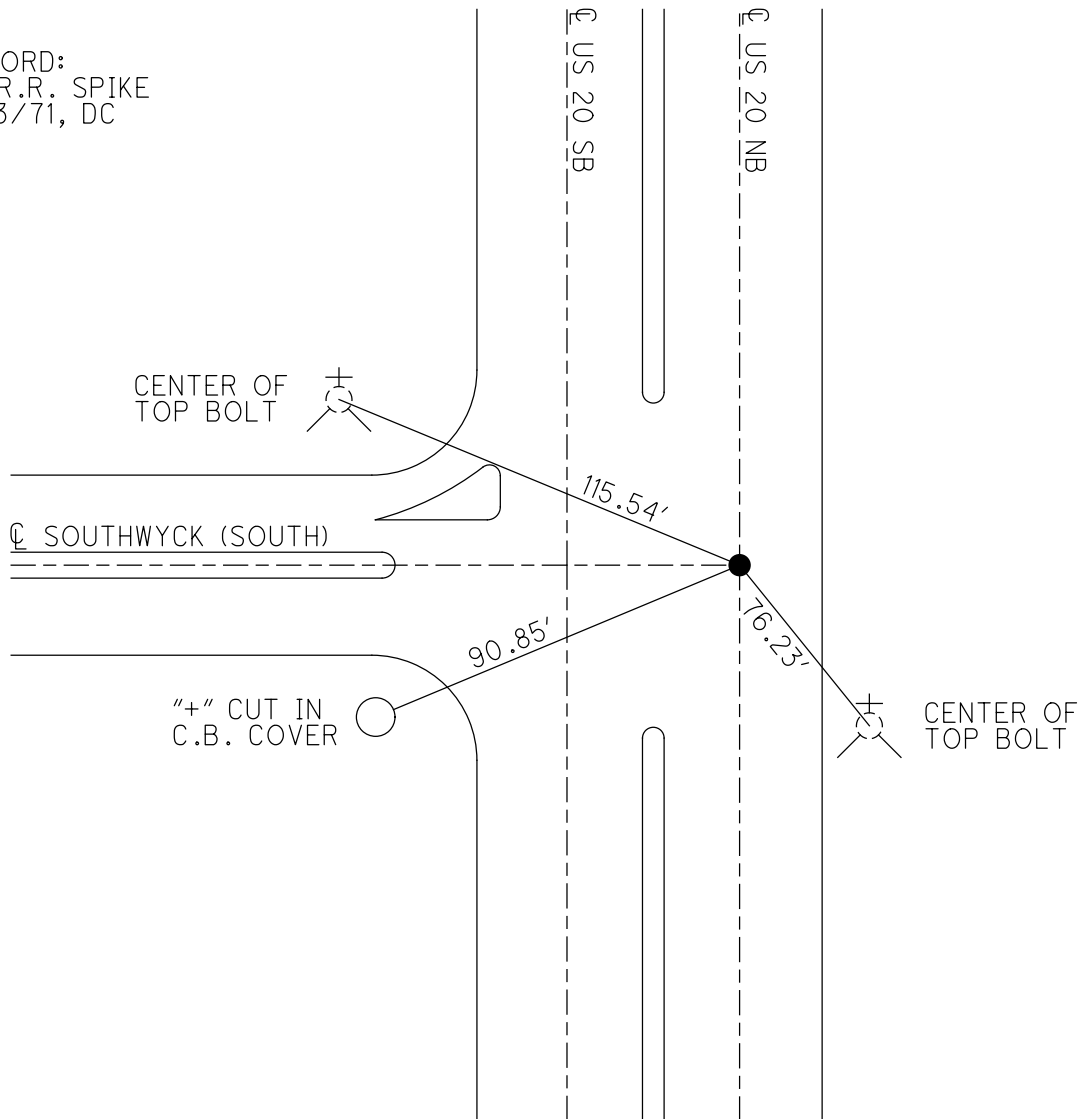

| PERSONNEL | TITLE | PERSONNEL | TITLE |
|------------|-------|-----------|-------|
| D. CURTIS | | | |
| D. STEVENS | | | |
| R. BRANNAN | | | |

COUNTY LUCAS DATE AUGUST 13, 1971
 S. R. U.S. 20 WEATHER SUNNY
 SEC. _____ TEMP. 80°±

DESCRIPTION REFERENCES TO CONTROL POINTS JOB NO. _____
LEFT CENTER LINE RIGHT

