

O.D.O.T. DISTRICT 2 SURVEY OFFICE (USE ONLY)

PERSONNEL

REFERENCE NO. CR 111

SHEET 1 OF 5

NOTES RHOADES

DATE 8/17/20

ROUTE CR 111

H.C. AUBLE

WEATHER SUNNY

COUNTY LUCAS

R.C. RHOADES

TEMP. 79°

TOWNSHIP PROVIDENCE

SECTION 32

DWG BY NIESE

PID 11616

T 6 N R 9 E

TYPE MONUMENT MONBOX W/ 1" IPIN

ON SURFACE - ~~BELOW~~ ON

OFFSET ϕ PAVEMENT _____ LT : RT

_____ TO _____ EDGE PAVEMENT


STATION: 43+04.89

HORZ.DATUM: NAD83(2011)


GEOID: NAVD88 2018

GRID: NORTHING: 647872.683

EASTING: 1597214.309

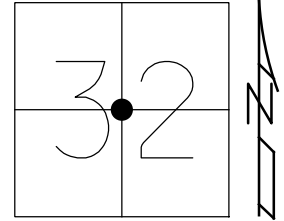

RECORD:
FD MONBOX
W/ 1" IPIN
REFCR111
8/17/20, DSA
CKREFCR111
4/30/21, DSA

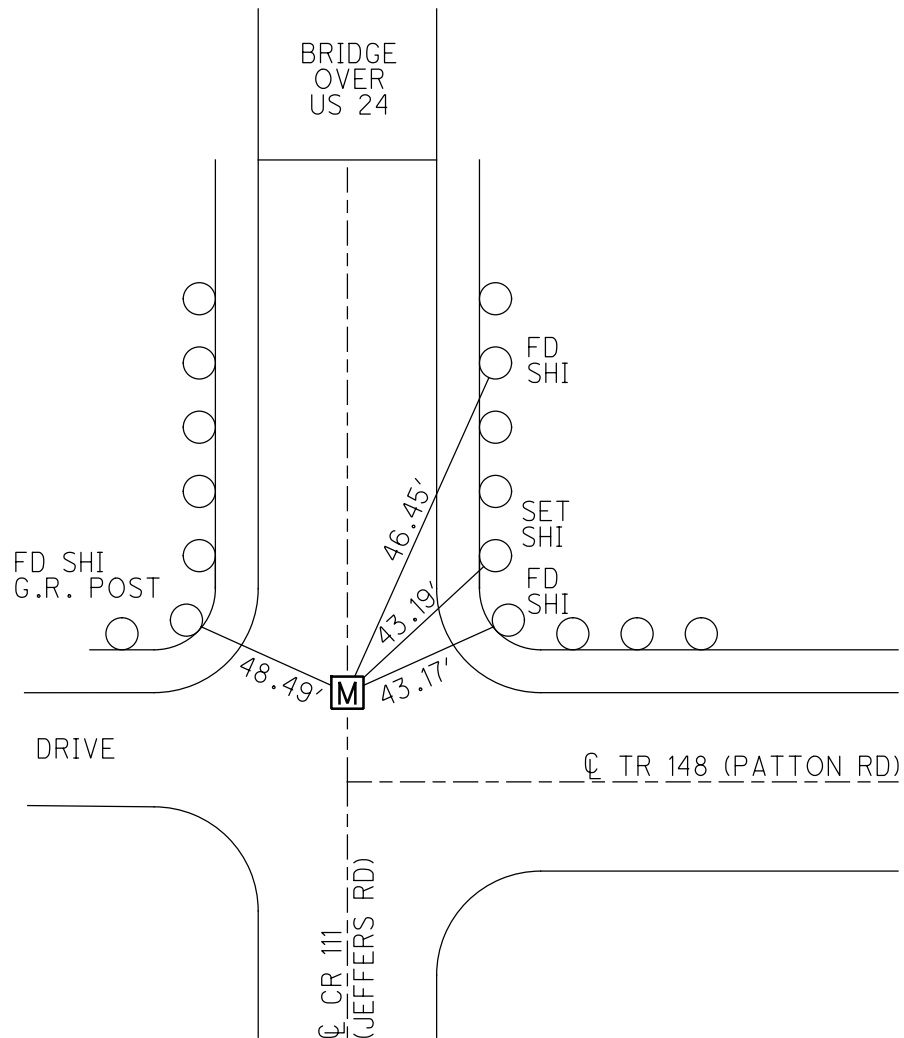

O.D.O.T. DISTRICT 2 SURVEY OFFICE (USE ONLY)

PERSONNEL

REFERENCE NO. CR1361

SHEET 2 OF 5

NOTES RHOADES

DATE 8/18/20

ROUTE CR 136

H.C. AUBLE

WEATHER SUNNY

COUNTY LUCAS

R.C. RHOADES

TEMP. 63°

TOWNSHIP WATERVILLE

DWG BY NIESE

PID 11616

SECTION 12

T 6 N R 9 E

TYPE MONUMENT MONBOX W/ 1" IPIN

ON SURFACE - ~~BELOW~~ ON

OFFSET ϕ PAVEMENT _____ LT : RT

_____ TO _____ EDGE PAVEMENT


STATION: 43+15.04

HORZ. DATUM: NAD83(2011)


GEOID: NAVD88 2018

GRID: NORTHING: 668960.540

EASTING: 1621448.887

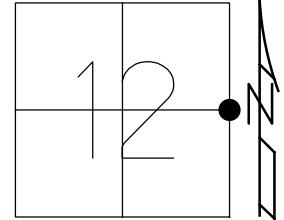

RECORD:
FD MONBOX
W/ 1" IPIN
REFCR1361
8/18/20, DSA

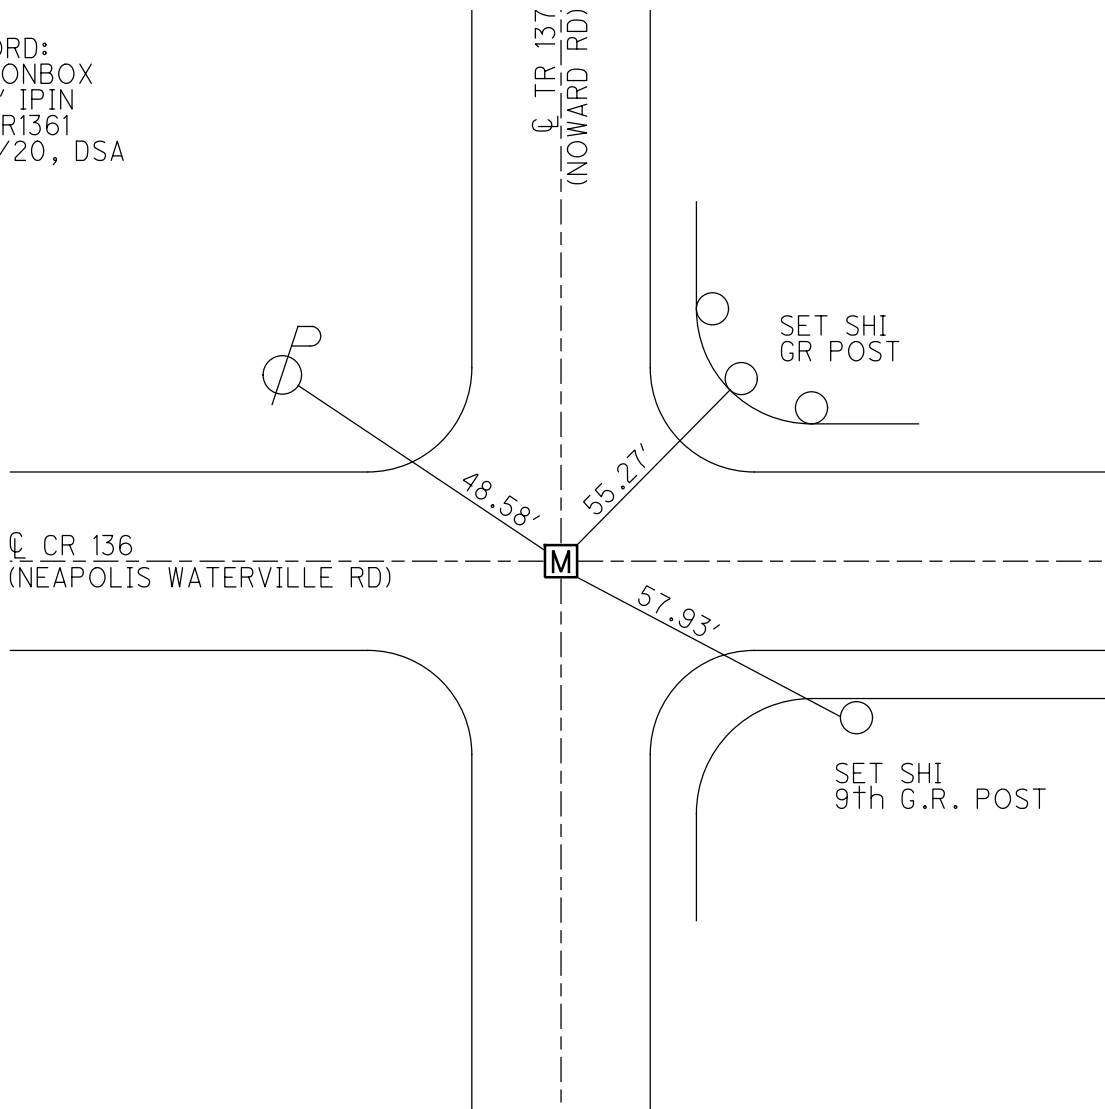

O.D.O.T. DISTRICT 2 SURVEY OFFICE (USE ONLY)

PERSONNEL _____

REFERENCE NO. CR1362

SHEET 3 OF 5

NOTES RHOADES

DATE 8/18/20

ROUTE CR 136

H.C. AUBLE

WEATHER SUNNY

COUNTY LUCAS

R.C. RHOADES

TEMP. 63°

TOWNSHIP WATERVILLE

DWG BY NIESE

PID 11616

SECTION 7

T 6 N R 10 E

TYPE MONUMENT MONBOX W/ 1" IPID

ON SURFACE - ~~BELOW~~ ON

OFFSET C PAVEMENT _____ LT : RT

_____ TO _____ EDGE PAVEMENT


STATION: 48+34.38

HORZ. DATUM: NAD83(2011)


GEOID: NAVD88 2018

GRID: NORTHING: 668991.537

EASTING: 1621972.824

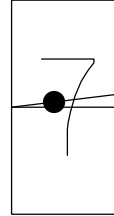

RECORD:
 FD MONBOX
 W/ 1" IPID
 REFCR1362
 8/18/20, DSA
 CKREFCR1362
 4/30/21, DSA

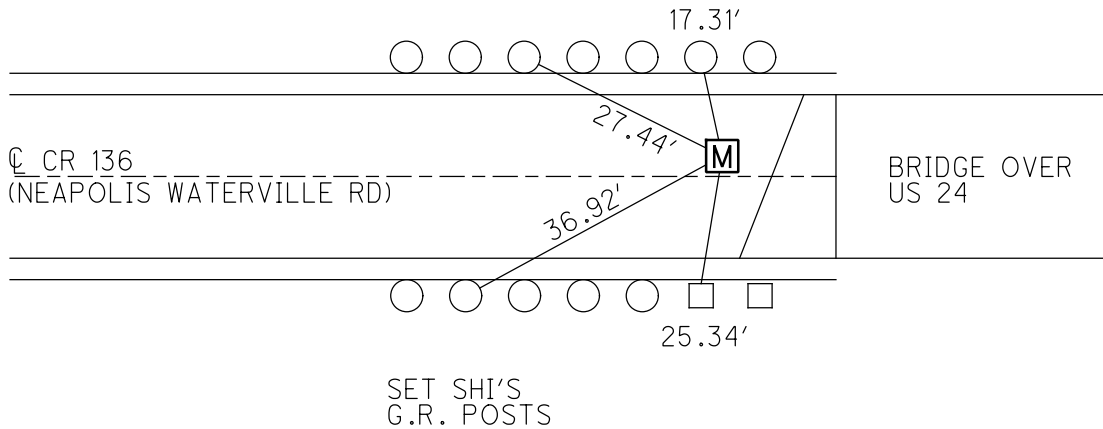

O.D.O.T. DISTRICT 2 SURVEY OFFICE (USE ONLY)

PERSONNEL _____

REFERENCE NO. CR1363

SHEET 4 OF 5

NOTES RHOADES

DATE 8/18/20

ROUTE CR 136

H.C. AUBLE

WEATHER SUNNY

COUNTY LUCAS

R.C. RHOADES

TEMP. 63°

TOWNSHIP WATERVILLE

DWG BY NIESE

PID 11616

SECTION 7

T 6 N R 10 E

TYPE MONUMENT MONBOX W/ 1" IPID

ON SURFACE - ~~BELOW~~ ON

OFFSET 0 PAVEMENT _____ LT : RT

_____ TO _____ EDGE PAVEMENT


STATION: 52+12.01

HORZ.DATUM: NAD83(2011)

GEOID: NAVD88 2018


GRID: NORTHING: 669016.551

EASTING: 1622291.816

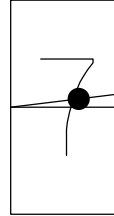

RECORD:
 FD MONBOX
 W/ 1" IPID
 "ODOT C"
 REFCR1363
 8/18/20, DSA
 CKREFCR1363
 4/30/21, DSA

SET SHI'S
 G.R. POSTS

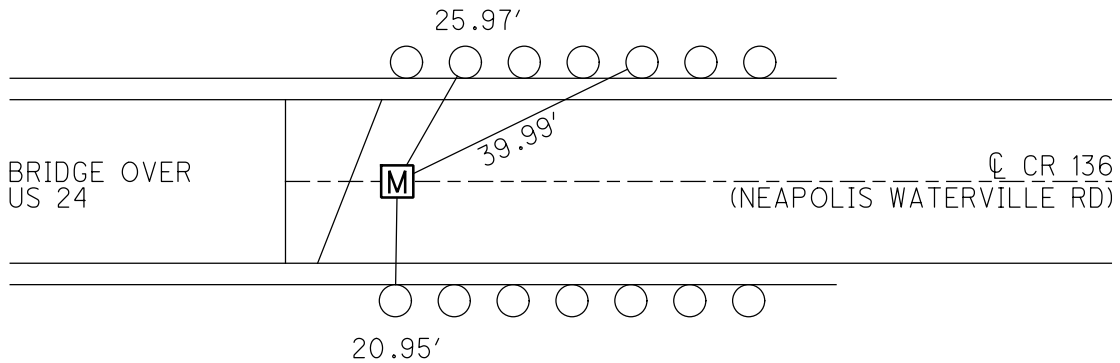

O.D.O.T. DISTRICT 2 SURVEY OFFICE (USE ONLY)

PERSONNEL

REFERENCE NO. CR 1364

SHEET 5 OF 5

NOTES RHOADES

DATE 8/18/20

ROUTE CR 136

H.C. AUBLE

WEATHER SUNNY

COUNTY LUCAS

R.C. RHOADES

TEMP. 63°

TOWNSHIP WATERVILLE

SECTION 7

DWG BY NIESE

PID 11616

T 6 N R 10 E

TYPE MONUMENT MONBOX W/ 1" IPID

ON SURFACE - ~~BELOW~~ ON

OFFSET ☉ PAVEMENT LT : RT

 TO EDGE PAVEMENT


STATION: 53+99.97

HORIZ.DATUM: NAD83(2011)

GEOID: NAVD88 2018

GRID: NORTHING: 669038.620

EASTING: 1622530.825

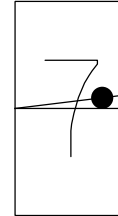

RECORD:
FD MONBOX
W/ 1" IPID
"ODOT ☉"
REFCR1364
8/18/20, DSA

