


PERSONNEL: Slane TITLE: _____ PERSONNEL: _____ TITLE: _____ COUNTY: Locas DATE: 18 Dec. 80

PERSONNEL: Conrad TITLE: _____ PERSONNEL: _____ TITLE: _____ S. R.: US#24 WEATHER: Cool

SEC: 0.00 - 1.11 TEMP: 33°

DESCRIPTION: Part 2 of 2 JOB NO.: 02612

LEFT CENTER LINE RIGHT

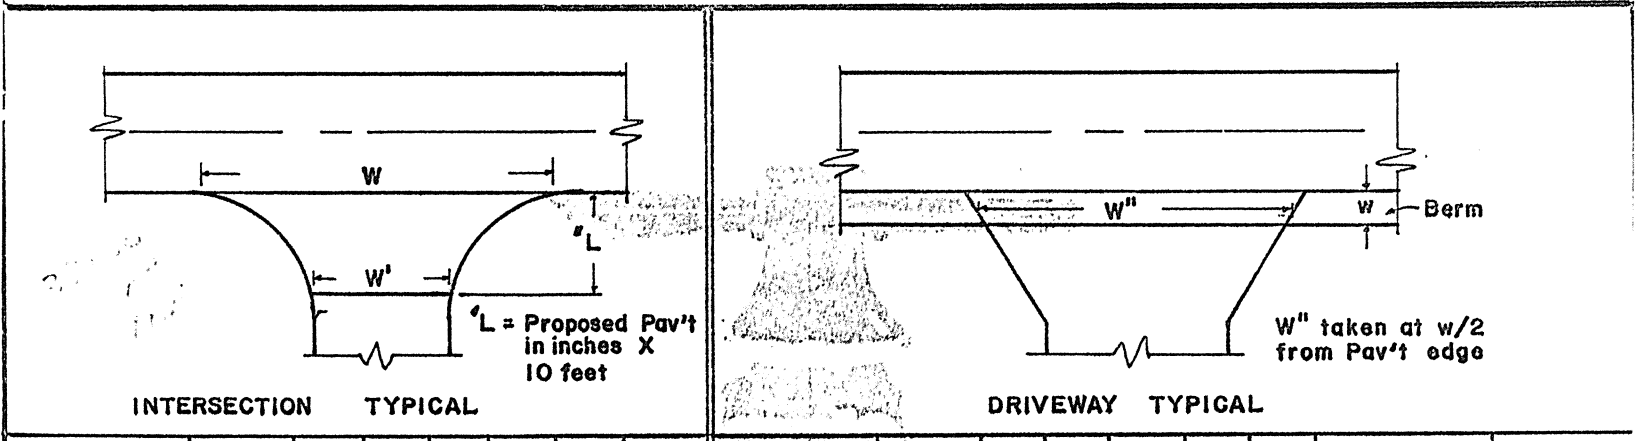

STATION	RT. LT.	L	W	W'	Asph	Conc		STATION	RT. LT.	w	W''	Asph	Conc	Aggr	Dropped Curb Feather NOT Req'd
28+90	Lt	15'	100	57	✓		Prop No. Sicut	2+20	Rt	3	37	✓			
37+70	Lt	15'	100	54	✓		Ludwig	2+70	Rt	3	34	✓			
								4+10	Rt	3	37	✓			
								5+85	Rt	3	36	✓			
								7+00	Rt	3	37	✓			
								9+80	Rt	3	38	✓			
								11+25	Rt	3	34	✓			
								13+85	Rt	3	34	✓			
								14+05	Rt	3	24	✓			
								14+10	Lt	3	40	✓			
								14+55	Lt	3	39	✓			
								16+50	Rt	3	38	✓			
								17+50	Rt	3	36	✓			
								19+90	Rt	3	30	✓			
								20+85	Rt	3	38	✓			
								23+10	Lt	3	36	✓			
								27+10	Rt	3	42	✓			
								27+30	Lt	3	56	✓			
								28+20	Rt	3	39	✓			
								29+05	Rt	3	39	✓			
								31+80	Rt	3	54	✓			
								33+85	Lt	3	16	✓			
								35+15	Lt	3	76	✓			
								36+20	Lt	3	75	✓			

PERSONNEL	TITLE	PERSONNEL	TITLE
Stacy			
E			
Crew			

SHEET NO. 1

COUNTY Lucas DATE 18 Dec. 80

S. R. US # 24 WEATHER Cool

SEC. 0.00 - 1.11 TEMP. 33°

DESCRIPTION Extra Pavement Part 2 of 2 JOB NO. 026112

