

01 T (D-2)

Notes to: B. Rosecrance 2-21-92
1992 TWO-LANE RESURFACING PROGRAM105
SHEET 1 OF 3

PRIORITY NO. 34 16 PART 2 OF 2
 COUNTY Lucas ROUTE US 24 SECTION 0.00
 BEGIN LOG (SLM) 0.00 TERMINII Henry County Line
 END LOG (SLM) 1.11 TERMINII Const joint near SR ~~500~~ 578
 TOTAL LENGTH 1.11 MILES MEASURED 60+06

MUNICIPALITY _____ BEGIN LOG (SLM) _____ END LOG (SLM) _____

MUNICIPALITY _____ BEGIN LOG (SLM) _____ END LOG (SLM) _____

PROPOSED WORK:

PAVEMENT 1 3/4" 402 1 1/4" 404 SHOULDER SAME, 607OTHER Grind full width part @ rutted portion (around cure) estimate length
2" deep 3' Rt

EXISTING DATA:

SLM	TO	PAV'T WIDTH	(type)	SHLD WIDTH	(type)
<u>0+50⁺</u>		<u>24'</u>	<u>Asp</u>	<u>3' 6"</u>	<u>PAVED</u>
<u>60+06</u>		<u>24'</u>	<u>Asp</u>	<u>3' 3"</u>	<u>PAVED</u>
SLM	TO	PAV'T WIDTH	(type)	SHLD WIDTH	(type)
SLM	TO	PAV'T WIDTH	(type)	SHLD WIDTH	(type)
STRUCTURES:

STR. NO. NONE, WIDTH _____, LENGTH _____, PROP. WORK _____
 STR. NO. _____, WIDTH _____, LENGTH _____, PROP. WORK _____
 STR. NO. _____, WIDTH _____, LENGTH _____, PROP. WORK _____

RAILROAD CROSSING:

(no work)
 NAME NONE STATION _____ NO. TRACKS _____ LENGTH ALONG C L _____ ft
 NAME _____ STATION _____ NO. TRACKS _____ LENGTH ALONG C L _____ ft
 NAME _____ STATION _____ NO. TRACKS _____ LENGTH ALONG C L _____ ft

MISCELLANEOUS:

NO. RAISED PAVEMENT MARKERS; EDGE OF PAVEMENT 81 TOTAL, CENTERLINE _____
 NO. MAILBOX APPROACHES 0, MAILBOX SUPPORTS 0

REMARKS:

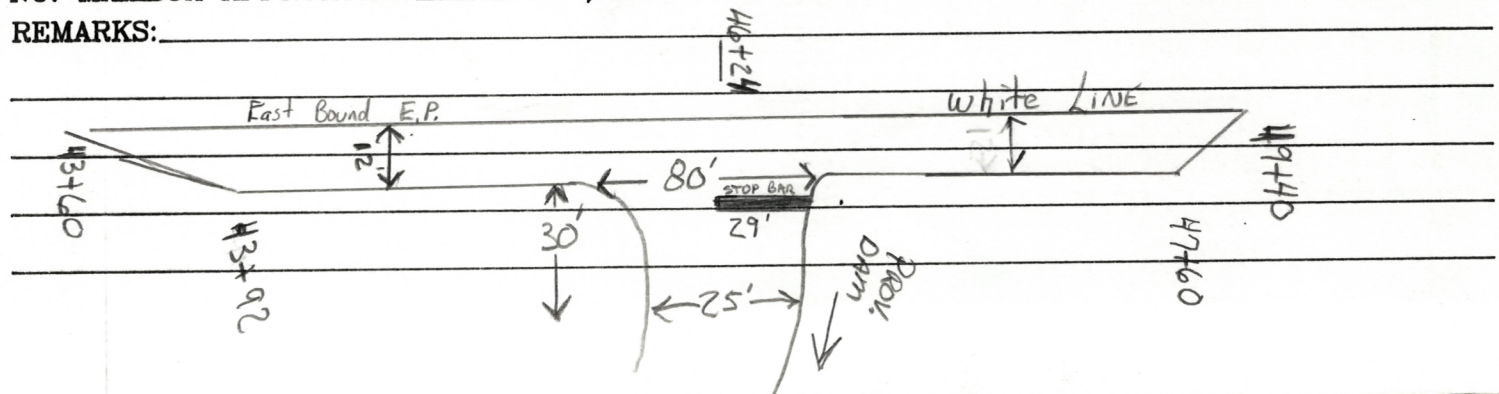

OD r (D-2)

1992 TWO-LANE RESURFACING PROGRAM APPROACHES (INTERSECTIONS & DRIVES)

2 of 5
SHEET 2 OF 3

COUNTY Lucas ROUTE US 24 SECTION 0.00

L = Prop Pav't Depth(in.) x 10; W = Width @ Mouth; W-1 = Width @ Throat

[illegible]

R = Raise F = Feather

[illegible]

PERSONNEL	TITLE	PERSONNEL	TITLE	COUNTY	DATE	S. R.	WEATHER	SEC.	TEMP.	JOB NO.
VAN DUSEN				LUCAS	2-20-92	US 24	Cloudy	0.00-1.11	+35°F	
BARNHISEL										
LONG										

DESCRIPTION "BAD PAVEMENT AREAS"

LEFT CENTER LINE RIGHT

STA.					
28+00					start Cracked Pavement
30+50					Both Lanes
33+00					End " "
50+50					start Bad Area
					Full Width Cracked & Rotted
					End —
					±2"

SUGGEST THIS TO
be GROUND DOWN

PERSONNEL	TITLE	PERSONNEL	TITLE
-----------	-------	-----------	-------

COUNTY LUCAS

DATE 2-20-92

VAN DWEN III

BARNHISEL Ø

LONG P

S. R. 4524

WEATHER Cloudy

SEC. 1.12TEMP. +40° F

DESCRIPTION

Minimum Vert. Distance under bridges

JOB NO

[illegible]