

LD-5 Rev. 2-83

PERSONNEL

LOERKE

CURTIS

ROMERO

TITLE

PERSONNEL

TITLE

OHIO DEPARTMENT OF TRANSPORTATION

SHEET NO.

COUNTY

LUCAS

DATE

4-2-92

S.R.

U.S. 24

WEATHER

CLOUDY

SEC.

13.49


TEMP.

+30

DESCRIPTION

PAVT MARKINGS for Resurf. Job in Waterville

JOB NO.

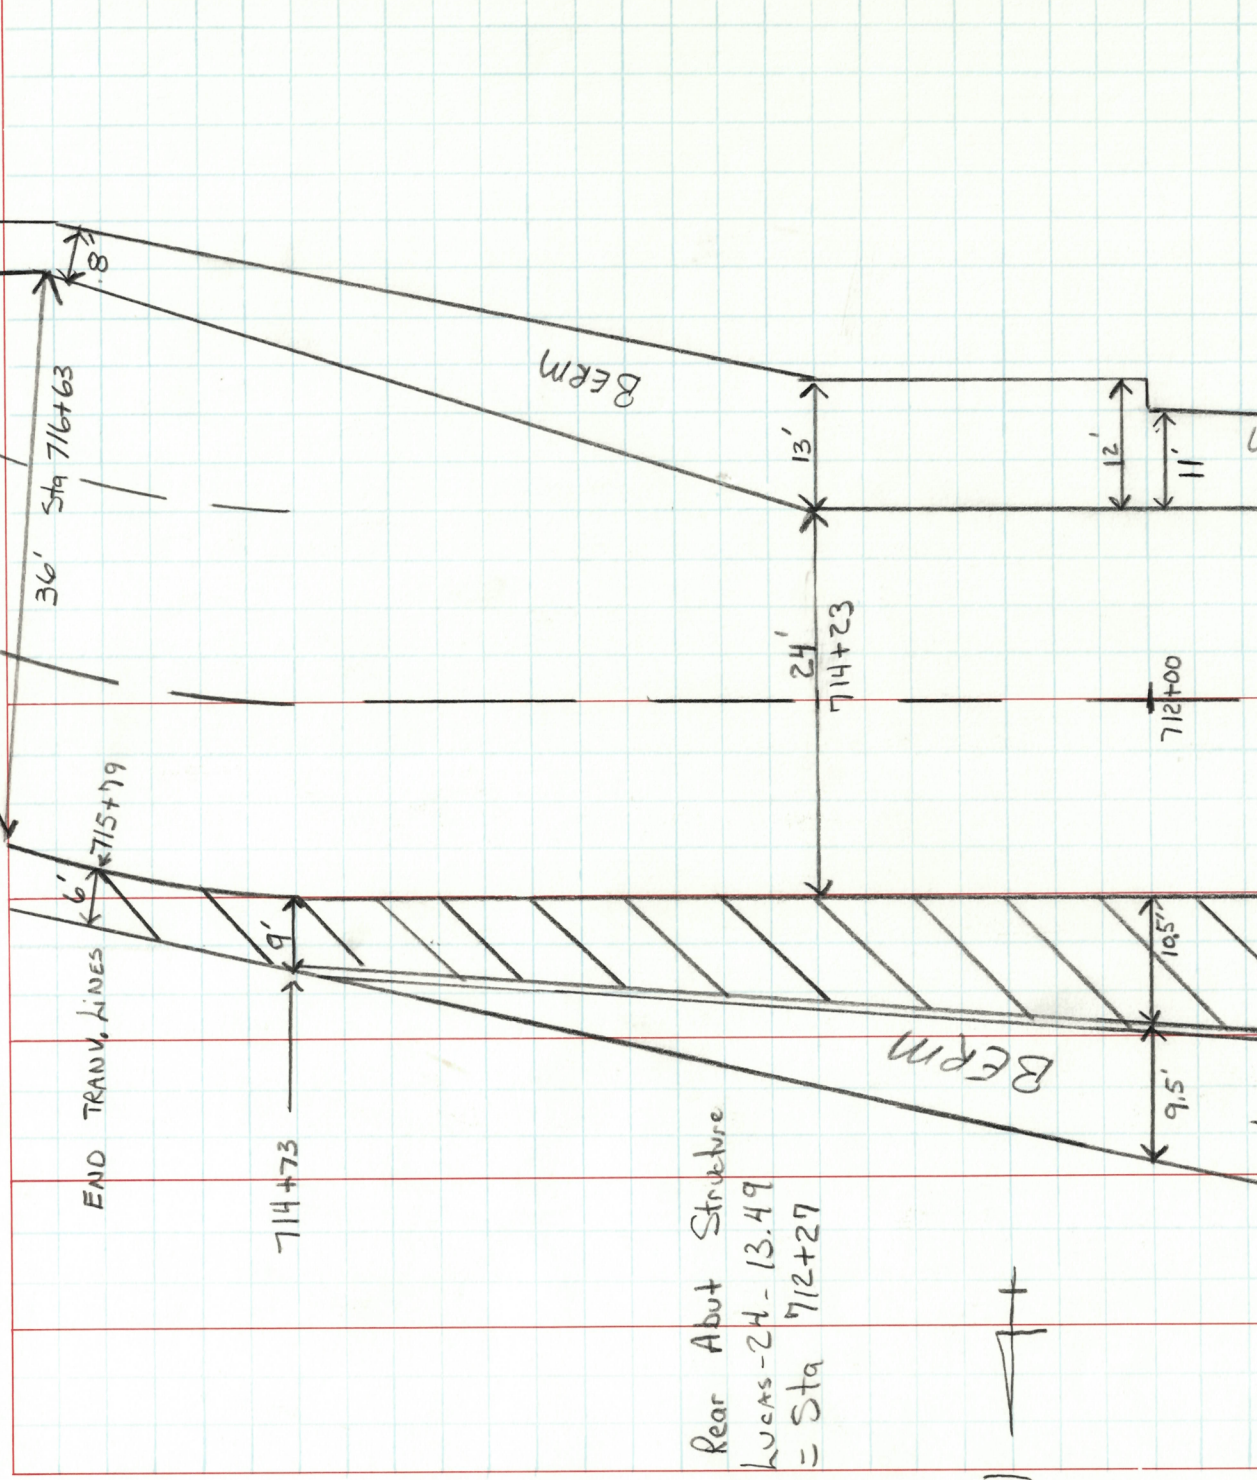

PERSONNEL	TITLE	PERSONNEL	TITLE	COUNTY	DATE
LOEHKE				LUCAS	4-3-92
CURTIS				S. R.	U.S. 24
ROMERO				WEATHER	Clear
				SEC.	13.49
				TEMP.	+25

DESCRIPTION	PAV. MARKINGS	W.B. LANE	CENTER LINE	RIGHT	JOB NO.
-------------	---------------	-----------	-------------	-------	---------

Stationing Obtain From

E.B. Lane Structure

Lucas-24-13.49 AND THEN

Right Angle Across to

W.B. Lane

 REAR ABUT, Lucas-24-13.49
 E.B. Lane = Sta 712+27
