


FED. RD. DIVISION	STATE	PROJECT
2	OHIO	



LUC. 24-15.86



DATE	REMARKS
4-20-64	Deleted Parcels 35WL & 35WU
10-14-64	COMPLETE

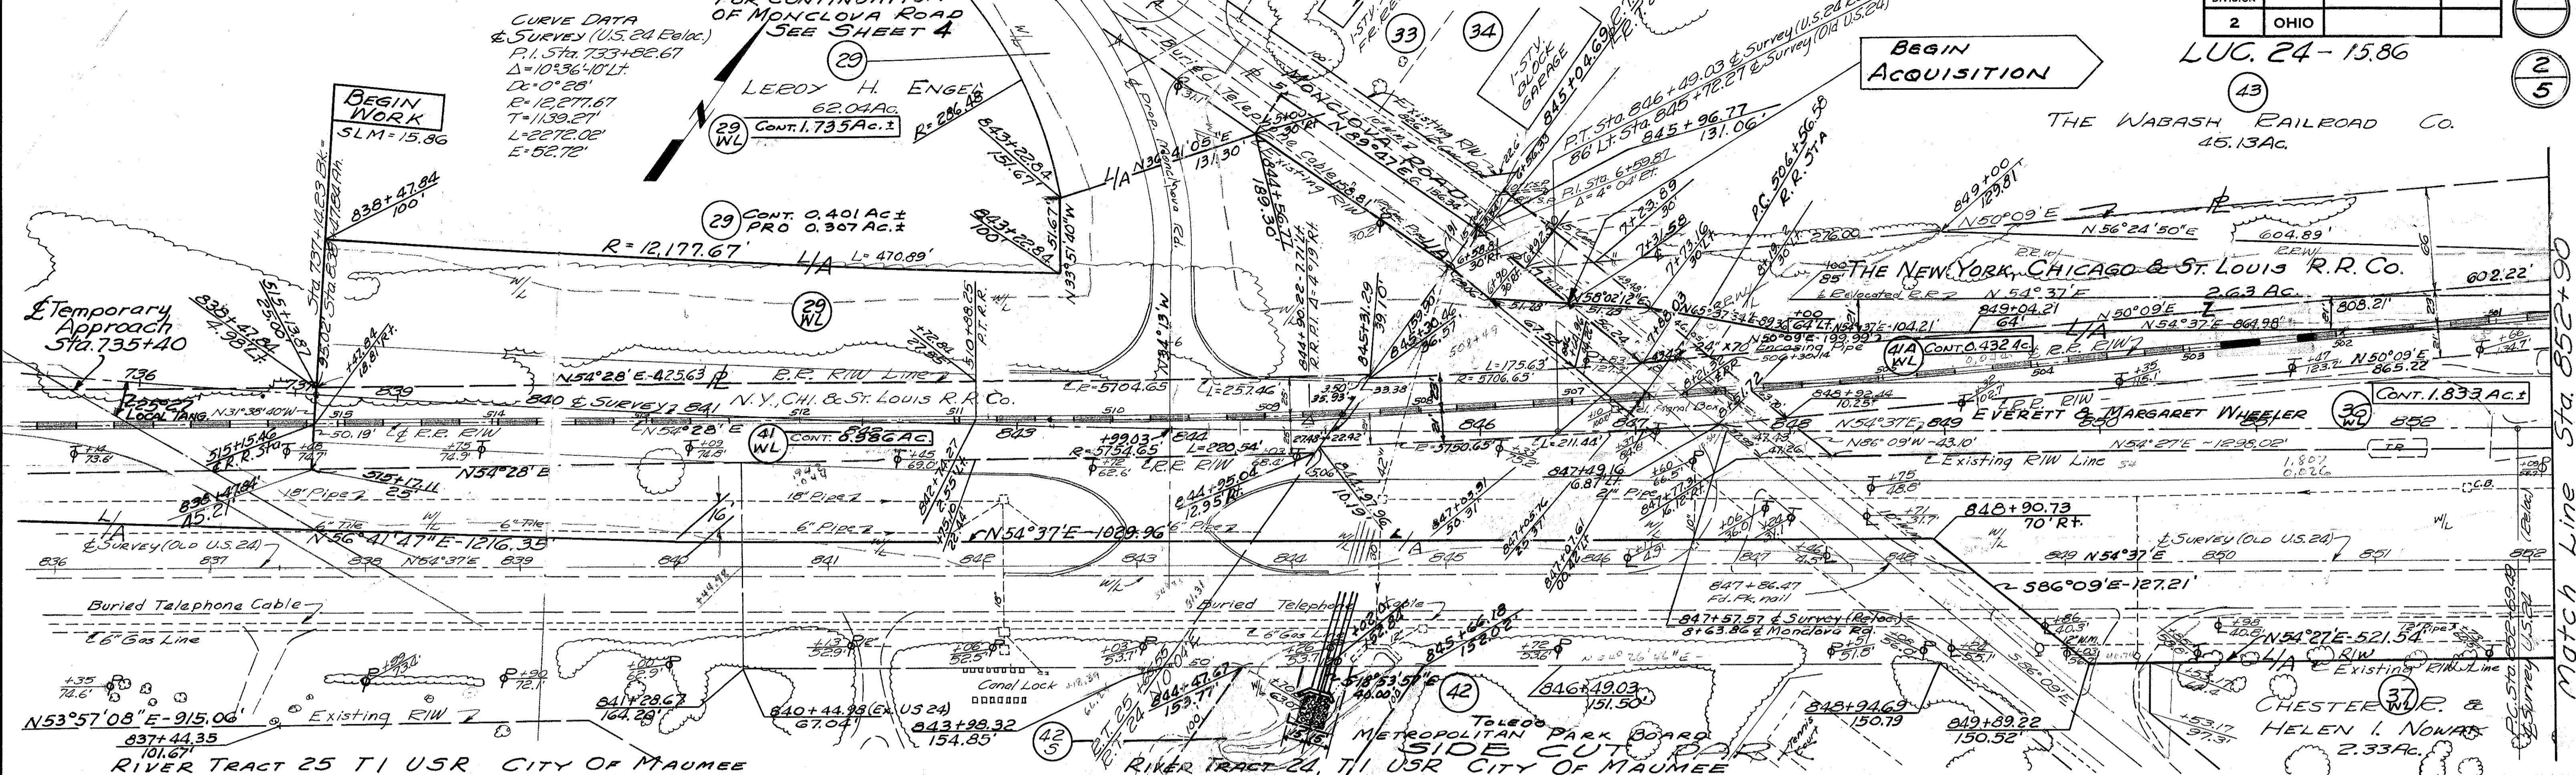

FED. RD. DIVISION	STATE	PROJECT
2	OHIO	

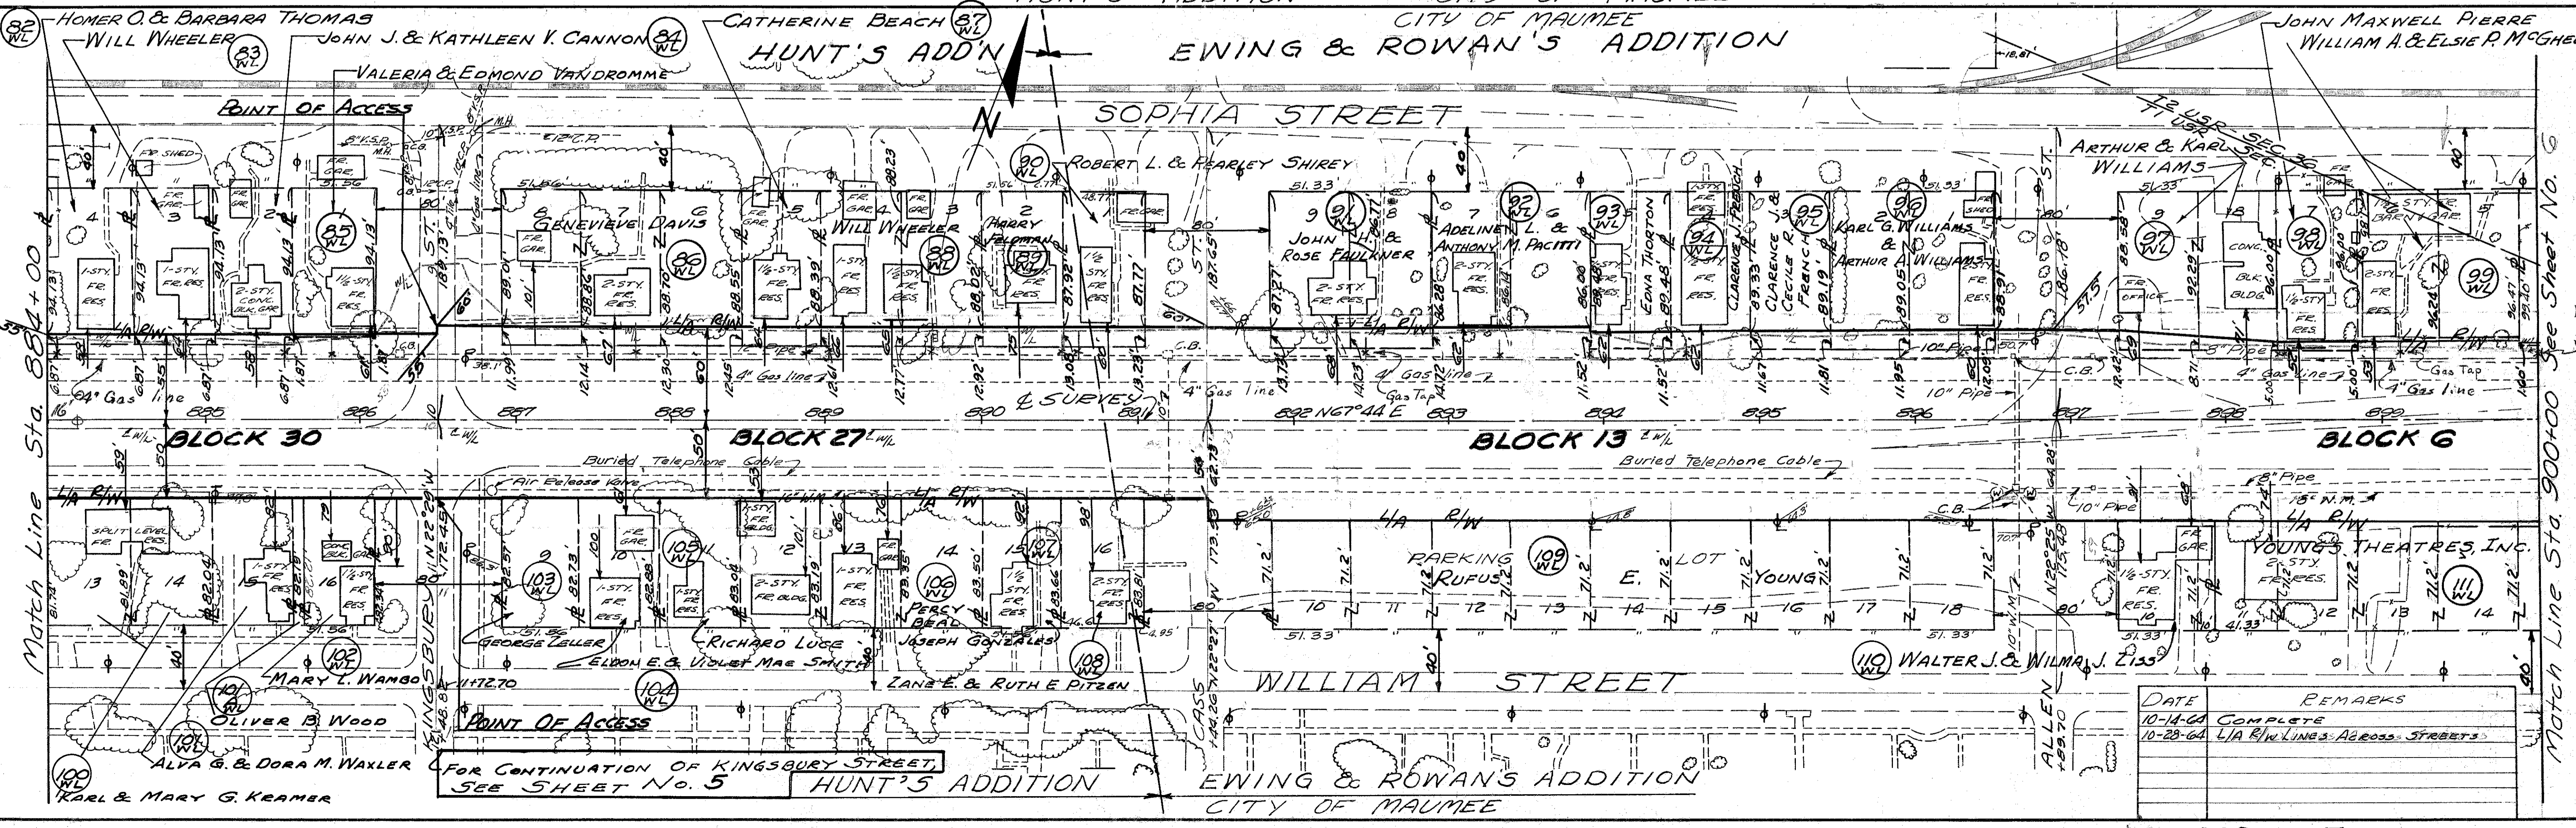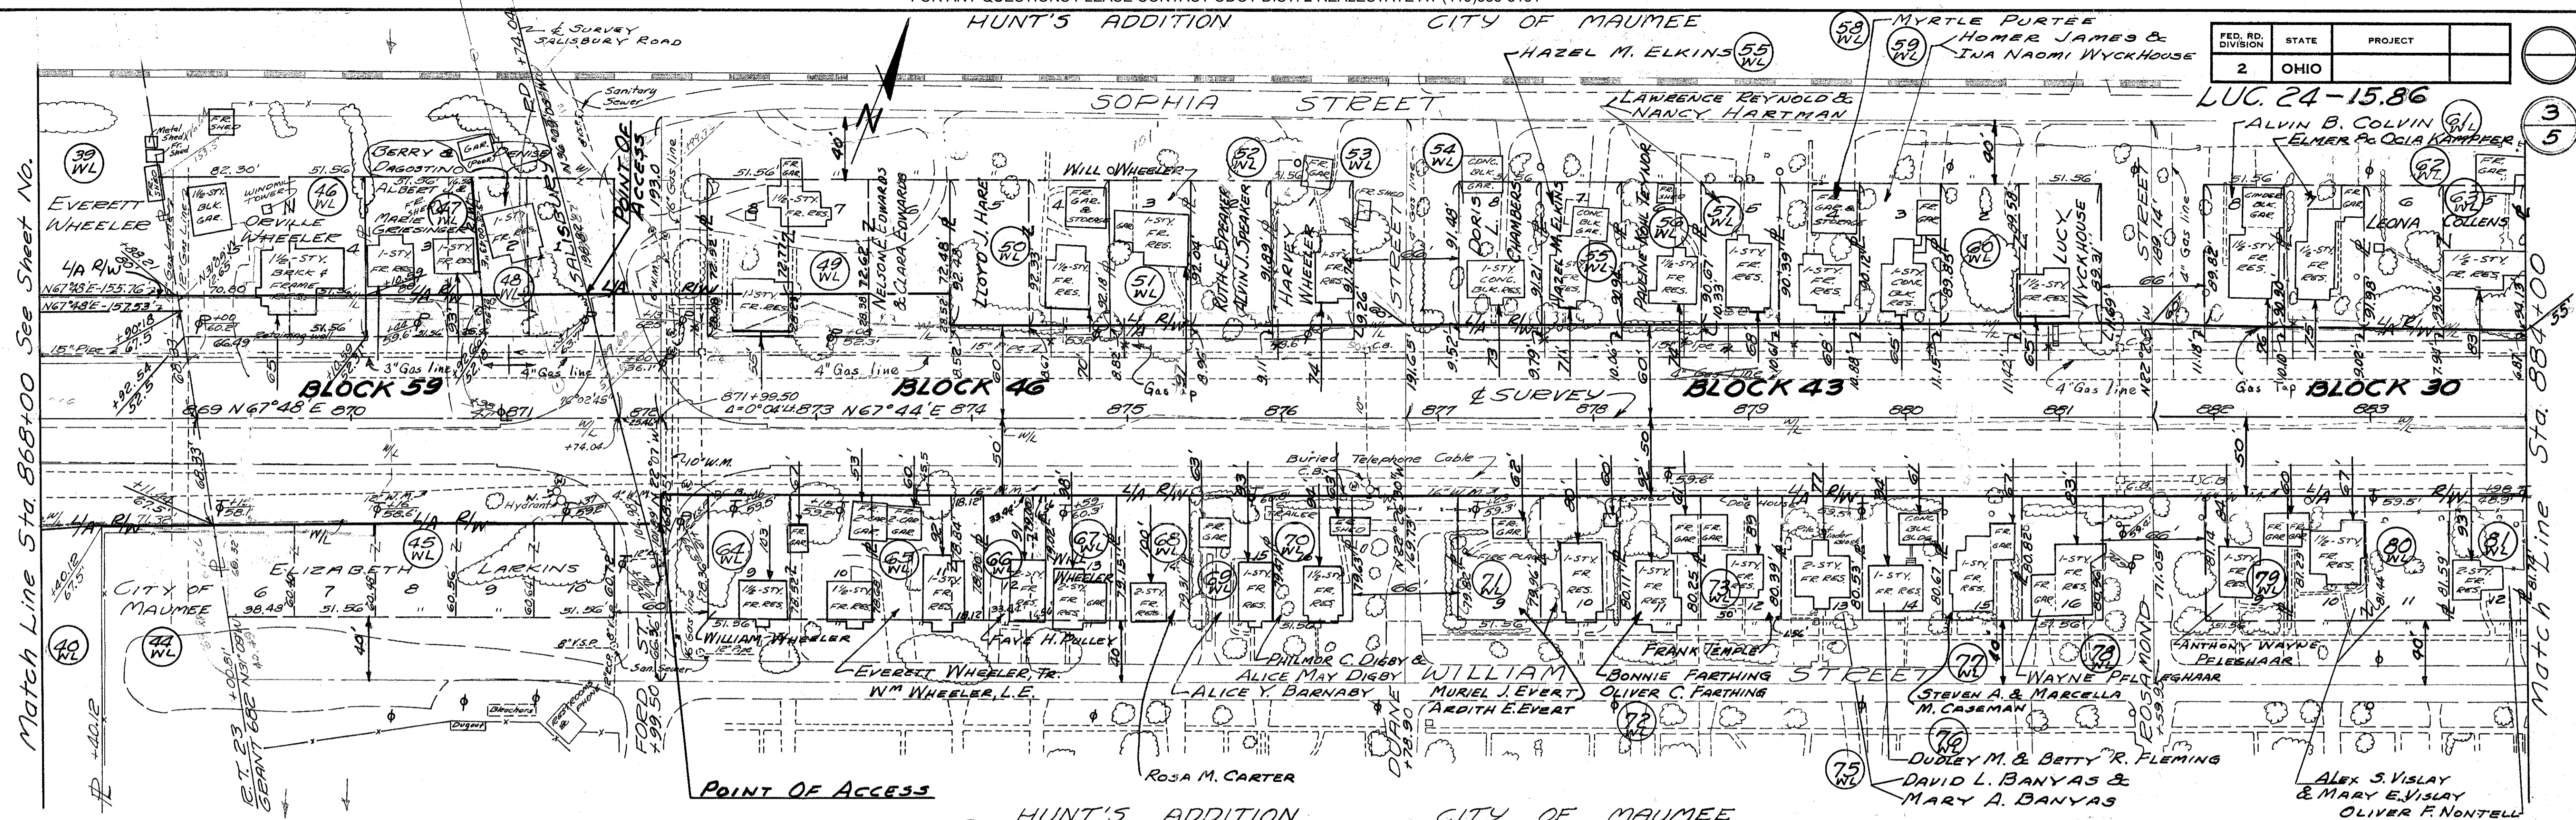

DATE	REMARKS
10-14-60	COMPLETE
10-28-60	L/A R/W LINES & ADDRESS STREETS

Match Line Sta. 868+00 See Sheet No. 4

Match Line Sta. 884+00

Match Line Sta. 884+00

Match Line Sta. 900+00 See Sheet No. 6

FOR CONTINUATION OF KINGSBURY STREET, SEE SHEET NO. 5

