

O.D.O.T. DISTRICT 2 SURVEY OFFICE

PERSONNEL

REFERENCE NO. 28

SHEET 35 OF 68

NOTES S. HUSS

H.C. B. VAN DUSEN

R.C. C. LOENKLE

A C. COV

DATE 6-5-97

WEATHER PARTLY CLOUDY

TEMP. 70°F

ROUTE US-24

COUNTY Lucas

TOWNSHIP Providence

SECTION 26

T. 6 N. R. 9 E


TYPE MONUMENT PK. & WASHER

ON SURFACE - ~~BELOW~~ ON SURFACE


~~LEFT - & PAV'T. - RIGHT~~ ON &

11.9' TO RT EDGE PAVEMENT

S.L.M. 269+91

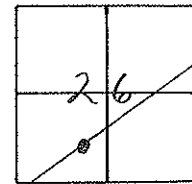

SET PK/WASHER
 10-21-97
 SAA

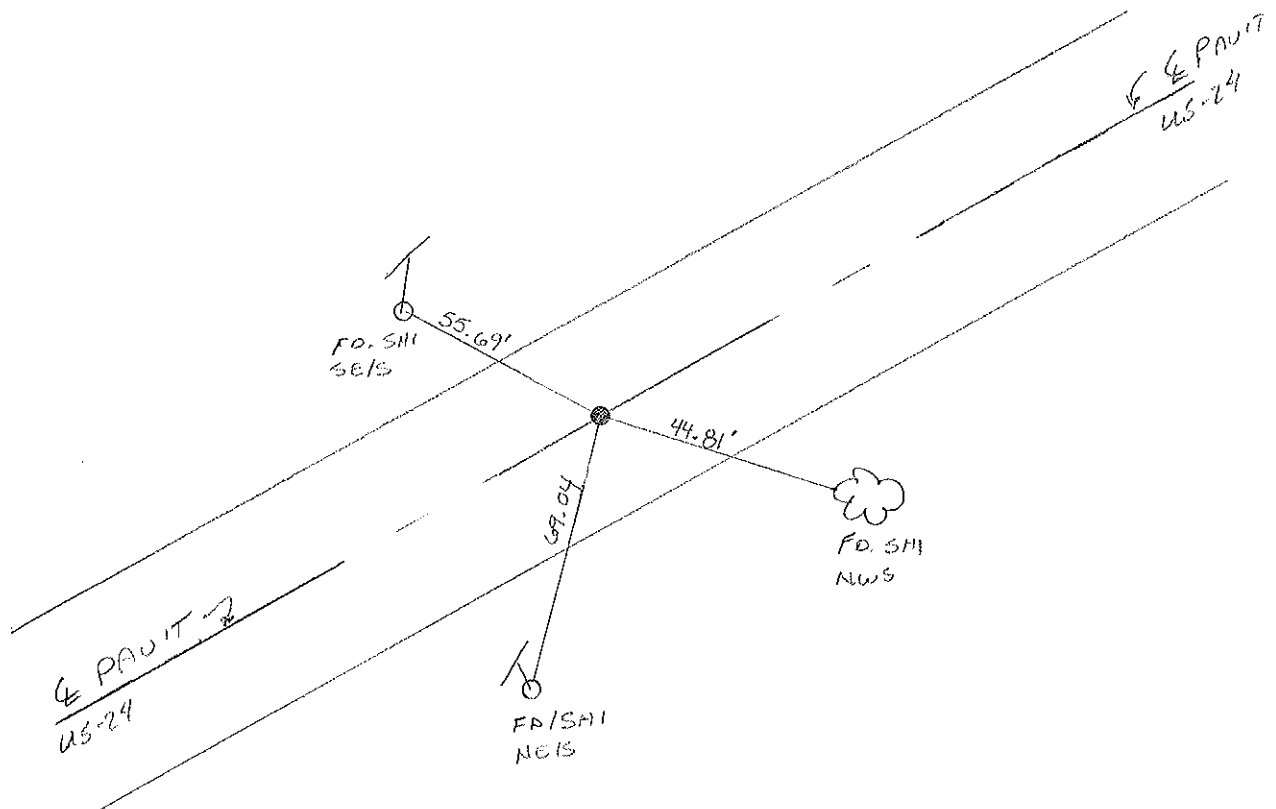

O.D.O.T. DISTRICT 2 SURVEY OFFICE

PERSONNEL _____

REFERENCE NO. 28

SHEET 28 OF _____

NOTES LOEHRKE

H.C. CANTENBURY

R.C. CORTES

DATE 10-11-94

WEATHER CLEAR

TEMP. +58°

ROUTE US #24

COUNTY LUCAS



TOWNSHIP Providence

SECTION 26

T. 6 N. R. 9 E.

Set P.K. / WASHER
5-11-95
C.L.

TYPE MONUMENT PK NAIL
ON SURFACE - BELOW SURFACE
LEFT - CL PAV'T. - RIGHT ON CL
11.7 TO RT EDGE PAVEMENT
S.L.M. 269+23

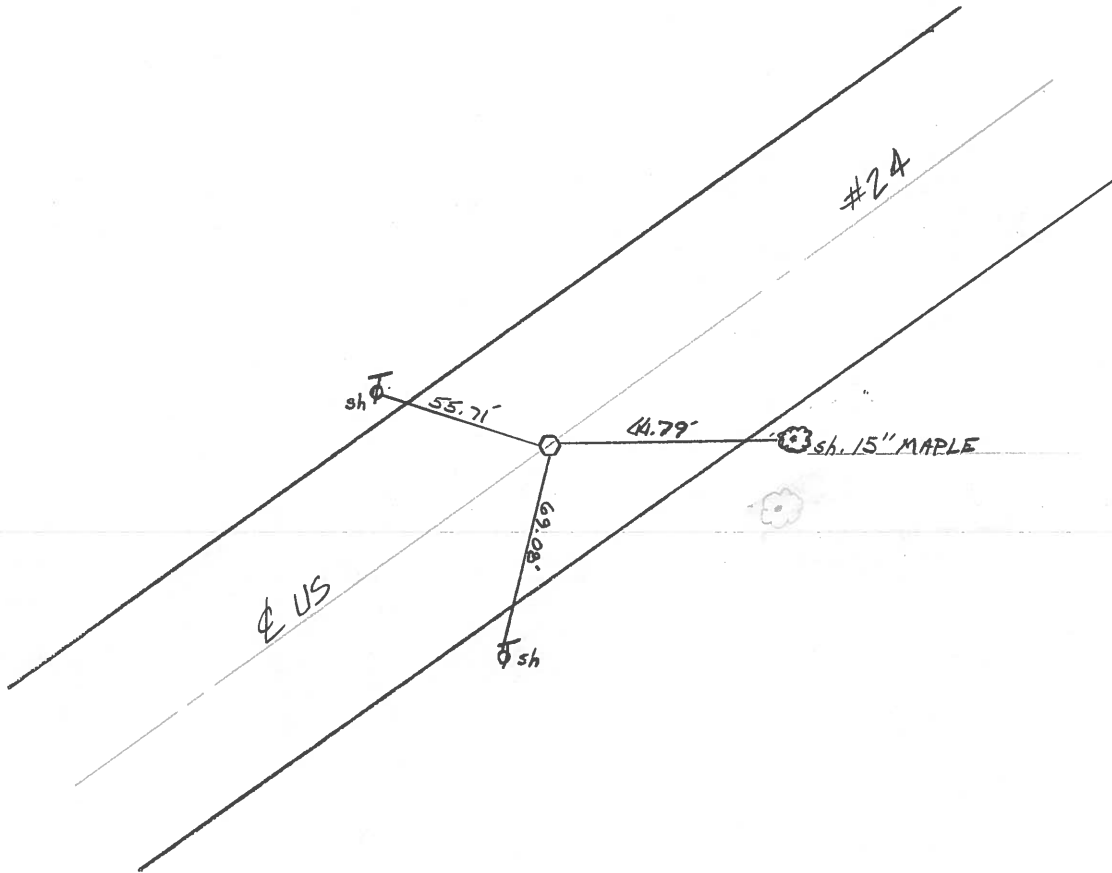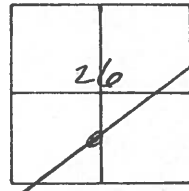

O.D.O.T. DISTRICT 2 SURVEY OFFICE

PERSONNEL _____

REFERENCE NO. 28

SHEET 28 OF _____

NOTES L. Stone

H.C. D. Cordis

R.C. J. Householder

DATE 30 Aug. 89

WEATHER Clear

TEMP. 76°

ROUTE US #24

COUNTY Lucas

TOWNSHIP Providence

SECTION 26

T _____ R _____


TYPE MONUMENT PK Nail

ON SURFACE - BELOW Surface



LEFT - \odot PAV'T. - RIGHT _____

_____ TO _____ EDGE PAVEMENT

S.L.M. 269+42

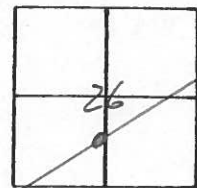

Set PK Nail 10/13/89 1RS

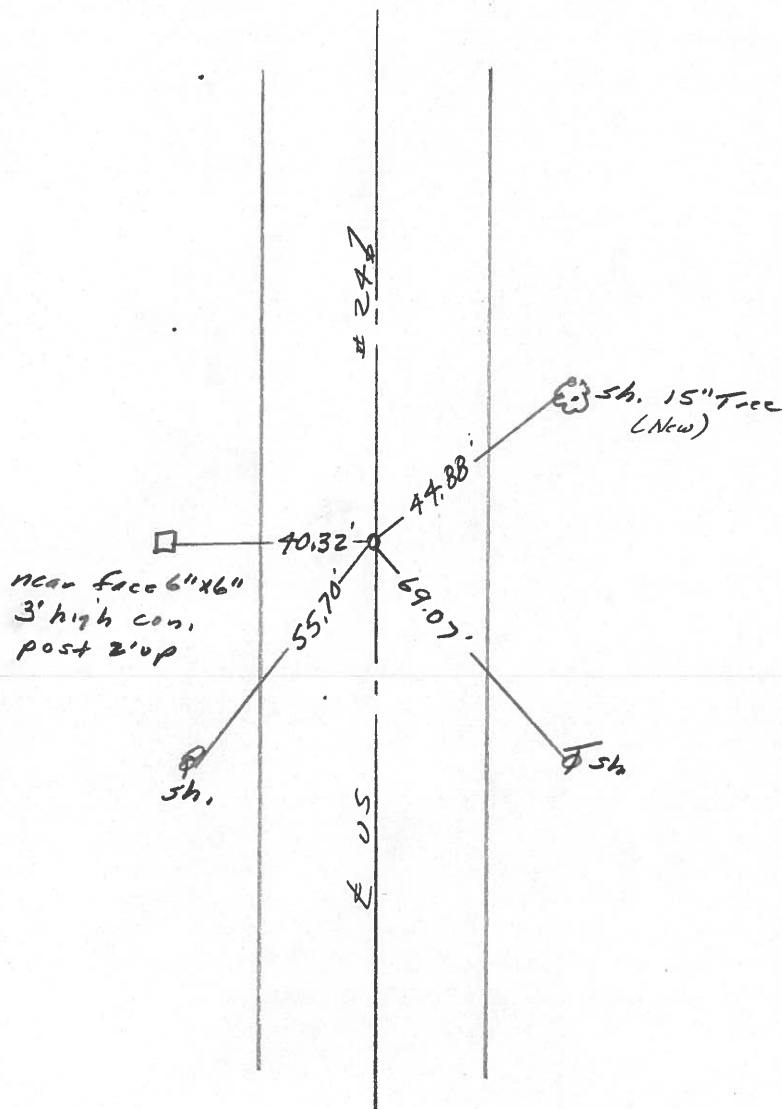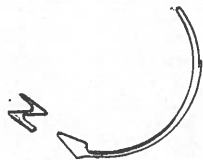

Q.D.O.T. DISTRICT 2 SURVEY OFFICE

Sht. 34 of

County Lucas ~~S.R.~~ US #24

Date 17 July 1980

Township Providence

Weather Warm

Section 26

Temp. 80°


T N, R E

Personnel I. Stone

28


P. Neuse

D. Curtis

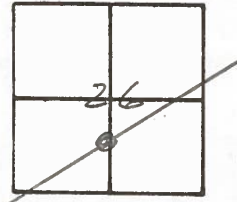


Ref. No. 4228

Fd. PK. Nail to Surface
Sta. 269+87.04 = P.O.T.
12.0' to S. edge pt.
11.9' to N. edge pt.

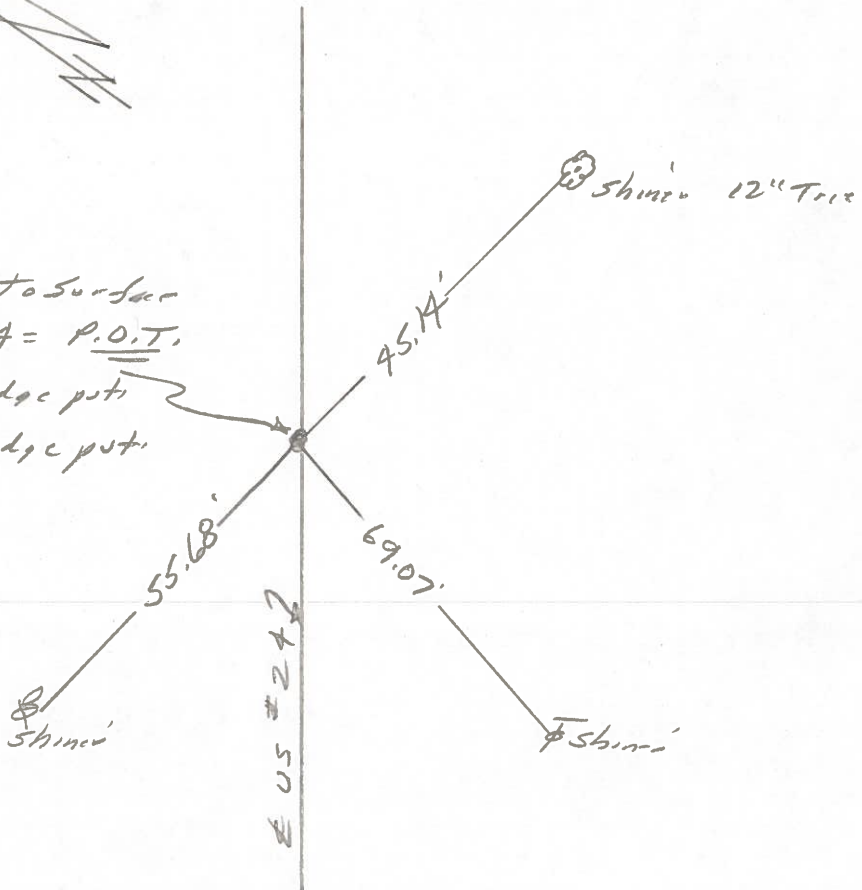


PERSONNEL	TITLE	PERSONNEL	TITLE	COUNTY	<u>LUCAS</u>	DATE	<u>JULY 7, 1971</u>
<u>W. DENNO</u>				S. R.	<u>U.S. #24</u>	WEATHER	<u>SUNNY - WAF</u>
<u>D. CURTIS</u>				SEC.		TEMP.	<u>85±</u>
<u>D. STEVENS</u>							
<u>R. BRANNAN</u>							

DESCRIPTION	REFERENCES TO CONTROL POINTS	JOB NO.
	LEFT CENTER LINE RIGHT	

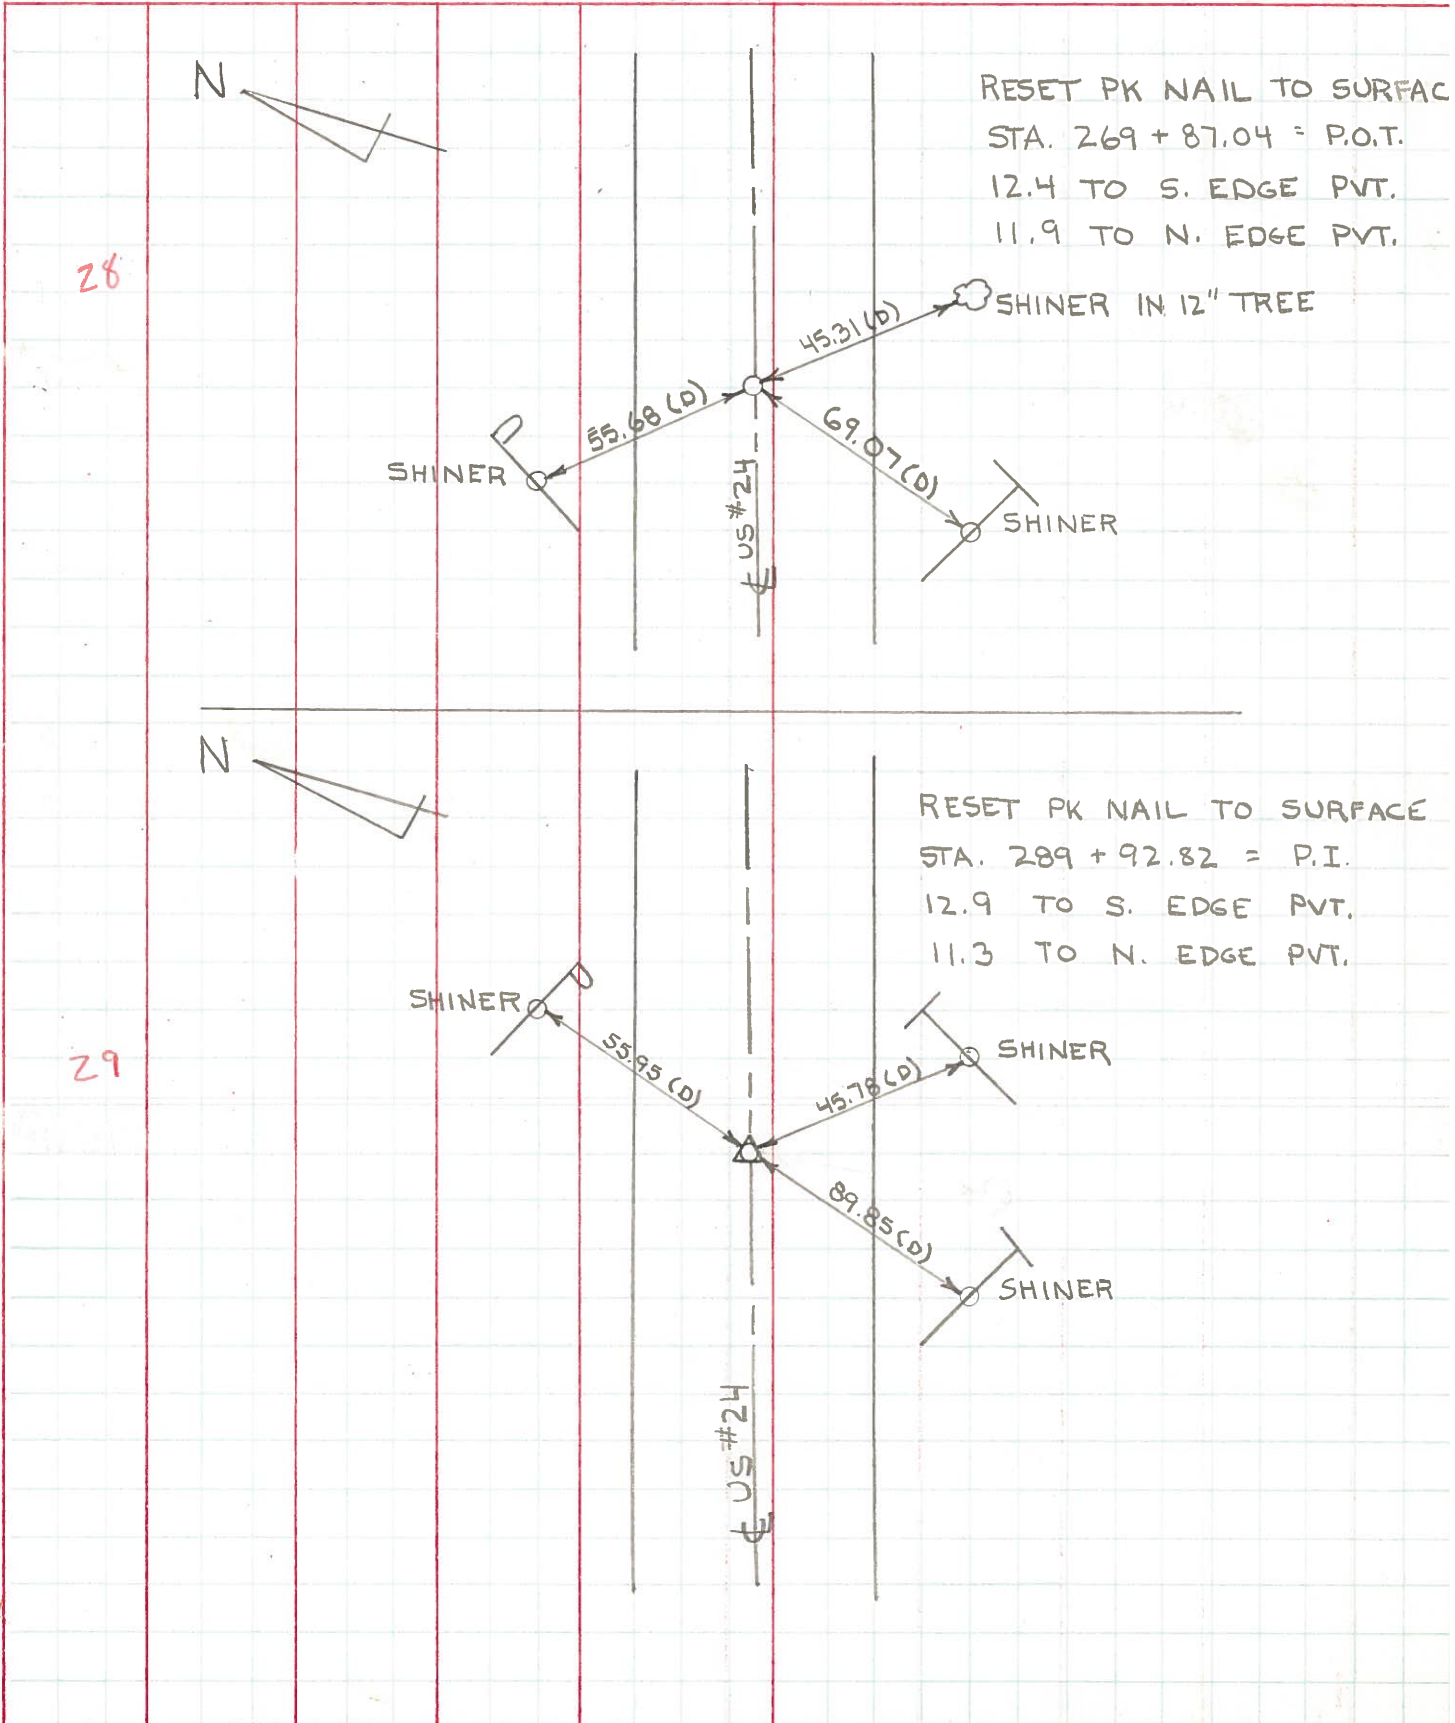

PERSONNEL	TITLE	PERSONNEL	TITLE	COUNTY	DATE
Stone	Notes			Lucas	May 68
Beck	Flag			S. R. #24	WEATHER Fair
Michalek	Tape			SEC.	TEMP.
Schroder	Tape				

DESCRIPTION References to Control Points LEFT CENTER LINE RIGHT JOB NO.

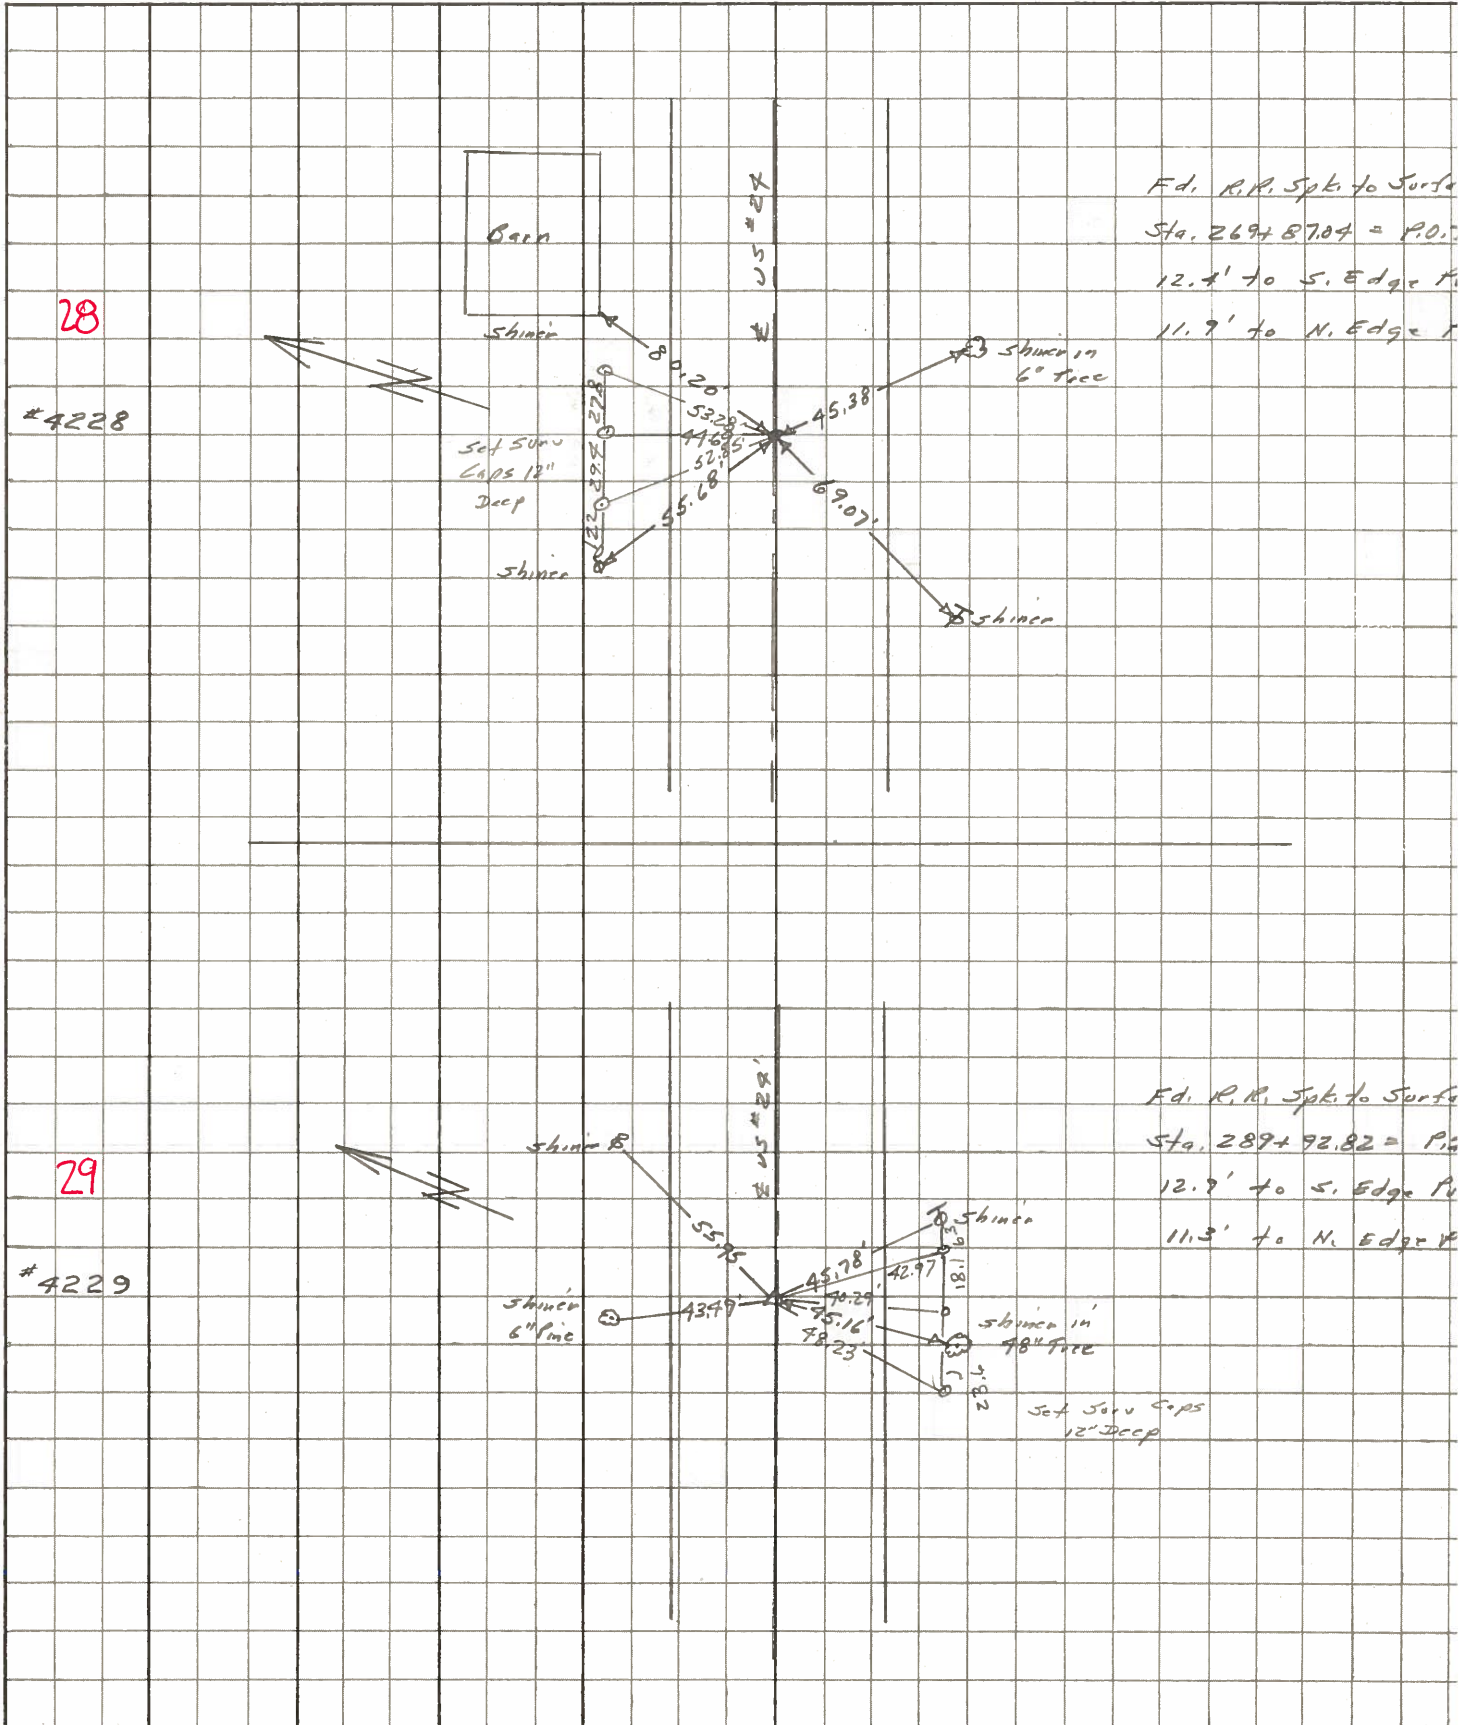

PERSONNEL TITLE PERSONNEL TITLE
 Stone _____
 Brock _____
 Brindley _____
 Schroeder _____

COUNTY Lucas DATE 3 Feb 66
 S. R. #27 WEATHER Cool
 SEC. _____ TEMP. 31°

DESCRIPTION *Pots to Control Points* JOB NO. _____
 LEFT CENTER LINE RIGHT

DESCRIPTION	LEFT	CENTER LINE	RIGHT	JOB NO.
266+43.17 = P.O.T. Fd. R.R. Spt. To Surface		76.70'	S.W. To Shiner in T.P.	(D)
		45.27'	S.S.E. To R/W Mon.	(D)
		45.47'	N.N.E. To R/W Mon.	(D)
		48.85'	N.E. To Shiner in P.P.	(D)
269+87.04 = P.O.T. Fd. R.R. Spt. To Surface		80.20'	N.E. To Shiner in S.W. Cor. Cont.	(D)
		45.38'	S.E. To Shiner in 6" Tree	(D)
		69.07'	S.W. To Shiner in T.P.	(D)
		55.68'	N.W. To Shiner in P.P.	(D)
289+72.82 = P.I. Fd. R.R. Spt. To Surface		45.16'	S.S.W. To Shiner in 78" Tree	(P)
		45.78'	S.S.E. To Shiner in T.P.	(D)
		55.95'	N.E. To Shiner in P.P.	(D)
		43.49'	N.N.W. To Shiner in 6" Pine	(D)
296+72.12 = P.O.T. (Box Rd.) Fd. R.R. Spt. To Surface		75.48'	N.N.E. To Shiner in T.P.	(P)
		50.82'	N.E. To Shiner in P.P.	(P)
		62.99'	N.W. To Shiner in P.P.	(D)
		41.30'	S. To Shiner in T.P.	(P)
304+38.50 = P.O.T. (Otsaga Rd.) Fd. R.R. Spt. To Surface		33.92'	N.W. To Shiner in P.P.	(D)
		38.07'	S.S.E. To Con. Road Sign	(D)
		40.86'	S.S.W. To Shiner in T.P.	(D)
		71.52'	S.W. To N.E. Cor. Con. Porch Slab	(D)
308+65.95 = P.I. Fd. 1/2" I.P. To Surface (Bent Over)		53.00'	N.N.E. To Shiner in P.P.	(D)
		49.25'	S.E. To Shiner in T.P.	(D)
		66.20'	S.W. To Shiner in 8" Walnut	(D)

PERSONNEL	TITLE	PERSONNEL	TITLE
Silvester			
#			
CREW			

COUNTY LUCAS DATE 1958
 S. R. #24 WEATHER _____
 SEC. He-Luc. - Waterville TEMP. _____
 (0.00)

DESCRIPTION LEFT CENTER LINE RIGHT JOB NO.

