

O.D.O.T. DISTRICT 2 SURVEY OFFICE

PERSONNEL _____

REFERENCE NO. 29

SHEET 36 OF 68

NOTES S. HUSS

H.C. R. VAN DUSEN

DATE 6-5-97

ROUTE US-24

R.C. C. LOERKE

WEATHER FAIR

COUNTY Lucas

G. COX

TEMP. +70°F

TOWNSHIP Providence

SECTION 26

T. 6 N. R. 9 E.


TYPE MONUMENT PK NAIL & WASHER

ON SURFACE - BELOW YES


LEFT - 0 PAV'T. - RIGHT 0.6 LT

11.5 TO LT EDGE PAVEMENT

S.L.M. 289496

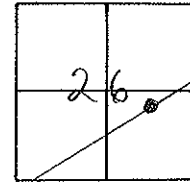

SET PK/WASHER
 10-21-97
 SAH

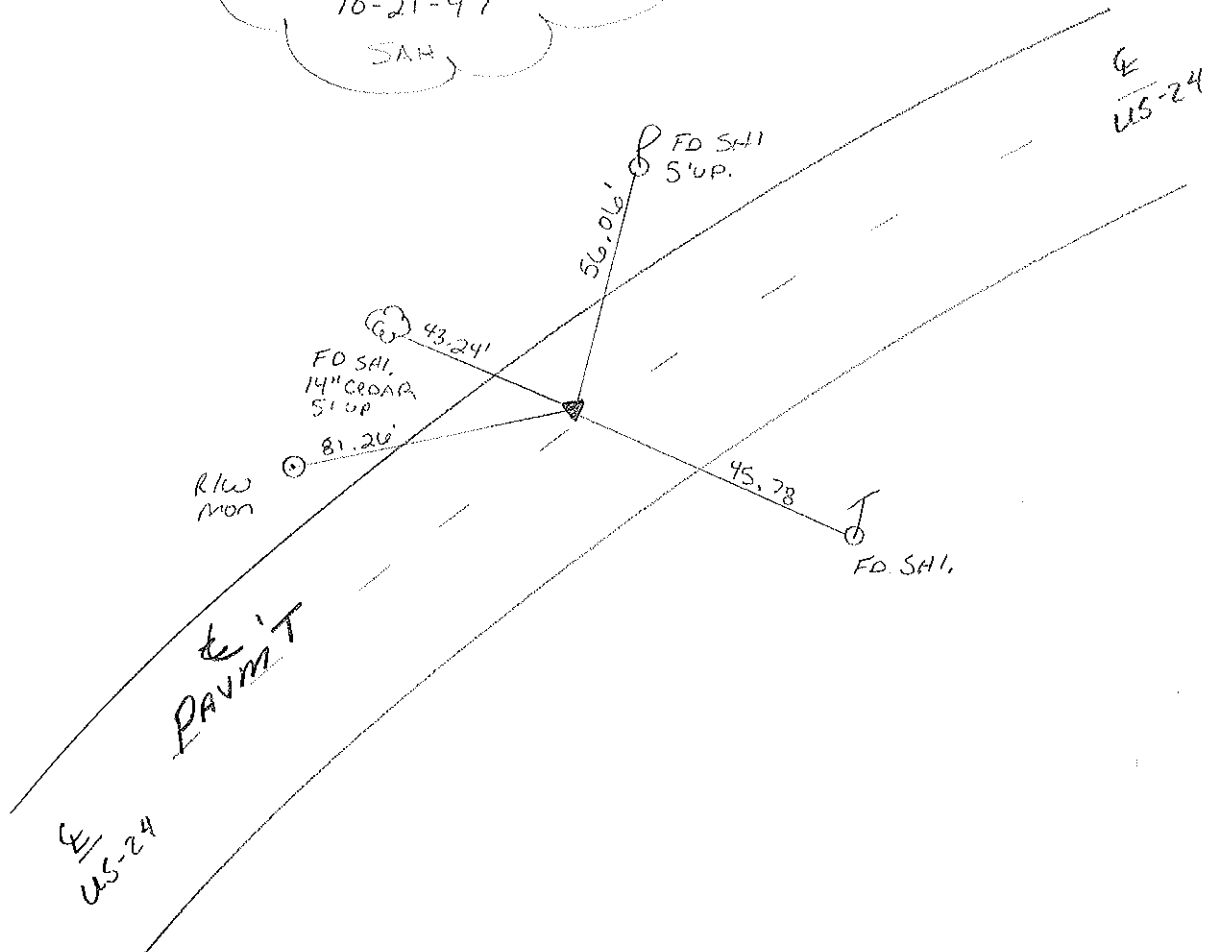

O.D.O.T. DISTRICT 2 SURVEY OFFICE

PERSONNEL _____

REFERENCE NO. 29

SHEET 29 OF _____

NOTES LOEHRKE

H.C. CANTONBURY

R.C. CORTES

DATE 10-11-94

WEATHER CLEAR

TEMP. +55°

ROUTE US #24

COUNTY LUCAS

TOWNSHIP Providence

SECTION 26

T. 6 N R. 9 E



TYPE MONUMENT PK. NAIL

ON SURFACE - BELOW SURFACE

LEFT - \odot PAV'T. - RIGHT 0.5' Lt.

0.9 TO Lt EDGE PAVEMENT

S.L.M. 289+26

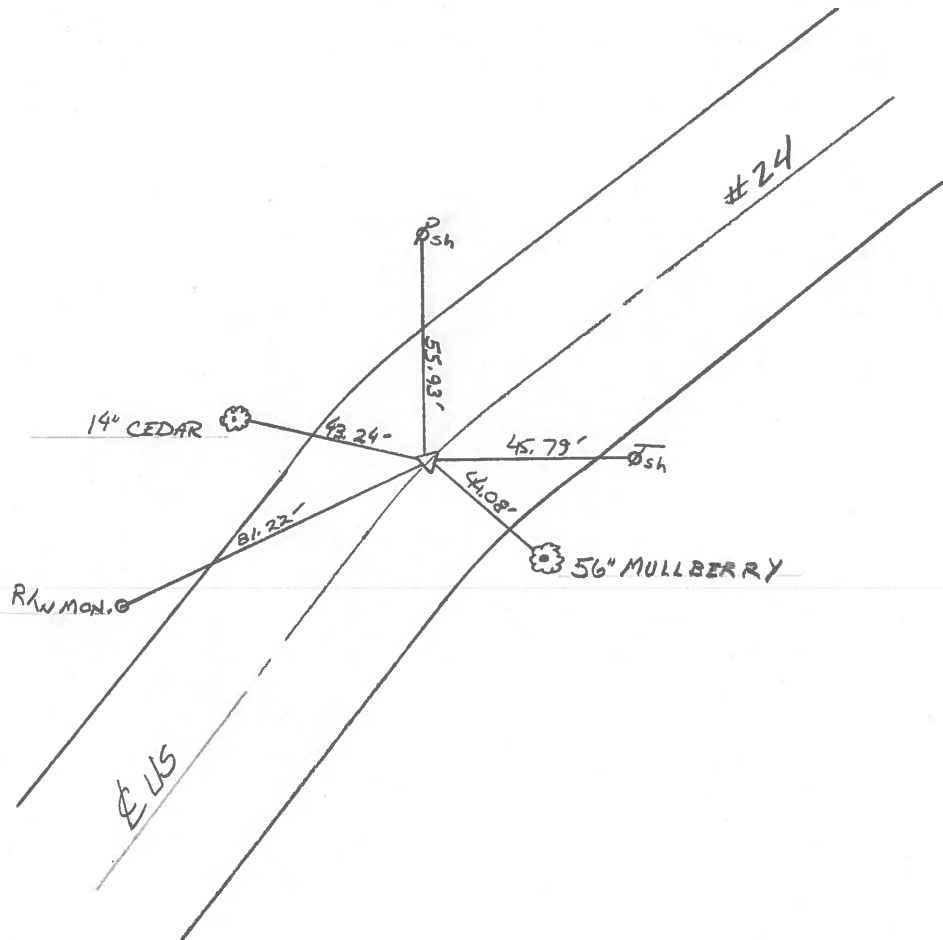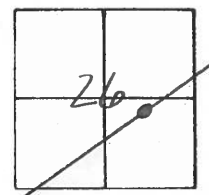

O.D.O.T. DISTRICT 2 SURVEY OFFICE

PERSONNEL _____

REFERENCE NO. 29

SHEET 29 OF _____

NOTES 1. Stone

H.C. D. Curtis

R.C. J. Householder

DATE 30 Aug. 89

WEATHER Clear

TEMP. 77°

ROUTE US #24

COUNTY Lucas

TOWNSHIP Providence

SECTION 26

T _____ R _____



TYPE MONUMENT PK Nail

ON SURFACE - BELOW Surface

LEFT - & PAW'T. - RIGHT _____

_____ TO _____ EDGE PAVEMENT

S.L.M. 289+47

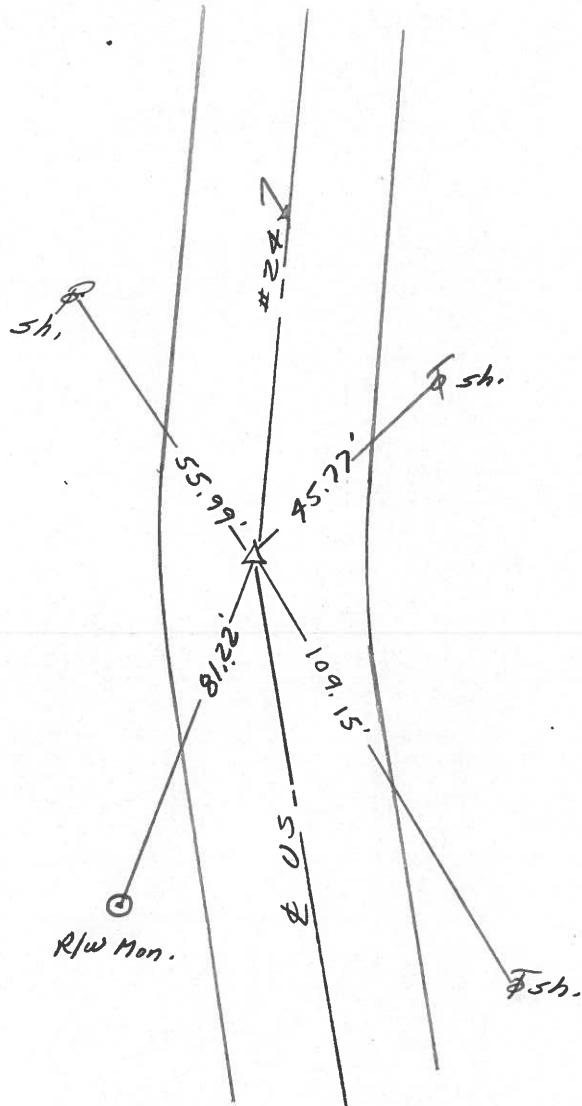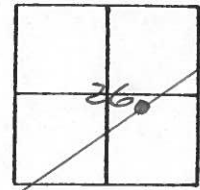

Q.D.O.T. DISTRICT 2 SURVEY OFFICE

Sht. 35 of

County Lucas S.R. US# 24

Date 17 July 1980

Township Providence

Weather Warm

Section 26

Temp. 80°


T N, R E

Personnel L. Stone


P. Neuse

D. Curtis

29

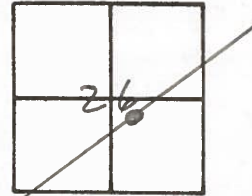

Ref. No. 4229

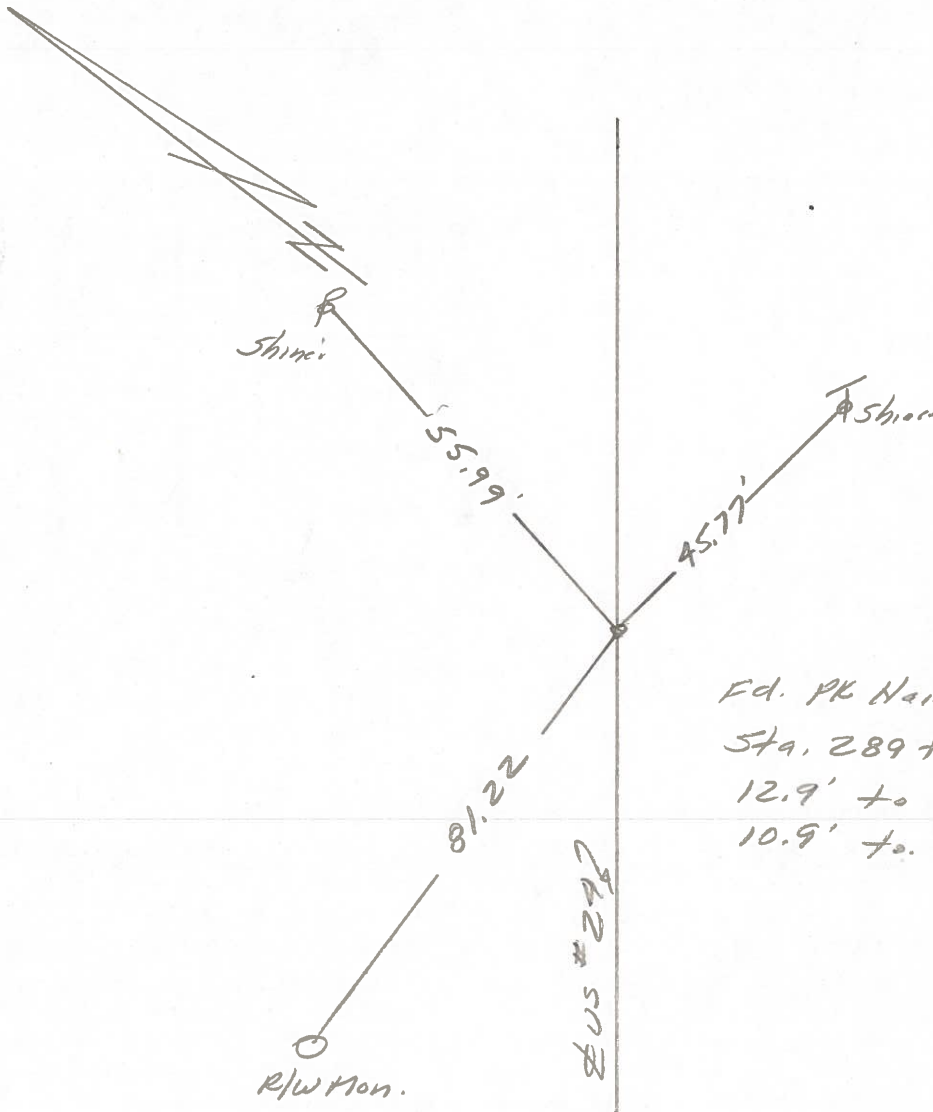

Ed. PK Nail to Surface
Sta. 289 + 92.82 = P.I.
12.9' to S. edge put.
10.9' to N. edge put.

PERSONNEL TITLE PERSONNEL TITLE

COUNTY LUCAS

DATE JULY 7, 1971

W DENNO

S. R. U.S. # 24

WEATHER SUNNY - WAE

D CURTIS

D STEVENS

SEC.

TEMP. 85±

R BRANNAN


DESCRIPTION REFERENCES TO CONTROL POINTS

JOB NO.

LEFT

CENTER LINE


RIGHT

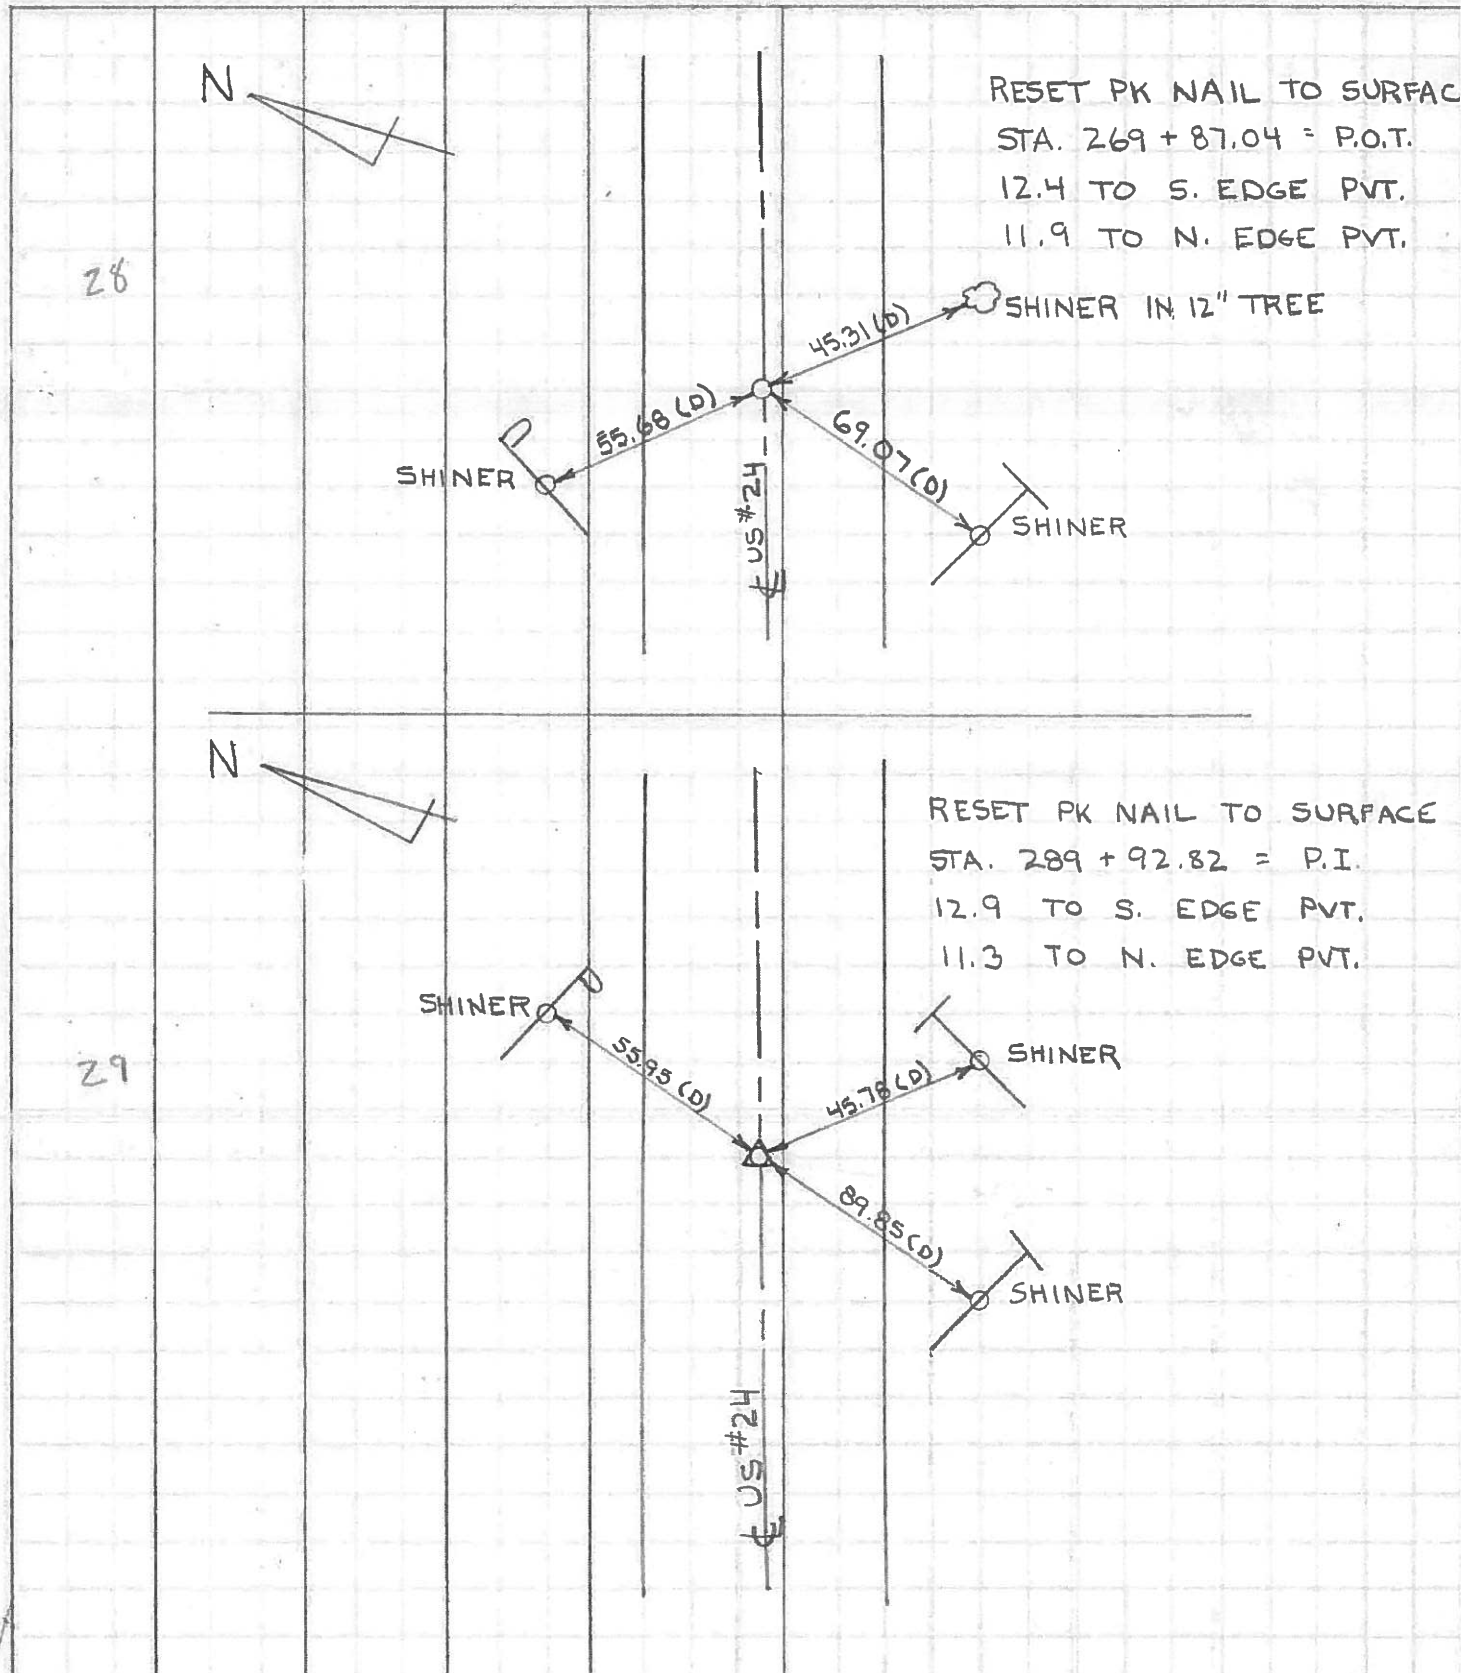

PERSONNEL	TITLE	PERSONNEL	TITLE	COUNTY	Lucas	DATE	May 68
Stone	Notes			S. R.	#24	WEATHER	Fair
Beck	Flag			SEC.		TEMP.	
Michalak	Tape						
Schroder	Tape						

DESCRIPTION: References to Control Points JOB NO. _____

LEFT CENTER LINE RIGHT

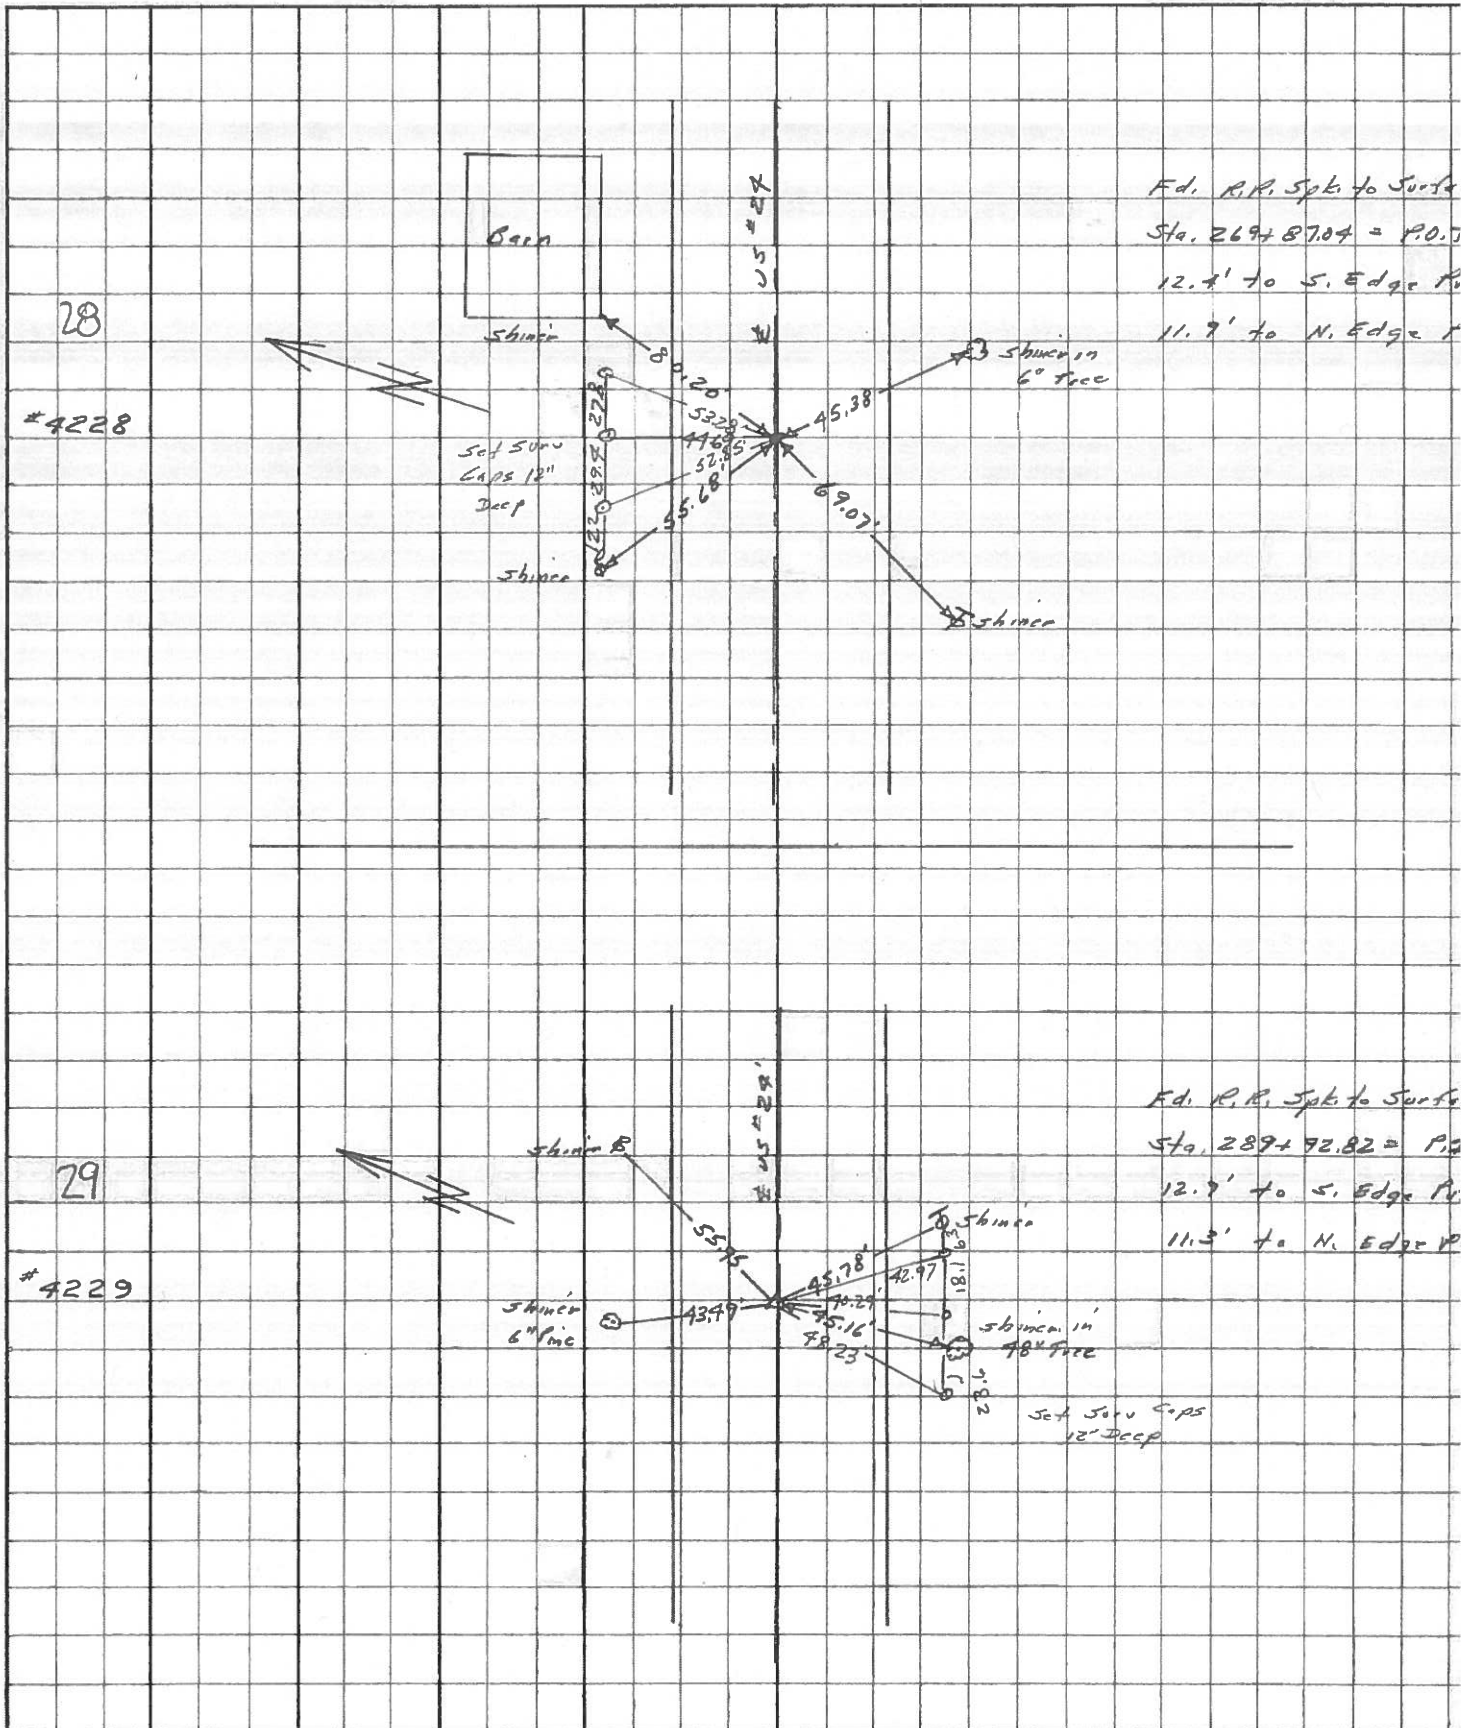

PERSONNEL	TITLE	PERSONNEL	TITLE	COUNTY	Lucas	DATE	3 Feb 26
Stone				S. R.	#24	WEATHER	Cloud
Brack				SEC.		TEMP.	31°
Brindley				DESCRIPTION <u>Rols. to Control Points</u>			
Schroeder				JOB NO. _____			

LEFT	CENTER LINE	RIGHT
266+43.17 = P.O.T.	76.70'	S.W. To Shiner in T.P. (D)
Fd. R.R. Spt.	45.27'	S.S.E. To R/W Mon. (D)
27 To Surface	45.47'	N.N.E. To R/W Mon. (D)
	48.85'	N.E. To Shiner in P.P. (D)
269+87.04 = P.O.T.	80.20'	N.E. To Shiner in Sw. Cor. Gate (D)
Fd. R.R. Spt.	45.38'	S.E. To Shiner in 6" Tree (D)
28 To Surface	69.07'	S.W. To Shiner in T.P. (D)
	55.68'	N.W. To Shiner in P.P. (D)
289+72.82 = P.I.	45.16'	S.S.W. To Shiner in 78" Tree (P)
Fd. R.R. Spt.	45.78'	S.S.E. To Shiner in T.P. (D)
29 To Surface	53.95'	N.E. To Shiner in P.P. (D)
	43.49'	N.N.W. To Shiner in 6" Pine (D)
296+72.12 = P.O.T. (Box R1)	75.48'	N.N.E. To Shiner in T.P. (P)
Fd. R.R. Spt.	50.82'	N.E. To Shiner in P.P. (P)
30 To Surface	62.99'	N.W. To Shiner in P.P. (D)
	41.30'	S. To Shiner in T.P. (P)
304+58.50 = P.O.T. (Ostrya Rd.)	33.92'	N.W. To Shiner in P.P. (D)
Fd. R.R. Spt.	38.07'	S.S.E. To Con. Road Sign (D)
31 To Surface	40.86'	S.S.W. To Shiner in T.P. (D)
	71.52'	S.W. To N.E. Cor. Con. Porch Sub (D)
308+65.95 = P.I.	53.00'	N.N.E. To Shiner in P.P. (D)
Fd. 1/2" I.P.	49.25'	S.E. To Shiner in T.P. (D)
32 To Surface (Bent Over)	66.20'	S.W. To Shiner in 8" Walnut (D)

PERSONNEL	TITLE	PERSONNEL	TITLE	COUNTY	Lucas	DATE	1958
Silvester				S. R.	#24	WEATHER	
Crew				SEC.	He-Luci-Waterville	TEMP.	
					(0.00)		

DESCRIPTION LEFT CENTER LINE RIGHT JOB NO.

