

O.D.O.T. DISTRICT 2 SURVEY OFFICE

PERSONNEL

REFERENCE NO. 48

SHEET 55 OF 68

NOTES HUSS

H.C. VANDUSEN

DATE 6-5-97

ROUTE U.S. 24

R.C. LOEHRE

WEATHER FAIR

COUNTY LUCAS

F C.COX

TEMP. +72°F

TOWNSHIP PROVIDENCE

SECTION 19

T 6 N R 10 E


TYPE MONUMENT P.K. NAIL / W

ON SURFACE - BELOW ON


LEFT - C PAV'T - RIGHT 1.0

12.6 TO RT EDGE PAVEMENT

S.L.M. 439 + 44

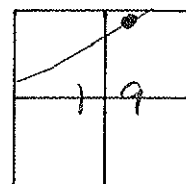

Set PK/W
10-08-97
SAH

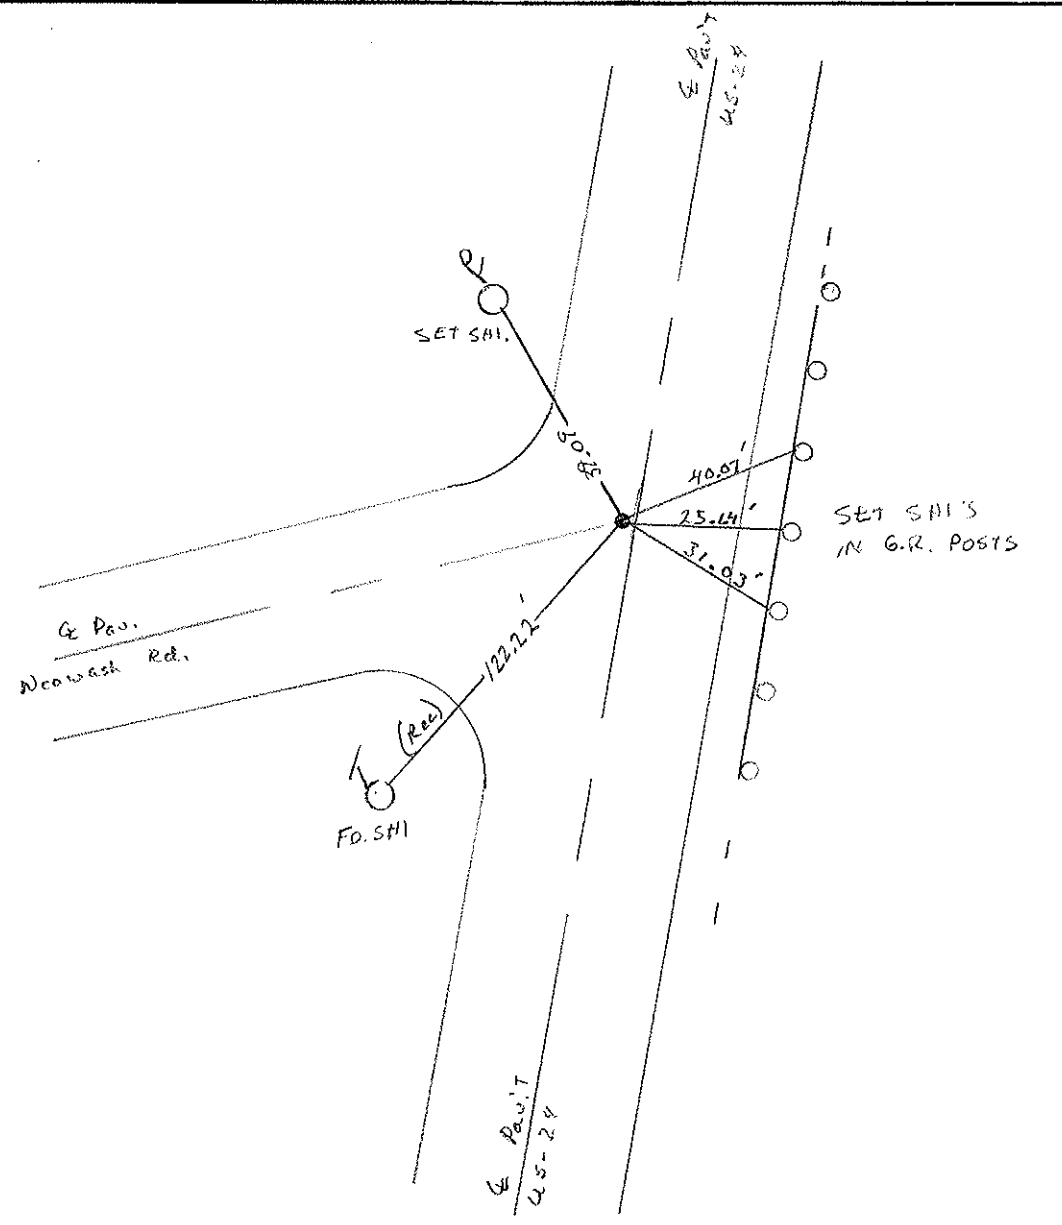

Q.D.O.T. DISTRICT 2 SURVEY OFFICE

Sht. 54 of

County Lucas S.R. US #24

Date 23 July 1980
OK. 9-5-80 G.W.S.

Township Providence

Weather Warm

Section 19

Temp. 79°


T N, R E

Personnel I. Stone


R. Michalak

D. Curtis

48

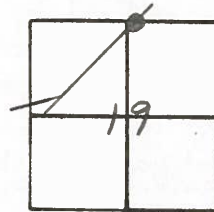

Ref. No. 4248

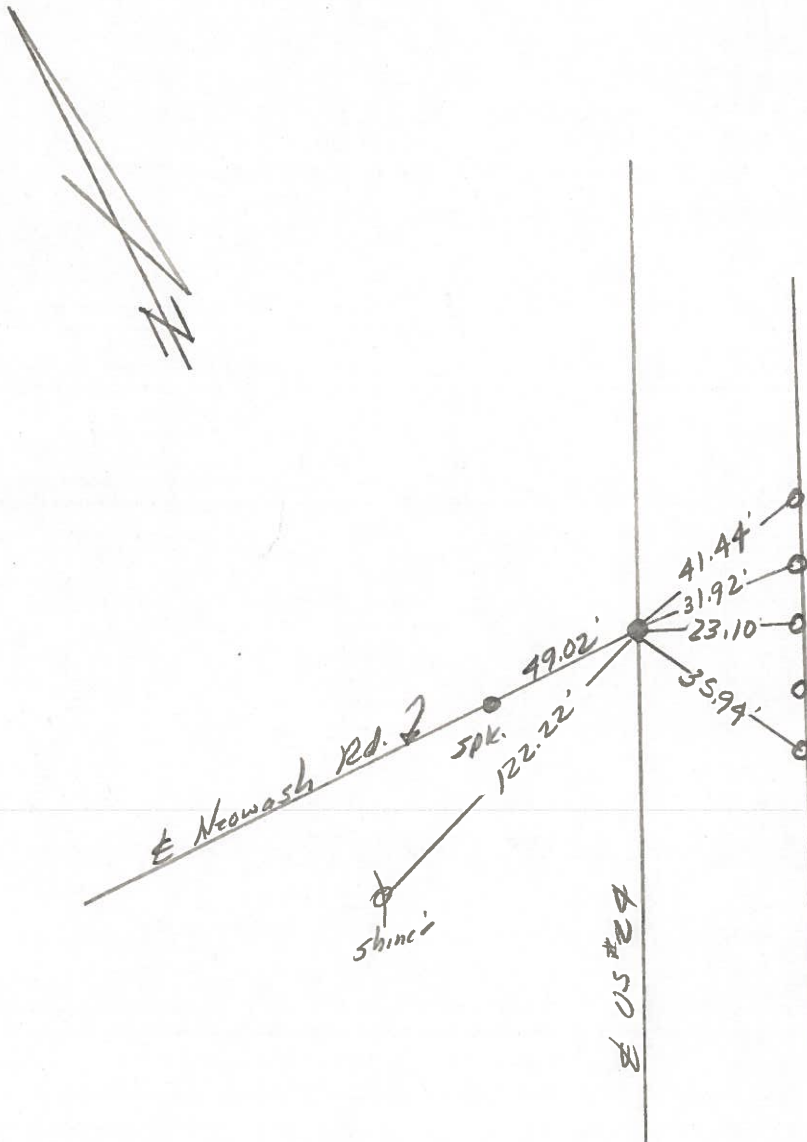


shinc's in
quad posts

SET P.K. NAIL
Ed. P.K. Nail Surface
12.5' to S. edge post.

PERSONNEL	TITLE	PERSONNEL	TITLE
W. Denno			
D. Curtis			
R. Engel			

COUNTY Lucas DATE May 3, 1977
 S. R. US. # 24 WEATHER Cool
 SEC. TEMP. 45°

DESCRIPTION References to Control Points LEFT CENTER LINE RIGHT JOB NO.

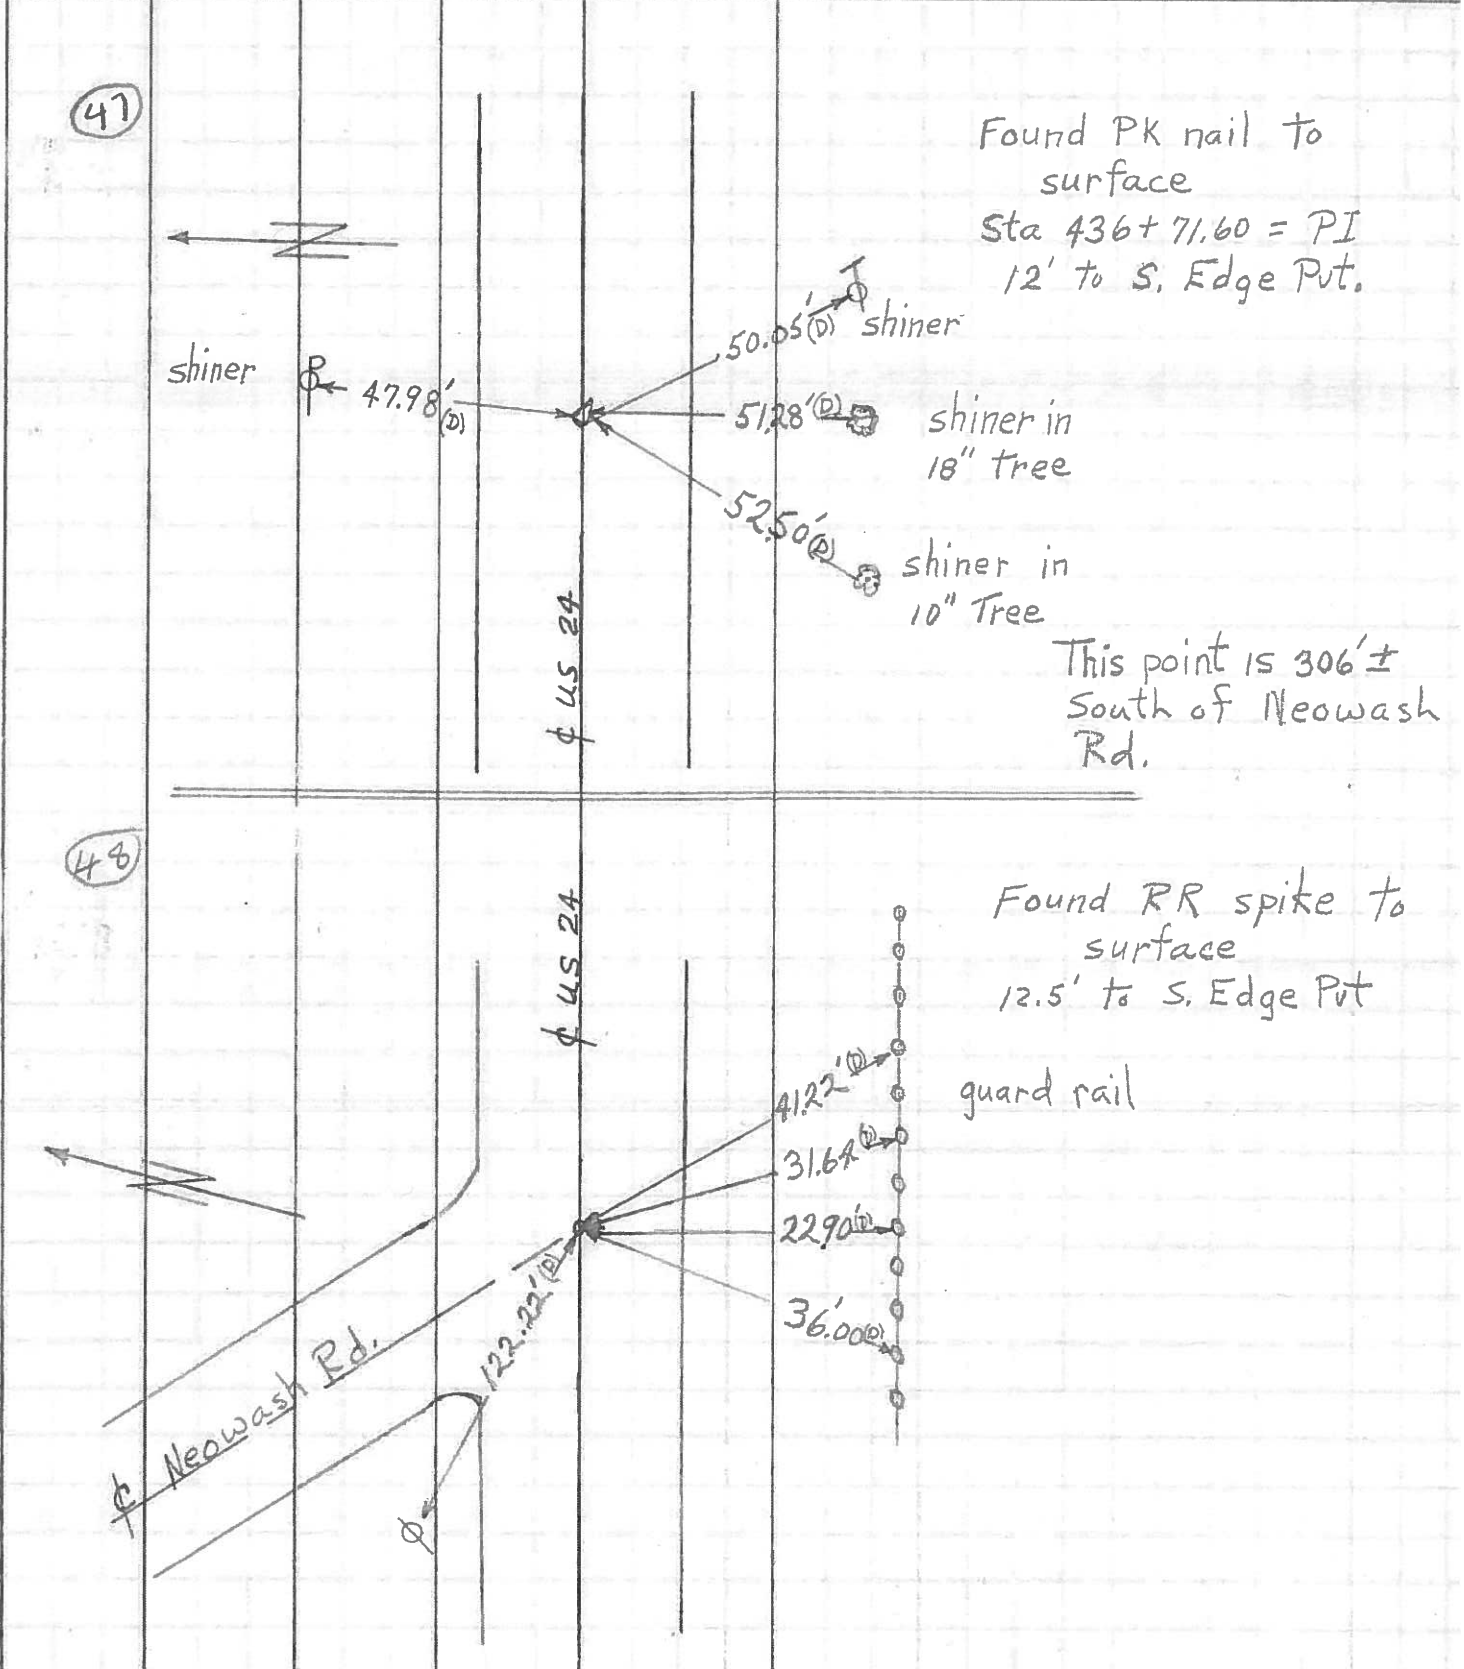

PERSONNEL	TITLE	PERSONNEL	TITLE	COUNTY	DATE	WEATHER	TEMP.
Stone	Notes			Lucas	May 68	Fair	
Beck	Flag			#29			
Michalak	Tape						
Schroder	Tape						

DESCRIPTION References to Control Points JOB NO. _____

